

Grant-Kohrs Ranch Complex, Stallion Barn, No. 2
(Grant-Kohrs Ranch National Historic Site, Stallion Barn)
Highway 10
Deer Lodge
Powell County
Montana

HABS No. MT-39-H

HABS
MONT,
39-DELO,
1-H-

PHOTOGRAPHS

Historic American Buildings Survey
National Park Service
Department of the Interior
Washington, D.C. 20240

ADDENDUM TO
GRANT-KOHRS RANCH, STALLION BARN No. 2 (HS-19)
Grant-Kohrs Ranch National Historic Site
Highway 10
Deer Lodge
Powell County
Montana

HABS No. MT-39-H

REDUCED COPIES OF MEASURED DRAWINGS

HISTORIC AMERICAN BUILDING SURVEY
Southwest System Support Office
National Park Service
P.O. Box 728
Santa Fe, New Mexico 87504

ADDENDUM TO:

GRANT-KOHR'S RANCH, STALLION BARN No. 2
(Grant-Kohrs Ranch, HS 19)
Grant-Kohrs Ranch National Historic Site
Highway 10
Deer Lodge
Powell County
Montana


HABS No. MT-39-H

PHOTOGRAPHS

HISTORIC AMERICAN BUILDING SURVEY
Southwest System Support Office
National Park Service
P.O. Box 728
Santa Fe, New Mexico 87504

HS-19 WAS BUILT IN THE 1870'S AS A STALLION BARN FOR ONE HORSE. SUBSEQUENTLY, A LEAN-TO WAS ADDED TO HOLD ANOTHER STALLION. THE INTERIOR WAS PARTITIONED TO ALLOW SAFE ACCESS FOR THE FEEDER; HAY WAS STORED IN THE LOFT. IN 1928, UNDER THE DIRECTION OF RANCH MANAGER PEMBROKE MCCOMAS, THE STRUCTURE WAS REMODELED INTO A BLACKSMITH SHOP; THE GARAGE DOORS WERE ADDED, A CONCRETE FLOOR POURED, THE LOFT REMOVED, AND A DOORWAY IN THE SOUTH WALL REMOVED. AFTER 1930, THE LEAN-TO WAS USED BY CON WARREN TO HOUSE A BULL AND THE LOFT WAS RECONSTRUCTED.


NOT TO SCALE

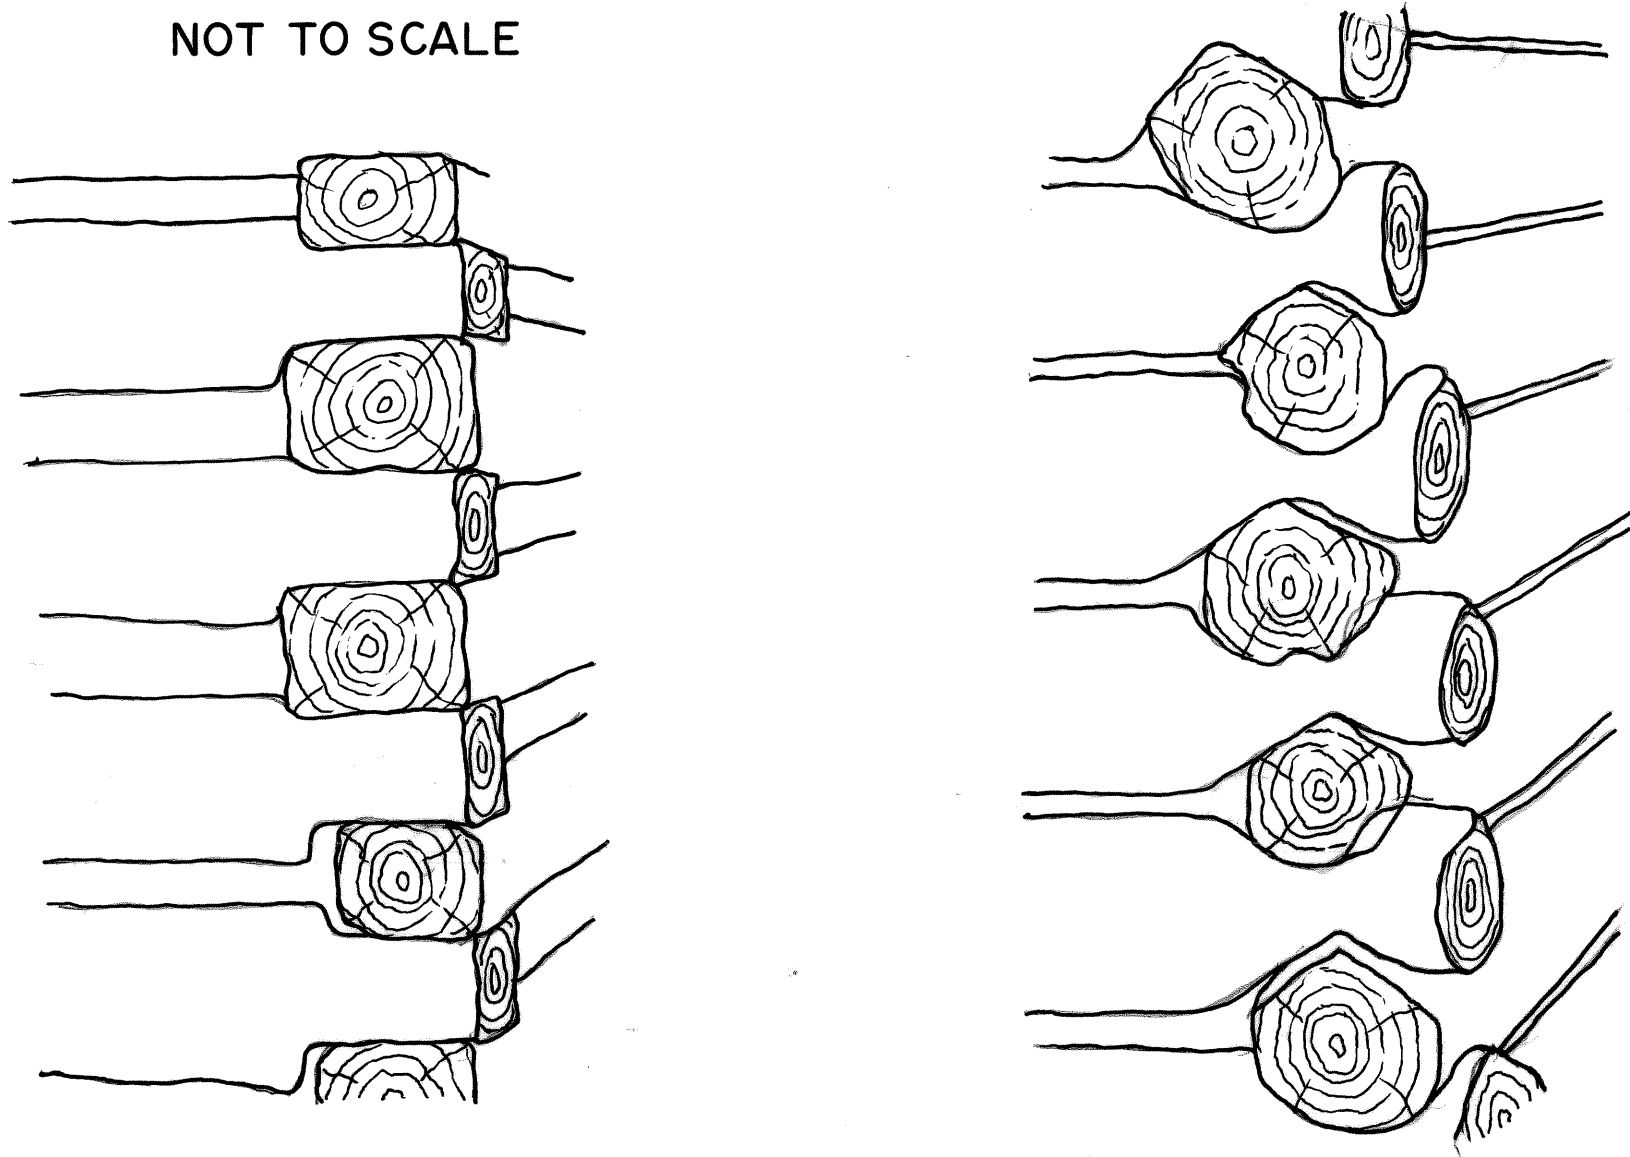

SQUARE JOINT



V NOTCH JOINT

LOG JOINT DETAILS

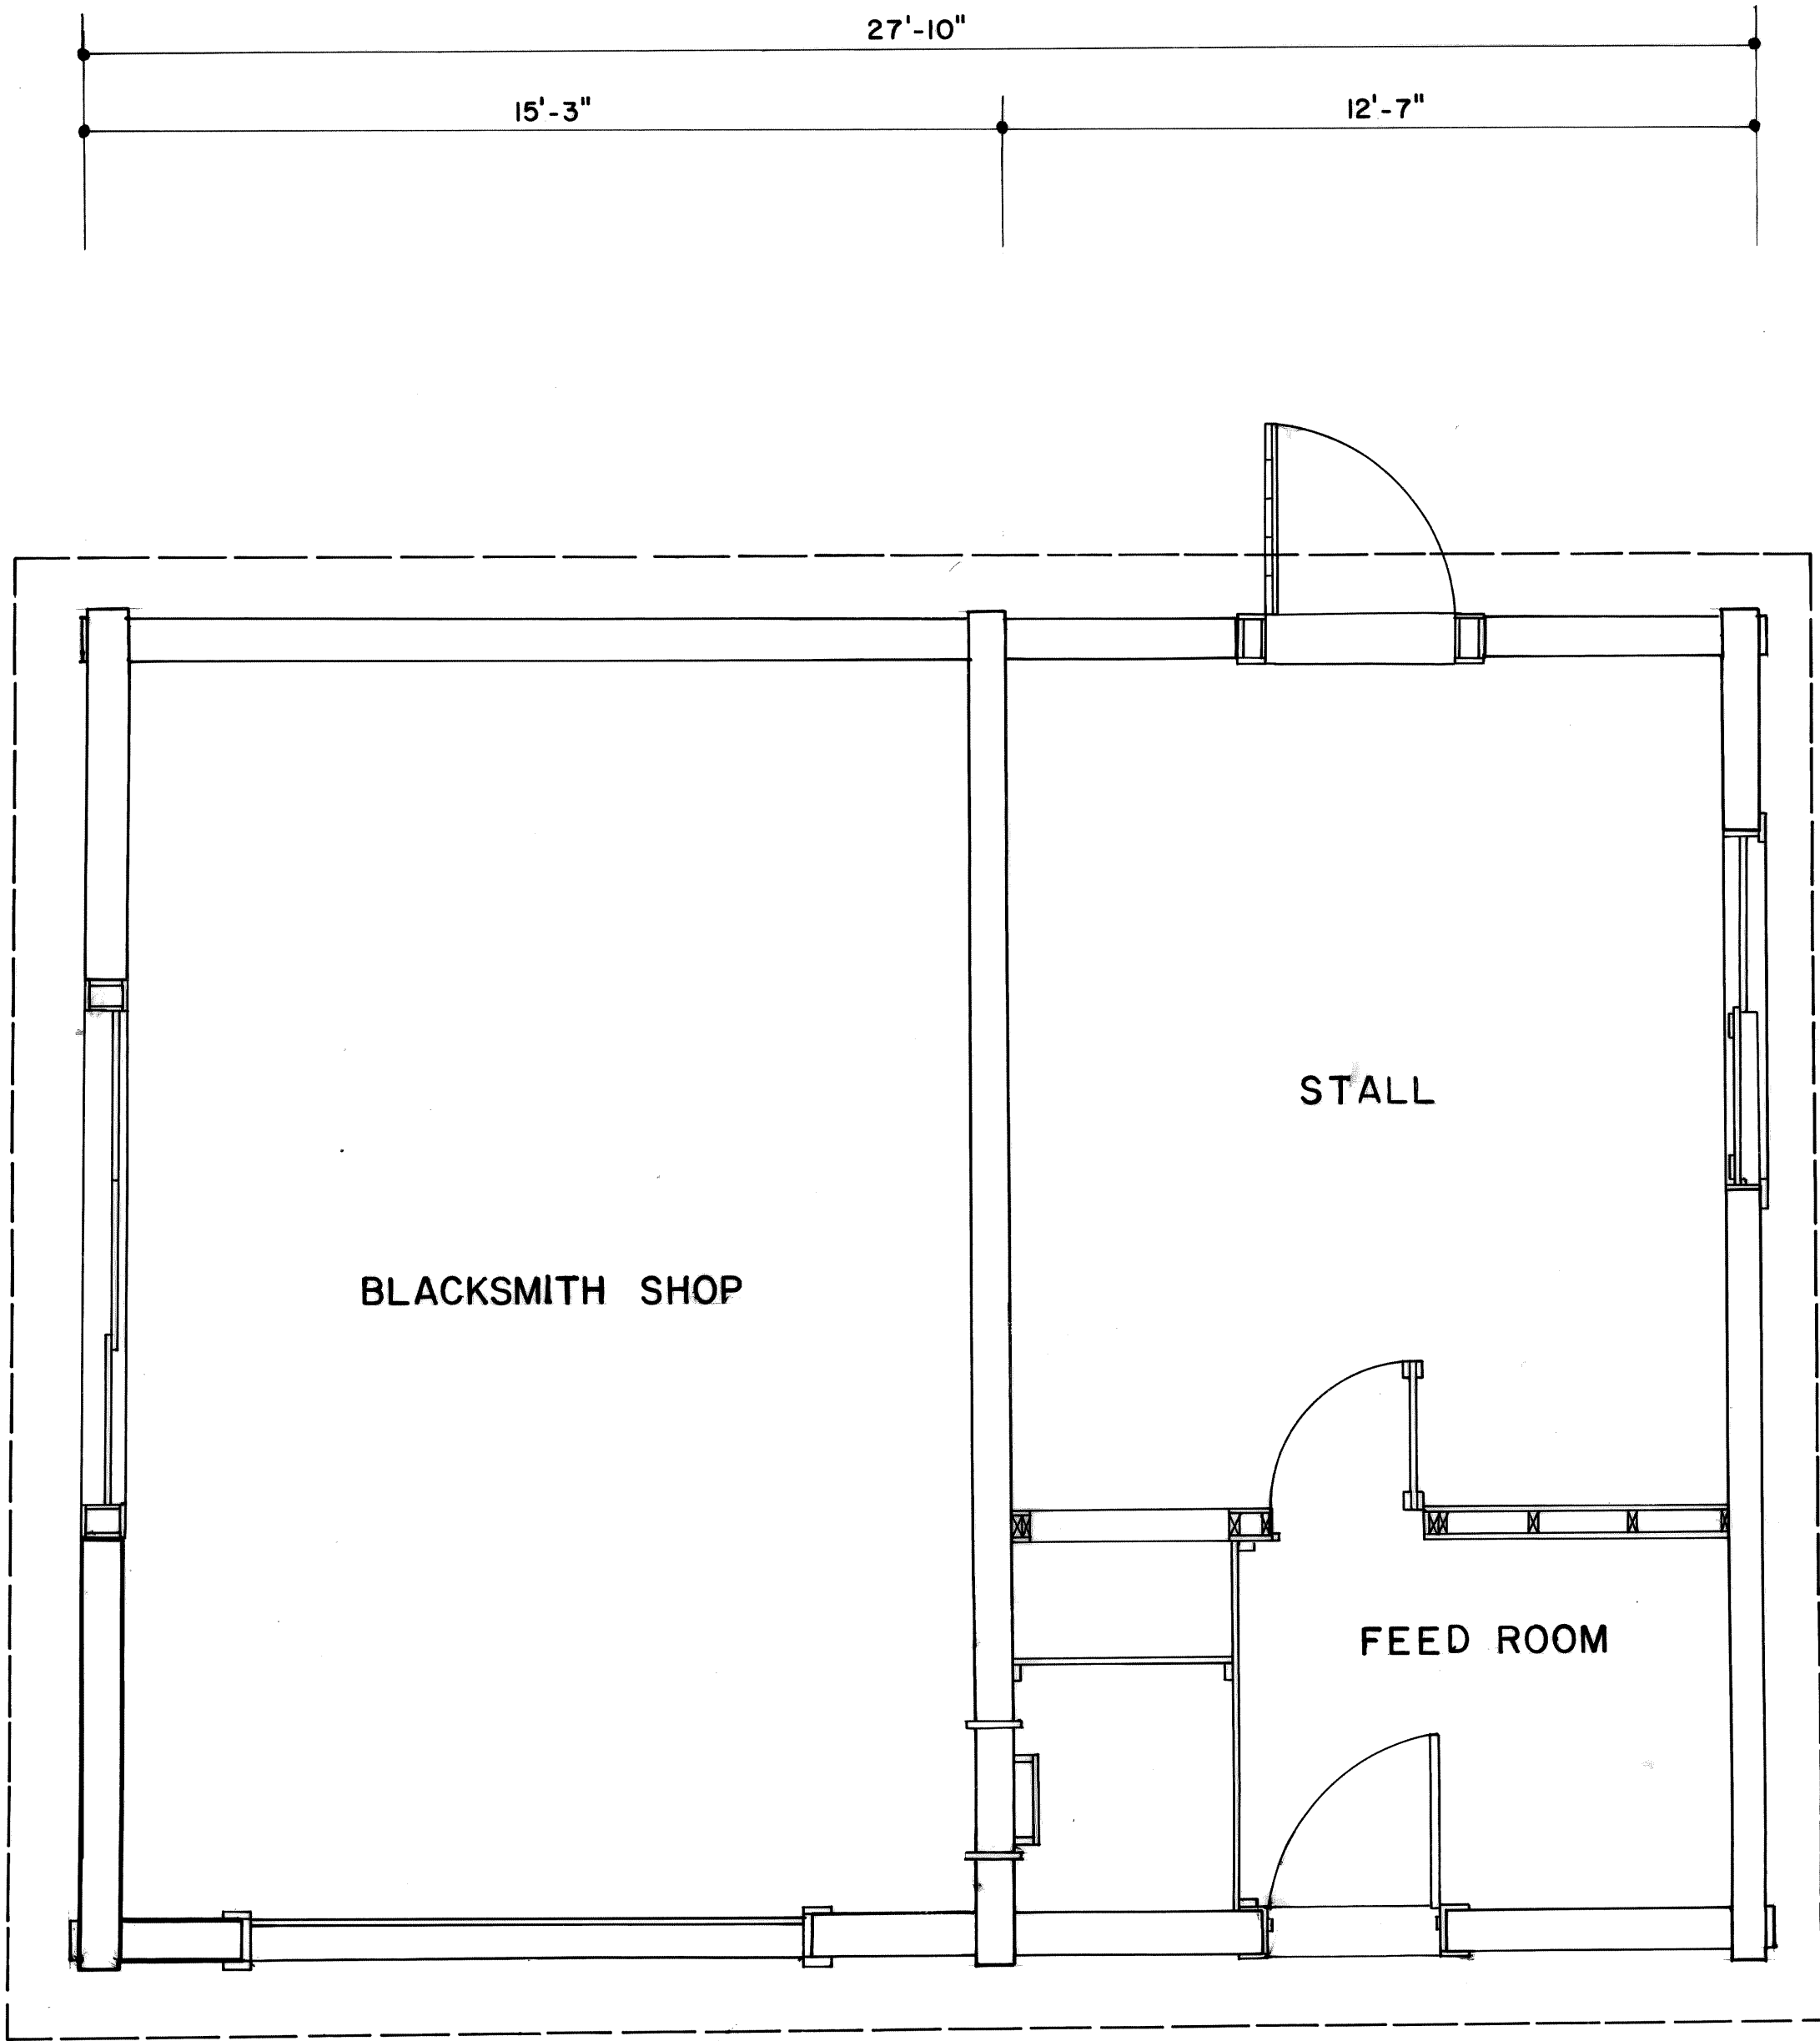

PLAN


SCALE: 3/8" = 1'-0"

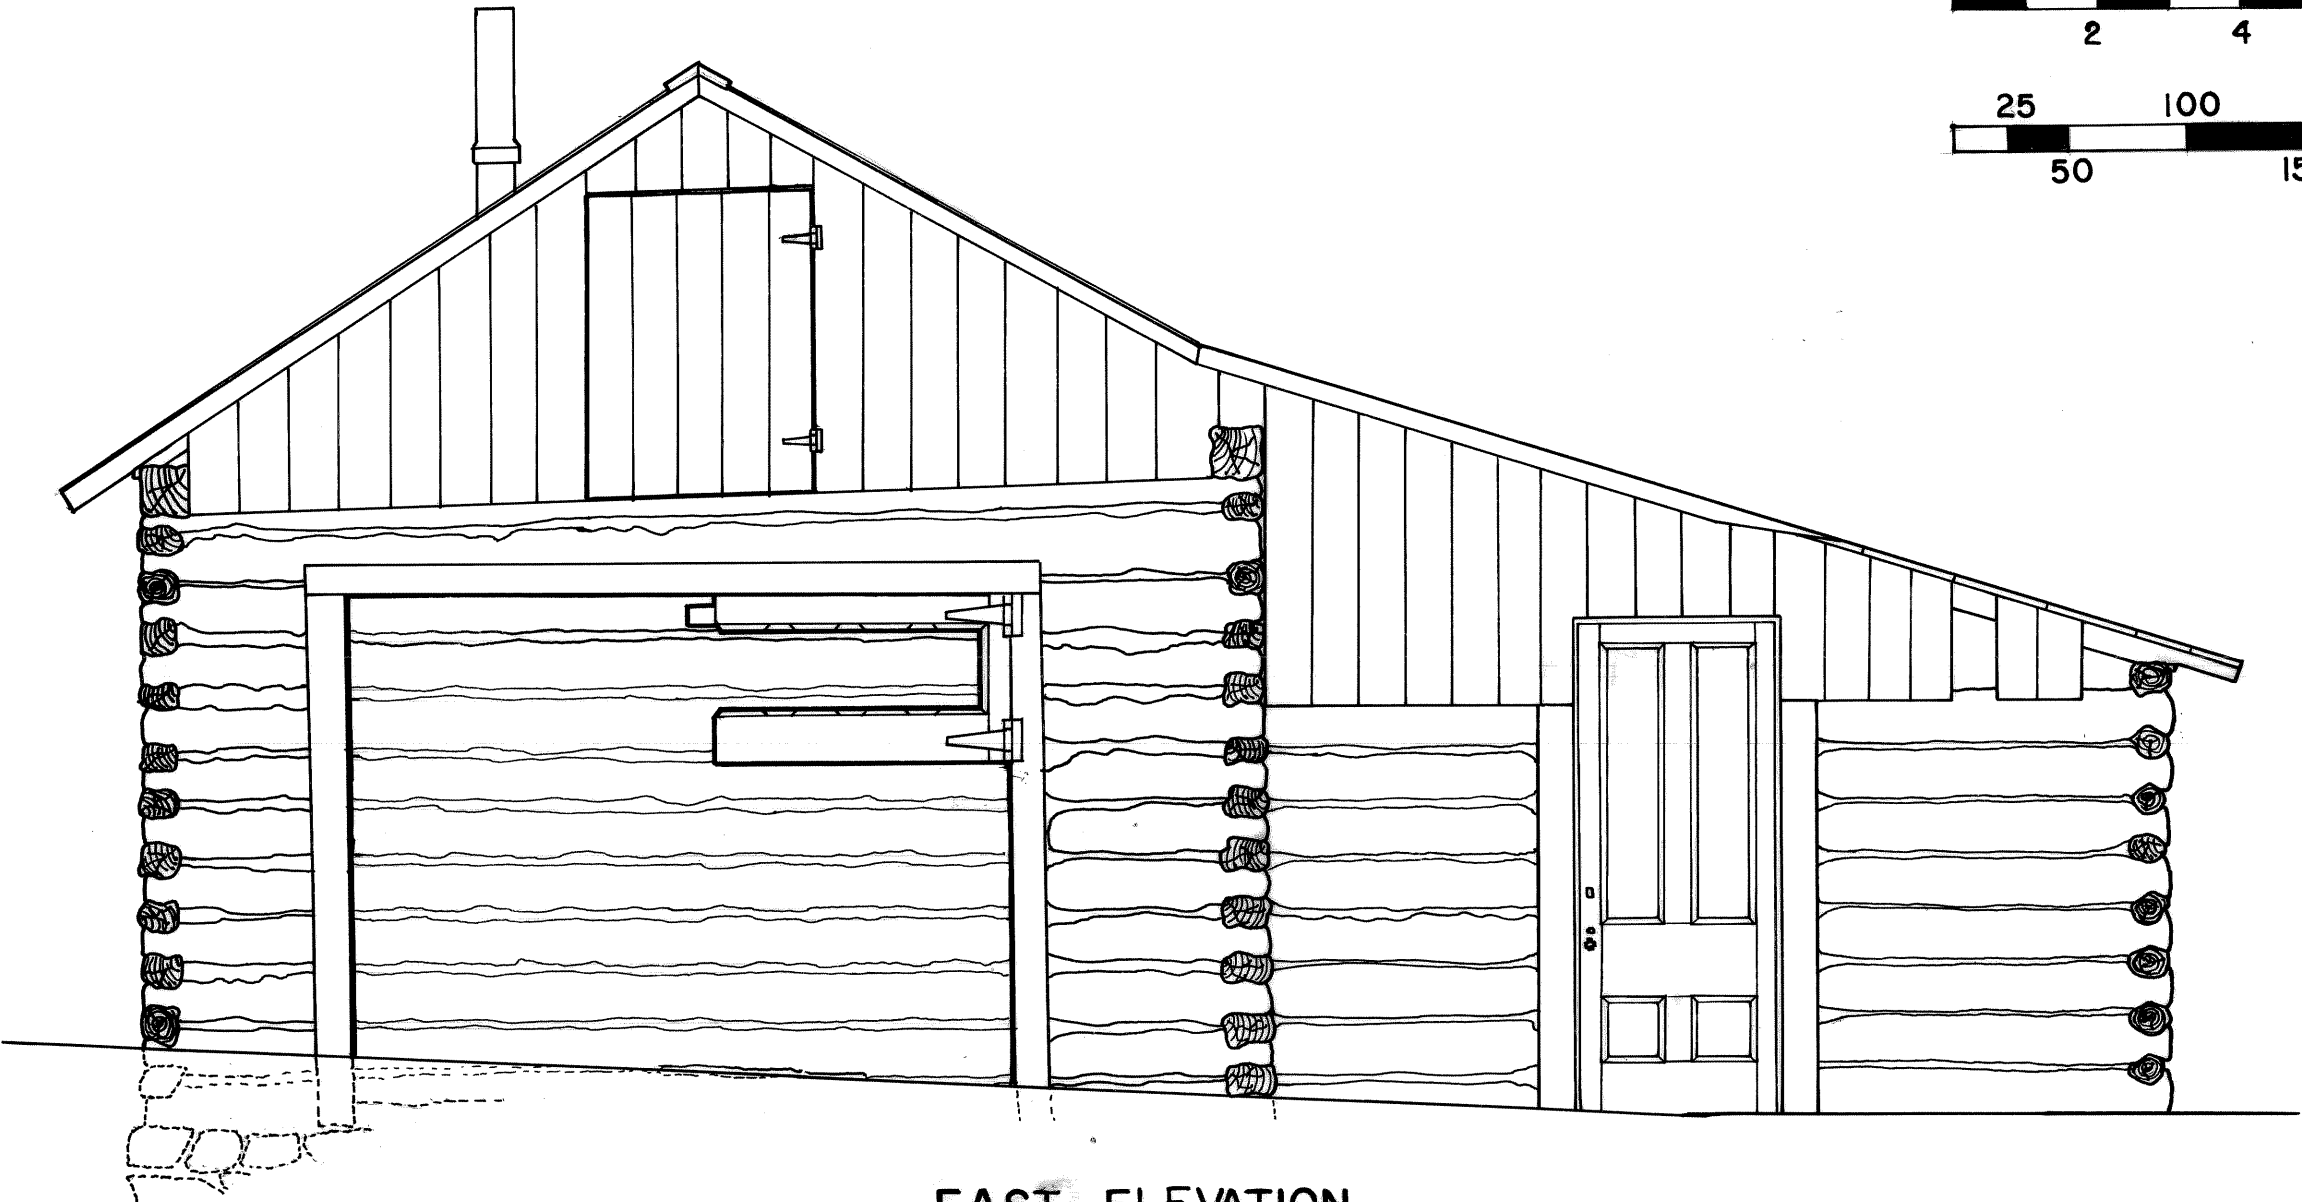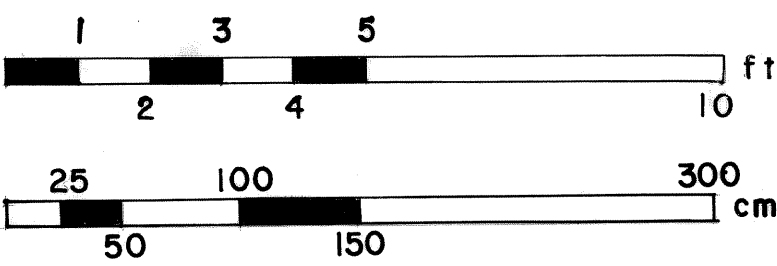


EAST ELEVATION



SOUTH ELEVATION

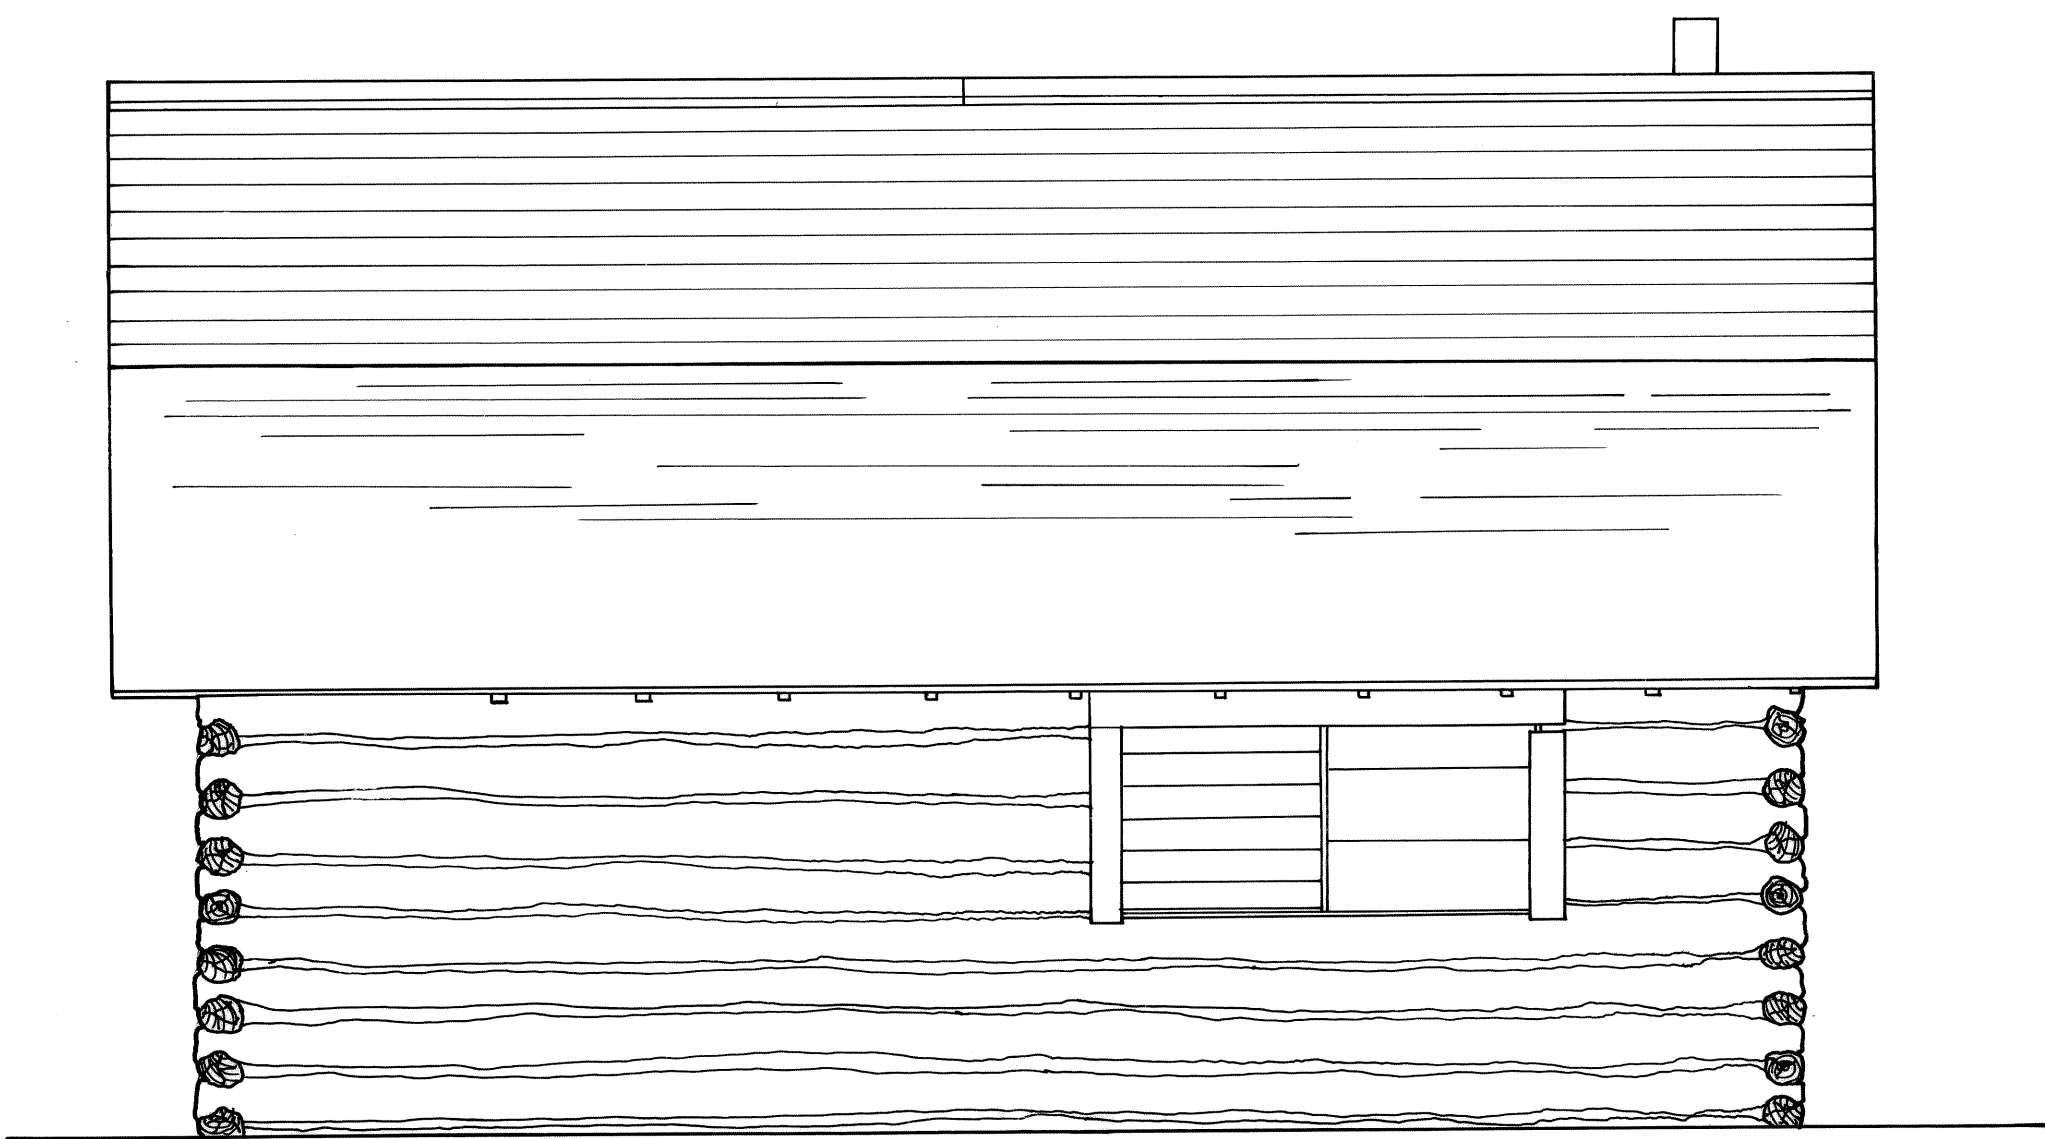


NORTH ELEVATION

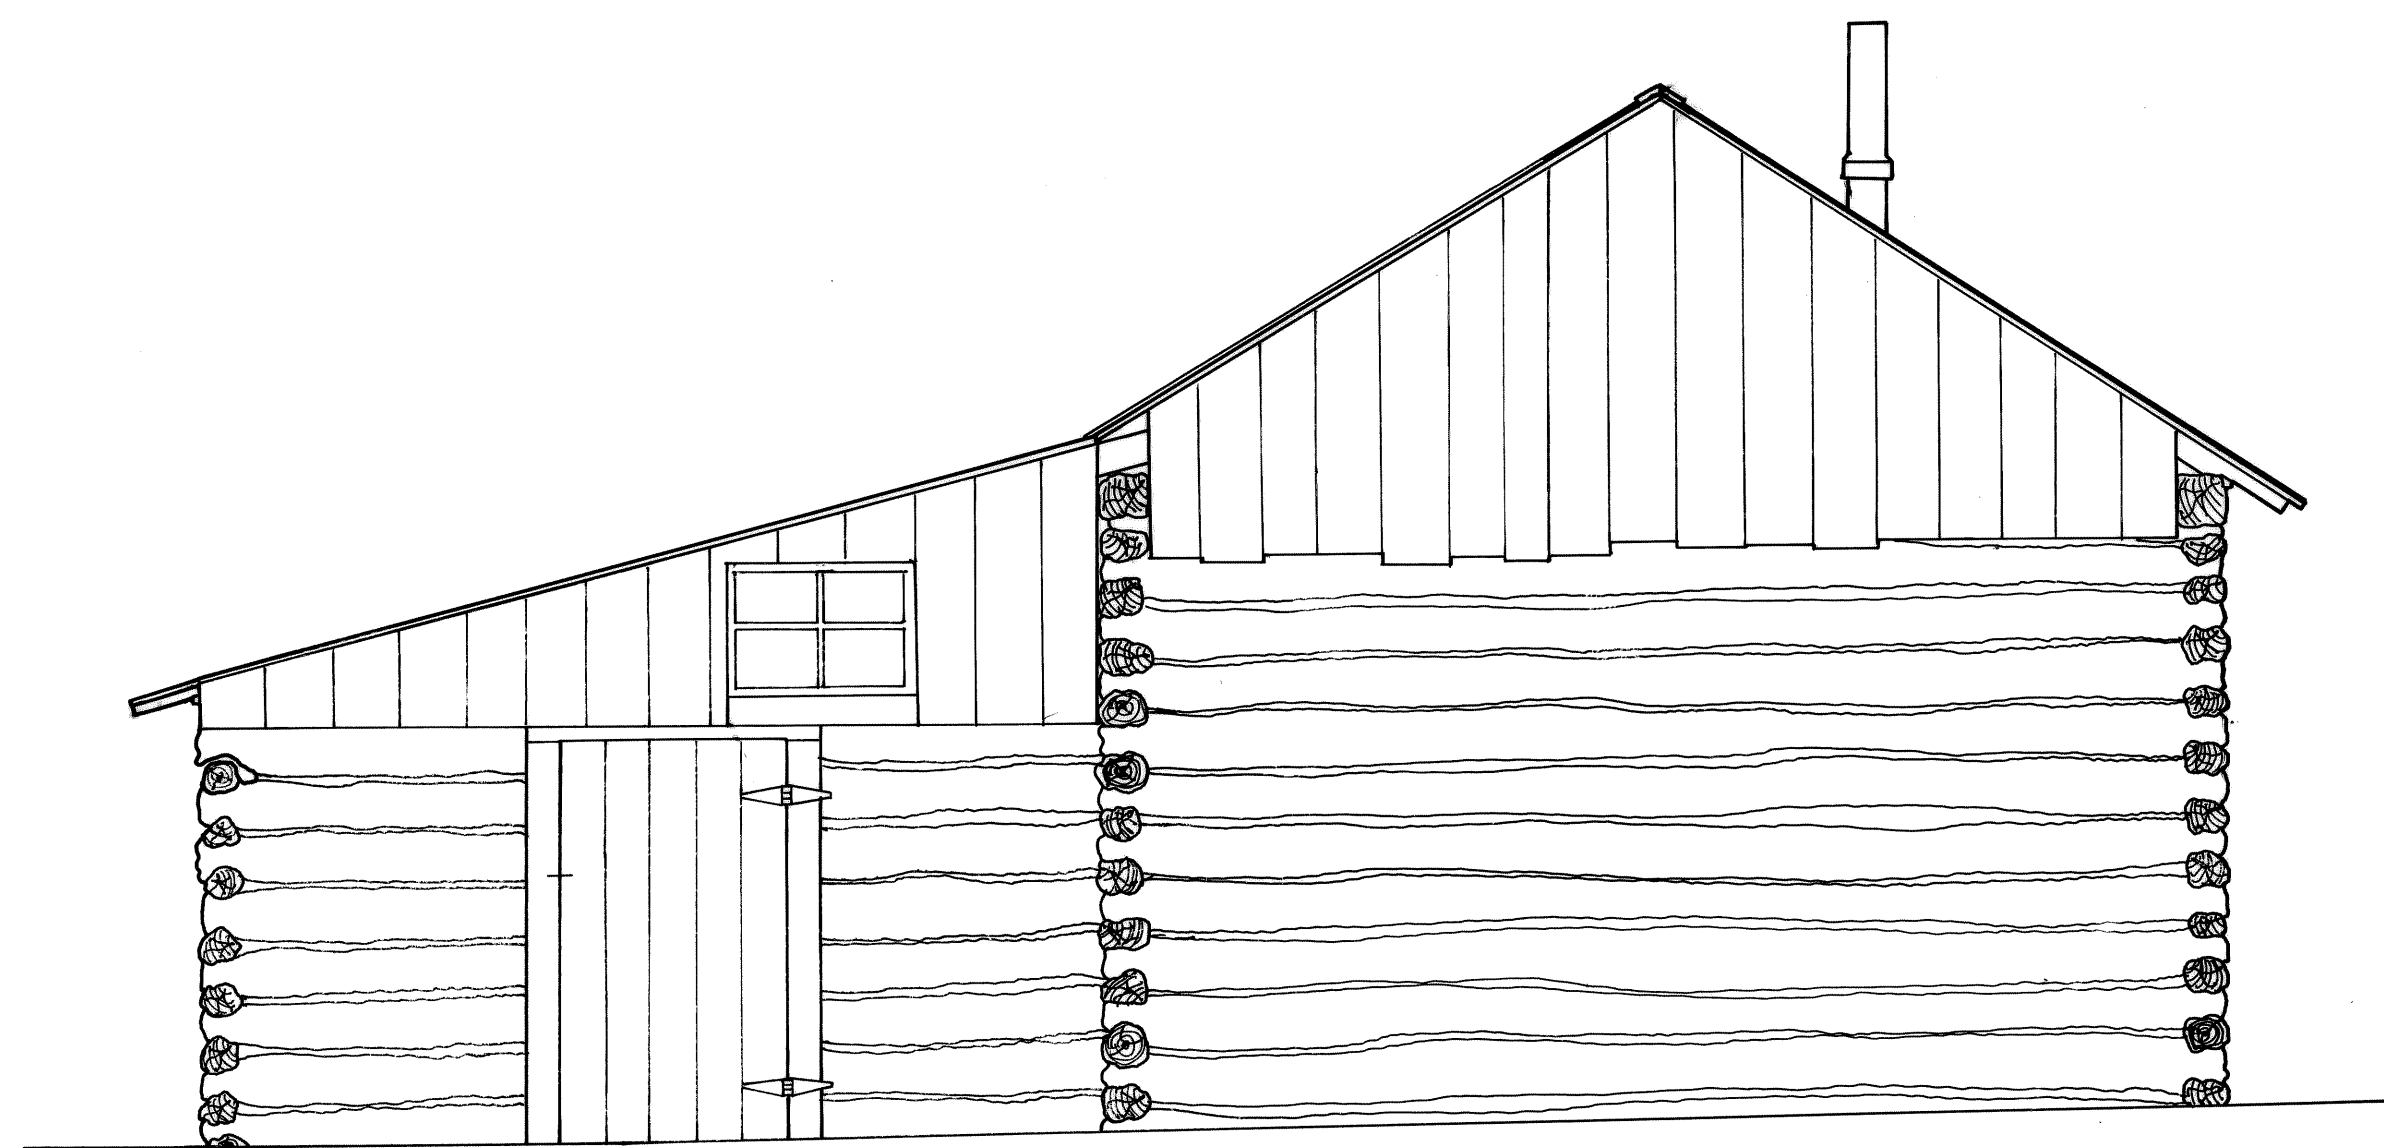

WEST ELEVATION

SCALE: 3/8" = 1'-0"

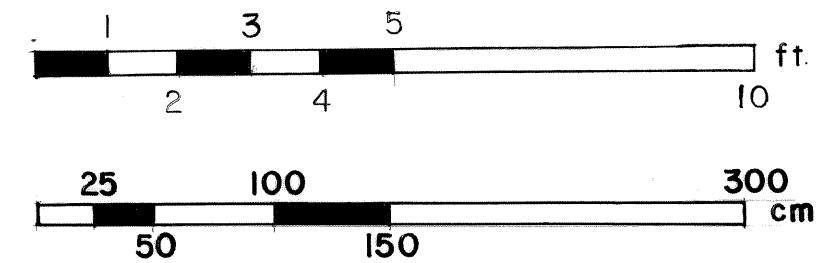

HISTORIC AMERICAN BUILDINGS SURVEY

INDEX TO PHOTOGRAPHS

HABS
MONT
39-DELO,
1-H-

Grant-Kohrs Ranch Complex, Stallion Barn, No.2
(Grant-Kohrs Ranch National Historic Site, Stallion Barn)
Highway 10
Deer Lodge
Powell County
Montana

HABS No. MT-39-H

Jack E. Boucher, Photographer October 1974

MT-39-H-1 PERSPECTIVE VIEW TAKEN FROM THE WEST

MT-39-H-2 PERSPECTIVE VIEW TAKEN FROM THE NORTHWEST

MT-39-H-3 PERSPECTIVE VIEW TAKEN FROM NORTHEAST

HISTORIC AMERICAN BUILDINGS SURVEY

INDEX TO PHOTOGRAPHS

ADDENDUM TO:
GRANT-KOHR'S RANCH, STALLION BARN NO. 2
(Grant-Kohrs Ranch, HS 19)
Grant-Kohrs Ranch National Historic Site
Highway 10
Deer Lodge
Powell County
Montana

HABS No. MT-39-H
(Page 2)

Photographs MT-39-H-1 through MT-39-H-3 were previously transmitted to the Library of Congress in August 1983.

John S. Hanttula, Photographer, May 22, 2001

MT-39-H-4 Exterior, northwest view

ALBANY, MONT.
JAN 1974

HH85 Ab. MT-34-4-1









HAB5 MT-39-H-44-105-A-MT-108-1-1

