

Henry Whitehead Place
Great Smoky Mountains National Park
Cades Cove Vicinity
Blount County
Tennessee

HABS TN-161

HABS

TEIN

5-CADCO.V,

1-

REDUCED COPIES OF MEASURED DRAWINGS

Addendum to
Henry Whitehead Place
(Great Smoky Mountains National Park)
Cades Cove Vicinity
Blount County
Tennessee

HABS No. TN-161

HABS
TENN,
5-CADCO1
1-

PHOTOGRAPHS

WRITTEN HISTORICAL AND DESCRIPTIVE DATA

Historic American Buildings Survey
National Park Service
Department of the Interior
Washington, D.C. 20240

Addendum to
HENRY WHITEHEAD PLACE
Great Smoky Mountains National Park
Cades Cove
Blount County
Tennessee

HABS
TENN
S-CADCO. 1/2
1-

Owner -

U. S. Government, National Park Service

Date of Erection -

Back Cabin 1881 (local tradition)

Front Cabin 1895-1898

H.C. Wilburn, C.S. Grossman and A. Stupka

Report on the Proposed Mountain Culture Program for the
Great Smoky Mountains National Park - typescript -
28 June 1938 .

Architect -

Builder -

Of back cabin - David Shields

Of front cabin - Henry Whitehead

Materials -

Back cabin - Roughly hewn logs with saddle-notched joints.

Front cabin - Sash-sawn timbers from the heart of white
pine logs with dovetail joints.

Present Condition -

The cabin was restored in 1937 by C.S. Grossman. Further repairs
were made in 1948 by the National Park Service.

References -

Wilburn, Grossman and Stupka - op. cit.

Cades Cove Leaflet.

Buildings File, Park Headquarters

Horace Kephart MS. Notebooks

Photographs

Campbell, John C. - The Southern Highlander and His Homeland.

Russell Sage Foundation, N. Y. 1921.

Murfree, Mary Noailles, The Prophet of the Great Smoky Mountains, Boston
Houghton Mifflin, 1885,

Ross, Marion Dean - The Henry Whitehead Place, Cades Cove, Great Smoky Mountains National Park - An Architectural Survey Report prepared August 1957. typescript in Eastern Office, Division of Design and Construction, National Park Service, 120 South 3rd Street, Philadelphia 6, Pa.

Architectural Description -

Layout - Two approximately square cabins, the larger with a porch on front and back.

Over-all dimensions -

Old cabin 15'2" x 14'9" (int. dimensions), connecting porch 6'10-3/8" x 20'7-1/2"

New cabin 17'-1/4" x 19' 9-1/2" (int. dimensions)

Porch on front of New Cabin 5' 1-1/2" x 20' 7-1/2"

Construction -

Foundations: piles of local stones and earth

Old Cabin: Built of roughly hewn logs, the hewing on the sides probably being done after they were laid up in the walls. As the wall was laid up, the lower log was "shouldered" at the corners and the next upper log "saddled" to fit on top. Wide spaces were left between the logs, which were filled with 1/2 inch chinking boards on each side, making the average thickness of the wall 9 inches. Most vertical measurements are out of plumb. The chimney was built of field stone laid in mud mortar. It was repaired in 1948. Both gable ends are covered with clapboards above the log wall.

The roof of the cabin is made of rived oak shakes laid shingle fashion, 24 inches long and 8 inches to the weather.

New or Front Cabin - Built of sawn log construction resting on low dry stone piers at each corner. The logs are carefully dovetailed with a half-butterfly notch to allow drainage at each joint. The vertical joints in the notches are cut with a saw. The joints are generally tight without chinking. According to Mr. Grossman, the walls were built to their full height before the openings were cut.

The chimney in the center of the southwest wall is built of hand-molded brick fired on the place. At the ground, the chimney measures 2'2" x 4'10".

Cost - Not known

Elevations -

The front of the newer cabin faces northwest. The porch in front was restored by Charles Grossman in 1937. There is a batten door off center to the right. There is a break between the shingles of the roof and the shingles of the porch. The height of the new cabin is about 20 ft. to the ridge of the roof.

The northwest elevation of the old cabin also has a batten door, more nearly in the center. The height to the ridge is 13'2-1/2".

The southwest elevation shows most sharply the contrast between the earlier hand-hewn cabin and the later sash-sawn cabin. On the top of the brick chimney, there is a high metal hood, which narrows toward the top.

In the newer cabin, there is one window to the left of the chimney. In the older cabin, there is a window on either side, the one to the left being only an 11" pane of glass which slides upward - originally an unglazed opening known as a "Granny Hole."

On the southeast elevation of the new cabin, there is also a batten door. On the southeast elevation of the old cabin, there is a wide, but low window 3'3-1/2" x 11".

Interior -

There is no basement in either cabin.

Ground floor - Old cabin only one room with the fireplace of local stone and clayey mortar. The arch of the fire opening was reinforced by two pieces of iron from a wagon tire 1-3/8" wide.

The new cabin has a loft over the main room, which is reached by narrow ladder stairs in the south corner of the room. The sash window has four panes. Over the brick fireplace, there is tongue and groove boarding up to a very high shelf. The fireplace lintel is of iron, size 5/8" x 2-3/8" x 34-1/2".

History -

The old cabin of 1881 was built by David Shields for his sister when she returned to Cades Cove as a widow with one child. The widow was courted by Henry Whitehead, who, in his efforts to persuade her to marry him, promised to build her the finest cabin in Cades Cove according to Mr. Grossman of the National Park Service, who has studied the log cabins of this region considerably. Henry Whitehead succeeded, and the new cabin is the "ultimate" in log construction. The logs were sash-sawn at the nearby Cable Mill. The cabin is about 16 by 18 feet, which is about the largest length of log which would be sawn at a sash-saw mill.

These cabins are on their original sites and have been repaired twice by the National Park Service, once in 1937 and again in 1948. In 1948, the National Park Service began marking and dating all replacements.

The hand-molded brick chimney was very unusual for the area and also gave a lot of prestige to the Henry Whitehead Cabin.

In the old cabin, there are remains of a warping frame hanging on pegs on the wall, on which are hanging fragments of a spool frame. The warping frame was used for measuring the warp and keeping it in order preparatory to setting up the loom. The spool frame was used separately and held yarn on cornhusk spindles, from which it was drawn to the warping frame.


March 4, 1958

Agnes A. Gilchrist
HABS-EQDC
National Park Service
April 3, 1958

HENRY WHITEHEAD PLACE

CADES COVE TENNESSEE

GREAT SMOKY MOUNTAINS NATIONAL PARK

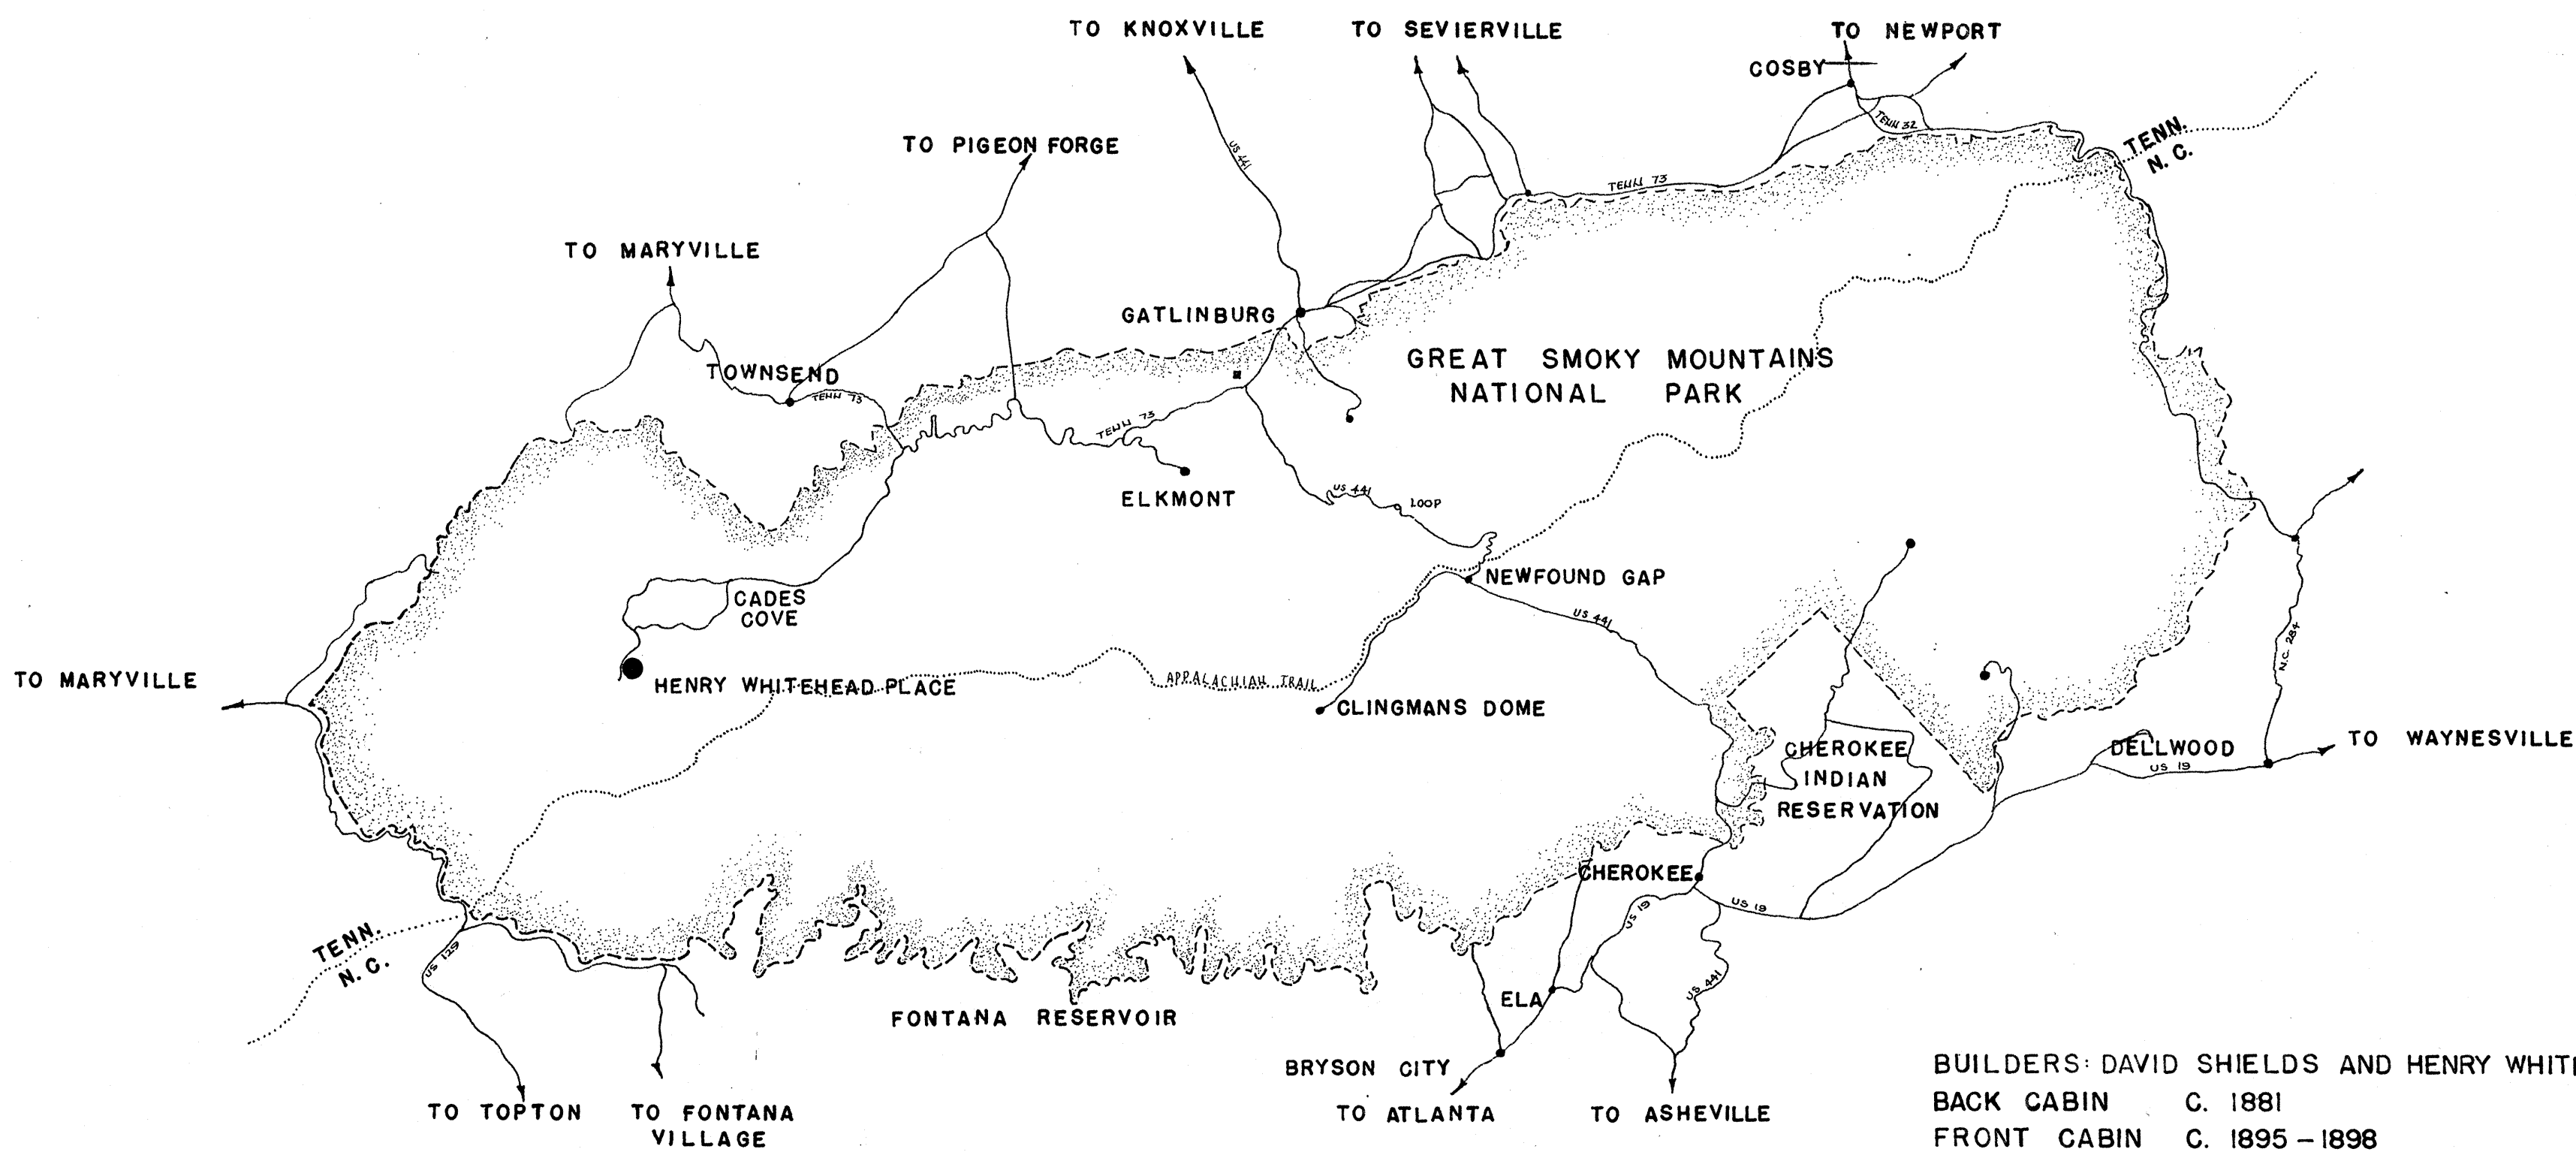

BUILDERS: DAVID SHIELDS AND HENRY WHITEHEAD
BACK CABIN C. 1881
FRONT CABIN C. 1895 - 1898

HISTORIC AMERICAN BUILDINGS SURVEY
U. S. DEPARTMENT OF THE INTERIOR
NATIONAL PARK SERVICE
BRANCH OF PLANS AND DESIGN

MEASURED: JUNE - JULY 1957

DRAWN: JULY - AUGUST 1957

MEASUREMENTS CHECKED:

DRAWINGS APPROVED:

DRAWINGS APPROVED:

ACCEPTED FOR LIBRARY OF CONGRESS:

, DISTRICT OFFICER.

, CHIEF ARCHITECT.

SURVEY NO.

TENN
161

11 SHEETS

INDEX NO.


TENN.
5-CADCO.V

—

SOURCES OF INFORMATION
FOR PLOT PLAN

MAP & SURVEY MADE BY G.G. MARTIN
JUNE 1957
OBSERVATIONS AND MEASUREMENTS
MADE AT SITE BY M.D. ROSS, C.R. LUNDY,
AND S.E. HENRY JUNE — JULY 1957

NOTE: B.M. — TOP OF STONE AT BASE
OF CHIMNEY USED AS BASE POINT
FOR ALL VERTICAL MEASUREMENTS.

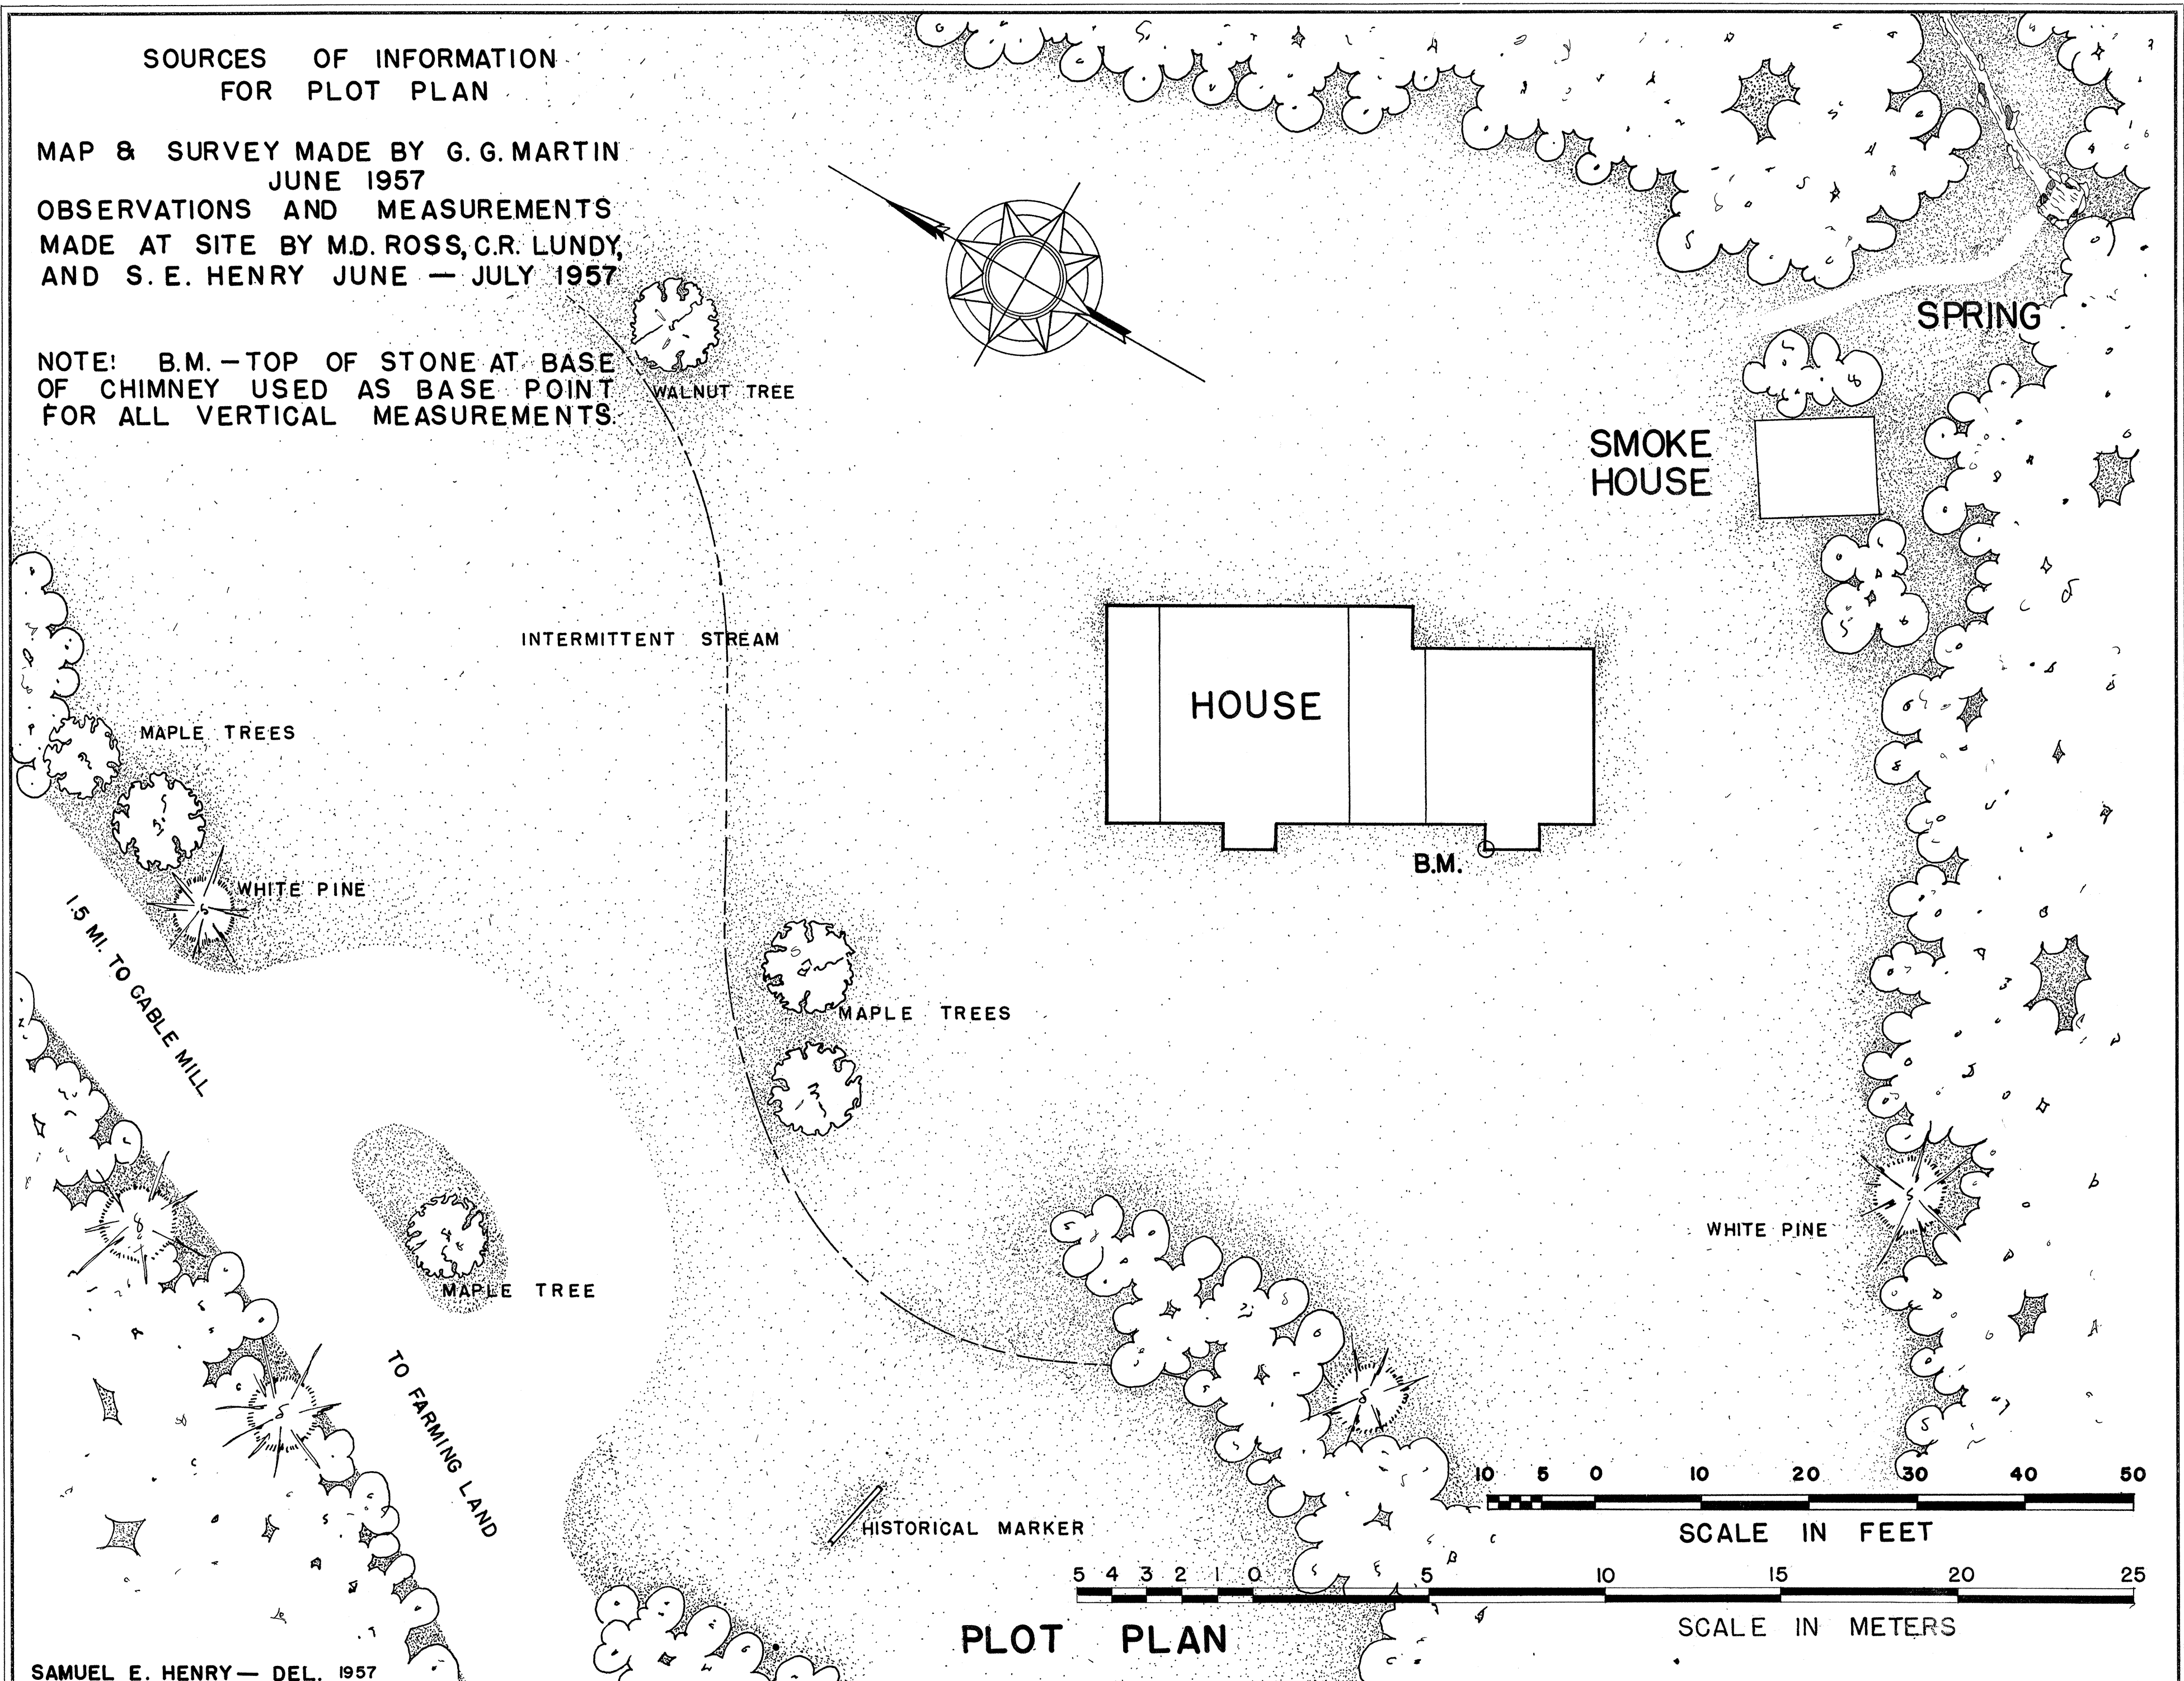

SAMUEL E. HENRY — DEL. 1957

PHILADELPHIA EASTERN OFFICE
DIVISION OF DESIGN & CONSTRUCTION
UNDER DIRECTION OF UNITED STATES DEPARTMENT OF THE INTERIOR
NATIONAL PARK SERVICE, BRANCH OF PLANS AND DESIGN

NAME OF STRUCTURE
THE HENRY WHITEHEAD PLACE
— CADES COVE — GREAT SMOKY MOUNTAINS NATIONAL PARK — TENNESSEE — BLOUNT COUNTY —

SURVEY NO.
TENN
161

HISTORIC AMERICAN
BUILDINGS SURVEY
SHEET 1 OF 11 SHEETS

LIBRARY OF CONGRESS
INDEX NUMBER


NOTE: NEW CABIN WALLS SASH SAWN LOGS, DOVETAILED CORNERS.
 OLD CABIN WALLS HEWN LOGS, SADDLE NOTCHED CORNERS.
 PORCH BETWEEN CABINS REPLACED IN 1937.
 FLOORS 1" BOARDS, IN REAR CABIN REPLACED IN 1937.

DOOR SCHEDULE


- ① 1" x 33" x 72"
- ② 1" x 32³/₄" x 72"
- ③ 1" x 23¹/₂" x 41¹/₂"
- ④ 1" x 31" x 62¹/₂"

LEGEND

BRICK IN SECTION
 STONE IN SECTION
 WOOD IN SECTION

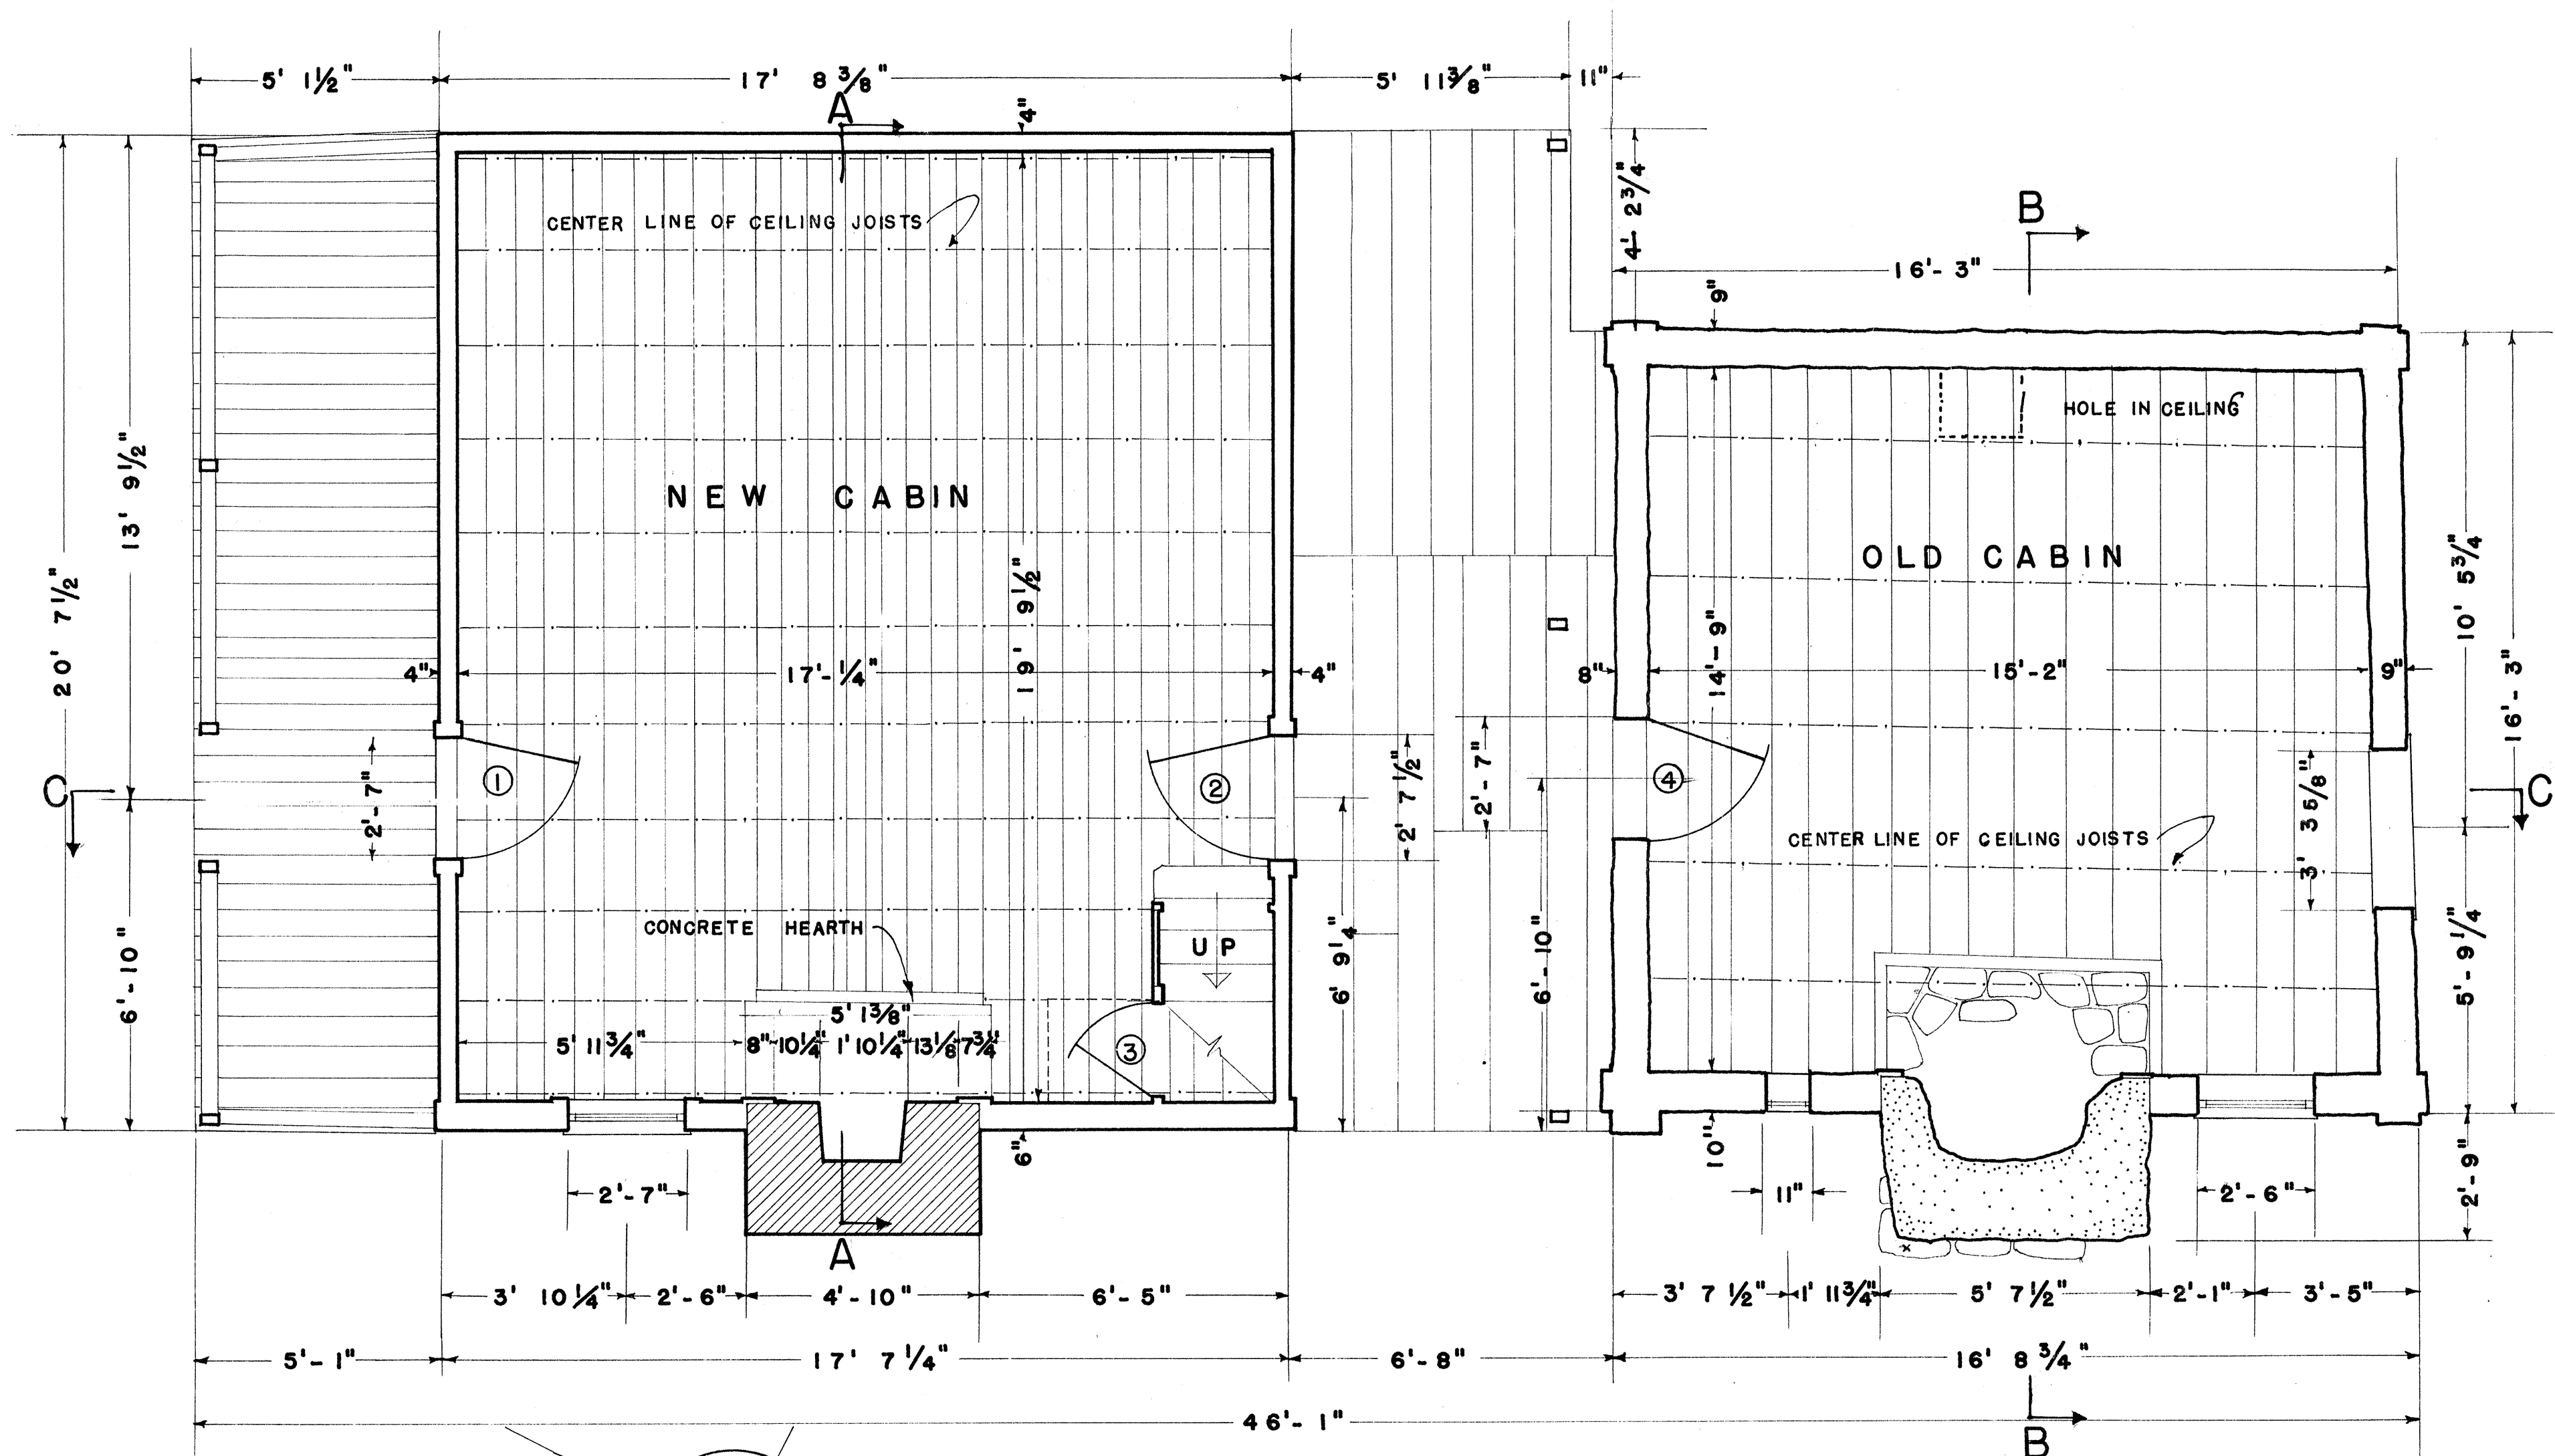

FIRST FLOOR PLAN
 SCALE 3/8" = 1'-0"

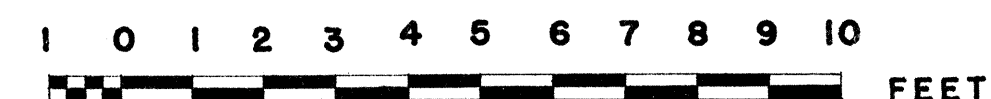

RICHARD LUNDY - DEL. 1957

PHILADELPHIA - EASTERN OFFICE
 DIVISION OF DESIGN AND CONSTRUCTION
 UNDER DIRECTION OF UNITED STATES DEPARTMENT OF THE INTERIOR
 NATIONAL PARK SERVICE, BRANCH OF PLANS AND DESIGN


NAME OF STRUCTURE
THE HENRY WHITEHEAD PLACE
 CADES COVE - GREAT SMOKY MOUNTAINS NATIONAL PARK - BLOUNT COUNTY - TENNESSEE

SURVEY NO.
 TENN
 161

HISTORIC AMERICAN
 BUILDINGS SURVEY
 SHEET 2 OF 11 SHEETS

LIBRARY OF CONGRESS
 INDEX NUMBER

52

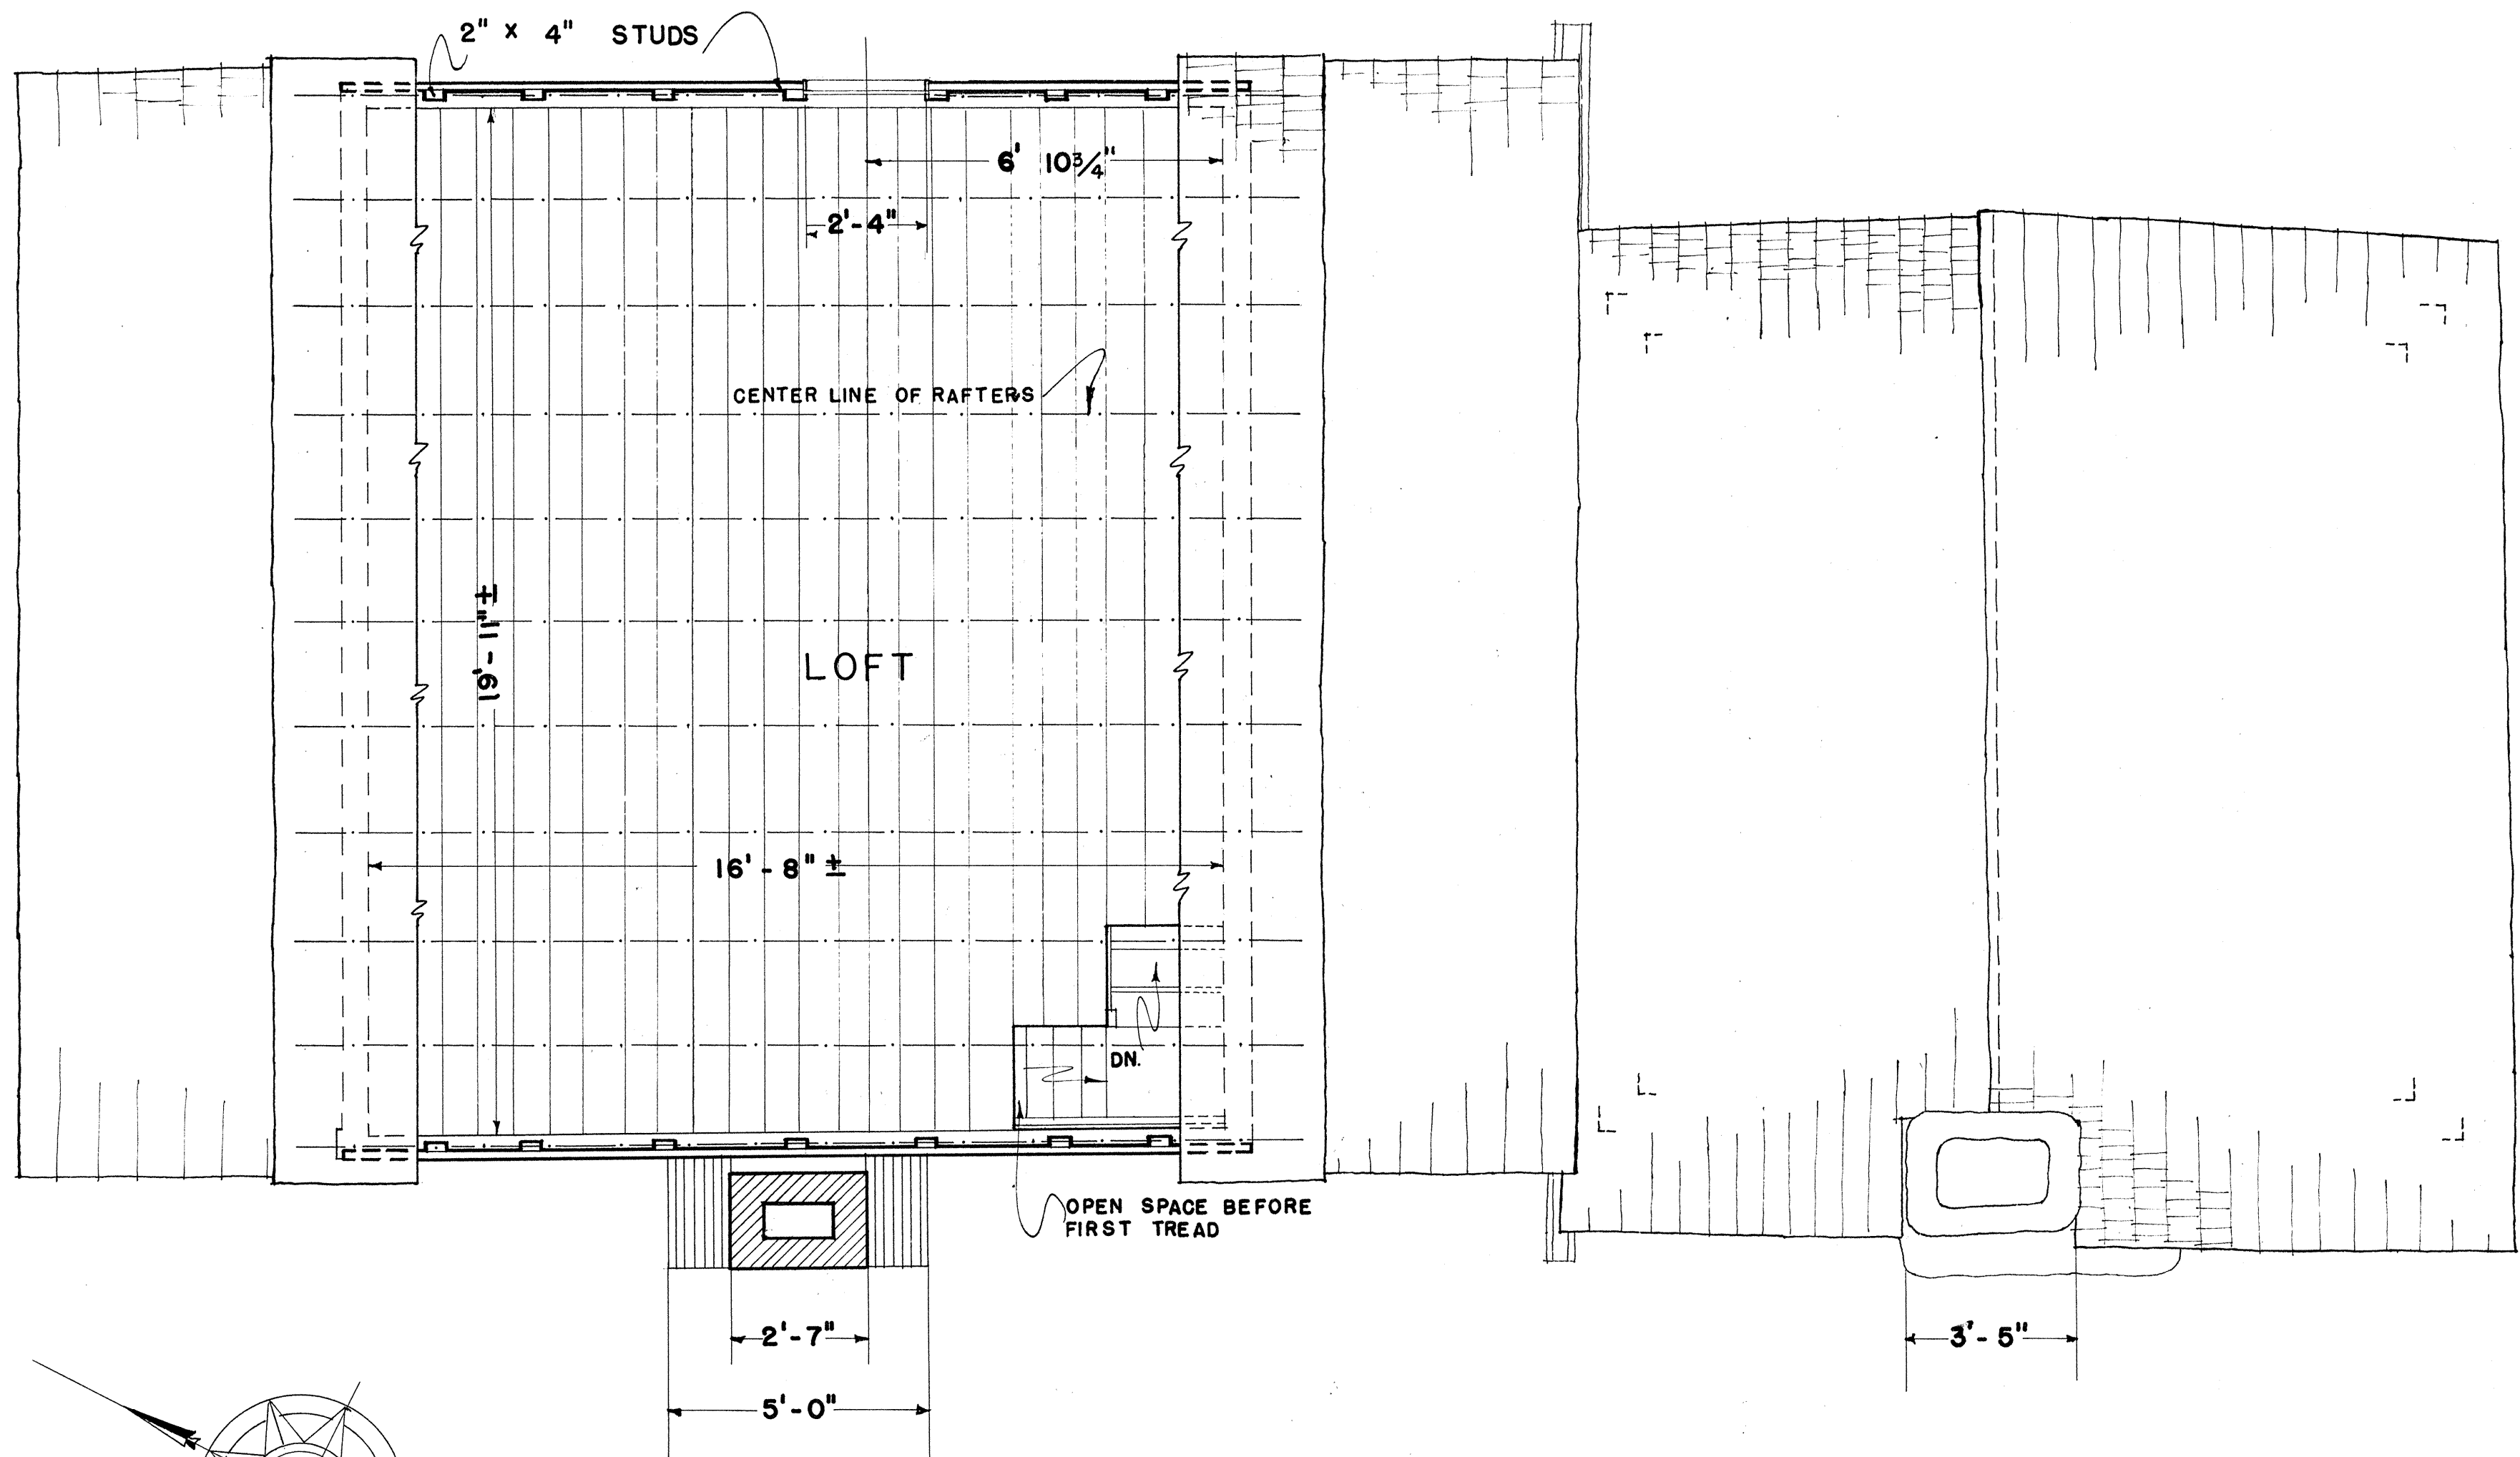

RICHARD LUNDY - DEL. 1957

PHILADELPHIA EASTERN OFFICE
DIVISION OF DESIGN AND CONSTRUCTION
UNDER DIRECTION OF UNITED STATES DEPARTMENT OF THE INTERIOR
NATIONAL PARK SERVICE, BRANCH OF PLANS AND DESIGN

NAME OF STRUCTURE
THE HENRY WHITEHEAD PLACE
CADES COVE - GREAT SMOKY MOUNTAINS NATIONAL PARK - BLOUNT COUNTY - TENNESSEE

SURVEY NO.
TENN
161


HISTORIC AMERICAN
BUILDINGS SURVEY
SHEET 3 OF 11 SHEETS

LIBRARY OF CONGRESS
INDEX NUMBER


ROOF: RIVED OAK SHAKES LAID SHINGLE STYLE.
BOARD CHINKING ON OLD CABIN REPLACED 1937.

NOTE: PORCH CUT AWAY TO SHOW OLD CABIN IN ELEVATION.


GUTTER: HEWN LOG - REPLACED 1948 BY NPS.

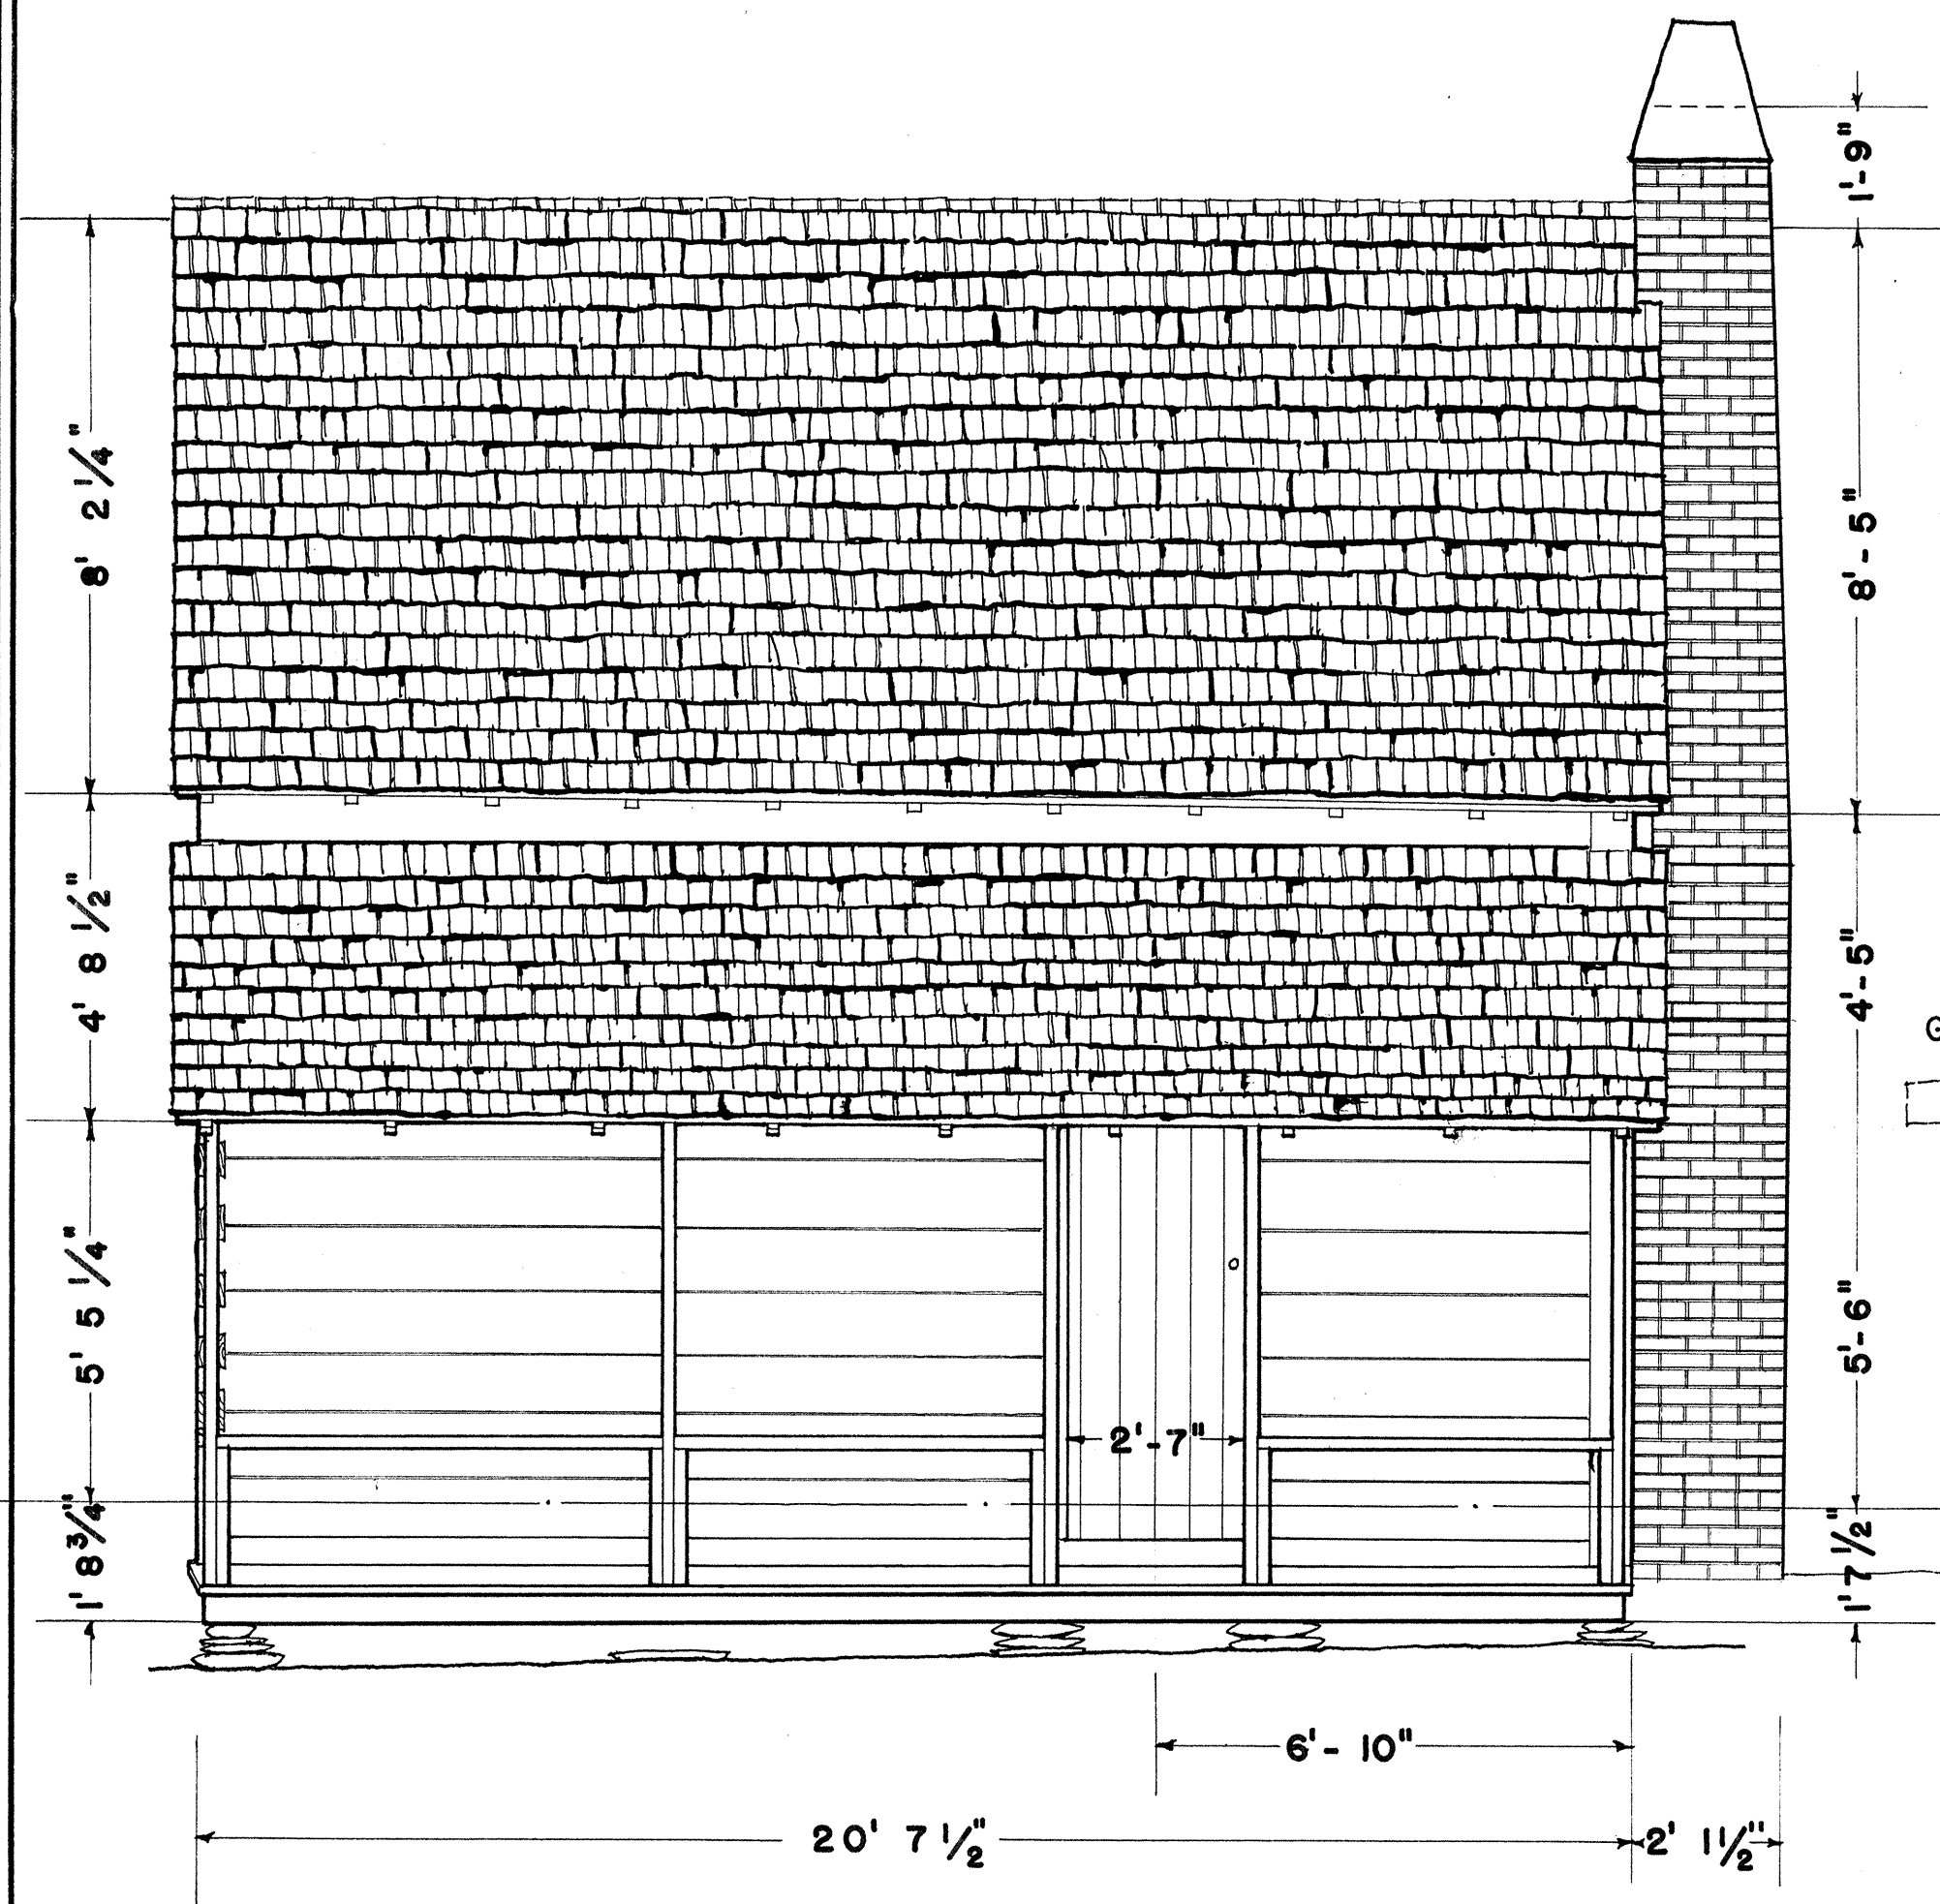

NORTHWEST ELEVATION - NEW CABIN
SCALE $\frac{3}{8}$ " = 1'-0"

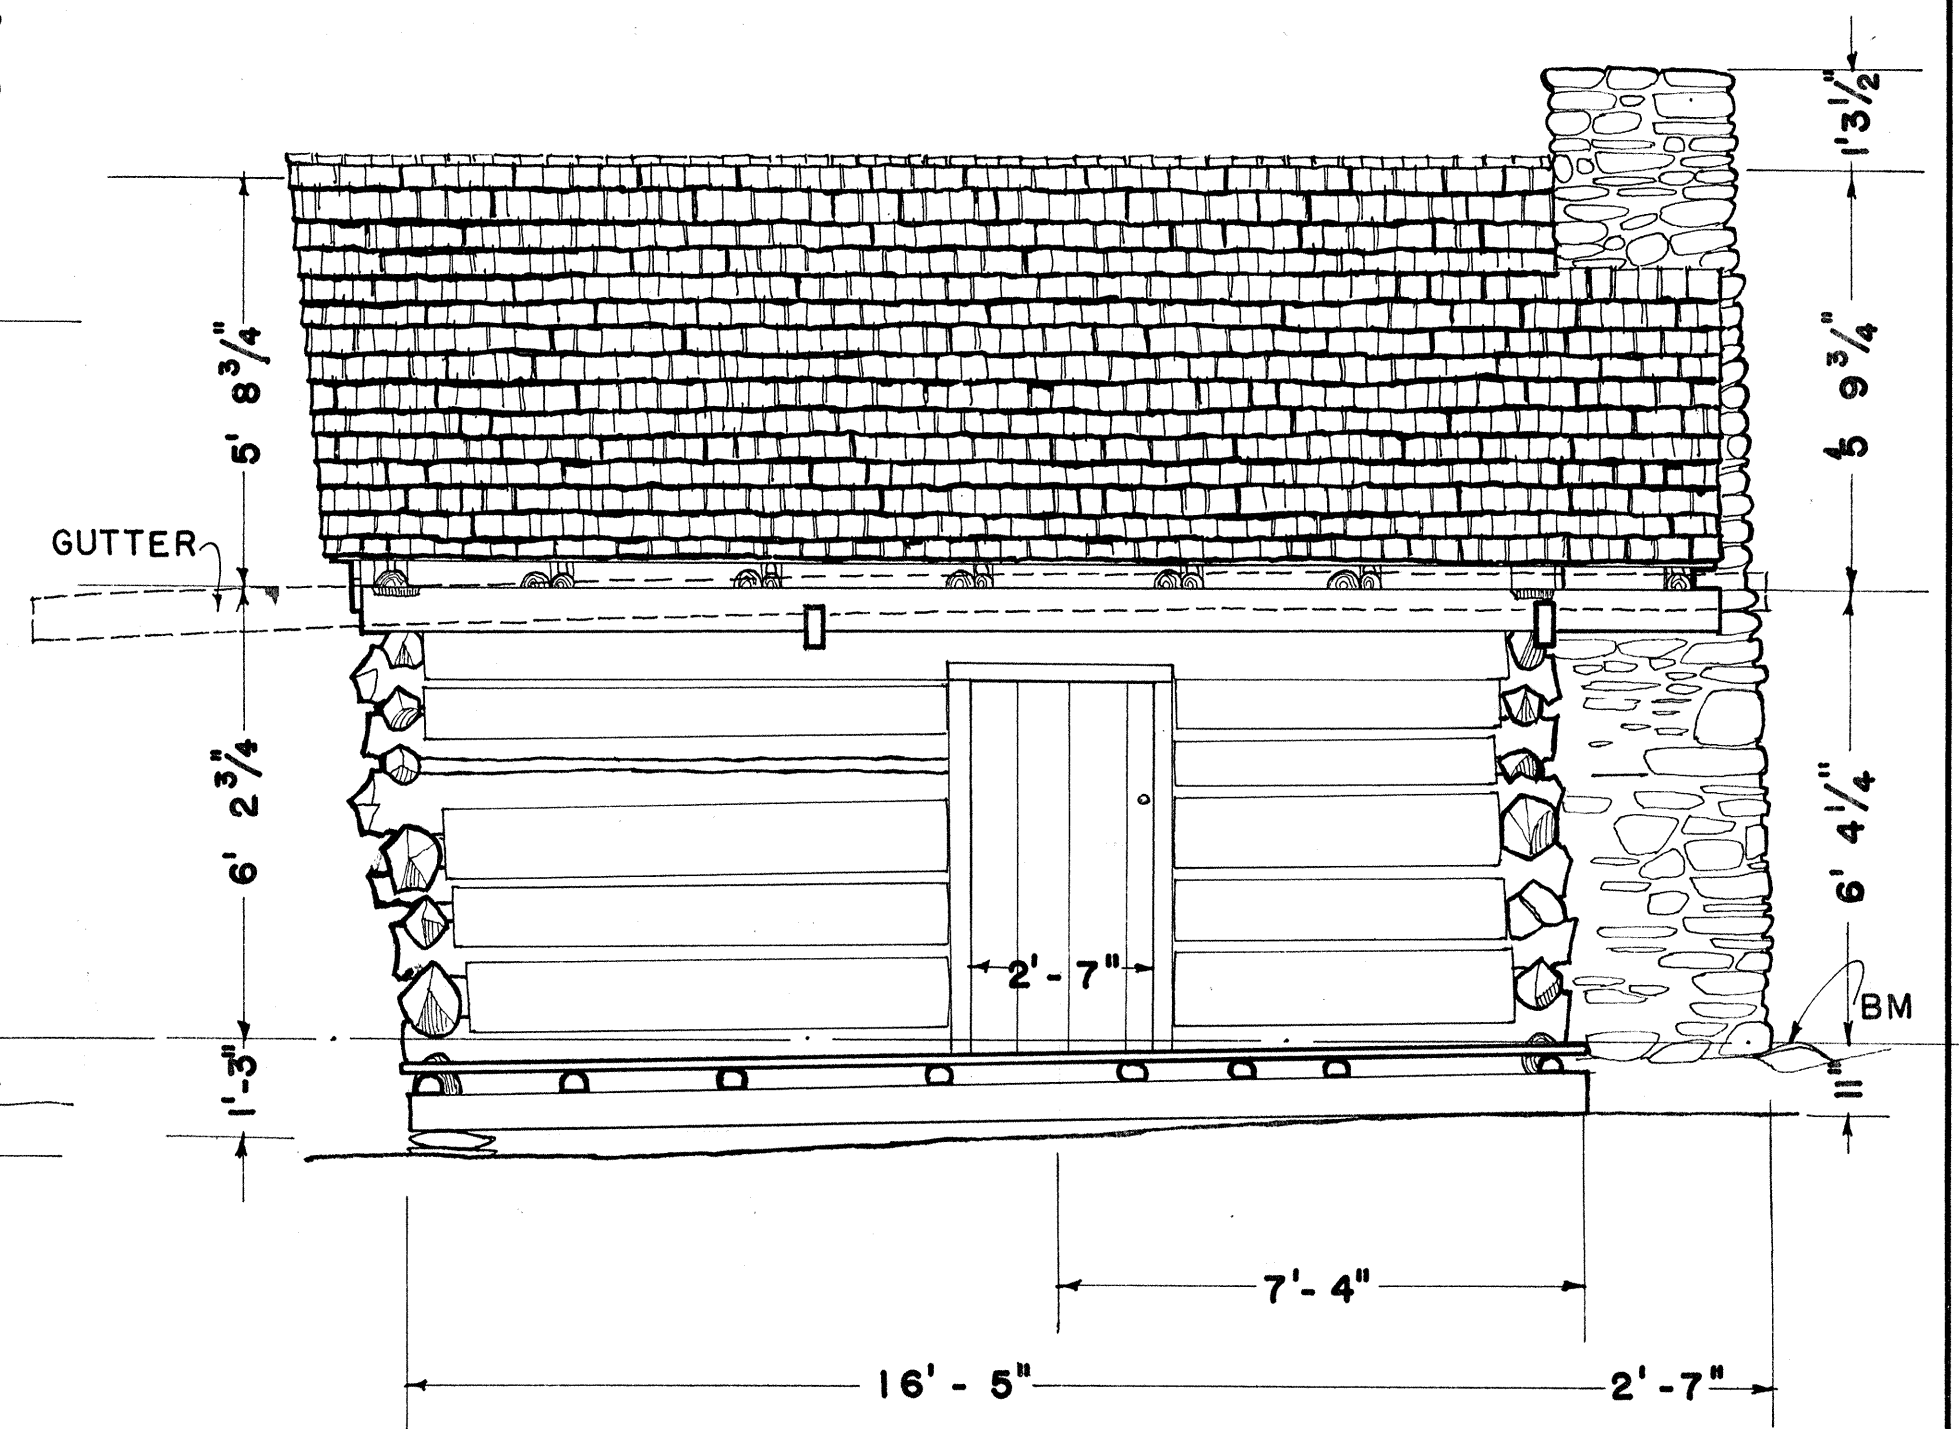

NORTHWEST ELEVATION - OLD CABIN
SCALE $\frac{3}{8}$ " = 1'-0"

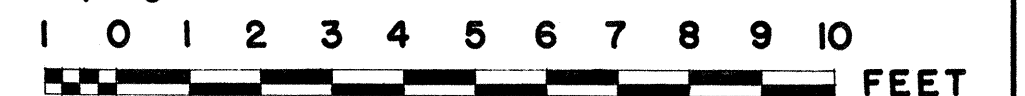

RICHARD LUNDY - DEL. 1957

PHILADELPHIA - EASTERN OFFICE
DIVISION OF DESIGN AND CONSTRUCTION
UNDER DIRECTION OF UNITED STATES DEPARTMENT OF THE INTERIOR
NATIONAL PARK SERVICE, BRANCH OF PLANS AND DESIGN

NAME OF STRUCTURE
THE HENRY WHITEHEAD PLACE
CADES COVE - GREAT SMOKY MOUNTAINS NATIONAL PARK - BLOUNT COUNTY - TENNESSEE

SURVEY NO.
TENN
161

HISTORIC AMERICAN
BUILDINGS SURVEY
SHEET 4 OF 11 SHEETS


LIBRARY OF CONGRESS
INDEX NUMBER

BRICK CHIMNEY: HAND MOLDED BRICK
FIRED ON THE PLACE - THE BRICK
DIMENSIONS ARE: $2\frac{3}{8}$ " TO $2\frac{5}{8}$ "
HIGH, $6\frac{5}{8}$ " TO $7\frac{1}{2}$ " LONG, 3" TO
 $3\frac{3}{4}$ " THICK. LAID IN COMMON BOND
WITH OCCASIONAL HEADER COURSES
FLUSH JOINTS - CLAY MORTAR.

GLASS REPLACED IN WINDOWS 1937.

PINE AND POPLAR WEATHERBOARD.

STONE CHIMNEY:
FIELD STONE LAID
IN CLAY MORTAR.

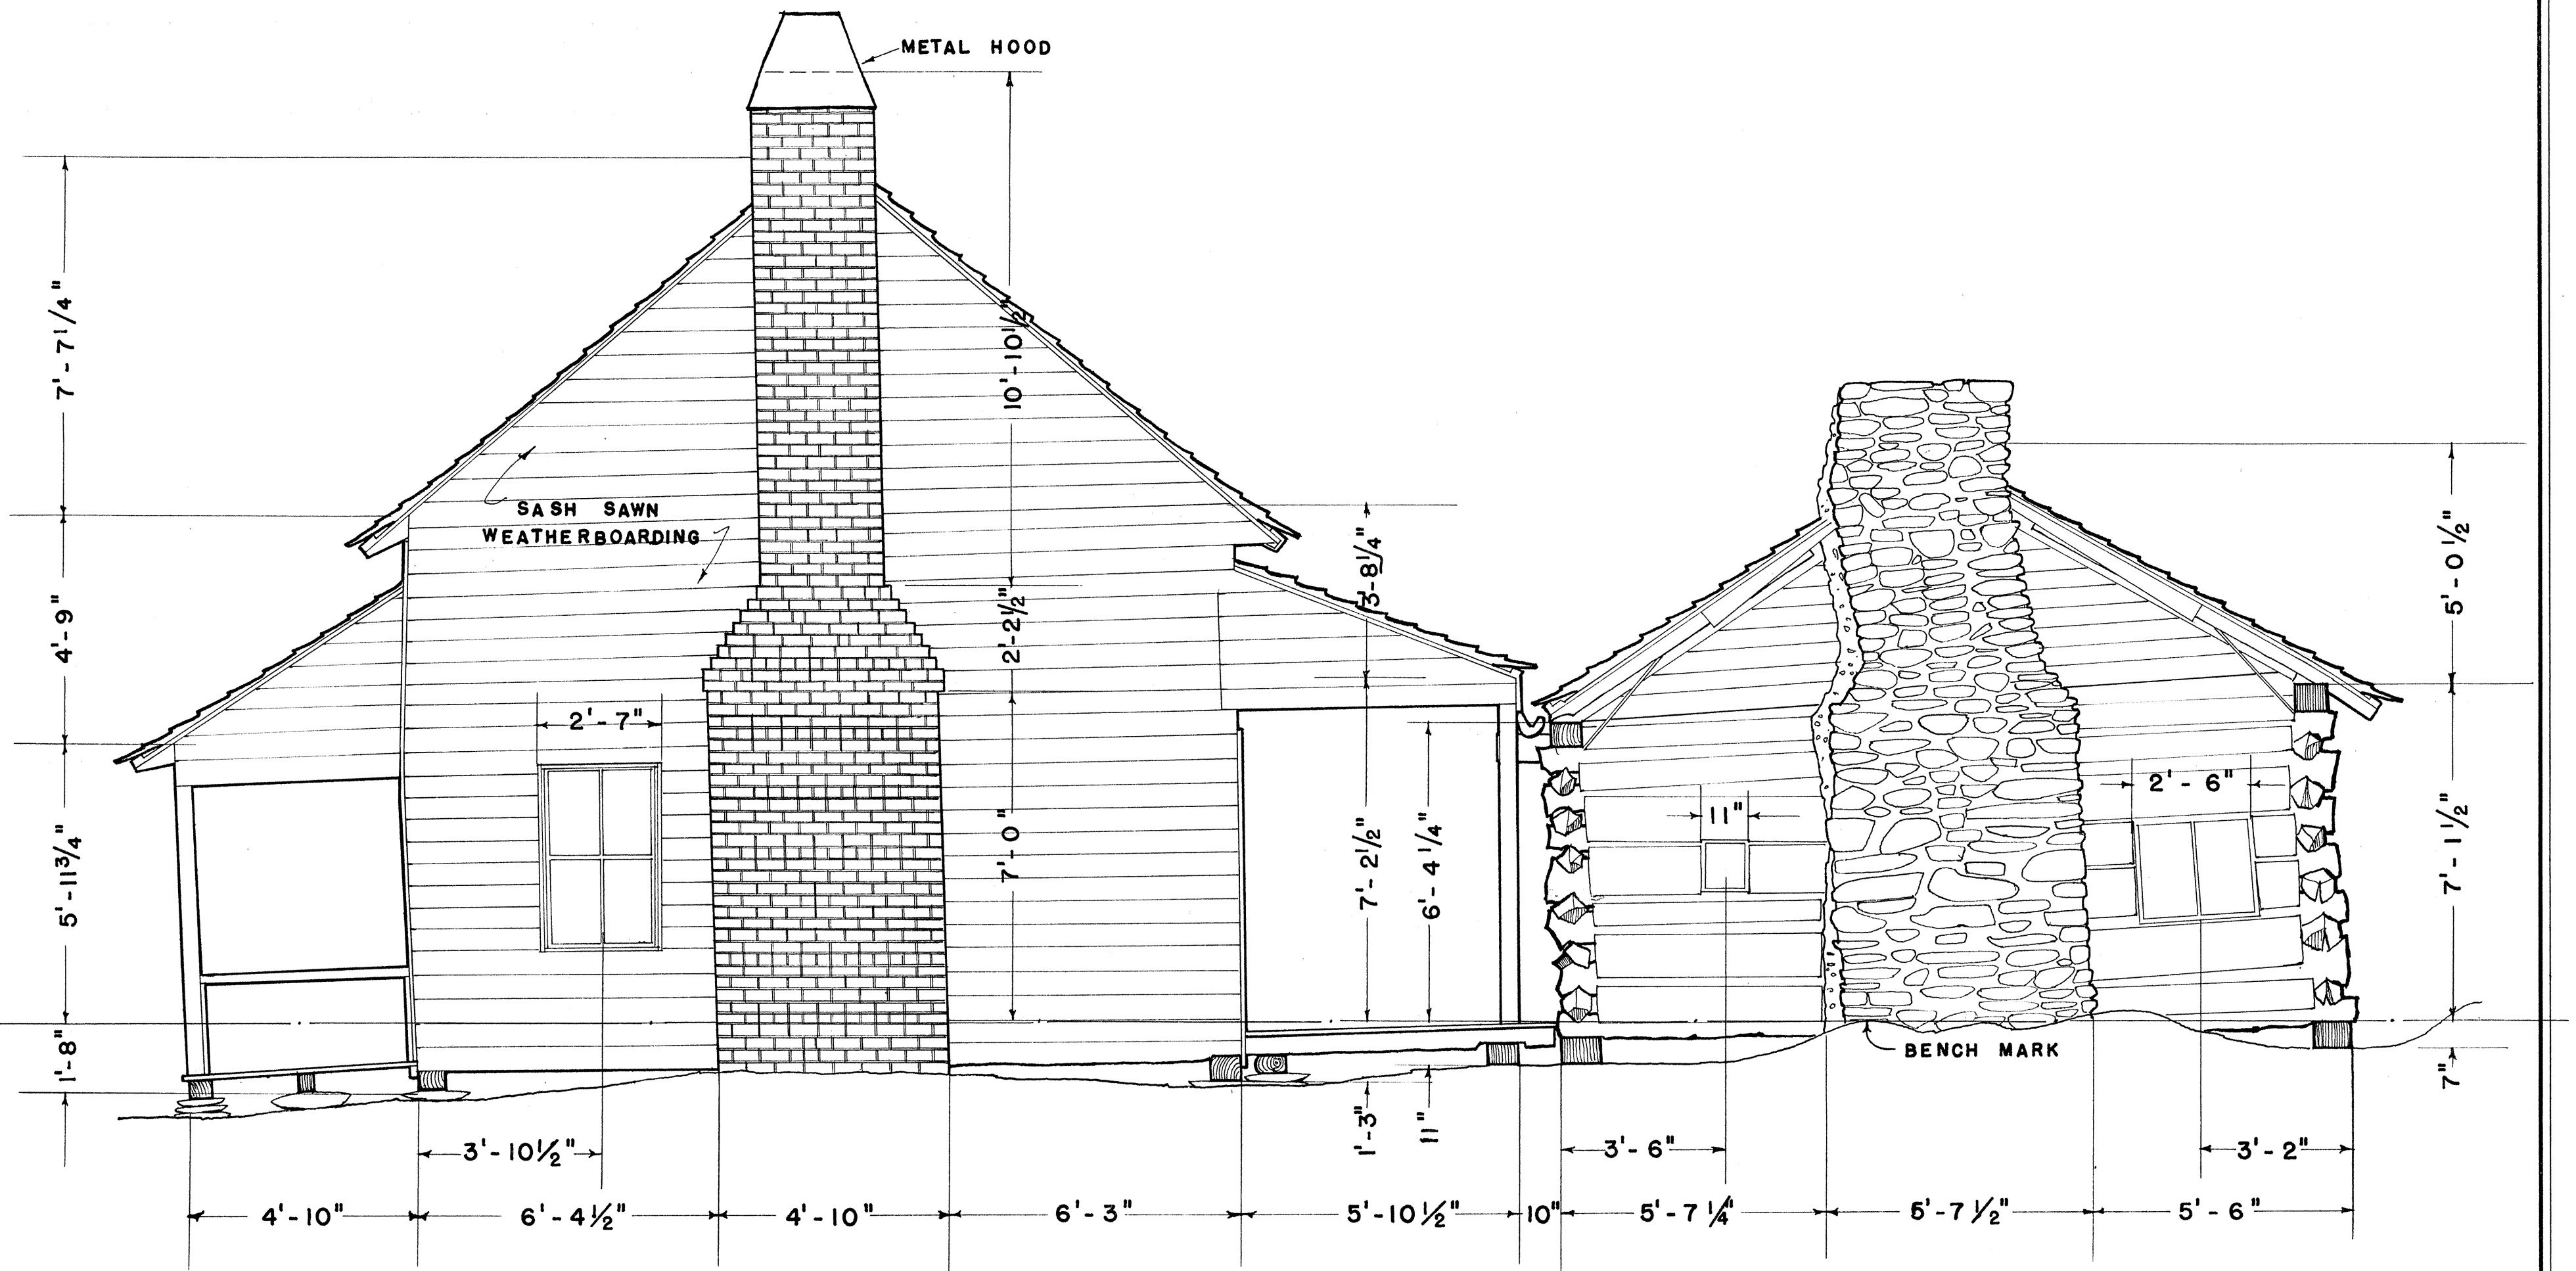

SOUTHWEST ELEVATION

SCALE: $\frac{3}{8}$ " = 1'-0"

1 0 1 2 3 4 5 6 7 8 9 10
FEET

1 0 1 2 3 4 5
METERS

RICHARD LUNDY - DEL. 1957

PHILADELPHIA - EASTERN OFFICE
DIVISION OF DESIGN AND CONSTRUCTION
UNDER DIRECTION OF UNITED STATES DEPARTMENT OF THE INTERIOR
NATIONAL PARK SERVICE, BRANCH OF PLANS AND DESIGN

NAME OF STRUCTURE
THE HENRY WHITEHEAD PLACE
CADES COVE - GREAT SMOKY MOUNTAINS NATIONAL PARK - BLOUNT COUNTY - TENNESSEE

SURVEY NO.
TENN
161

HISTORIC AMERICAN
BUILDINGS SURVEY
SHEET 5 OF 11 SHEETS

LIBRARY OF CONGRESS
INDEX NUMBER


NOTE: JOIST ARE SET IN THE TOP OF NOTCHES
AND BLOCKED IN PLACE WITH WOODEN
PLUGS FACED ON OUTSIDE WITH CLAY
MORTAR.

ROOFS ARE RIVED OAK BOARDS 24" ± LONG
AND LAID 8" TO WEATHER


ROOF COMBS REPLACED IN 1948 BY NPS.

A-A PEGS DRIVEN INTO LOG TO HOLD WARPING FRAME.


PORCH CUT AWAY TO SHOW ELEVATION OF NEW CABIN.

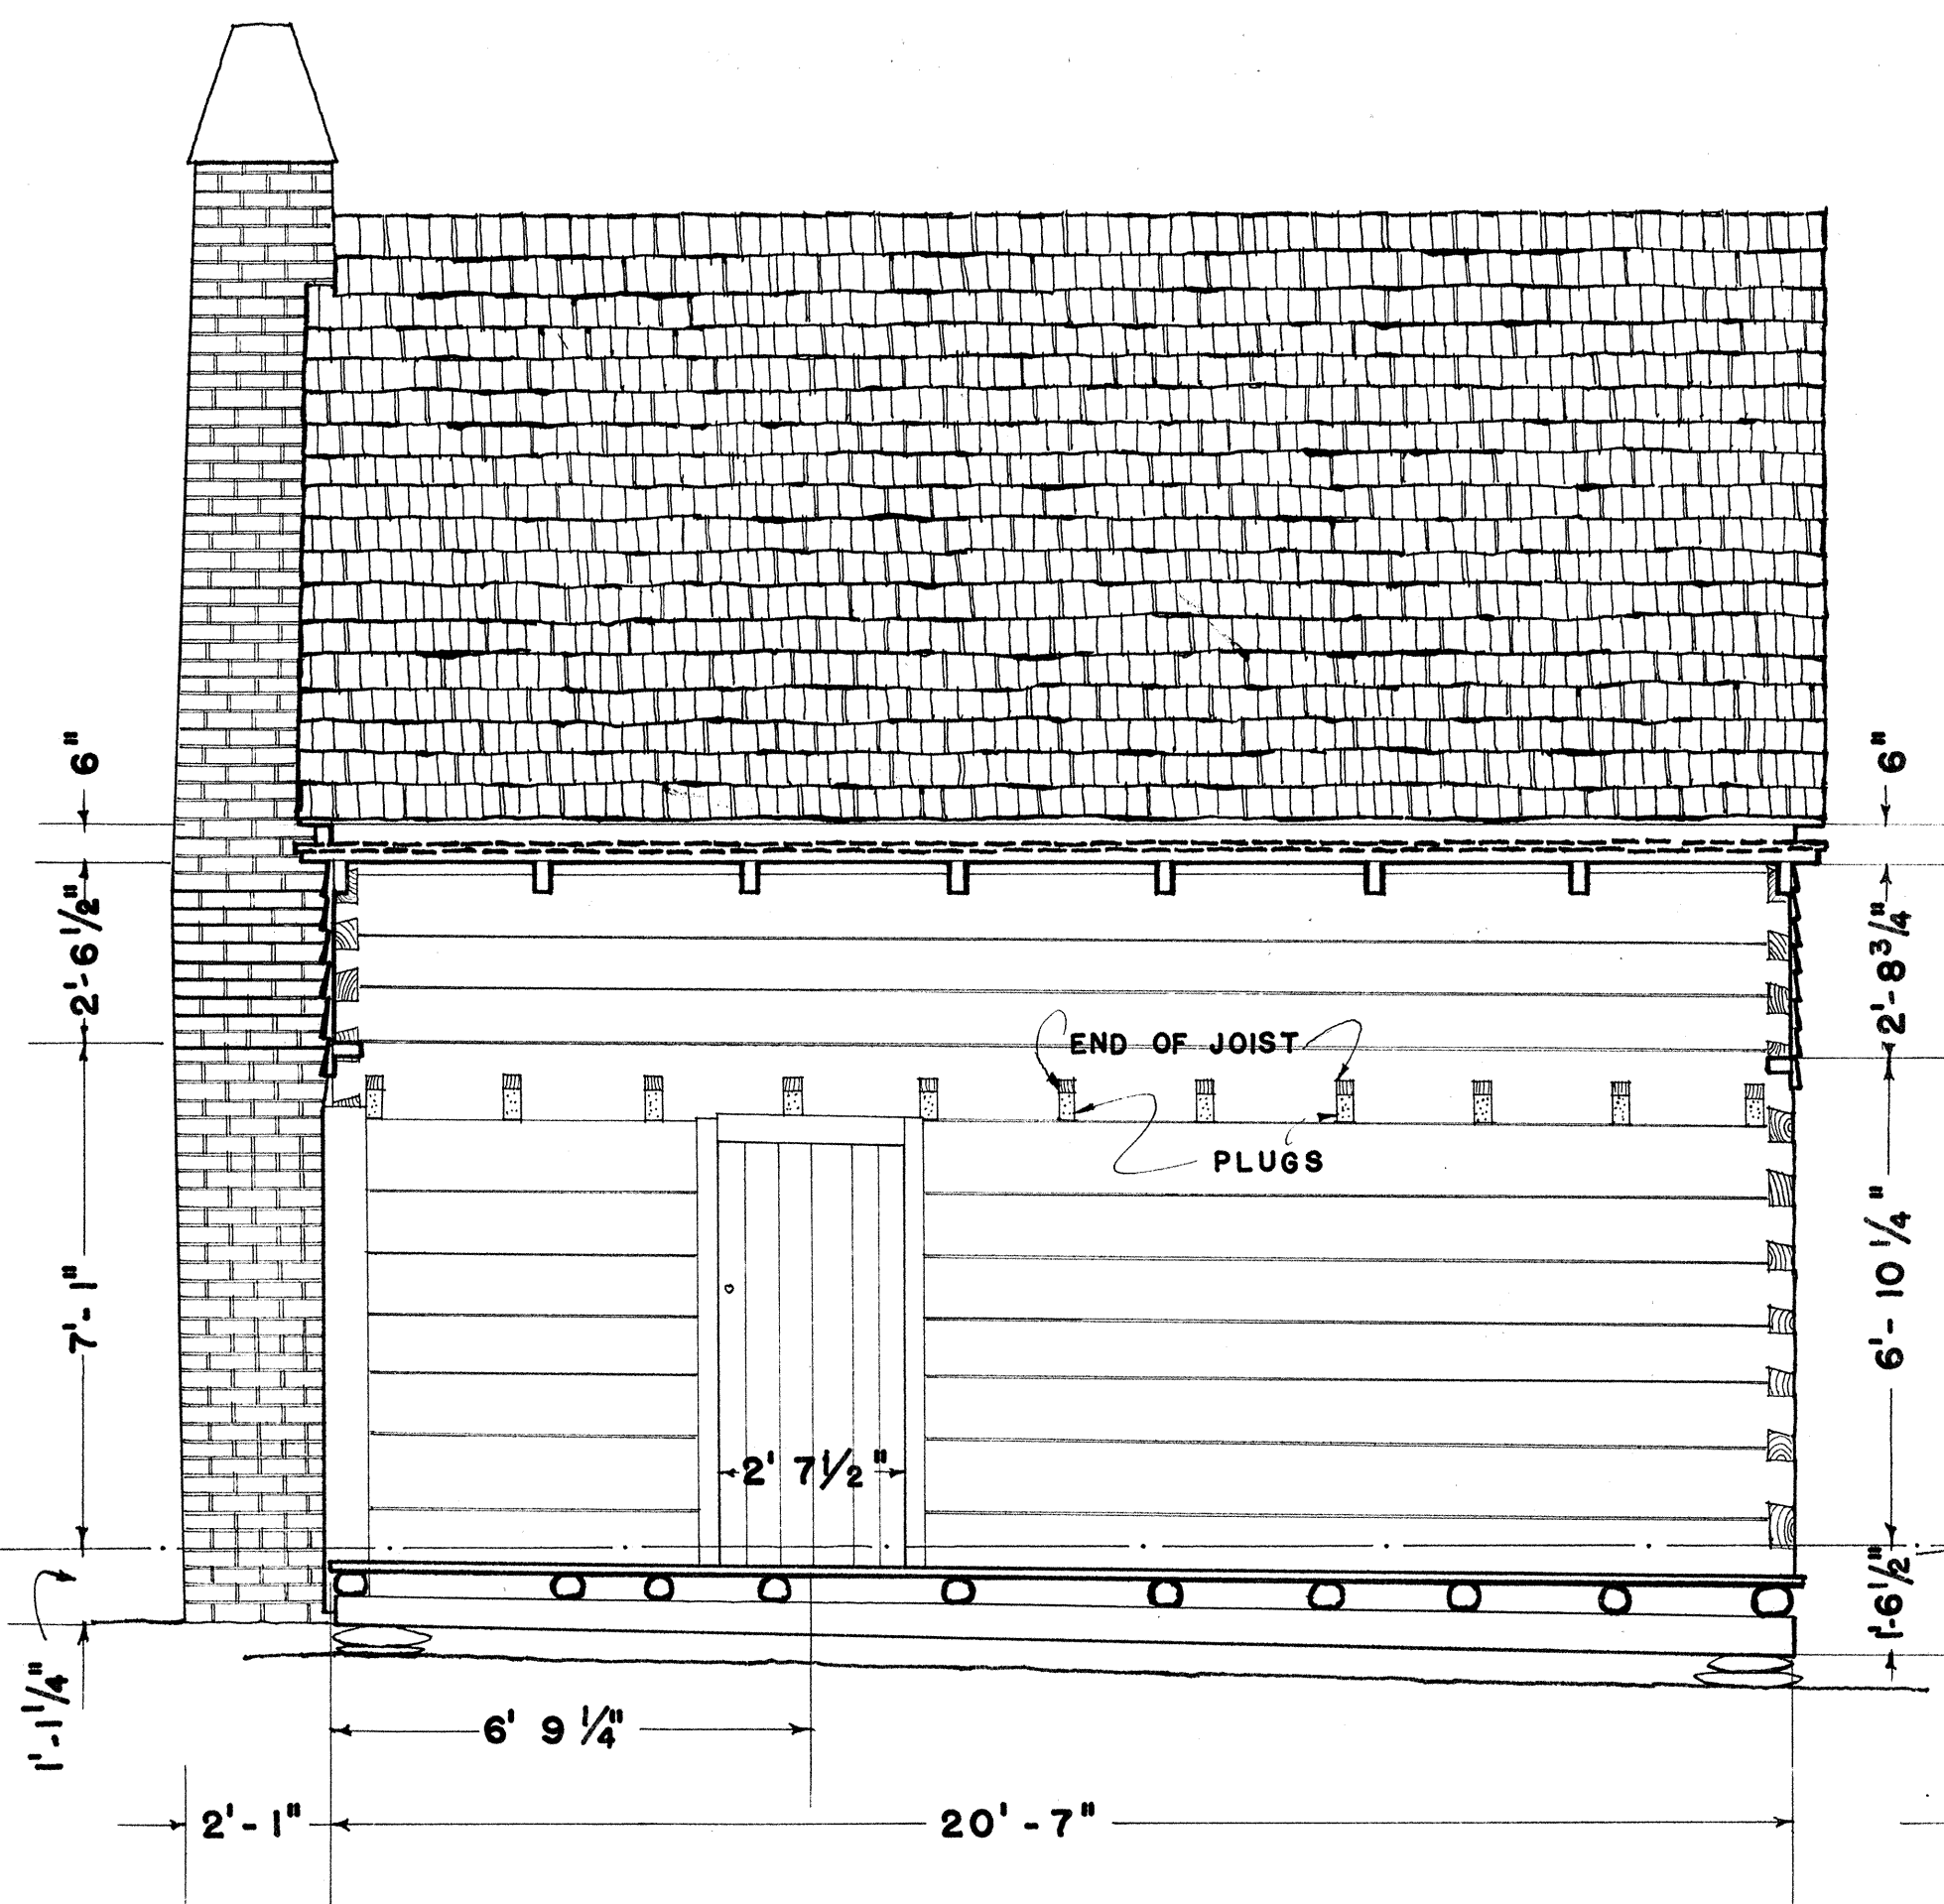

SOUTHEAST ELEVATION - NEW CABIN
SCALE $\frac{3}{8}" = 1'-0"$

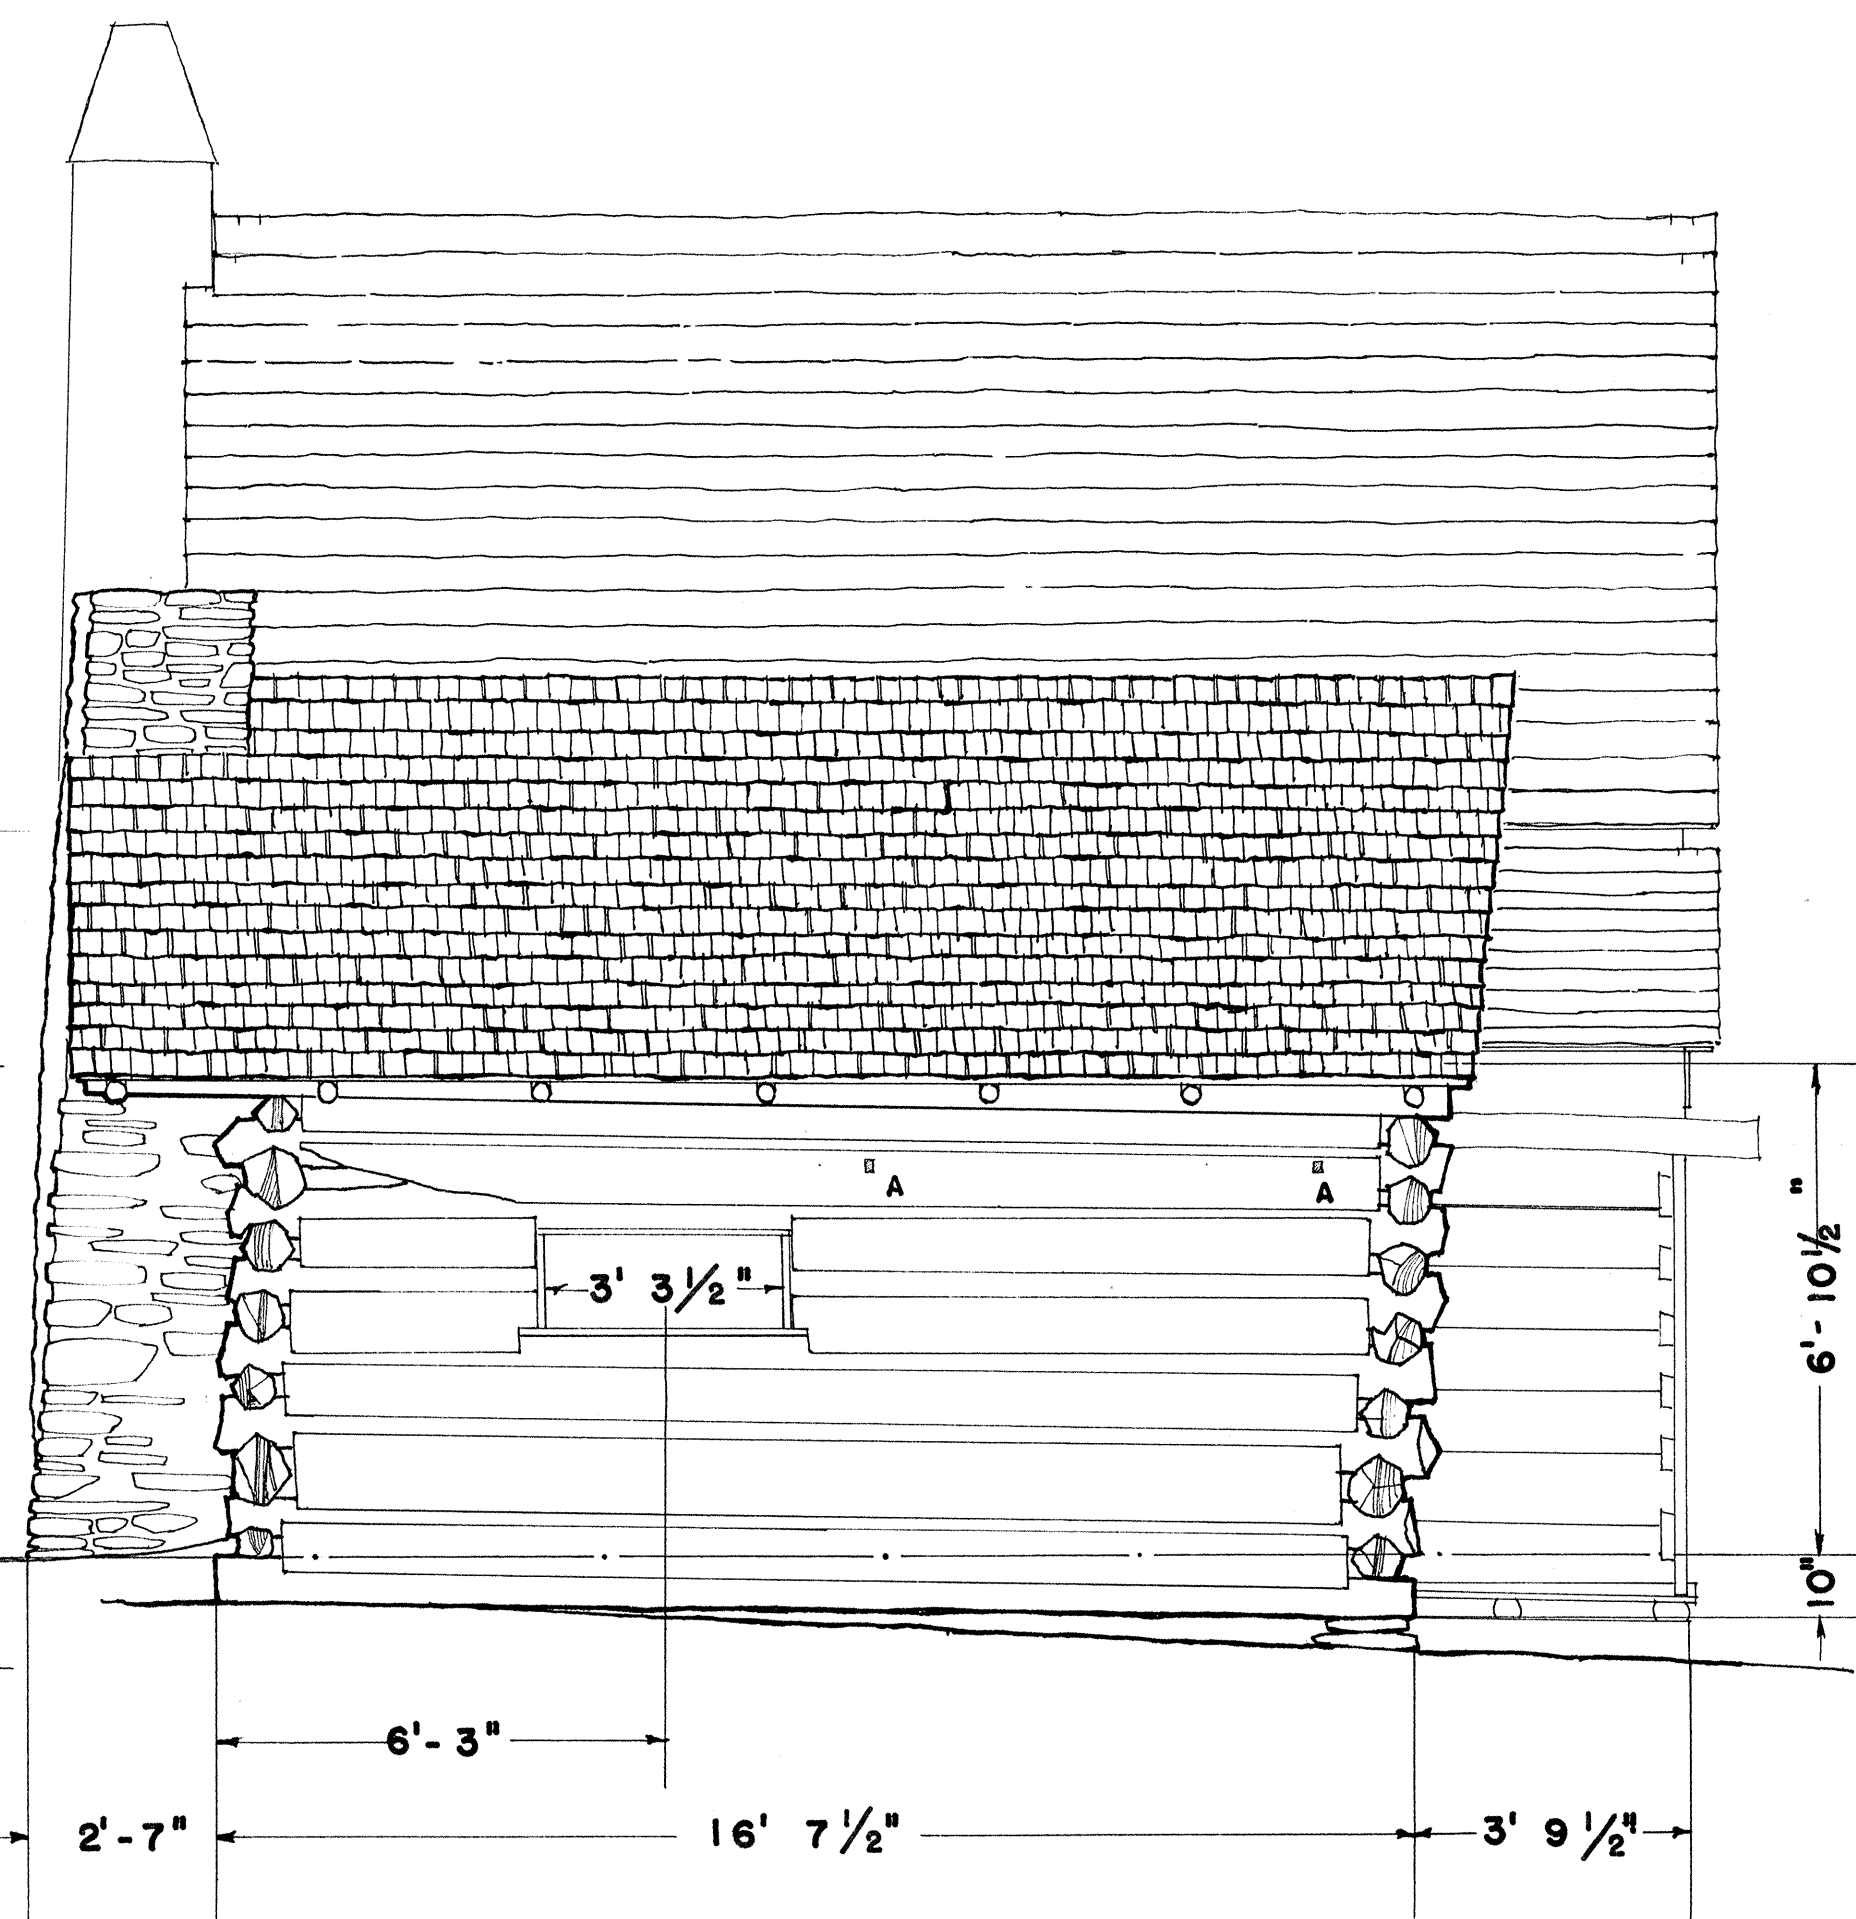

SOUTHEAST ELEVATION - OLD CABIN
SCALE $\frac{3}{8}" = 1'-0"$

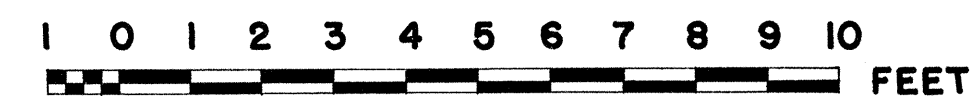

RICHARD LUNDY - DEL. 1957

PHILADELPHIA EASTERN OFFICE
DIVISION OF DESIGN AND CONSTRUCTION
UNDER DIRECTION OF UNITED STATES DEPARTMENT OF THE INTERIOR
NATIONAL PARK SERVICE, BRANCH OF PLANS AND DESIGN

NAME OF STRUCTURE
THE HENRY WHITEHEAD PLACE
CADES COVE - GREAT SMOKY MOUNTAINS NATIONAL PARK - BLOUNT COUNTY - TENNESSEE


SURVEY NO.
TENN
161

HISTORIC AMERICAN
BUILDINGS SURVEY
SHEET 6 OF 11 SHEETS

LIBRARY OF CONGRESS
INDEX NUMBER


GABLE ENDS — SASH SAWN CLAPBOARDS

JOINTS BETWEEN LOGS GENERALLY TIGHT, WHERE THERE IS A SPACE IT IS FILLED WITH BOARDS, AND COVERED ON THE OUTSIDE WITH MUD MORTAR.

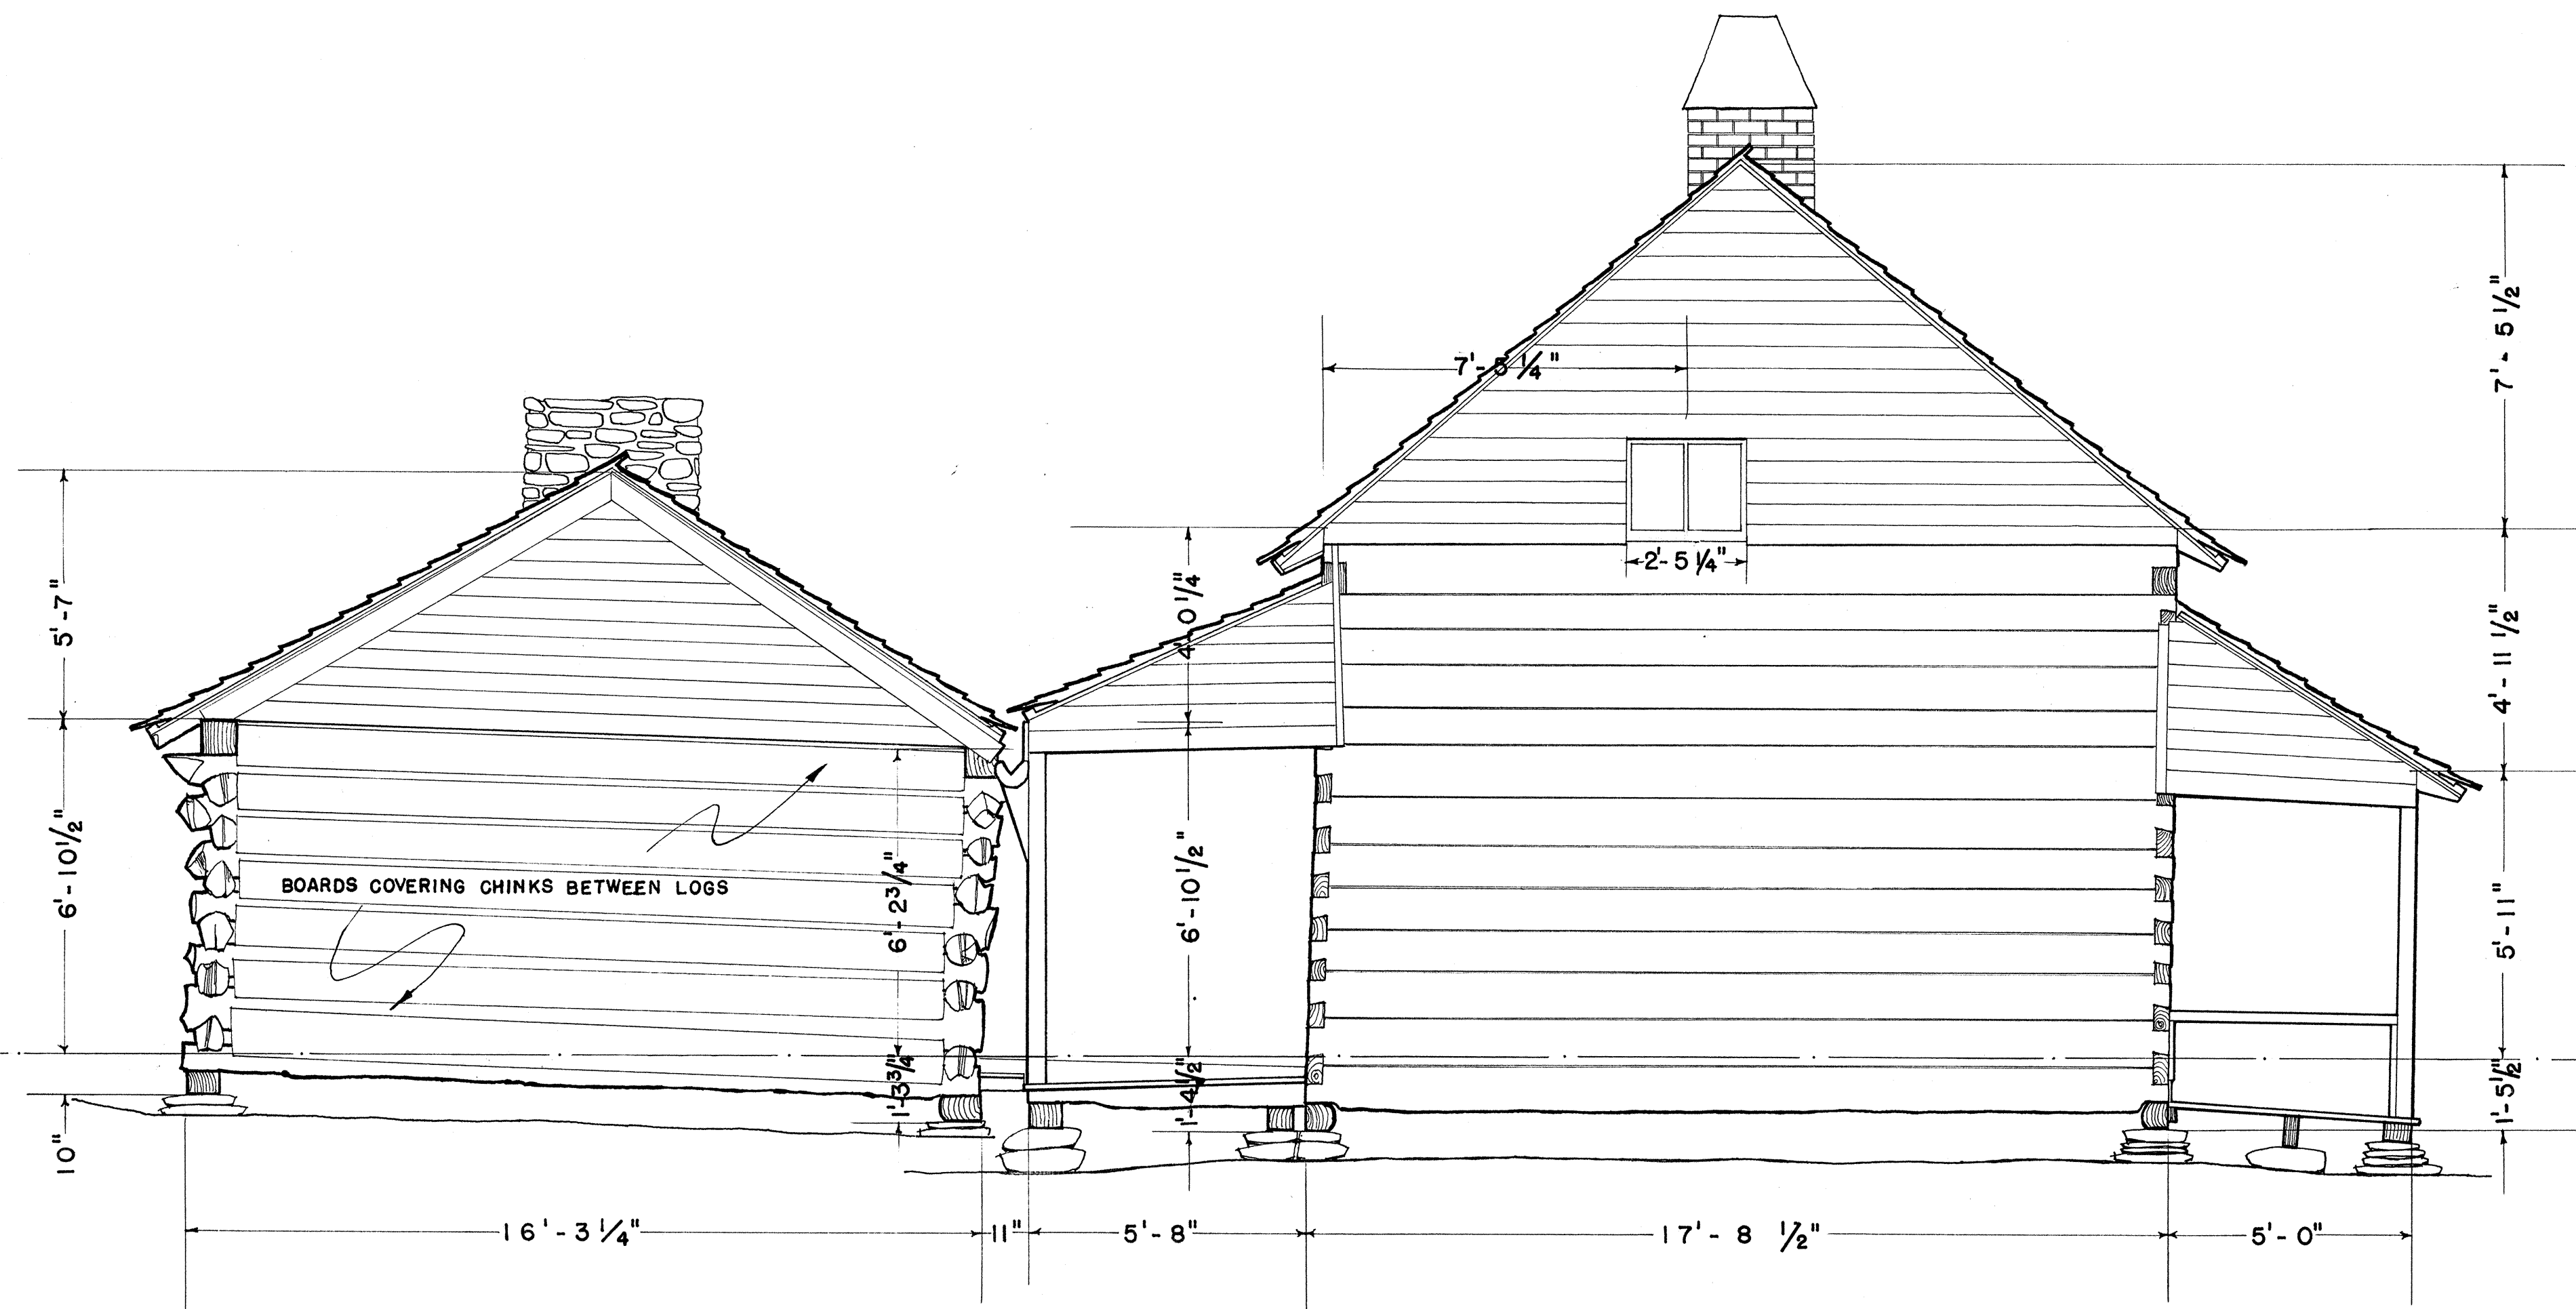

NORTHEAST ELEVATION

SCALE: $\frac{3}{8}$ " = 1'-0"

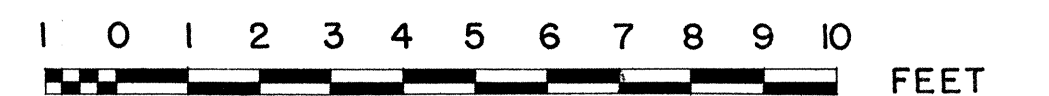

RICHARD LUNDY — DEL. 1957

PHILADELPHIA — EASTERN OFFICE
DIVISION OF DESIGN AND CONSTRUCTION
UNDER DIRECTION OF UNITED STATES DEPARTMENT OF THE INTERIOR
NATIONAL PARK SERVICE, BRANCH OF PLANS AND DESIGN

NAME OF STRUCTURE
THE HENRY WHITEHEAD PLACE
CADES COVE — GREAT SMOKY MOUNTAINS NATIONAL PARK — BLOUNT COUNTY — TENNESSEE


SURVEY NO.
TENN
161

HISTORIC AMERICAN
BUILDINGS SURVEY
SHEET 7 OF 11 SHEETS

LIBRARY OF CONGRESS
INDEX NUMBER


57

RAFTERS, PINE, SASH SAWN 2" x 4"'s

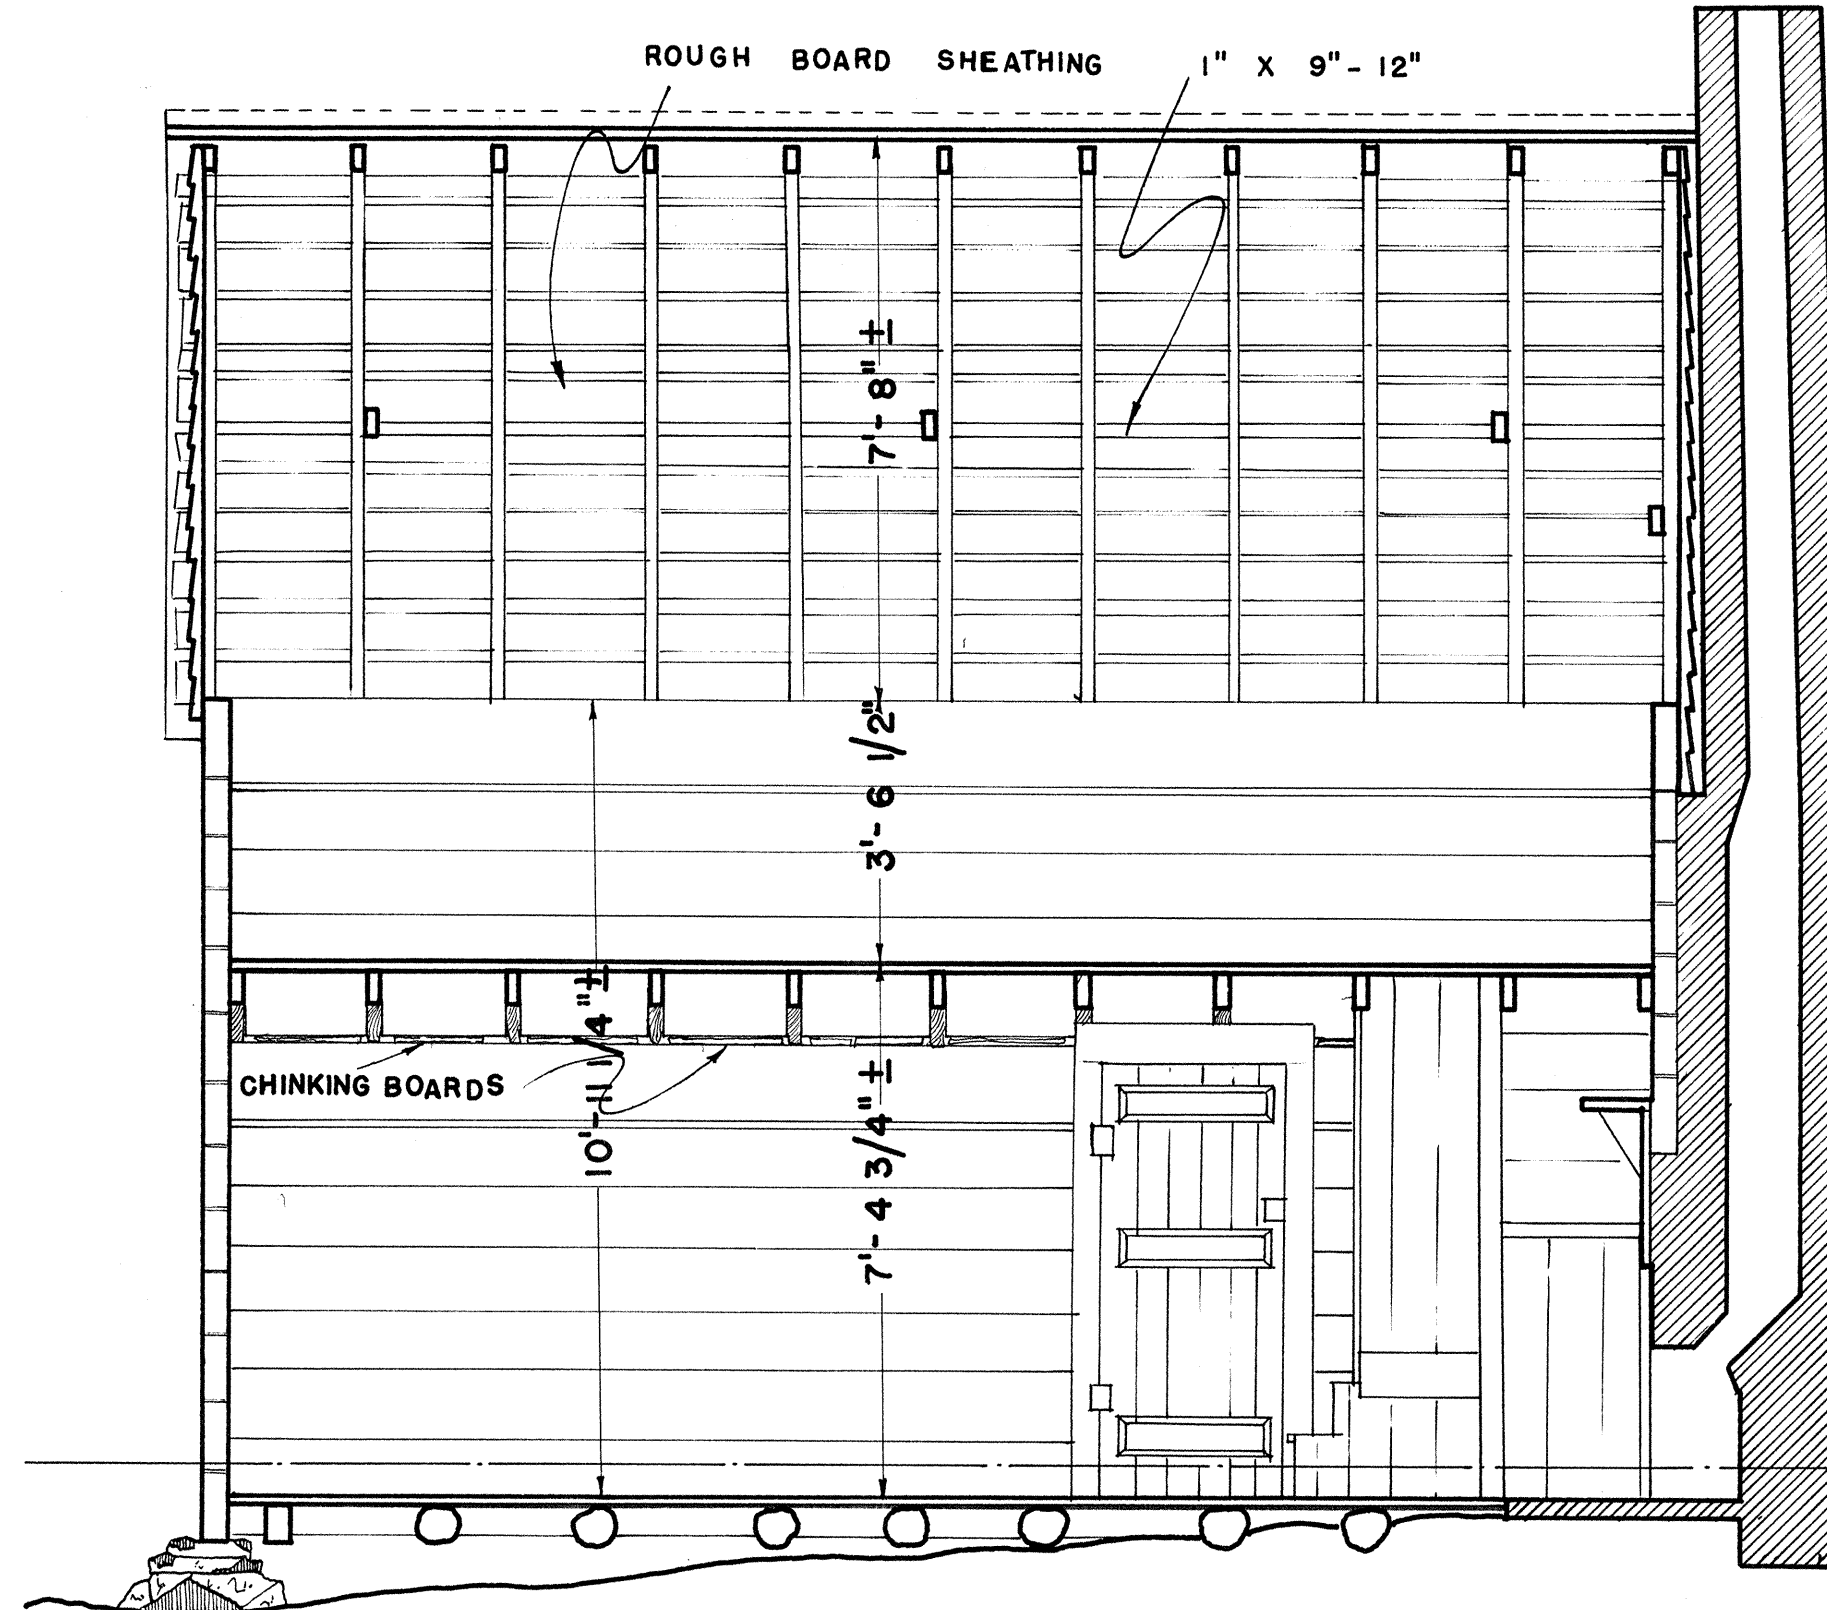

SECTION AA
SCALE: 3/8" = 1'-0"

RAFTERS, PINE, 3" TO 5" IN DIAMETER

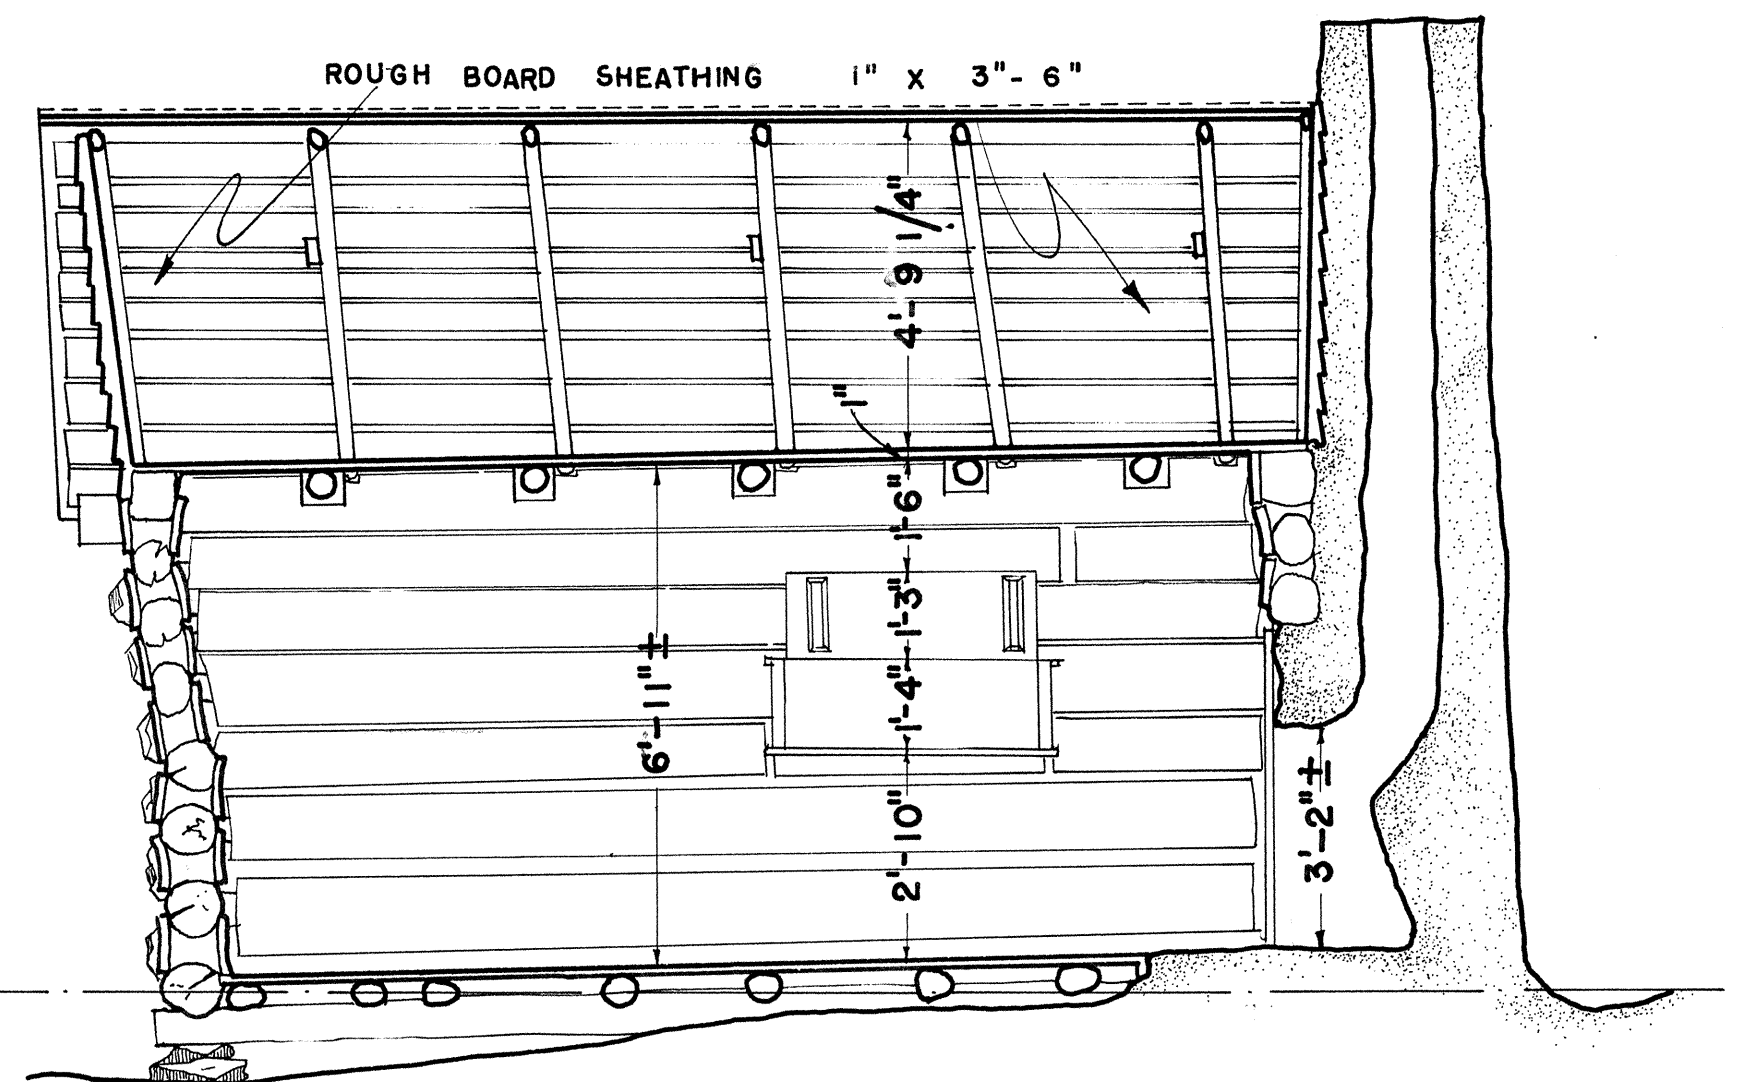

SECTION BB
SCALE: 3/8" = 1'-0"

1 0 1 2 3 4 5 6 7 8 9 10 FEET

1 0 1 2 3 4 5 METERS

SAMUEL E. HENRY — DEL. 1957

PHILADELPHIA EASTERN OFFICE
DIVISION OF DESIGN AND CONSTRUCTION
UNDER DIRECTION OF UNITED STATES DEPARTMENT OF THE INTERIOR
NATIONAL PARK SERVICE, BRANCH OF PLANS AND DESIGN

NAME OF STRUCTURE
THE HENRY WHITEHEAD PLACE
— CADES COVE — GREAT SMOKY MOUNTAINS NATIONAL PARK — TENNESSEE — BLOUNT COUNTY —

SURVEY NO.
TENN
161

HISTORIC AMERICAN
BUILDINGS SURVEY
SHEET 8 OF 11 SHEETS

LIBRARY OF CONGRESS
INDEX NUMBER

C - FIREPLACE LINTEL - 2 PIECES - IRON
FROM WAGON TIRE - $1\frac{3}{8}$ " WIDE.


A - WOODEN PINS BETWEEN LOGS ABOUT 1" DIAMETER.

T & G - MANTLEPIECE TONGUE AND GROOVE POPLAR
BOARDS. ONLY T & G BOARDS IN BUILDING.


B - FIREPLACE LINTEL - IRON - $5\frac{1}{8}$ " X $2\frac{3}{8}$ " X $34\frac{1}{2}$ ".

SMALL WINDOW TO RIGHT OF FIREPLACE ORIGINALLY
AN UNGLAZED OPENING KNOWN AS A "GRANNY HOLE".

TOP SHINGLES ON PORCH ROOF ARE
INSERTED INTO CHINK BETWEEN LOGS.

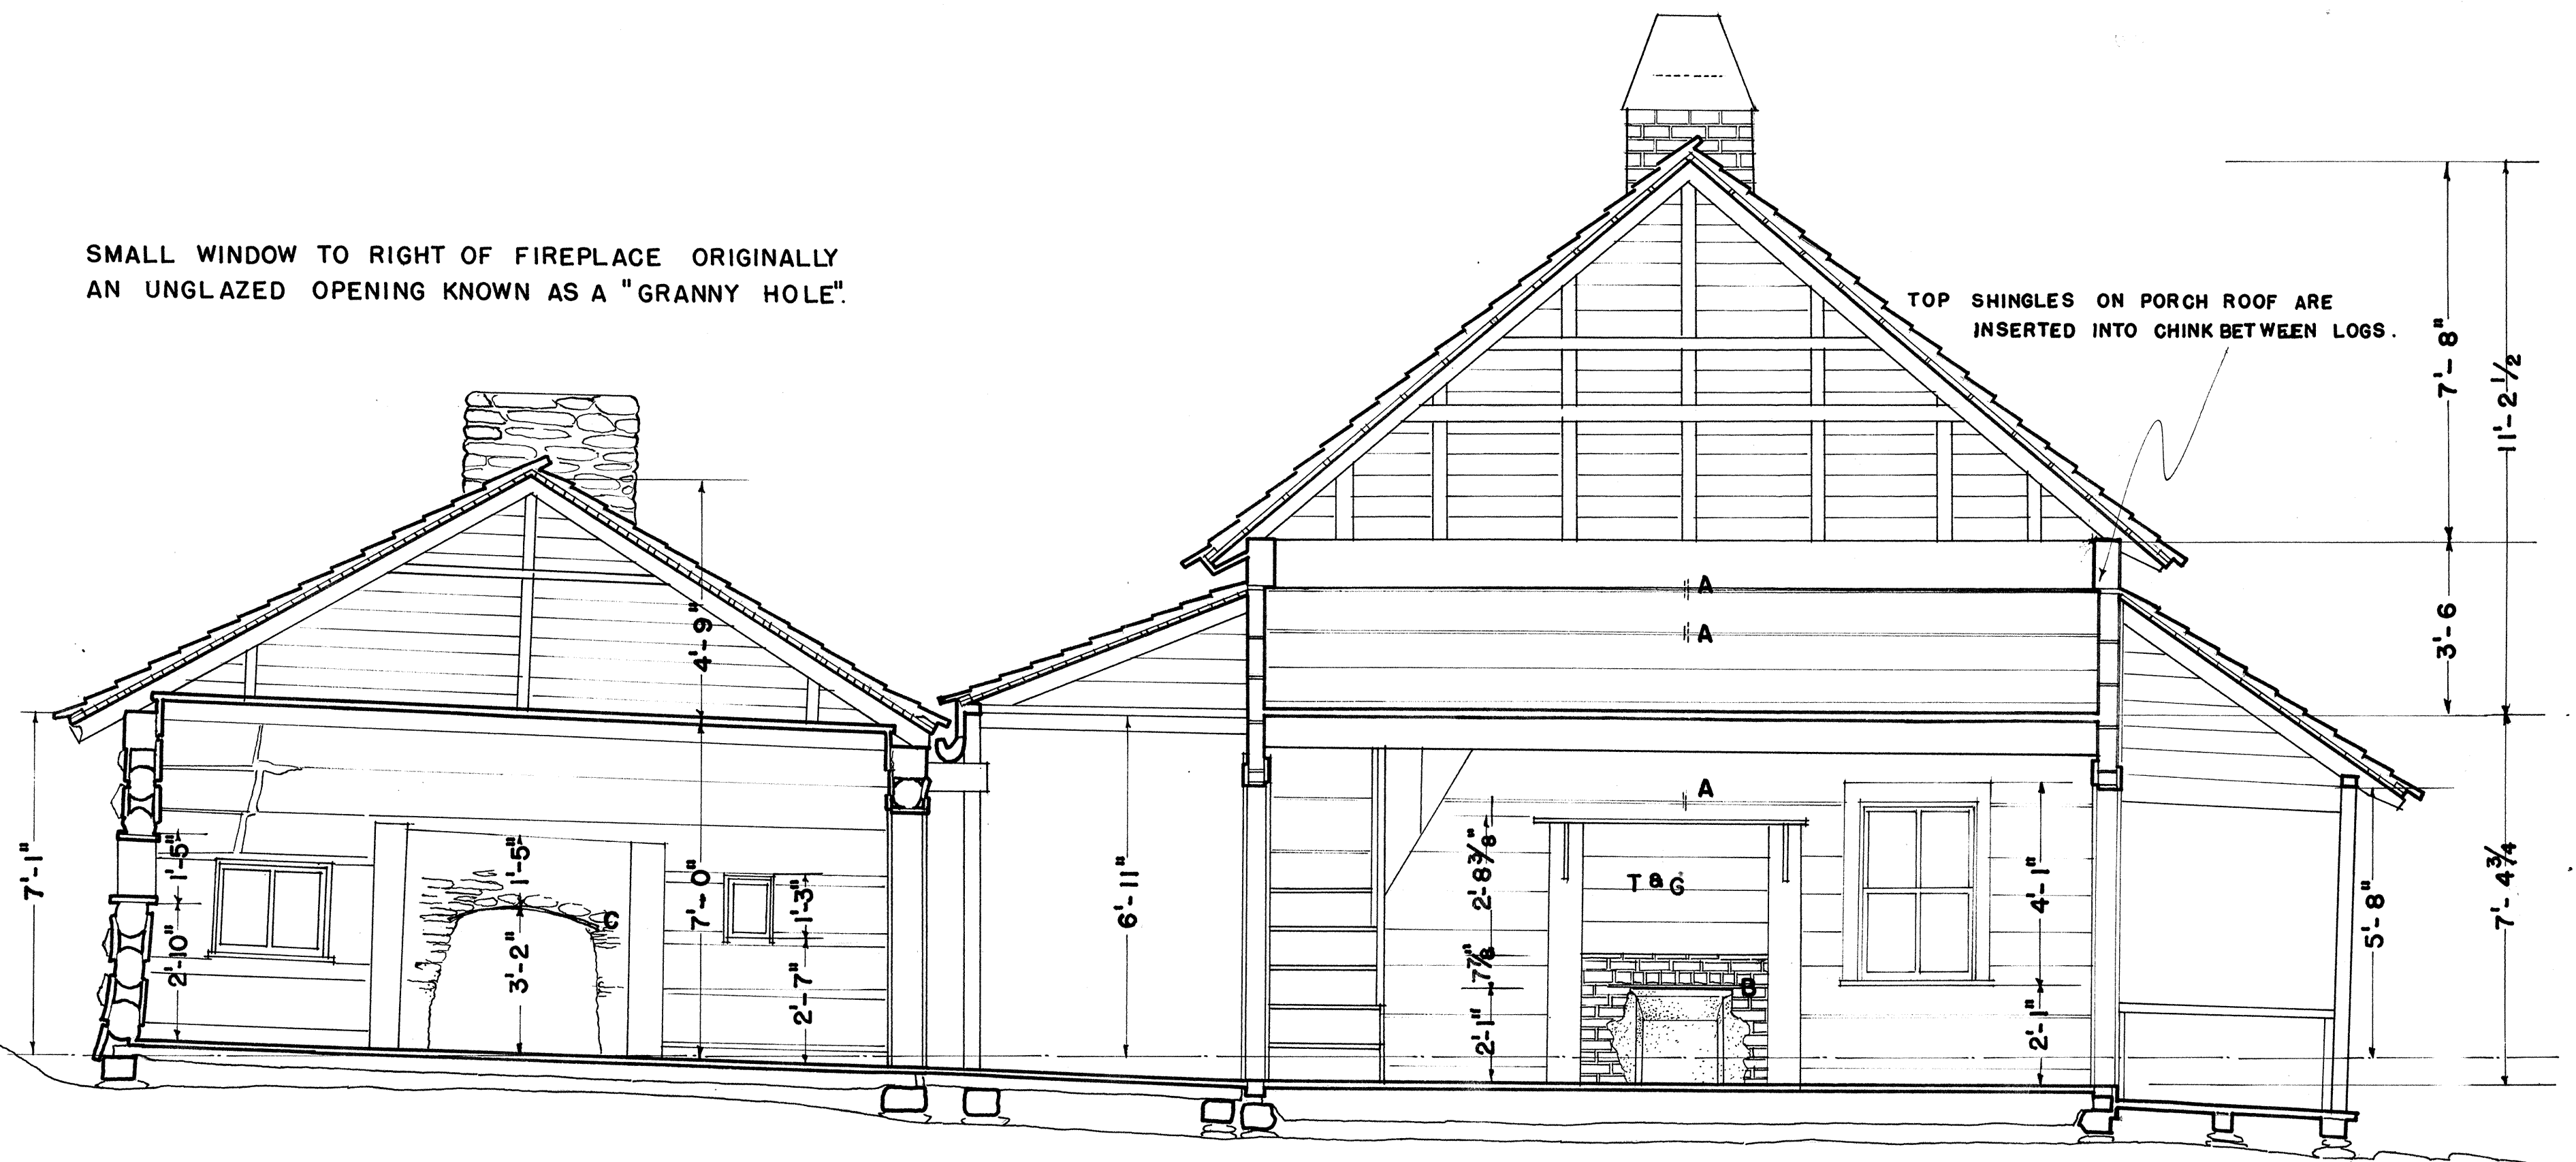

SECTION C-C
SCALE: $\frac{3}{8}$ " = 1'-0"

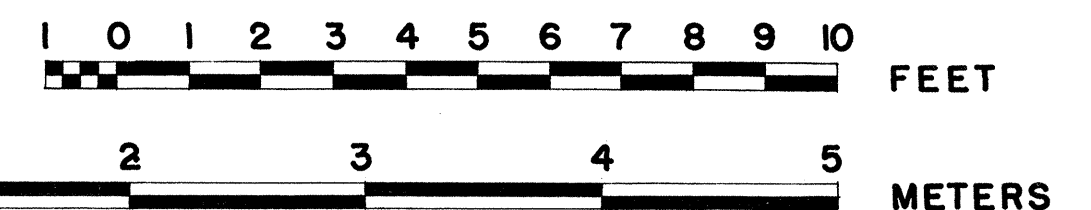

M.D. ROSS - DEL. 1957

PHILADELPHIA EASTERN OFFICE
DIVISION OF DESIGN AND CONSTRUCTION
UNDER DIRECTION OF UNITED STATES DEPARTMENT OF THE INTERIOR
NATIONAL PARK SERVICE, BRANCH OF PLANS AND DESIGN


NAME OF STRUCTURE
THE HENRY WHITEHEAD PLACE
CADES COVE - GREAT SMOKY MOUNTAINS NATIONAL PARK - BLOUNT COUNTY - TENNESSEE

SURVEY NO.
TENN
161


HISTORIC AMERICAN
BUILDINGS SURVEY
SHEET 9 OF 11 SHEETS

LIBRARY OF CONGRESS
INDEX NUMBER


NOTE: THE WARPING FRAME WAS USED FOR MEASURING THE WARP AND KEEPING IT IN ORDER PREPARATORY TO SETTING UP THE LOOM. THE SPOOL FRAME WAS USED SEPARATELY AND HELD YARN ON CORNHUSK SPINDLES FROM WHICH IT WAS DRAWN TO THE WARPING FRAME. THE SPOOL FRAME WAS STORED BY HANGING ON THE WARPING FRAME.

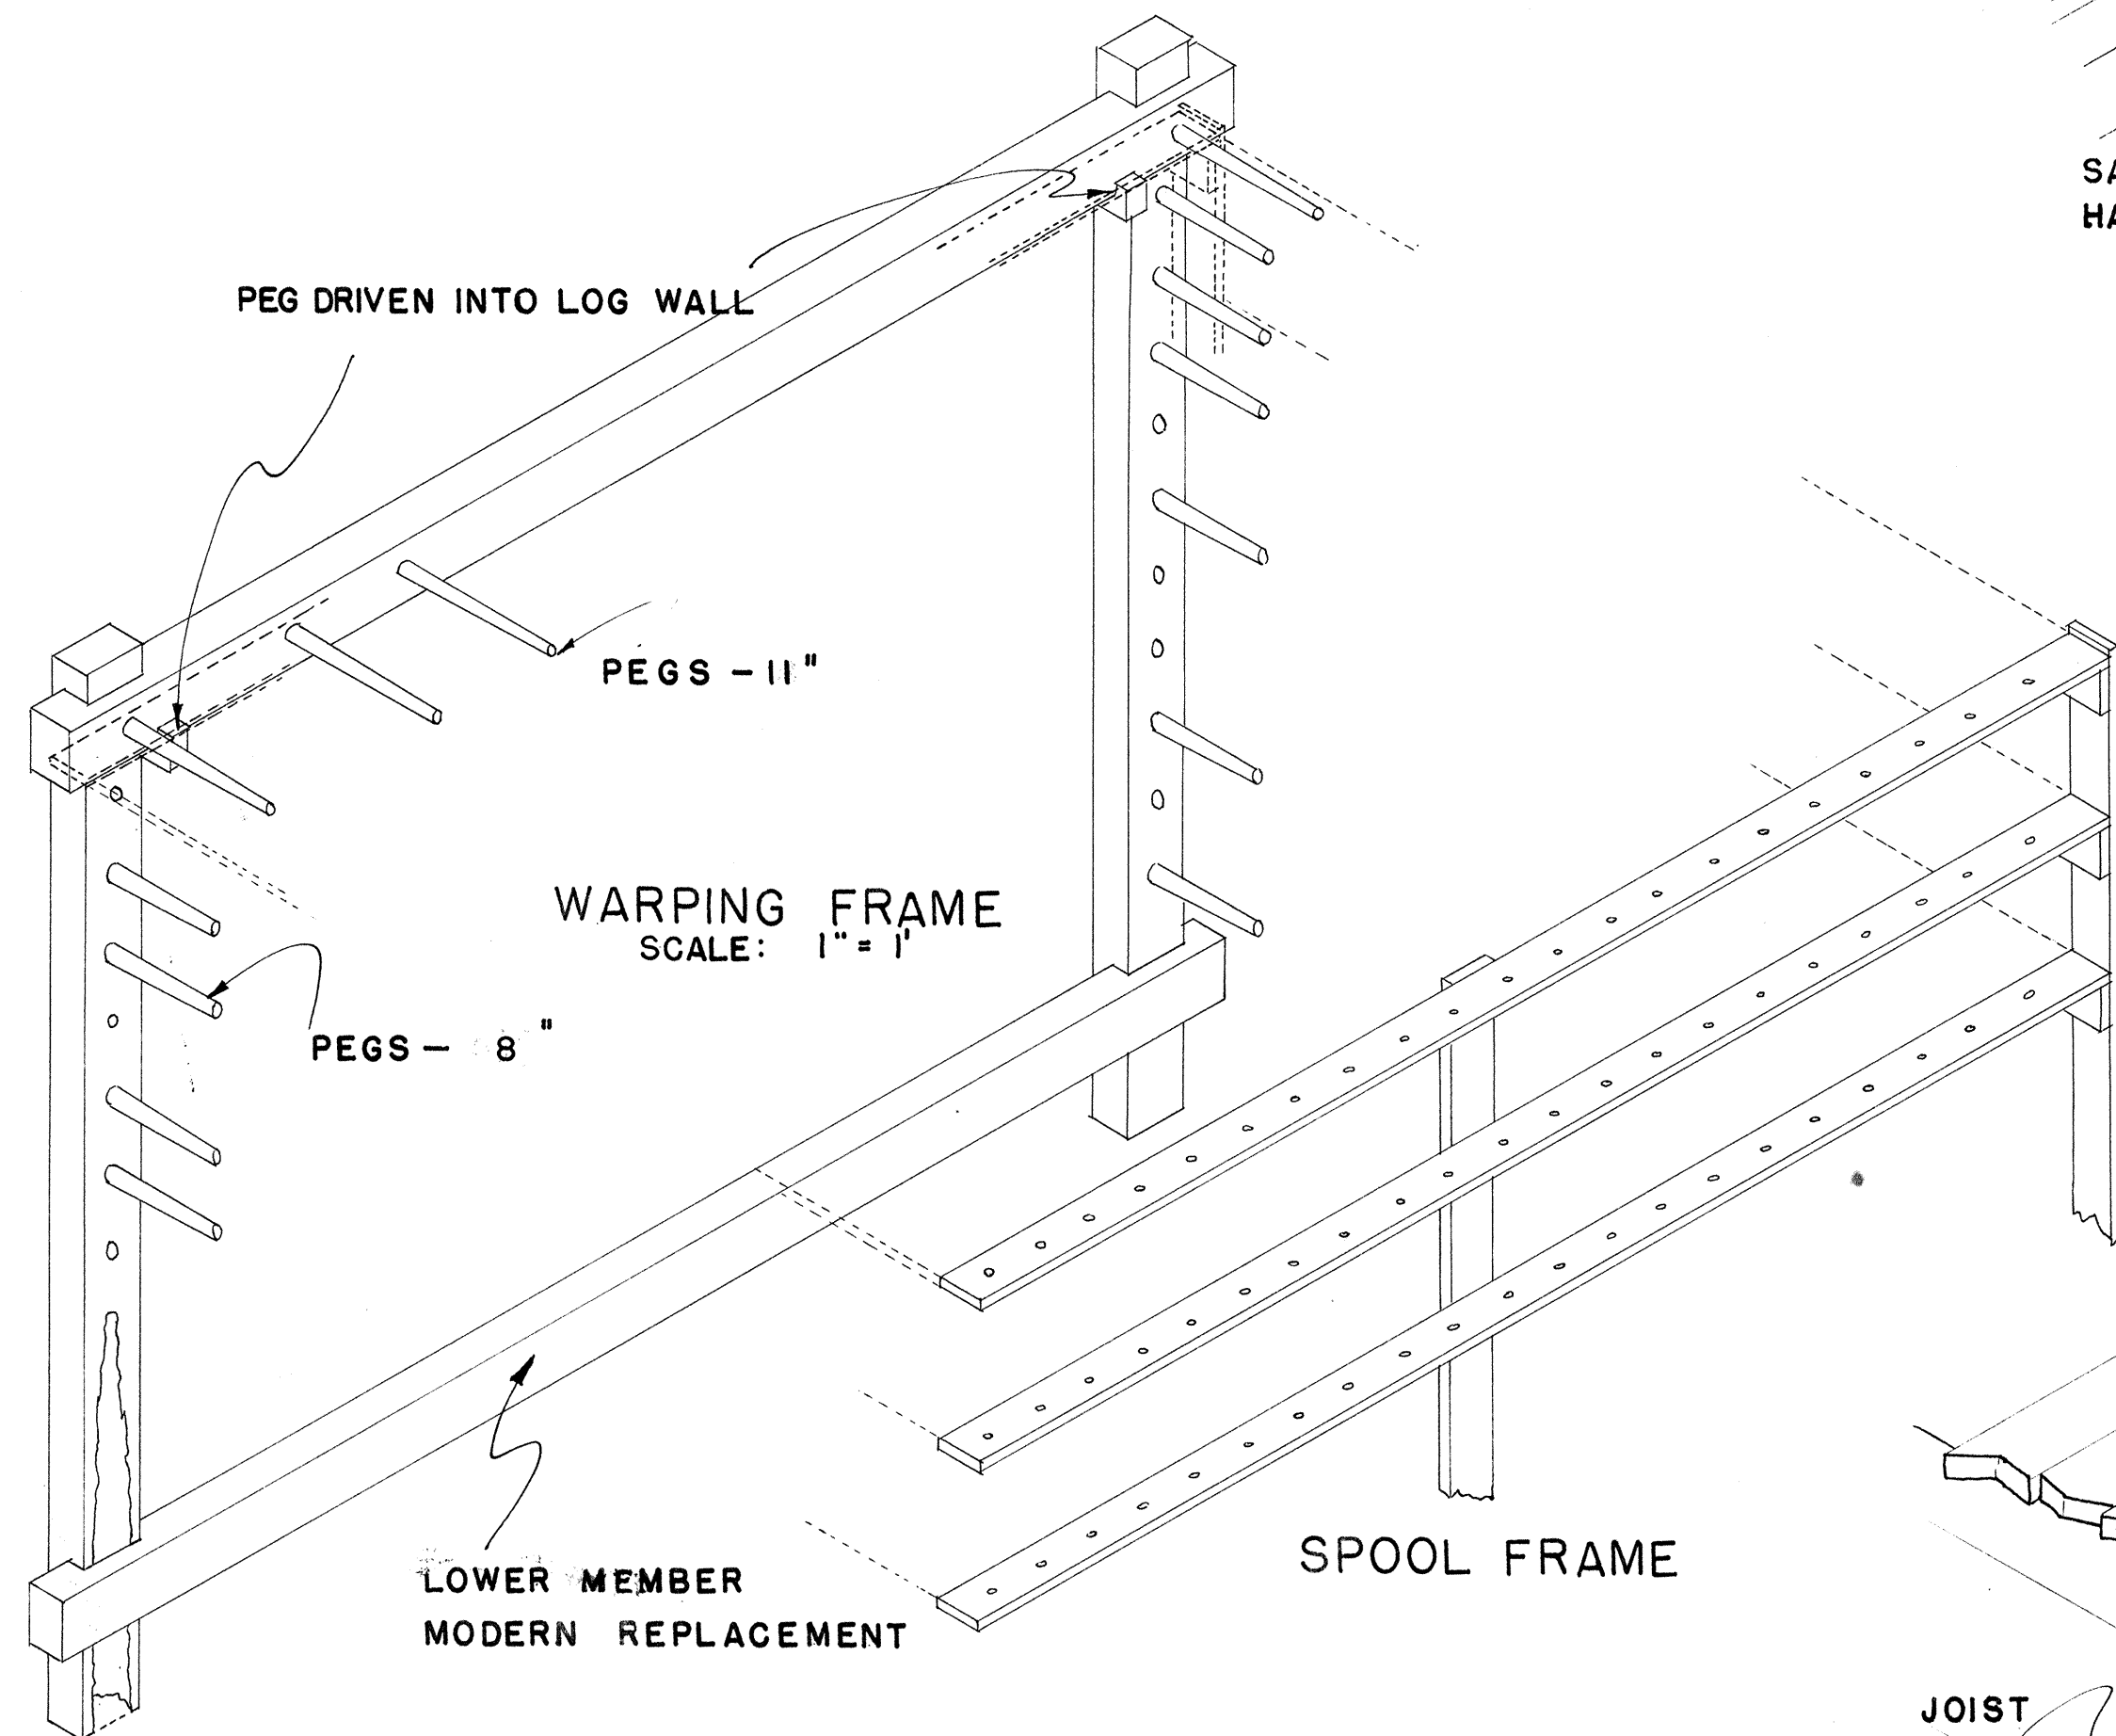

NOTE: BOTH WARPING FRAME AND SPOOL FRAME ARE IN FRAGMENTARY CONDITION, THE REMAINS OF SPOOL FRAME ARE HANGING ON WARPING FRAME WHICH IS HANGING ON PEGS ON SE WALL OF OLD CABIN.

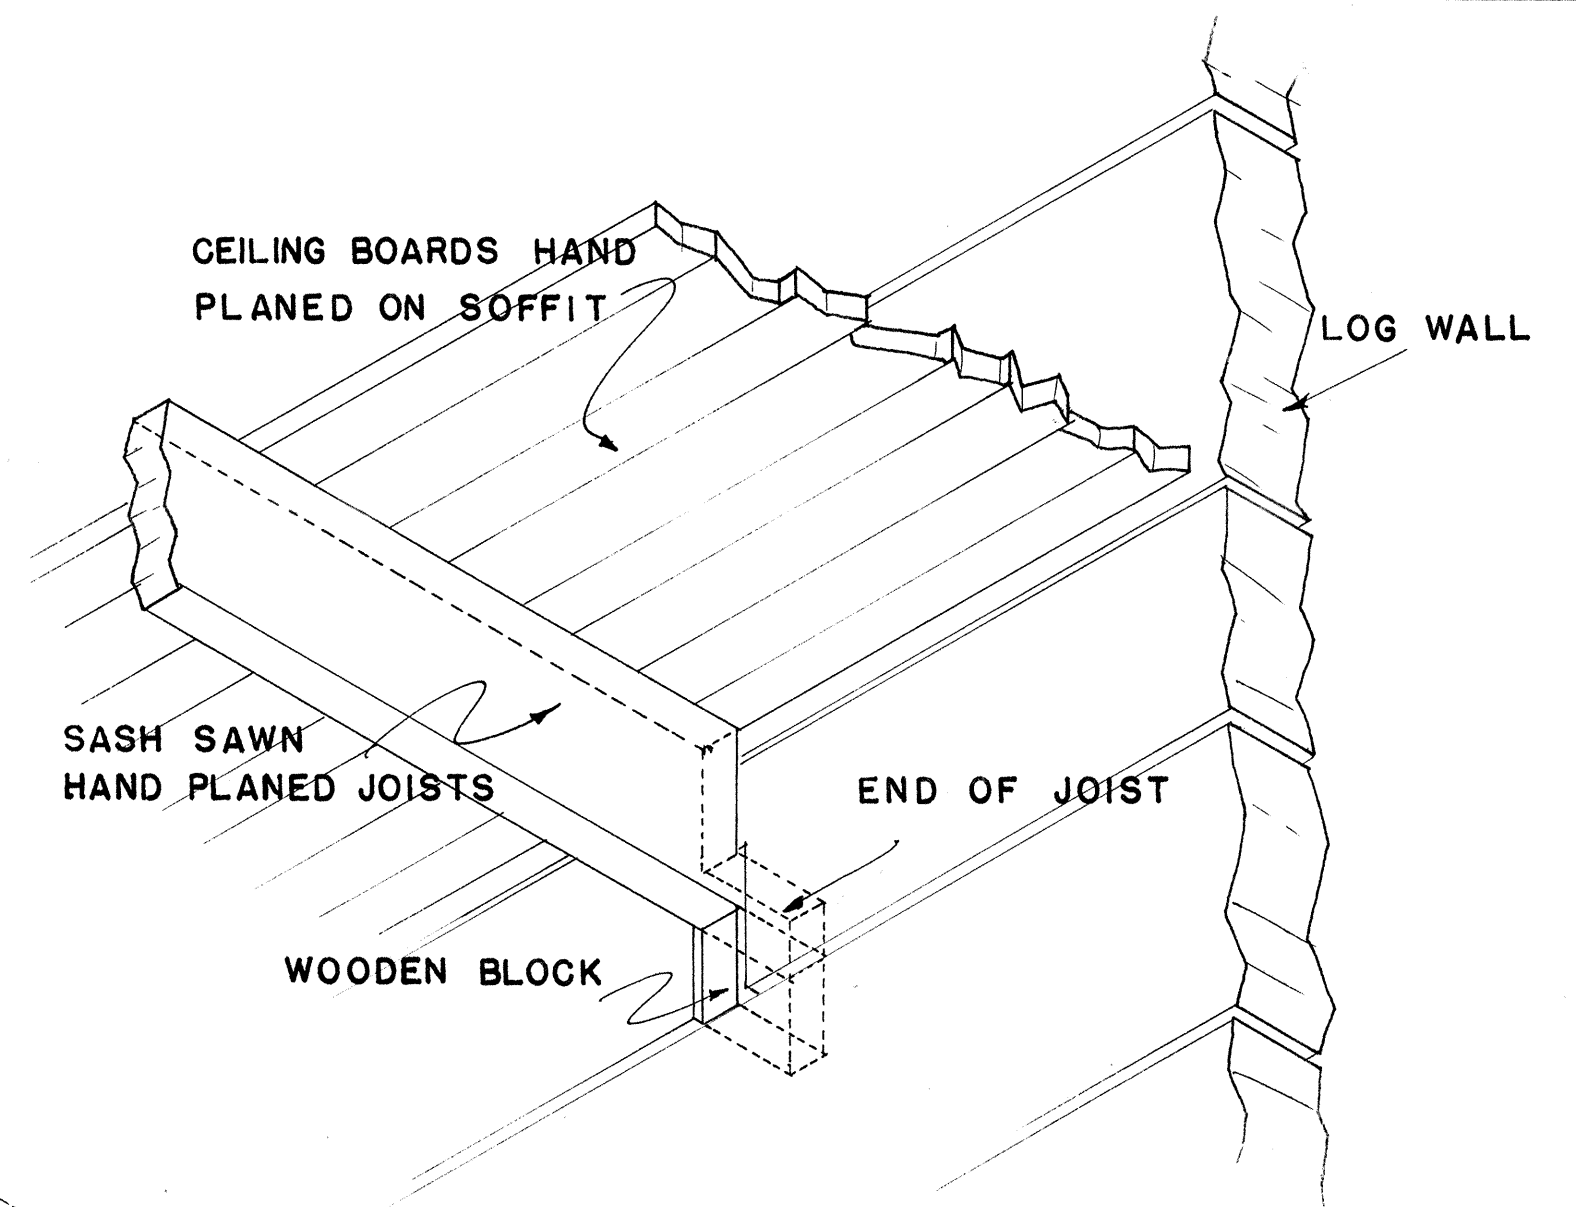

DETAIL OF JOISTS
NEW CABIN
SCALE: $1\frac{1}{2}'' = 1' - 0''$

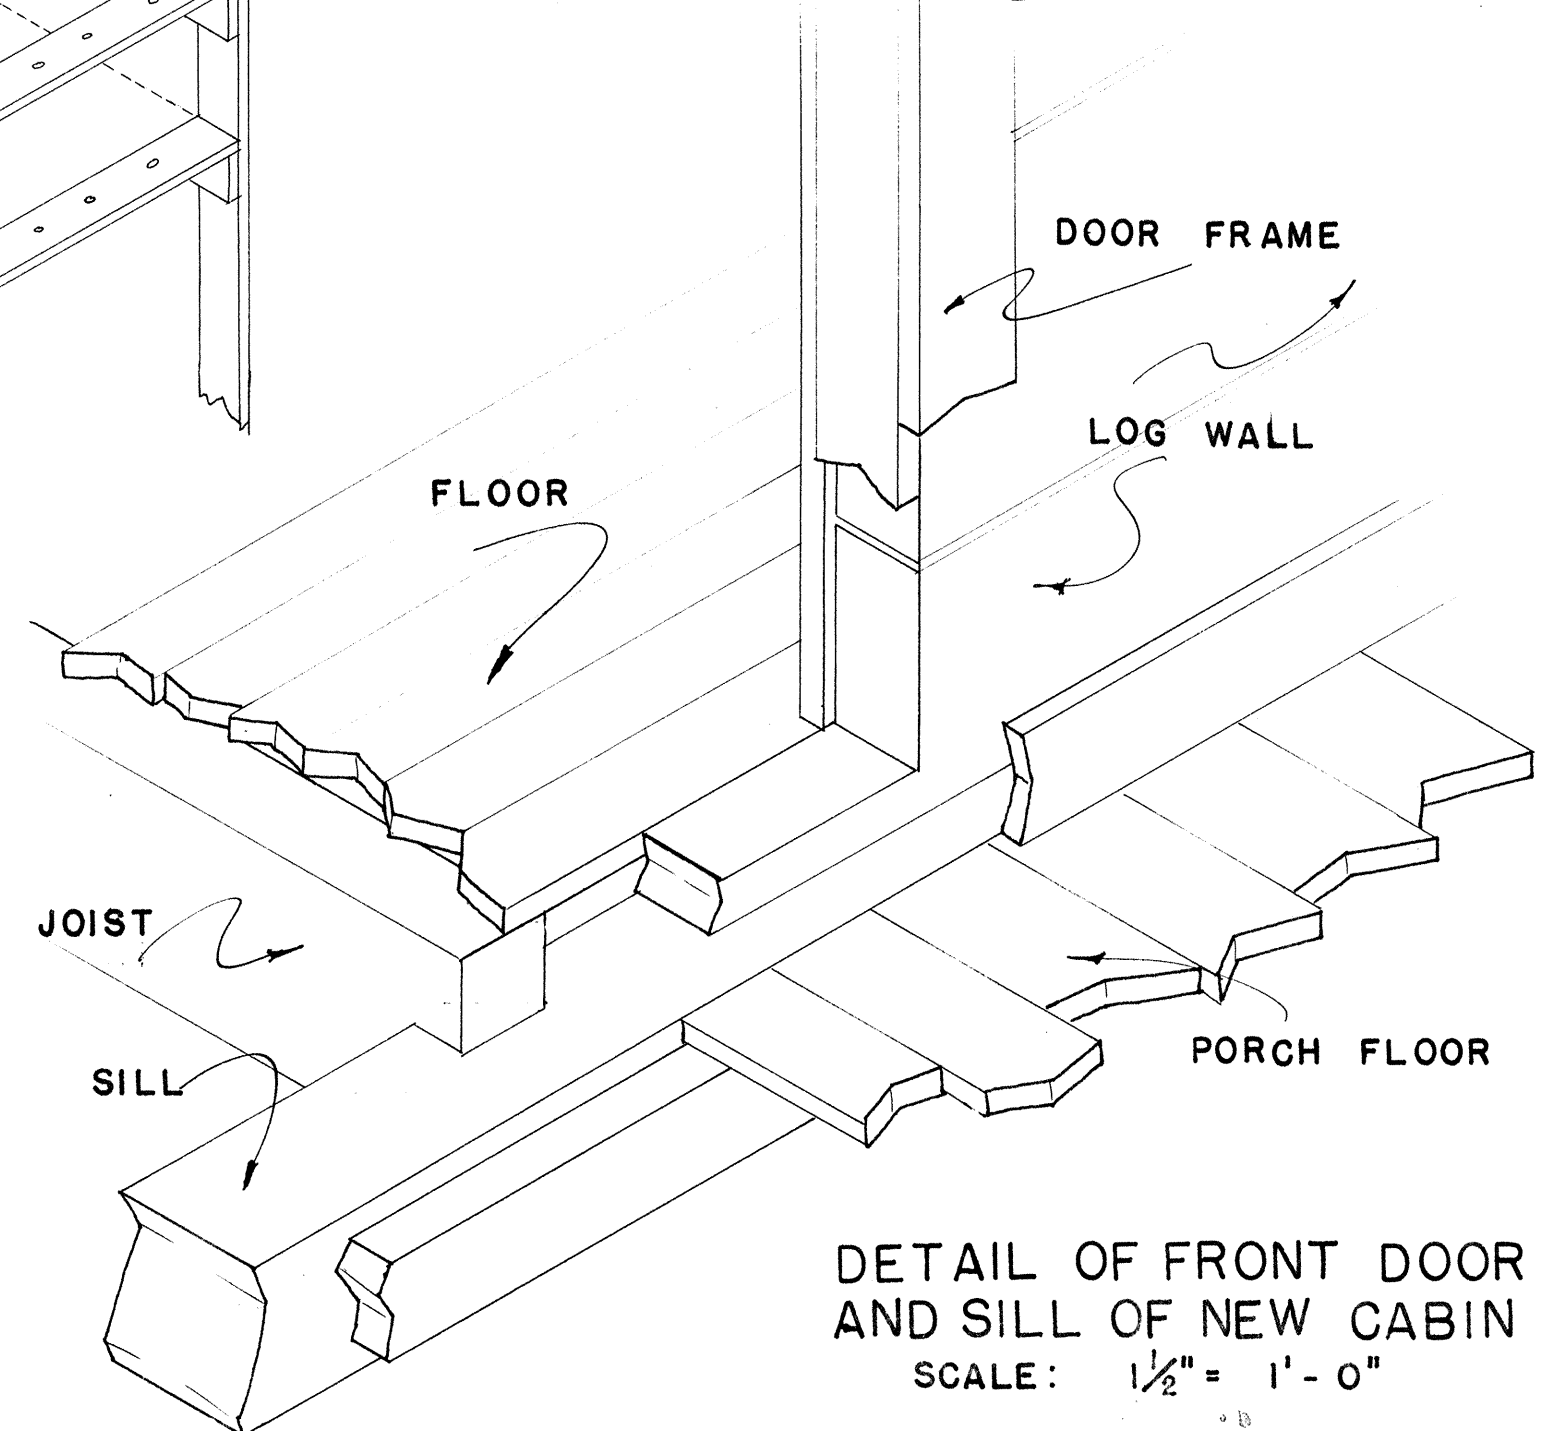

DETAIL OF FRONT DOOR
AND SILL OF NEW CABIN
SCALE: $1\frac{1}{2}'' = 1' - 0''$

SAMUEL E. HENRY - DEL. 1957

1 9 6 0 1 2 FEET

1 6 0 1 2 3 4 FEET

METRIC


PHILADELPHIA - EASTERN OFFICE
DIVISION OF DESIGN AND CONSTRUCTION
UNDER DIRECTION OF UNITED STATES DEPARTMENT OF THE INTERIOR
NATIONAL PARK SERVICE, BRANCH OF PLANS AND DESIGN

NAME OF STRUCTURE
THE HENRY WHITEHEAD PLACE
CADES COVE - GREAT SMOKY MOUNTAINS NATIONAL PARK - BLOUNT COUNTY - TENNESSEE

SURVEY NO.
TENN
161

HISTORIC AMERICAN
BUILDINGS SURVEY
SHEET 10 OF 11 SHEETS

LIBRARY OF CONGRESS
INDEX NUMBER

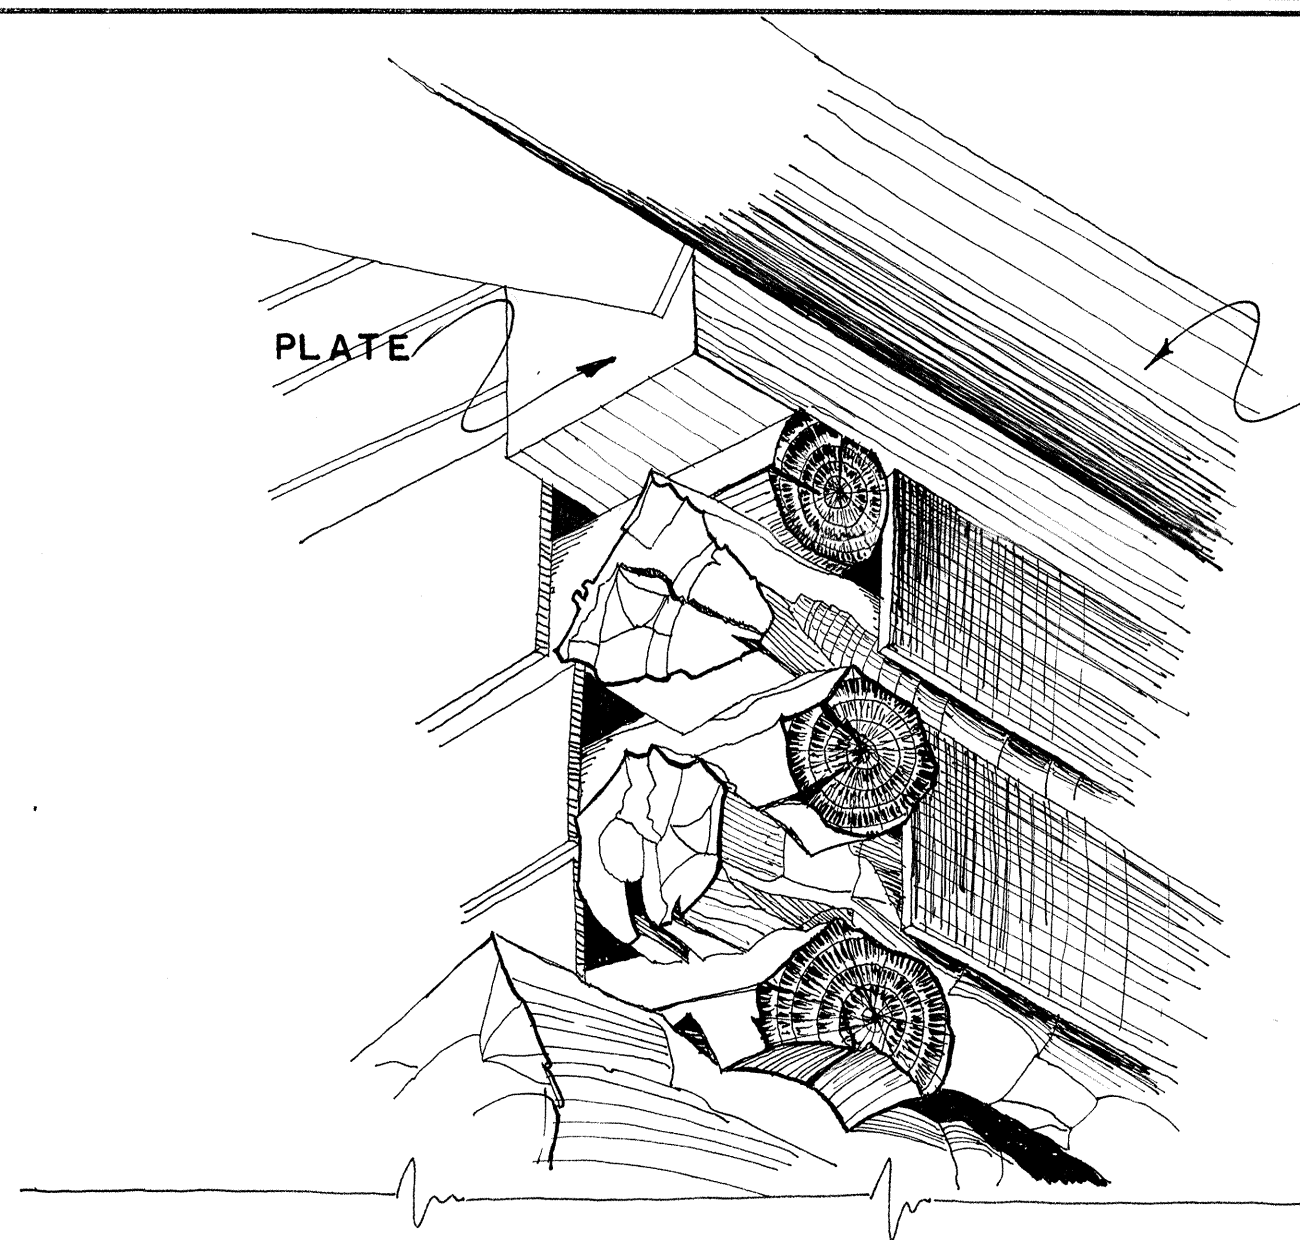


HAND HEWN GUTTER
REPLACED IN 1948

ROUGH HEWN LOGS
SADDLE NOTCHED CORNERS
CHINKING BOARDS 1/2" THICK
REPLACED IN 1937


OLD CABIN
NORTH CORNER

SILL

CORNER DETAILS SCALE 1" = 1'-0"

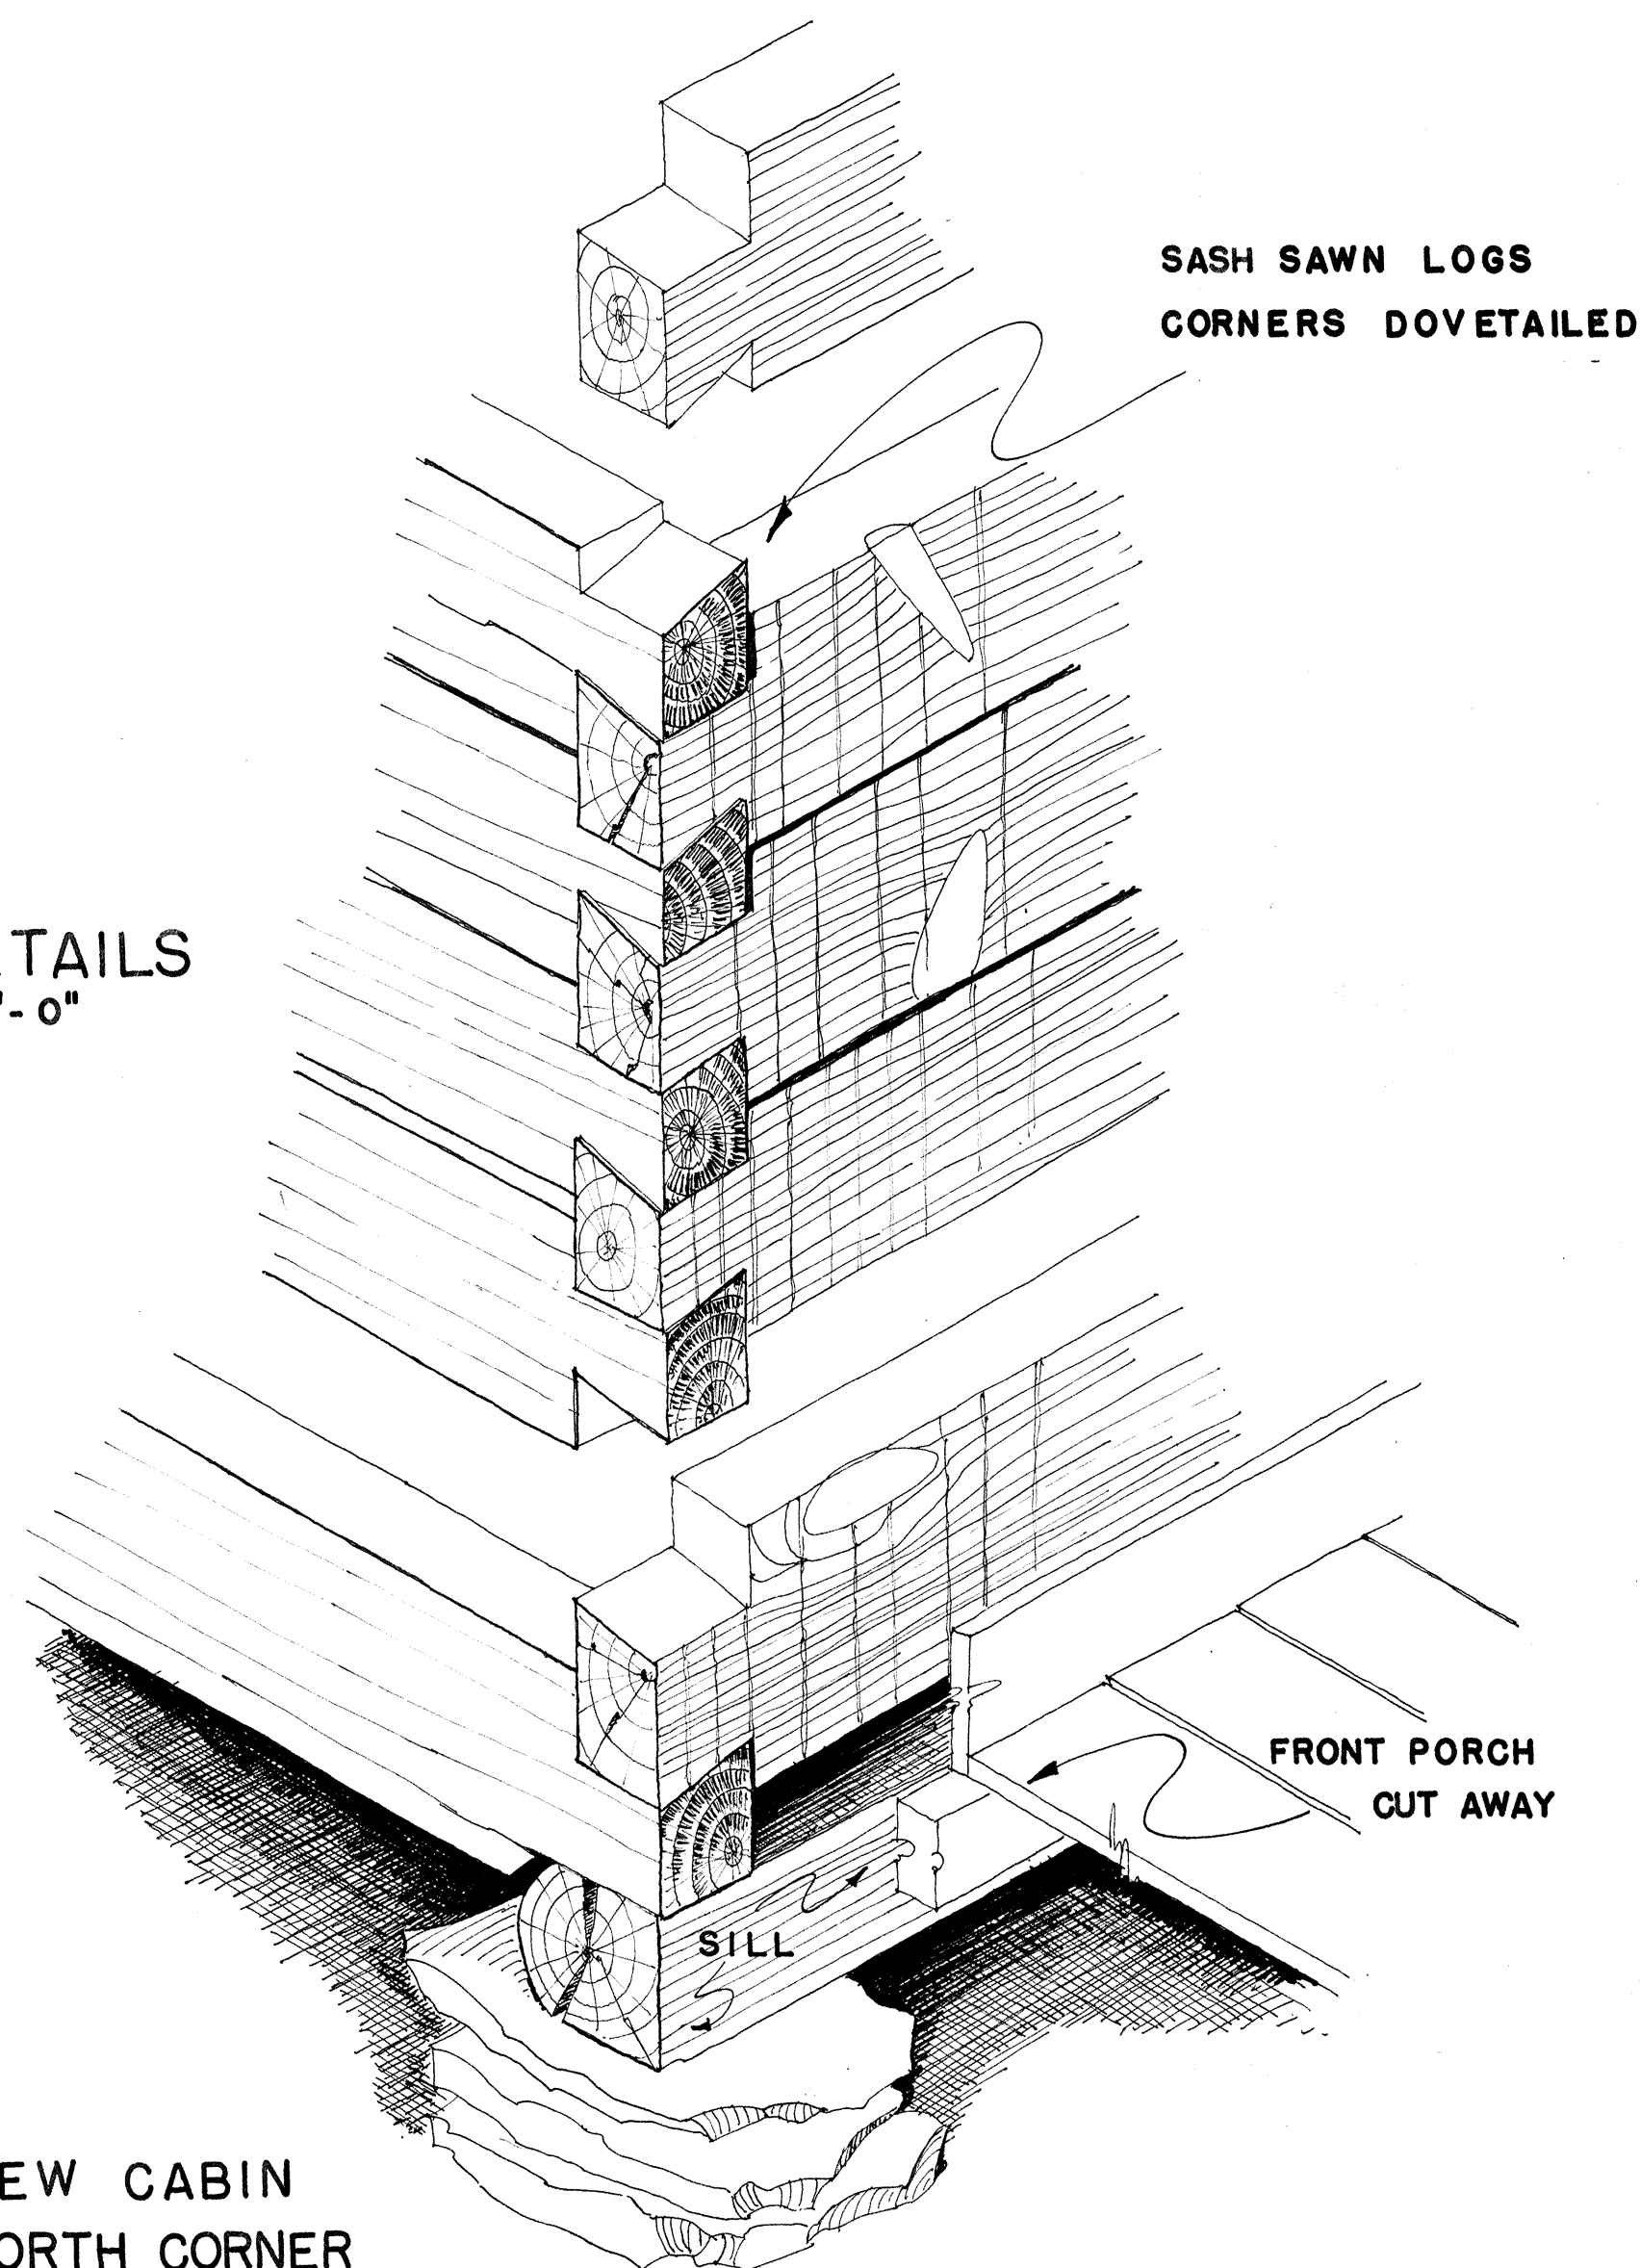

NEW CABIN
NORTH CORNER

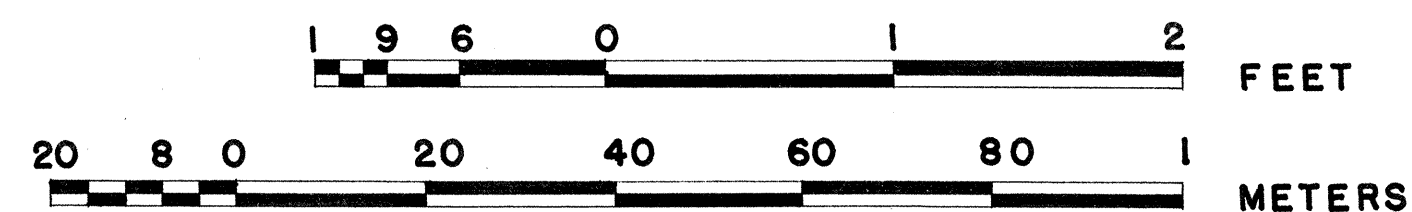

RICHARD LUNDY- DEL. 1957

PHILADELPHIA EASTERN OFFICE
DIVISION OF DESIGN AND CONSTRUCTION
UNDER DIRECTION OF UNITED STATES DEPARTMENT OF THE INTERIOR
NATIONAL PARK SERVICE, BRANCH OF PLANS AND DESIGN

NAME OF STRUCTURE
THE HENRY WHITEHEAD PLACE
CADES COVE - GREAT SMOKY MOUNTAINS NATIONAL PARK - BLOUNT COUNTY - TENNESSEE

SURVEY NO.
TENN
161

HISTORIC AMERICAN
BUILDINGS SURVEY
SHEET 11 OF 11 SHEETS

LIBRARY OF CONGRESS
INDEX NUMBER

HABS
TENN
S-CADCO.V,
1-

HISTORIC AMERICAN BUILDINGS SURVEY

INDEX TO PHOTOGRAPHS

Addendum to
Henry Whitehead Place (Great Smoky Mts. Natl. Park)
Cades Cove Vicinity
Blount County
Tennessee

HABS No. TN-161

Photographs TN-161-6, 9, and 10 were taken by Marion D. Ross, Photographer, July 1957. Photographs TN-161-1-5, 7, 8, 11 were taken by Jack Boucher, Photographer, April 1962.

- TN-161-1 EXTERIOR, GENERAL VIEW SHOWING HENRY WHITEHEAD CABIN (FRONT) AND
 DAVID SHIELDS CABIN (REAR)
- TN-161-2 EXTERIOR, NORTH CORNER VIEW OF BOTH CABINS
- TN-161-3 EXTERIOR, SOUTHWEST VIEW OF BOTH CABINS
- TN-161-4 EXTERIOR, WEST CORNER VIEW OF BOTH CABINS
- TN-161-5 EXTERIOR, DAVID SHIELDS CABIN, (REAR), SOUTHEAST VIEW
- TN-161-6 EXTERIOR, DAVID SHIELDS CABIN (REAR), EAST CORNER DETAIL SHOWING
 JOINTS
- TN-161-7 EXTERIOR, WHITEHEAD CABIN (FRONT), DETAIL OF WEST CORNER SHOWING
 DOVETAIL JOINTS
- TN-161-8 INTERIOR, WHITEHEAD CABIN (FRONT), FIREPLACE AND STAIRWAY
- TN-161-9 INTERIOR, WHITEHEAD CABIN (FRONT), DETAIL OF FIREPLACE
- TN-161-10 INTERIOR, WHITEHEAD CABIN (FRONT), SOUTH CORNER
- TN-161-11 INTERIOR, ATTIC





HA85 NO. TN-141-2



HABS No. TN-161-3



HAS Nb. TN-161-4


HABS No-TN-141-5



HABS No. TN-161-6



#ABS No-TN-101-7

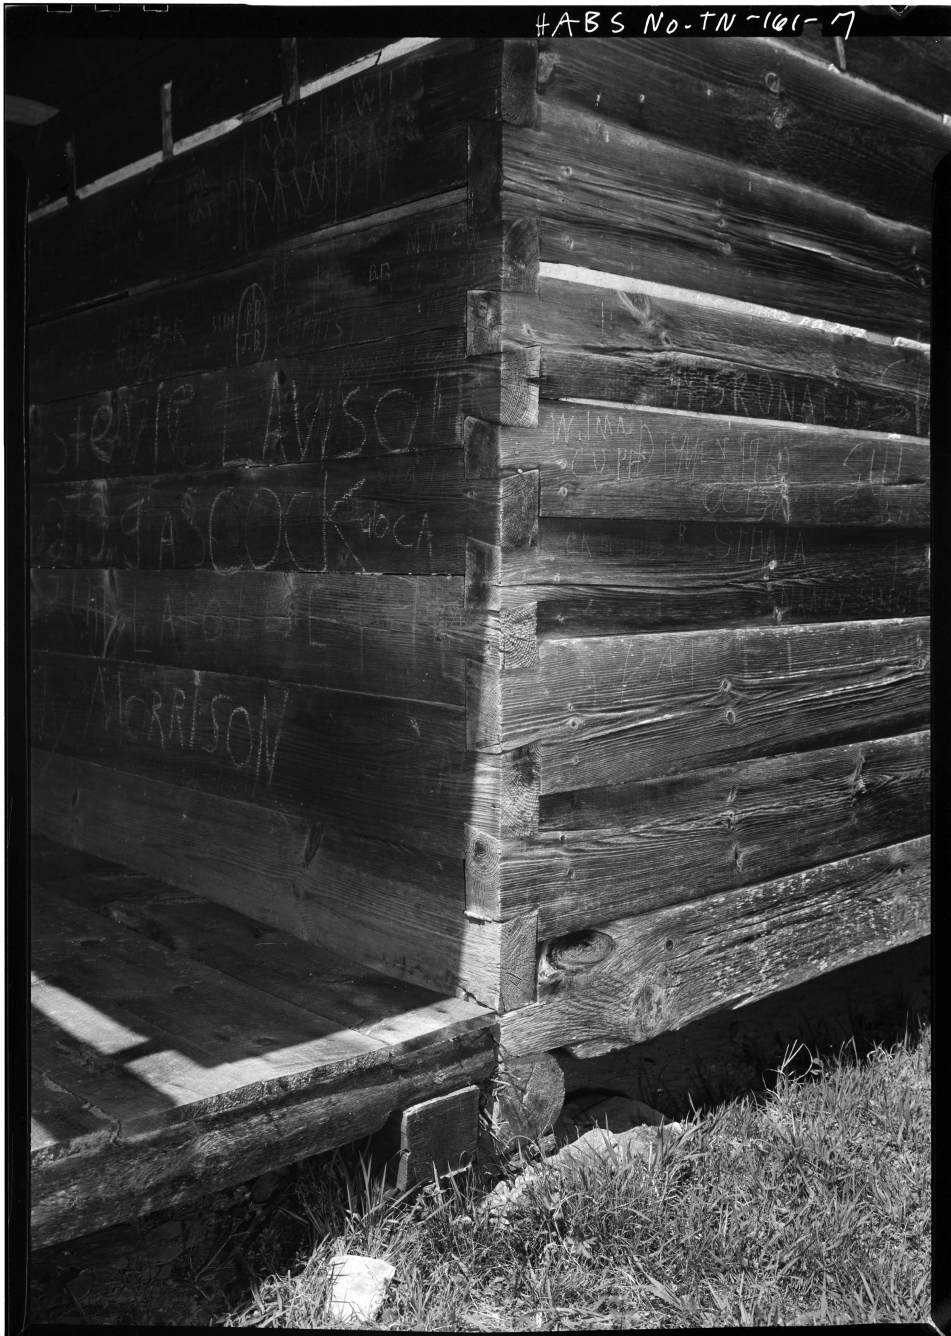



Vicki's Diner

DOWN
ARREST (KIX) 1917
THE HOUSE 1917
KIX 1917

HABS No. TN-141-8

HABS No. TN-161-9



KODAK-SAFETY FILM 35

HABS No. TN-166-10





HABS No. TN-141-11