

Menor's Ferry
Moose
Grand Teton National Park
Wyoming

HABS No. WYO-24

HABS
WYO
20-MOOS
2-

PHOTOGRAPHS

HISTORIC AMERICAN BUILDINGS SURVEY
NATIONAL PARK SERVICE
Western Office, Division of Design and Construction
450 Golden Gate Avenue
San Francisco, California

PHOTOGRAPH-DATA BOOK REPORT
HISTORIC AMERICAN BUILDINGS SURVEY

WYO-24
Page 1

MENOR'S FERRY

Grand Teton National Park, Moose, Wyoming

ADDRESS: West bank of the Snake River, Moose, Wyo.
OWNER: National Park Service
OCCUPANT: none
USE: Historic Point of Interest

HISTORICAL AND ARCHITECTURAL SIGNIFICANCE

William D. (Bill) Menor came to the Jackson Hole valley in 1892 and established squatters rights to 148 acres of land on the west bank of the Snake River. Here he built a log cabin and a ferry; later a store was started. Menor's Ferry was evidently the heart of the economy of the valley. The dangerous Snake River divides the valley into two parts. The east portion contains most of the arable land, while the bulk of the forest was in the west portion.

The ferry and store served the inhabitants of the valley for over thirty years. In 1918 Menor sold his homestead and ferry to Miss Maud Noble. She continued operation of the ferry until 1926 when a steel bridge was built nearby. Miss Noble sold the property and operation to the Snake River Land Company in 1929.

In June, 1949, the Jackson Hole Preserve, Inc. began the restoration of the ferry, the cabin-store and other remaining buildings. In 1950 the property became part of Grand Teton National Park.

The cabin that served as living quarters and store, the smoke house, and the restored ferry -- which transports visitors partway across the Snake River and back -- serve as a reminder of an important transportation link in the Jackson Hole area.

HISTORICAL INFORMATION

Bill Menor was reportedly a buffalo hunter for the Union Pacific Railroad prior to his entry into the Jackson Hole country in 1892.

WYO
20-1005
2-

WYO-24

Page 2

He established a homestead on the west bank of the Snake River. The selection of the land was doubtless guided by his desire to operate a ferry across the river. The forest was also on the west side of the river, and much of Menor's business was the ferrying of logs across the river. On August 13, 1908, he received patent to the 148.53 acres he had settled on earlier. He seems to have been the first homesteader on the west side of the Snake River.

The log cabin Menor built among the cottonwood trees has three rooms which, judging from the construction, were built at different times. The west room dates from 1892; the east room which became the store was built next, then the center room was built connecting the two, and served as kitchen and storage area for the cabin-store combination. The exterior of the buildings was white-washed (as they appear today).

The ferry that Bill Menor built was a flatbottomed boat resting on pontoons. It was carried by the current and guided by ropes attached to an overhead cable which was secured to a windlass so that the cable could be adjusted to the rise and fall of the current.

The boat was large enough to accommodate four horses and a wagon. The horses were unhitched and placed beside the wagon. Bill charged 50¢ for a team and 25¢ for a man on horseback; foot passengers rode free if a vehicle was being ferried across. When Maud Noble bought the ferry operation in 1918, she promptly raised the prices.

The ferry was beached in the winter months and the river had to be forded. Later a winter bridge, removed in the spring, was constructed.

Menor's Ferry was the site of a celebration on August 15, 1898, in honor of William O. Owen, Bishop Franklin, S. Spalding, Frank C. Petersen and John Shive who made the first ascent of the Grand Teton Peak on August 11, 1898. It was here at the ferry that the party had left their wagon and started out on foot up the Grand Teton.

In 1905 Bill Menor's brother, Holiday, arrived. For a time they lived together, then a disagreement arose and Holiday moved out, establishing a homestead of his own on the east side of the Snake River. They did not speak for two years, and according to legend would curse and shake fists at each other across the river.

The surviving homestead structures reconstructed in 1949 by the Jackson Hole Preserve, Inc. include the cabin-store, a warehouse building of logs with a root cellar, a log smokehouse and a privy. The blacksmith shop and barn are missing.

Sometime after sale of the Bill Menor homestead, he and Holiday moved to California. Bill Menor died in San Diego on May 30, 1933, and Holiday Menor died there on December 18, 1934.

SUPPLEMENTAL MATERIAL AND SOURCES

- Apple, Russell A., An Interpretive Prospectus for Post-Fur Trade History, Grand Teton National Park, Midwest Region, National Park Service, U. S. Dept. of Interior, 1960: amendments 1963.
- Bonney, Orrin H. & Lorraine G., Jackson Hole and Grand Teton National Park, publ. by author, Houston, 1961.
- Bureau of Vital Statistics, San Diego, Calif.
- Judge, Frances, "Mountain River Men", Campfire Tales of Jackson Hole, publ. by Grand Teton Natural History Assn., Moose, Wyo., 1960.
- Kendrew, A. E., "Report on Owned Structures of a Historic Character, Jackson Hole, Wyoming", 1942.
- Mumey, Nolie, The Teton Mountains, Their History and Tradition, Art-craft Press, Denver, 1947.
- U. S. Patent 15033, Patent Book 1, p. 291, Teton County Courthouse, Jackson, Wyo.

ARCHITECTURAL INFORMATION

EXTERIOR

Overall Dimensions - A one story, three room cabin -- the rooms built at different times. The east room (the store) has a porch on the south-southwest; 41'-4½" x 23'-11".

Foundation - Stone.

Wall Construction - Log construction, notched cornering, except for the center room (which was probably the last addition) which is of vertical board and batten on the south and vertical capped rough sawn planks on the north.

Openings - Entrances: Two exterior doors, 2'-7" x 6'-4½" of vertical rough cut planks of 1 x 6's and 1 x 8's. Each

WYO
20-MOOS
21

WYO-24
Page 4

door has a light of 6 panes. Casings are rough cut 2 x 8's.

Windows: Wood double-hung, vary from 1/4, 4/4 to 6/6.

Roof - Gable roof, planking covered with tar paper and a second layer of planks. Roof over the west and central rooms has a pitch of approximately $16\frac{1}{2}^{\circ}$ and that over the east room has a pitch of 18° .

Chimney - none.

INTERIOR

Floor Plan - The original (1892) cabin was the east room of 16'-4" x 16'-11 $\frac{1}{2}$ "; the west room - later the store - is 14'-1" x 20'-1" set back from the front or south-south-west facade and projecting 6'-2" to the rear of the other two rooms; the center or connecting room is 11'-7 $\frac{1}{2}$ " x 17'-0".

Flooring - Rough cut planking.

Wall and Ceiling Finish - Logs and planking exposed.

Trim - None except rough sawn window and door jambs, etc.

Hardware - Hand forged hinges on door to the store.

GENERAL SETTING

The homestead cabin and outbuildings are situated on the west bank of the Snake River.

OUTBUILDINGS

There is a log storage building with a root cellar beneath which has walls of native field stone; exterior dimensions 13'-4" x 18'-10 $\frac{1}{2}$ ". Also there is a log smoke house 9'-4" x 9'-4" which has boxed corner construction, and there is a privy.

Approved: *A. Lewis Koue*
A. Lewis Koue, FAIA
Supervisory Architect
Div. Historic Architecture
National Park Service
June 1967


Prepared by
John N. DeHaas, Jr.
John N. DeHaas, Jr.
Architect

MENOR'S

GRAND TETON MOOSE,

FERRY

NATIONAL PARK WYOMING

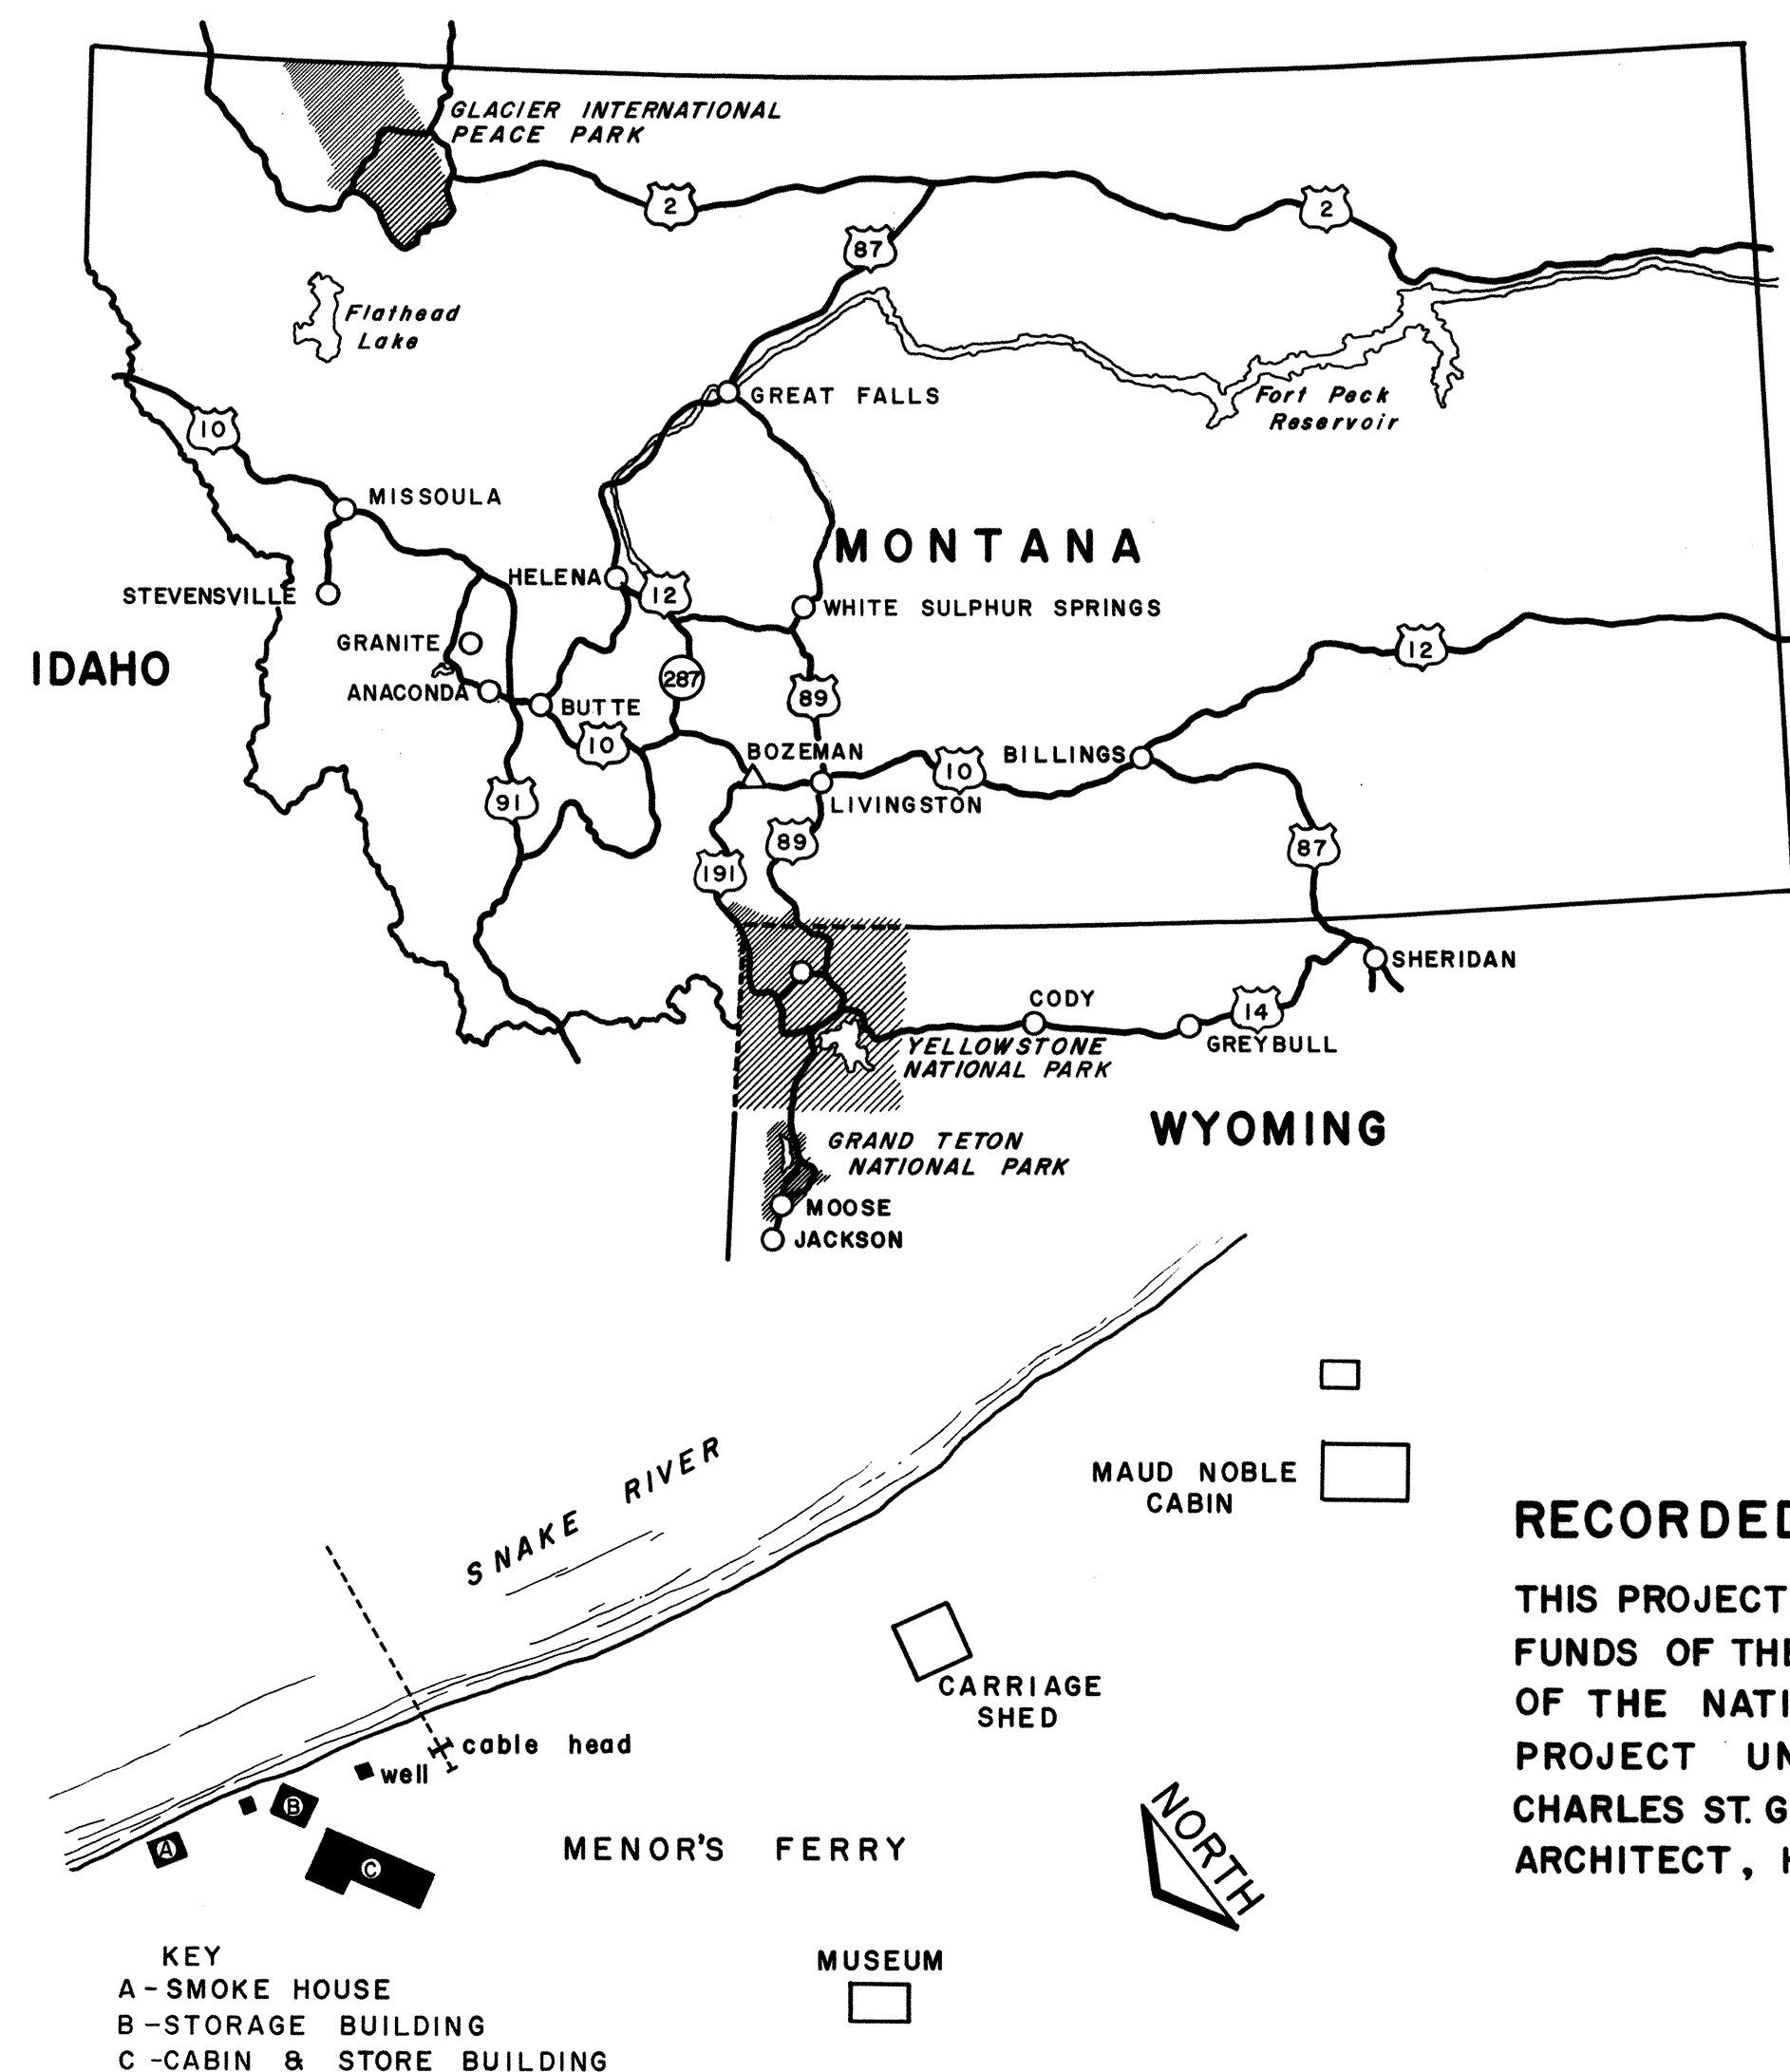

DRAWN BY: CHARLES B. GOLDY, JR.

WESTERN OFFICE
SAN FRANCISCO, CALIFORNIA
UNDER DIRECTION OF THE NATIONAL PARK SERVICE,
UNITED STATES DEPARTMENT OF THE INTERIOR

NAME AND LOCATION OF STRUCTURE
MENOR'S FERRY
GRAND TETON NATIONAL PARK MOOSE, WYOMING

SURVEY NO.
WYO 24

HISTORIC AMERICAN
BUILDINGS SURVEY
SHEET 1 OF 12 SHEETS

LIBRARY OF CONGRESS
INDEX NUMBER

WILLIAM D. MENOR CAME TO JACKSON HOLE IN 1892 AND HOMESTEADED ON 148 ACRES OF LAND ON THE WEST BANK OF THE SNAKE RIVER.

HE BUILT A LOG CABIN HAVING TWO ROOMS NEAR THE RIVER. HIS PRINCIPAL INCOME WAS FROM THE OPERATION OF A FERRY. THE SNAKE, A DANGEROUS RIVER TO CROSS, SPLIT THE JACKSON HOLE AREA INTO EAST AND WEST SECTIONS. MOST OF THE ARABLE LAND WAS ON THE EAST SIDE WHILE THE BULK OF THE FOREST, SOURCE OF LOGS NEEDED BY FARMERS AND RANCHERS, WAS ON THE WEST SIDE OF THE SNAKE. A FERRY AT THIS LOCATION WAS NECESSARY SINCE THE ONLY MEANS OF CROSSING THE SNAKE WAS OVER TWENTY MILES NORTH OR SOUTH OF THIS POINT.

BILL MENOR BUILT A STORE BUILDING ATTACHING IT TO THE EAST END OF HIS CABIN. THE BARN AND BLACKSMITH SHOP ARE GONE NOW BUT THE HOMESTEAD CABIN AND ATTACHED STORE WERE RESTORED IN 1949 AS WERE THE SMOKEHOUSE AND THE STORAGE BUILDING WITH ITS ROOT CELLAR.

THE CABIN AND STORAGE BUILDING WERE WHITEWASHED WITH LIME MADE IN BROTHER HOLIDAY MENOR'S KILN.

BILL MENOR SOLD HIS FERRY AND THE BUILDINGS TO MAUD NOBLE IN 1918.

RECORDED BY THE UNITED STATES NATIONAL PARK SERVICE

THIS PROJECT WAS FINANCED FROM FUNDS OF THE "MISSION 66" PROGRAM OF THE NATIONAL PARK SERVICE PROJECT UNDER DIRECTION OF CHARLES ST. GEORGE POPE SUPERVISING ARCHITECT, HISTORIC STRUCTURES.


MEASURED AND DRAWN JUNE-SEPT 1965 UNDER THE SUPERVISION OF JOHN N. DEHAAS, JR. ARCHITECT, MONTANA STATE UNIVERSITY.

U. JAMES BLACKBURN
DURWARD K. SOBEK
JACK OYAMA
DICK SHANAHAN
CHARLES B. GOLDY, JR.


MONTANA STATE UNIVERSITY
MONTANA STATE UNIVERSITY
S M O K E H O U S E

E L E V A T I O N S A N D P L A N

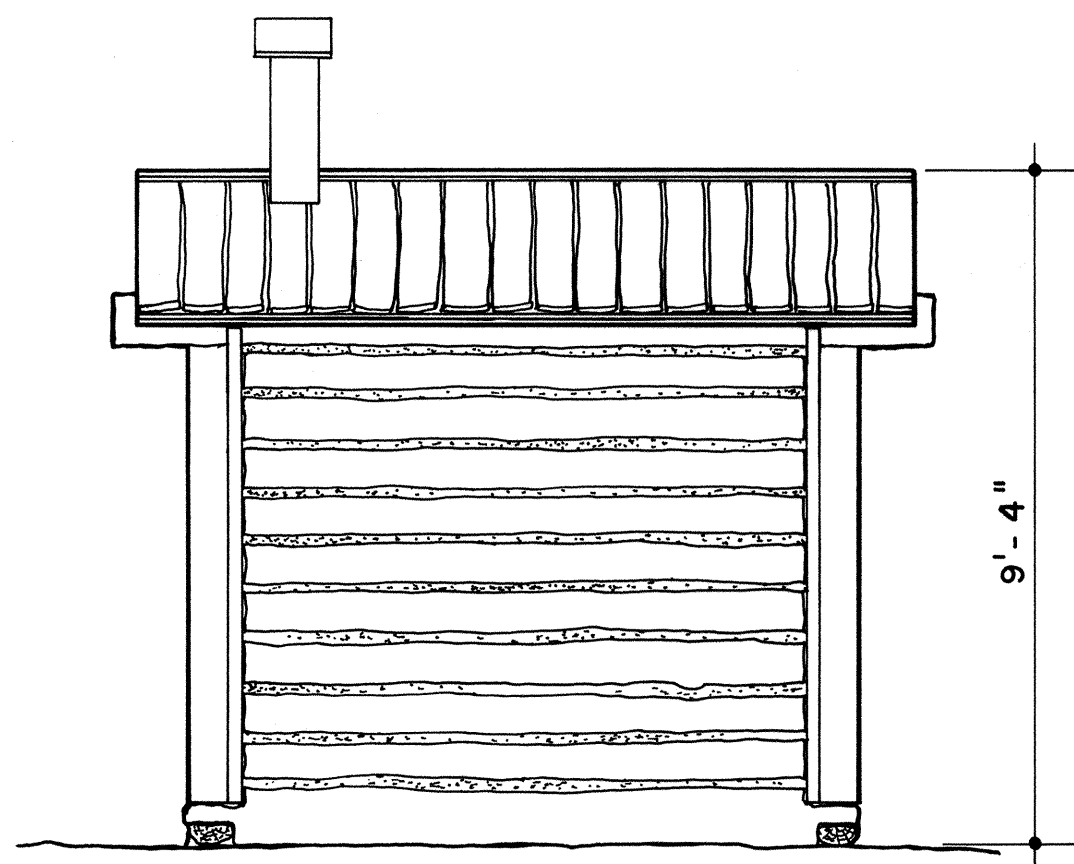


W E S T
E L E V A T I O N

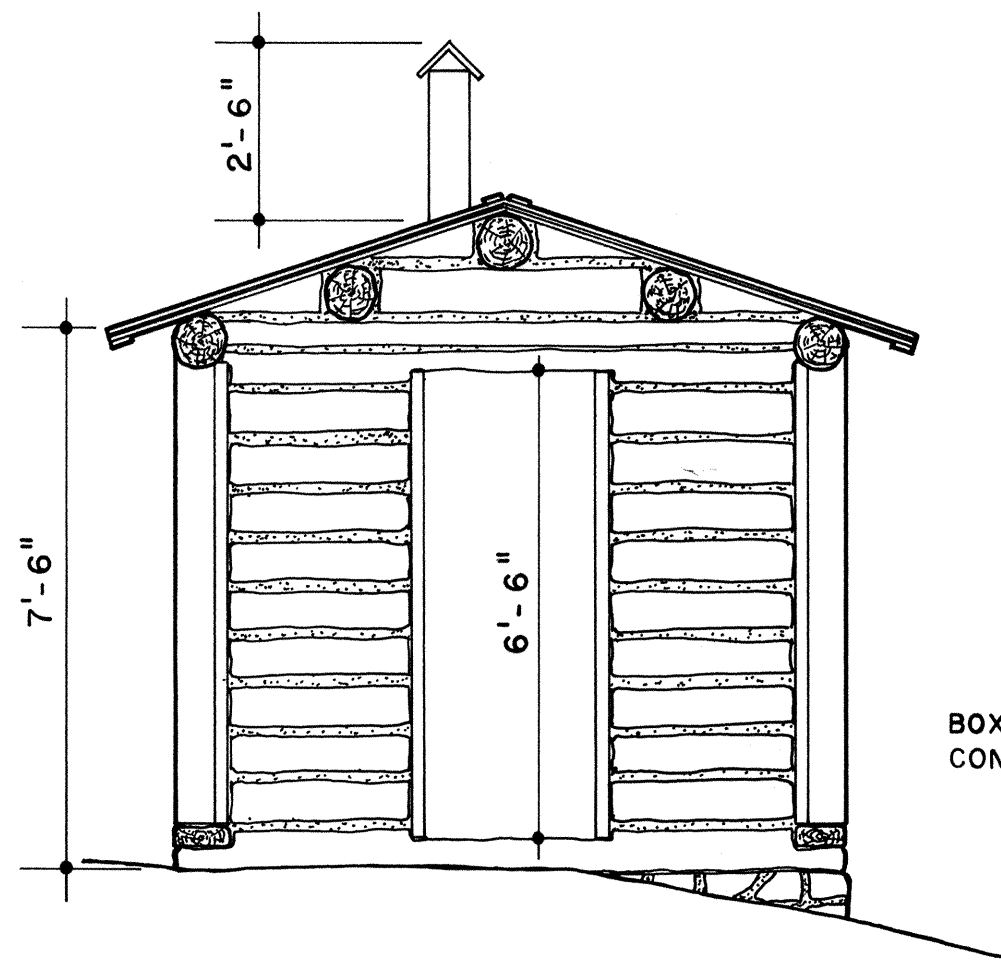


S O U T H
E L E V A T I O N


NOTE:
4" DIA. WOOD POLES
OVERHEAD 1' C.C.

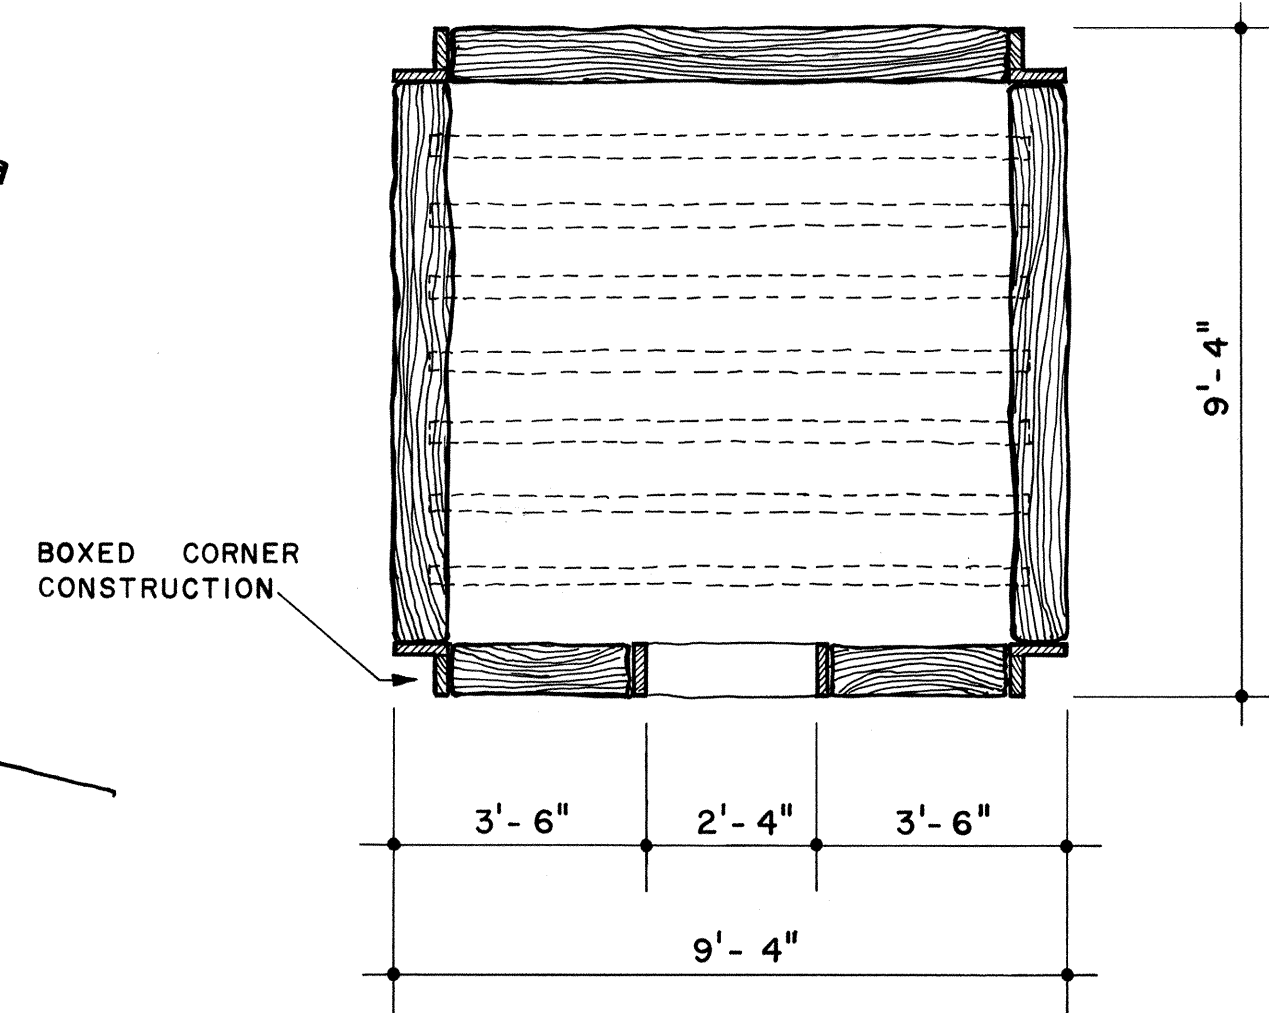

P L A N

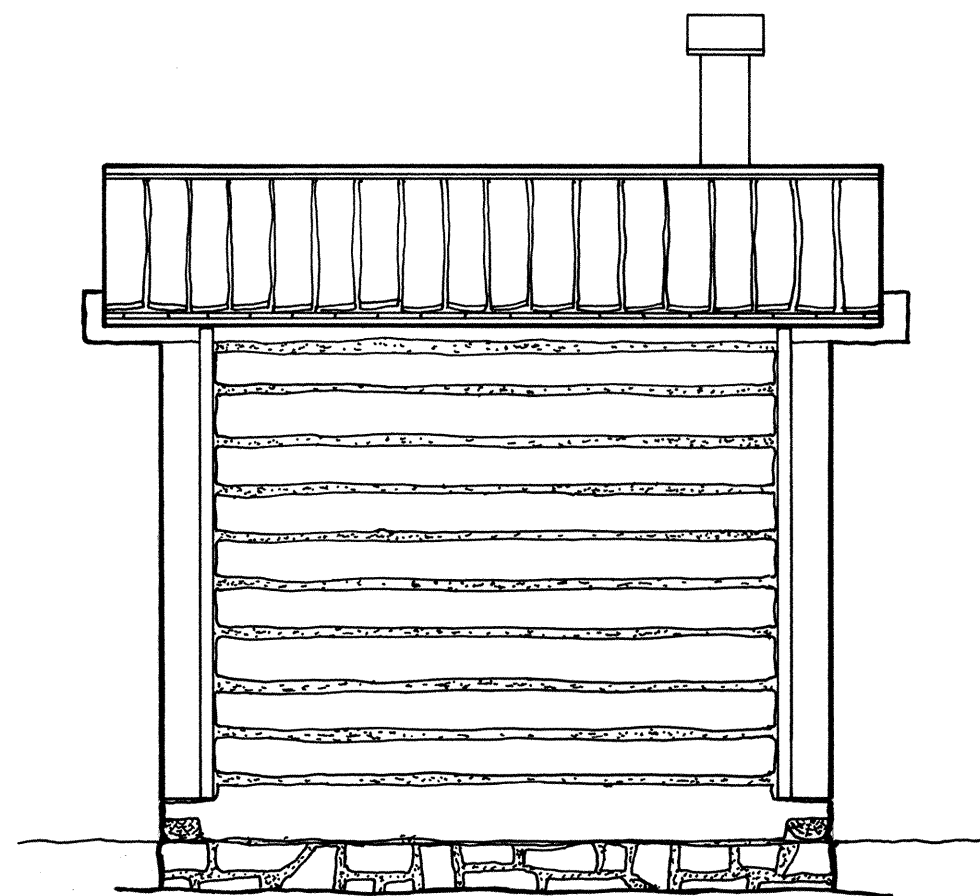


E A S T
E L E V A T I O N

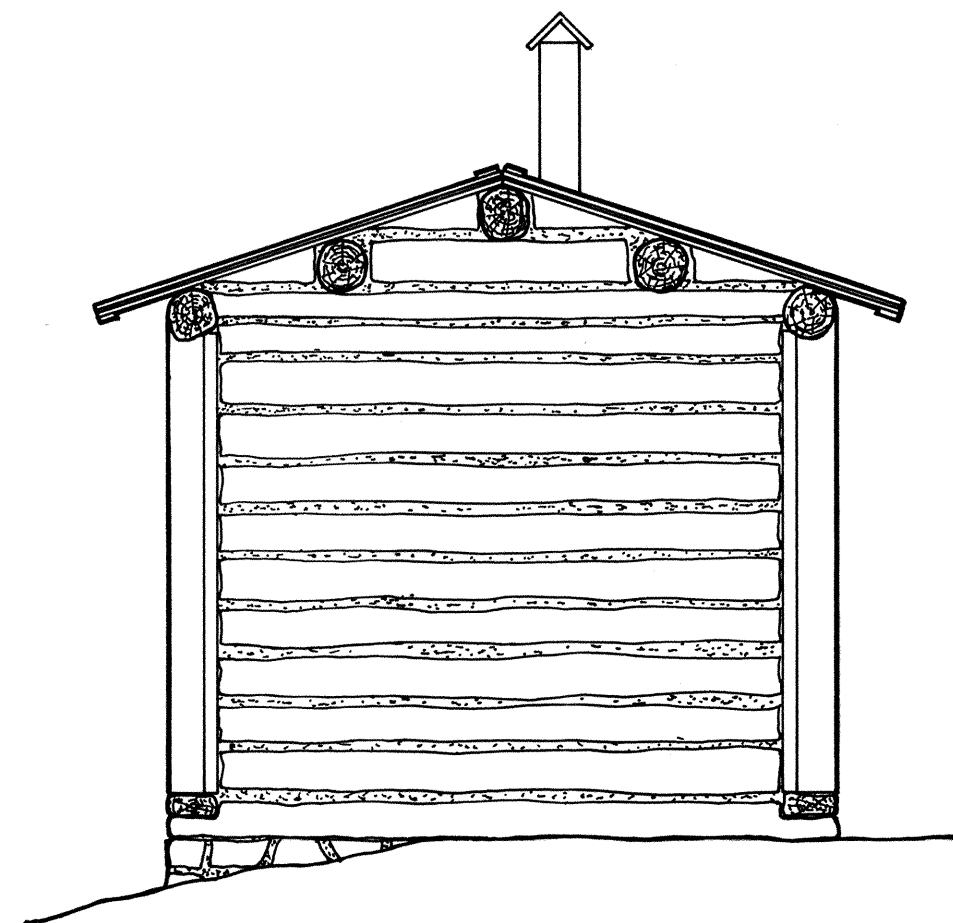

N O R T H
E L E V A T I O N

NOTE:
INTERIOR
PLASTER AND WOOD (RANDOM)
CHINKING. DIRT FLOOR.
EXTERIOR
PLASTER DAUBING

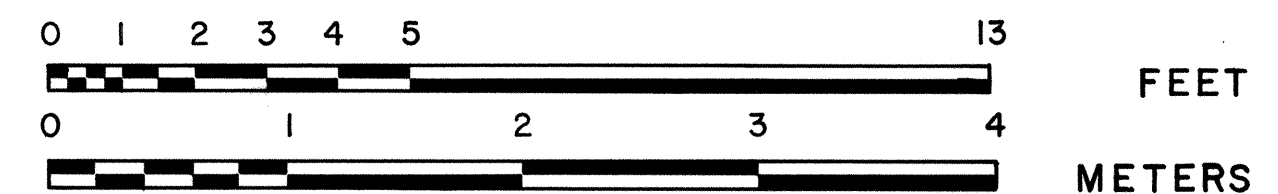

DRAWN BY: DURWARD K. SOBEK

WESTERN OFFICE
SAN FRANCISCO, CALIFORNIA
UNDER DIRECTION OF THE NATIONAL PARK SERVICE,
UNITED STATES DEPARTMENT OF THE INTERIOR

NAME AND LOCATION OF STRUCTURE


M E N O R ' S F E R R Y
GRAND TETON NATIONAL PARK MOOSE, WYOMING

SURVEY NO.
WYO 24


HISTORIC AMERICAN
BUILDINGS SURVEY
SHEET 2 OF 12 SHEETS

LIBRARY OF CONGRESS
INDEX NUMBER


S T O R A G E B U I L D I N G

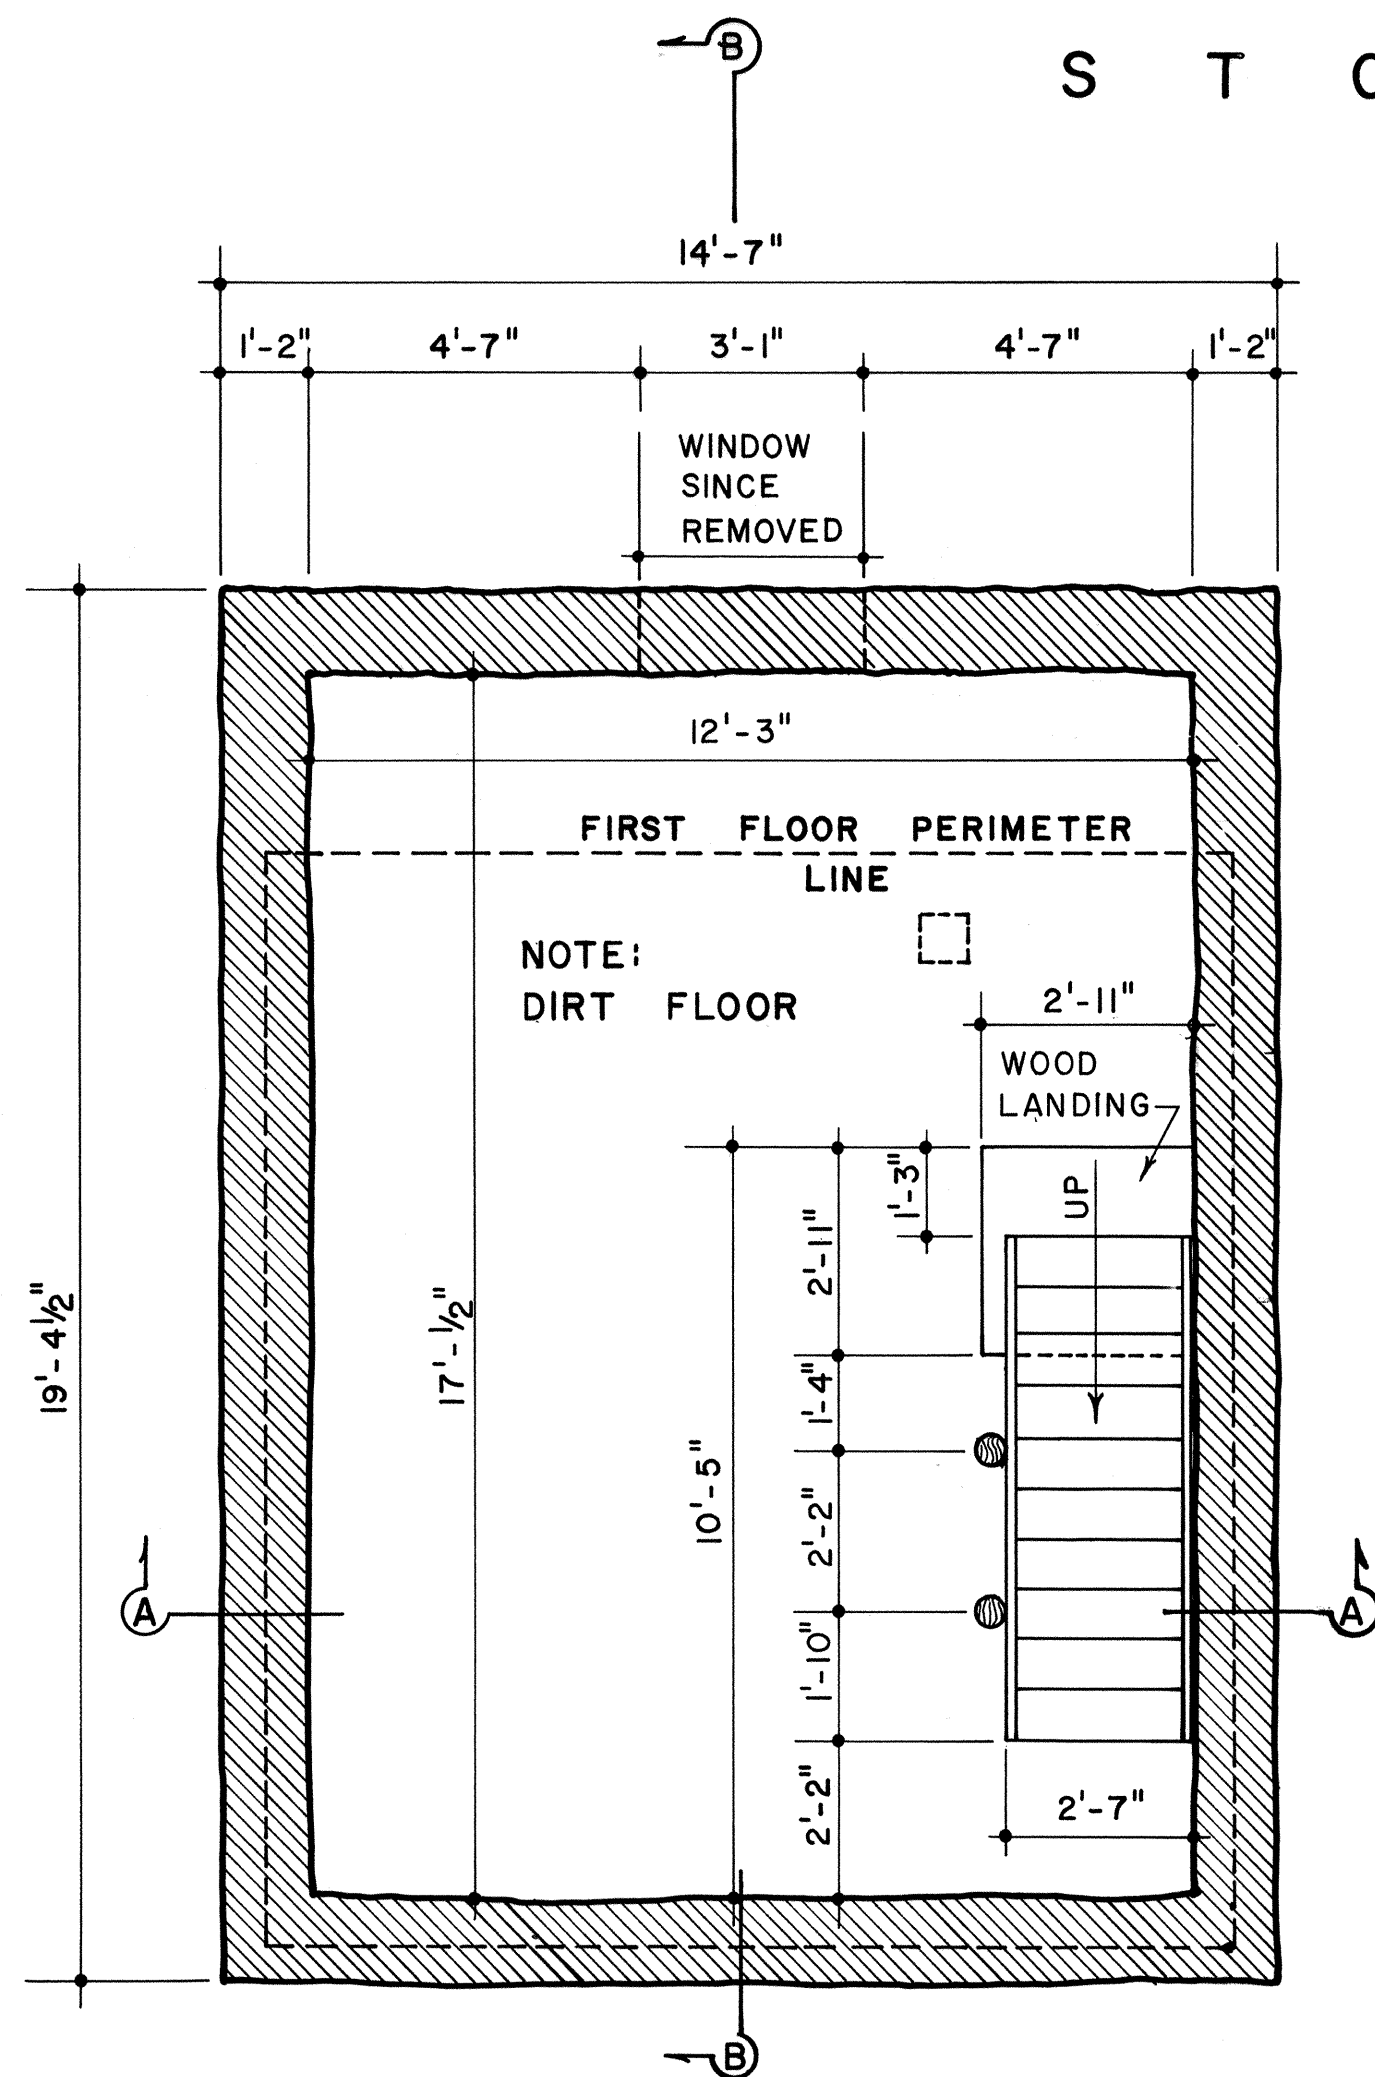

C E L L A R P L A N

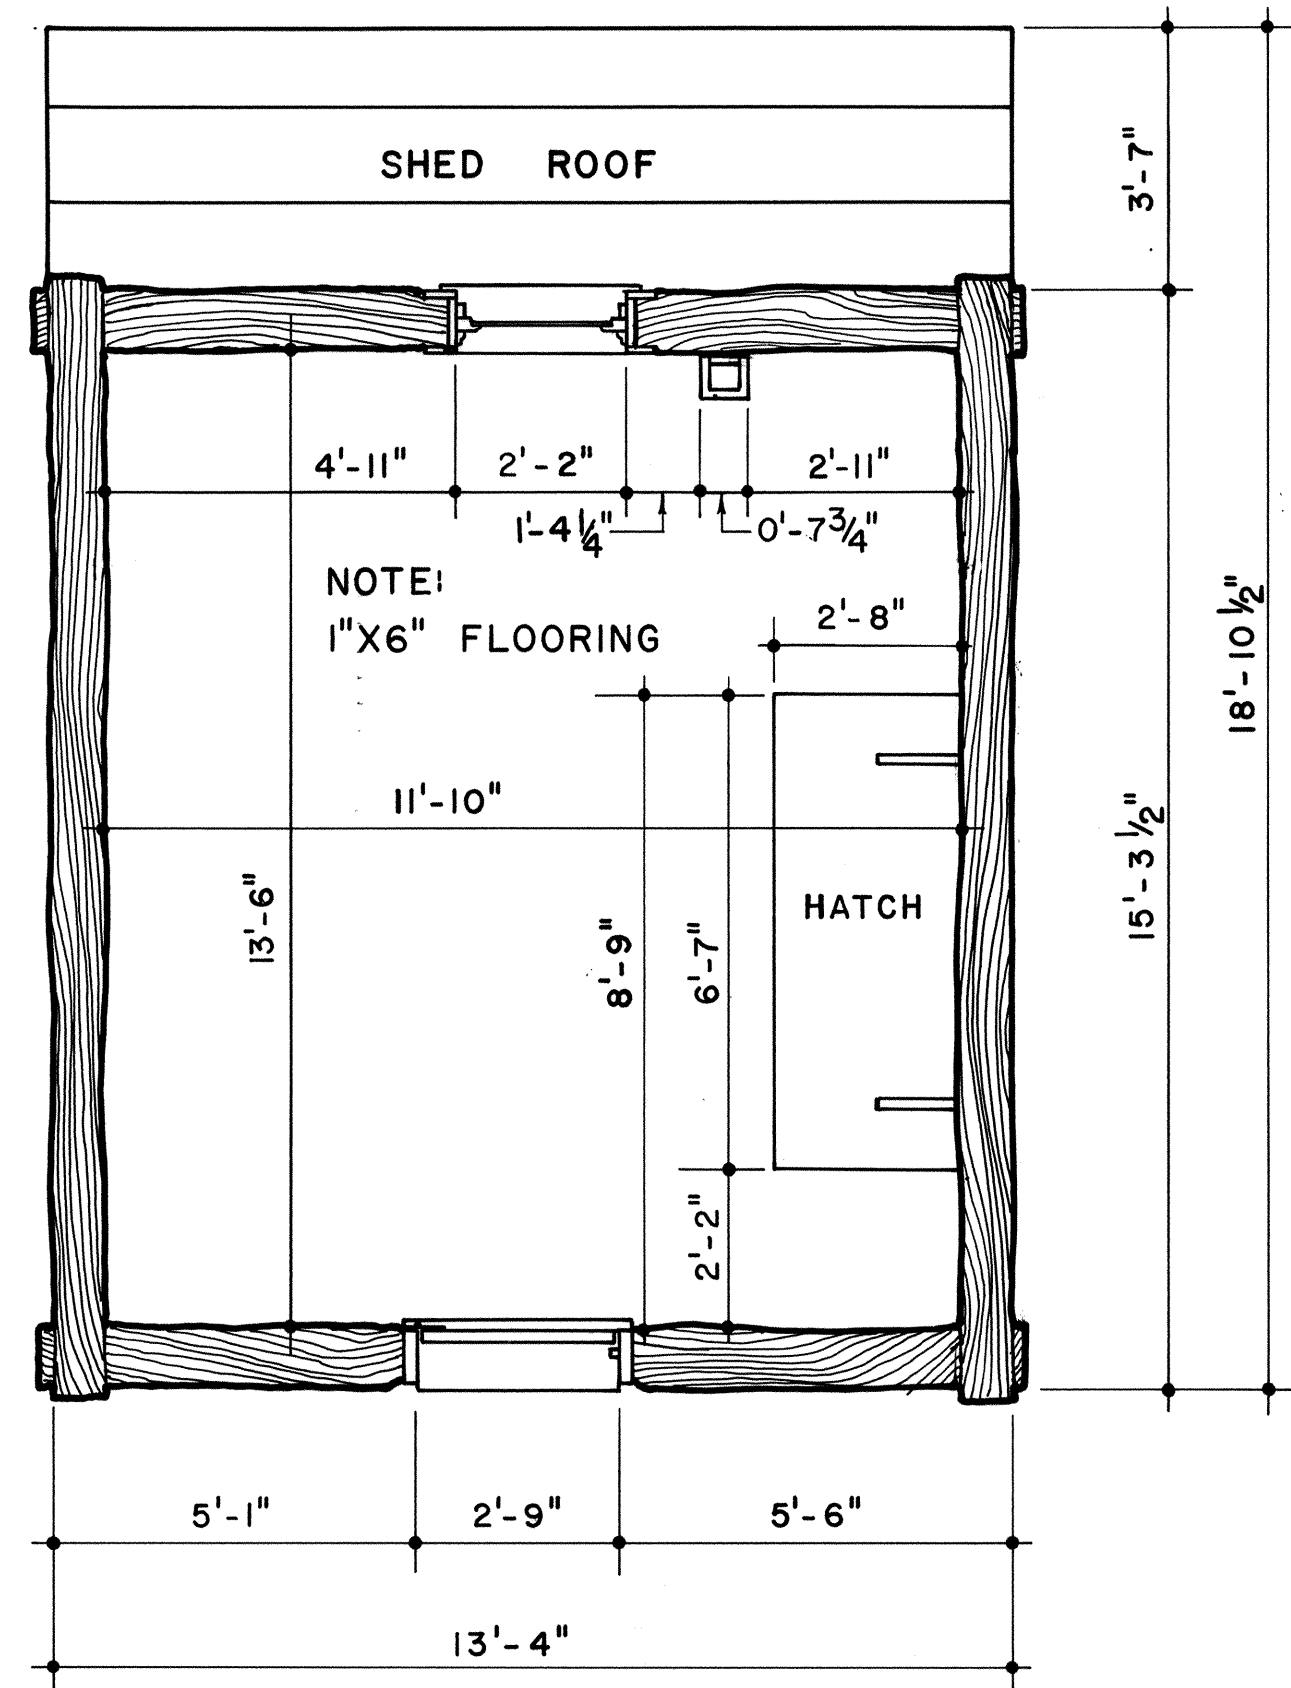

F L O O R P L A N

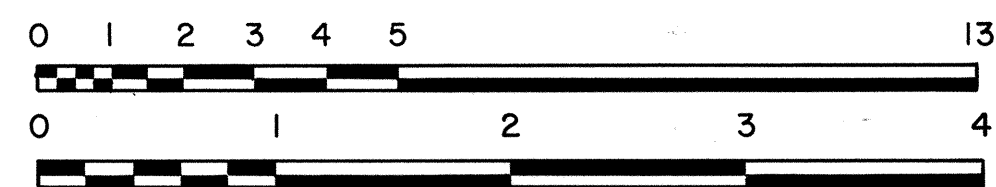

DRAWN BY: DURWARD K. SOBEK

WESTERN OFFICE
SAN FRANCISCO, CALIFORNIA
UNDER DIRECTION OF THE NATIONAL PARK SERVICE,
UNITED STATES DEPARTMENT OF THE INTERIOR


NAME AND LOCATION OF STRUCTURE
M E N O R S F E R R Y
GRAND TETON NATIONAL PARK MOOSE, WYOMING

SURVEY NO.
WYO 24


HISTORIC AMERICAN
BUILDINGS SURVEY
SHEET 3 OF 12 SHEETS

LIBRARY OF CONGRESS
INDEX NUMBER


STORAGE BUILDING ELEVATIONS

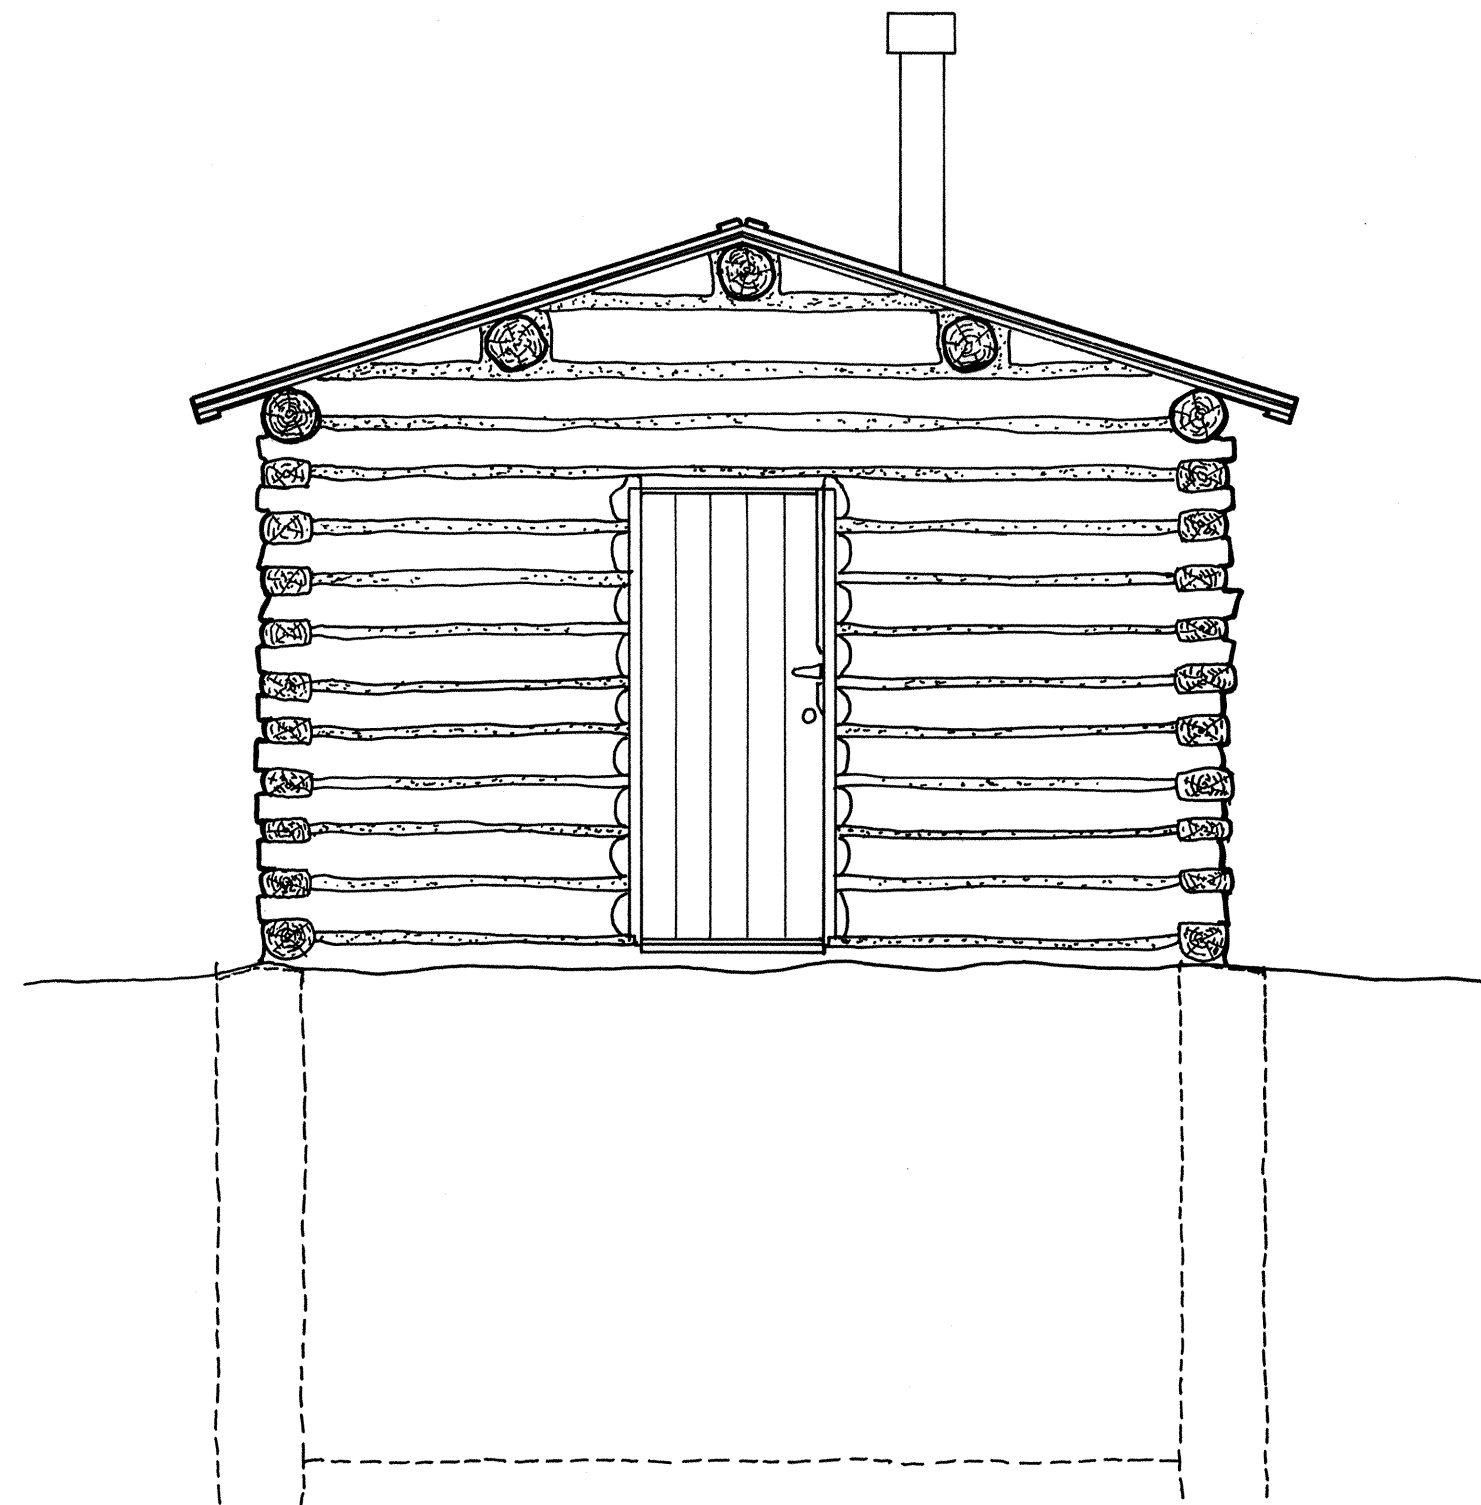

WEST ELEVATION

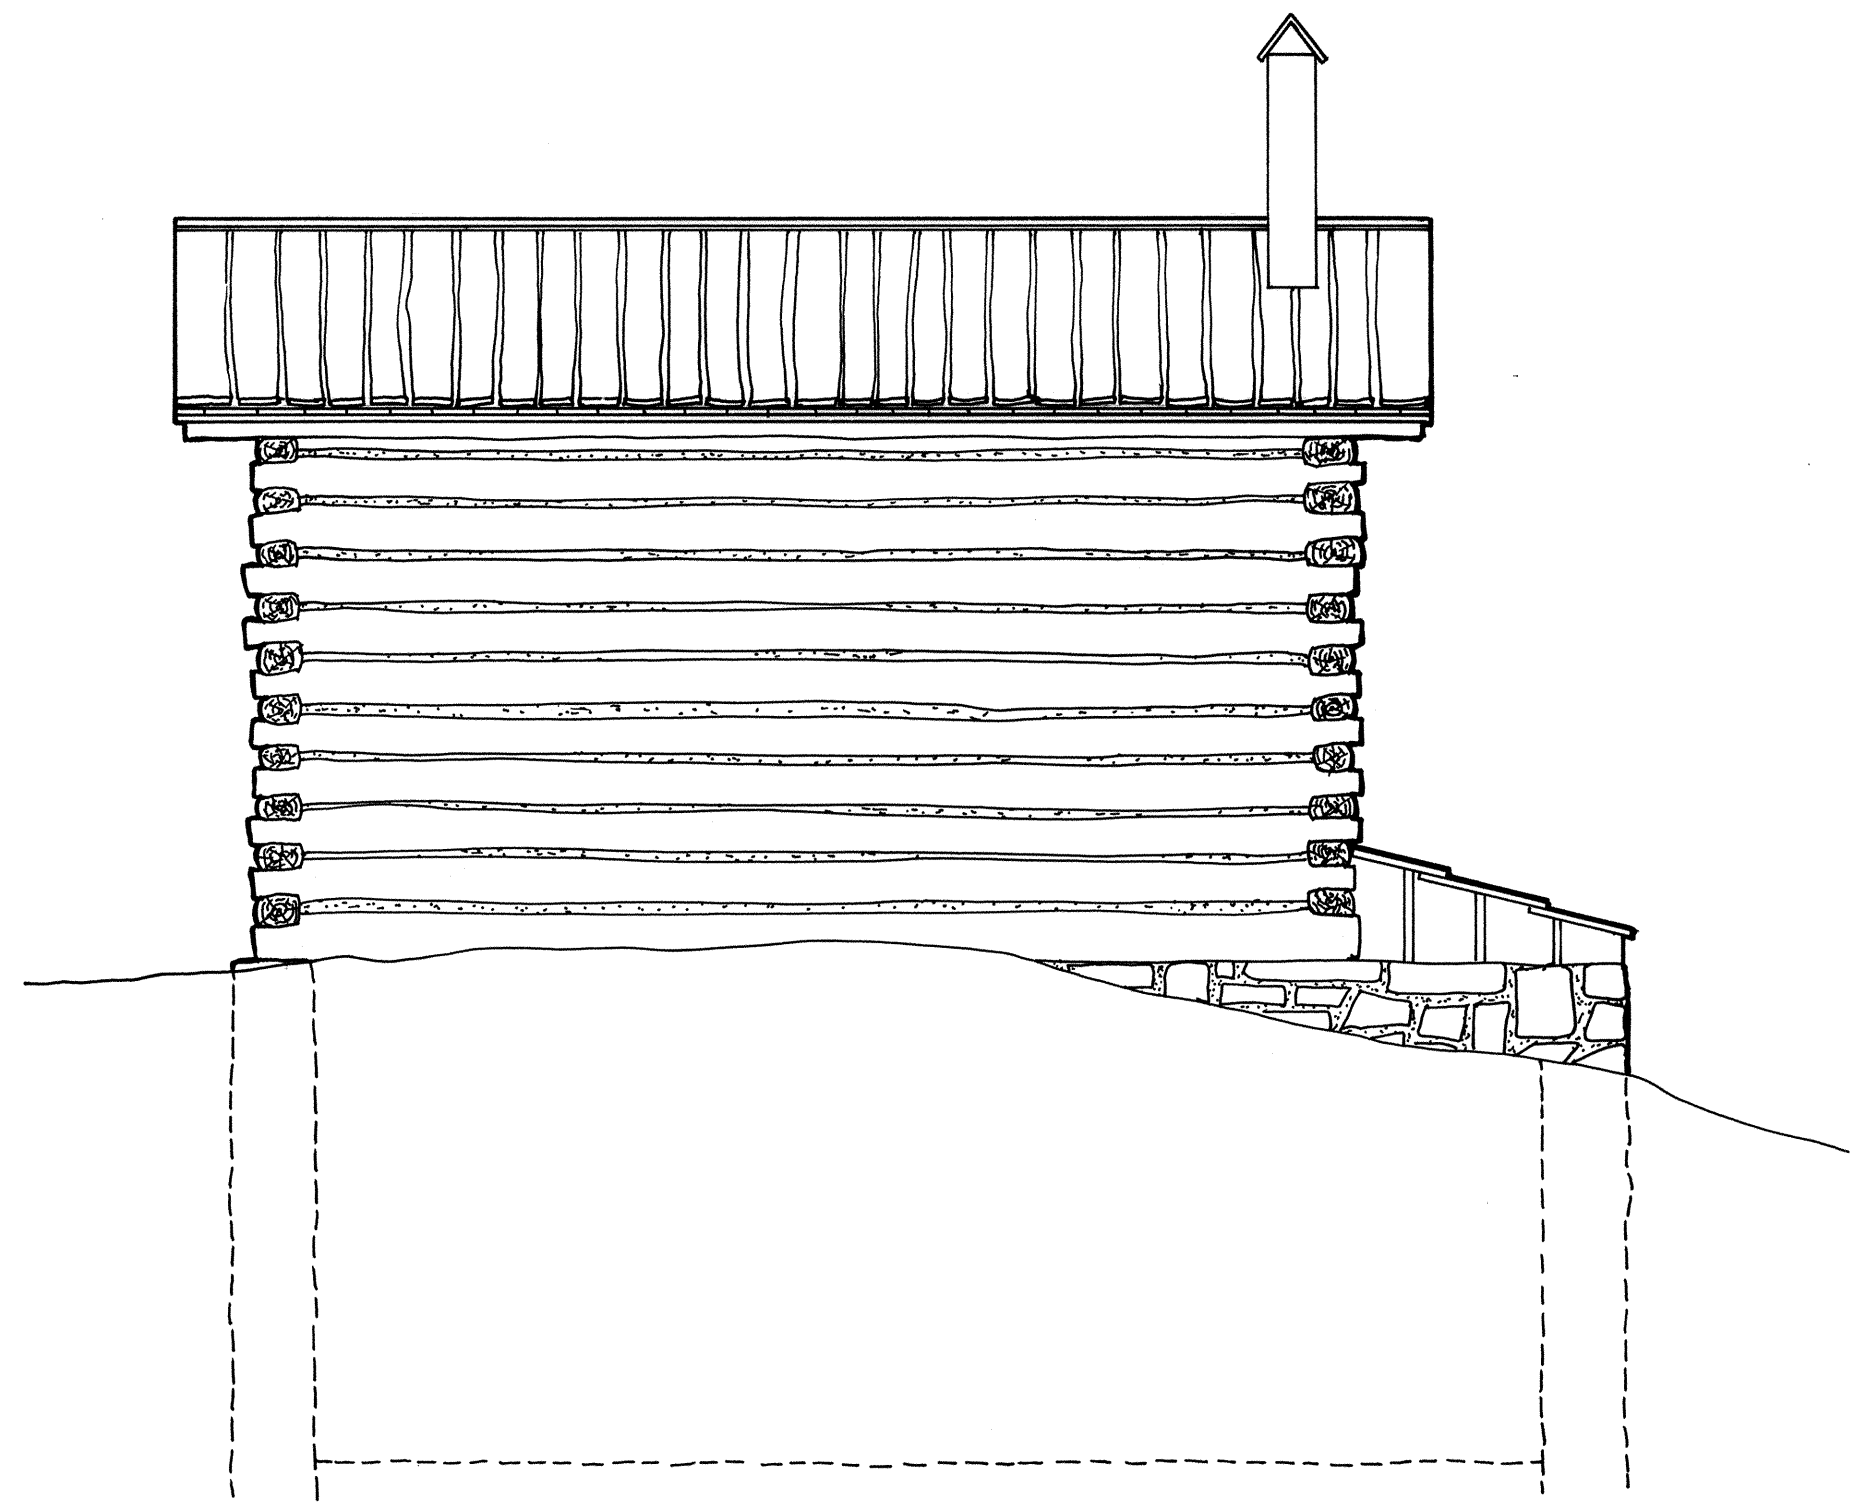

SOUTH ELEVATION

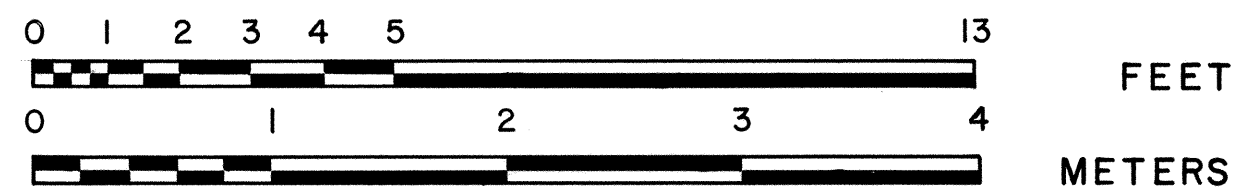

DRAWN BY: DURWARD K. SOBEK

WESTERN OFFICE
SAN FRANCISCO, CALIFORNIA
UNDER DIRECTION OF THE NATIONAL PARK SERVICE,
UNITED STATES DEPARTMENT OF THE INTERIOR

NAME AND LOCATION OF STRUCTURE


MENOR'S FERRY
GRAND TETON NATIONAL PARK MOOSE, WYOMING

SURVEY NO.
WYO 24


HISTORIC AMERICAN
BUILDINGS SURVEY
SHEET 4 OF 12 SHEETS

LIBRARY OF CONGRESS
INDEX NUMBER


STORAGE BUILDING ELEVATIONS

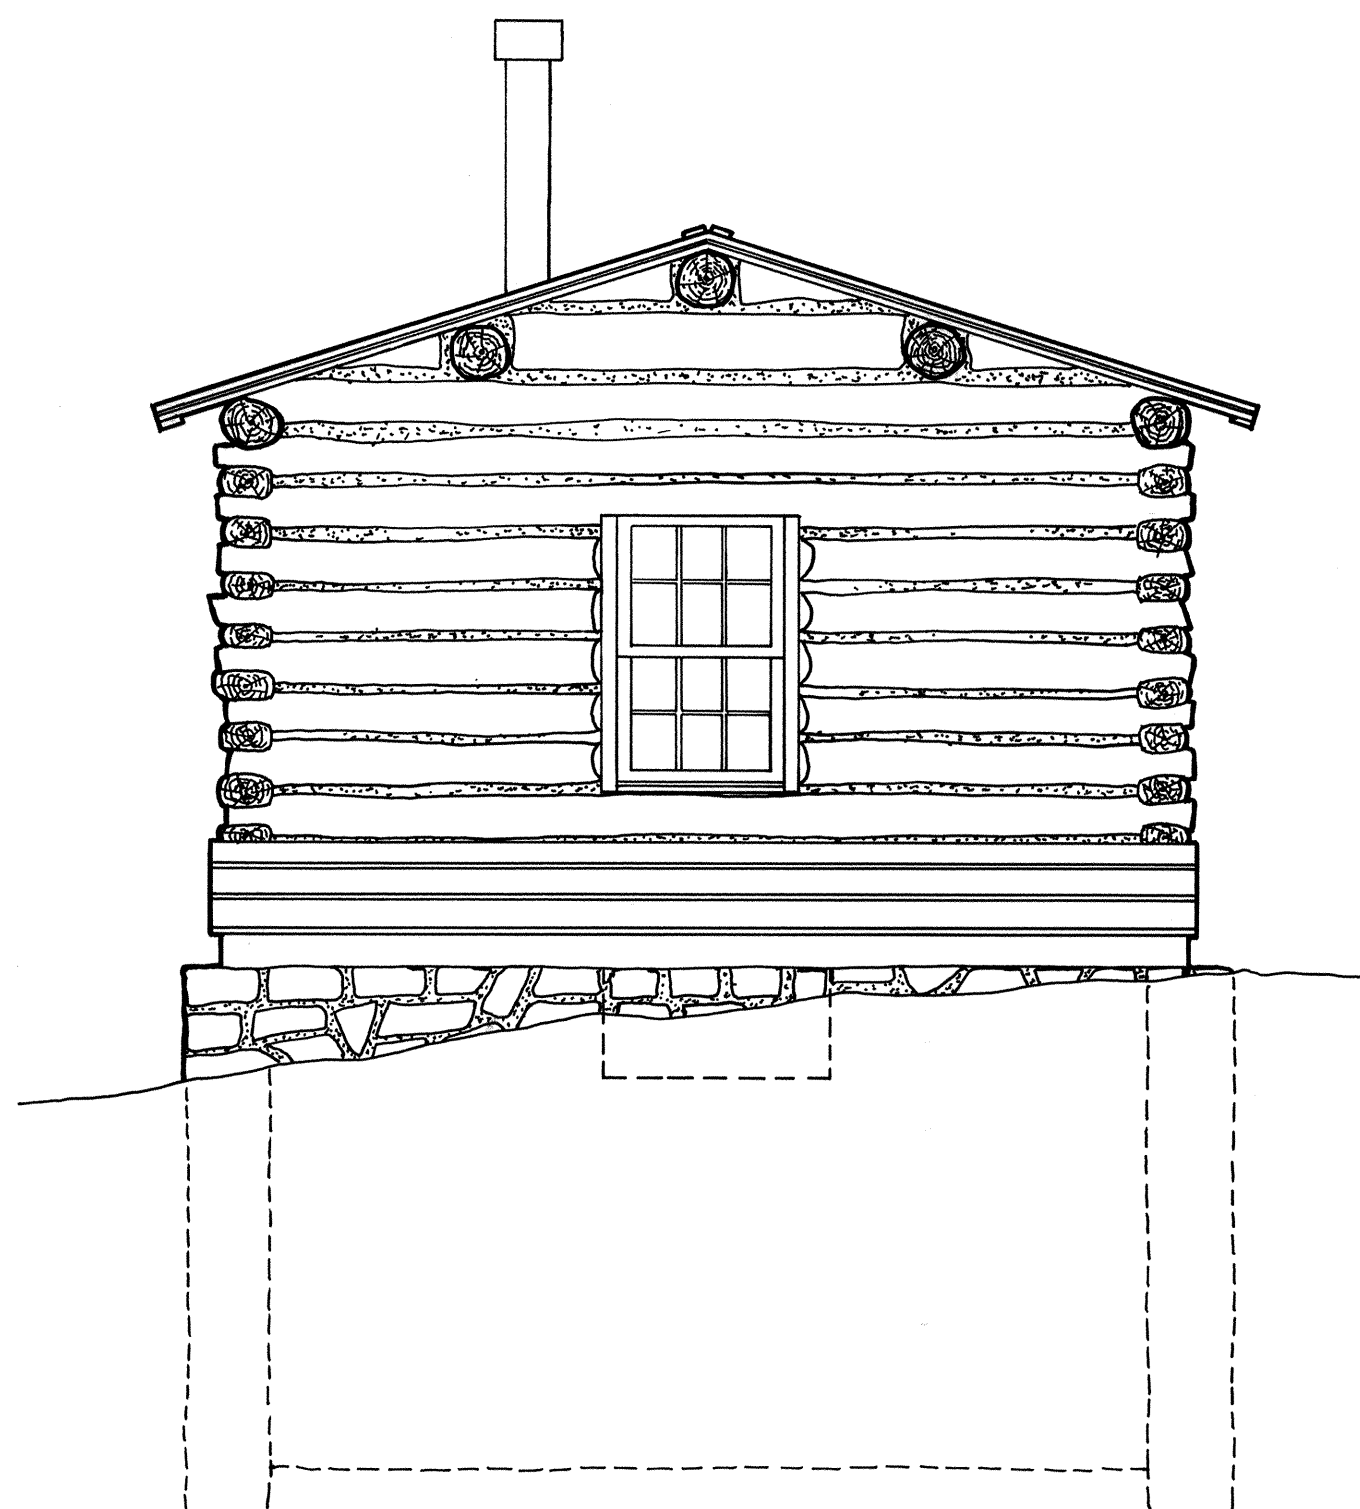

EAST ELEVATION

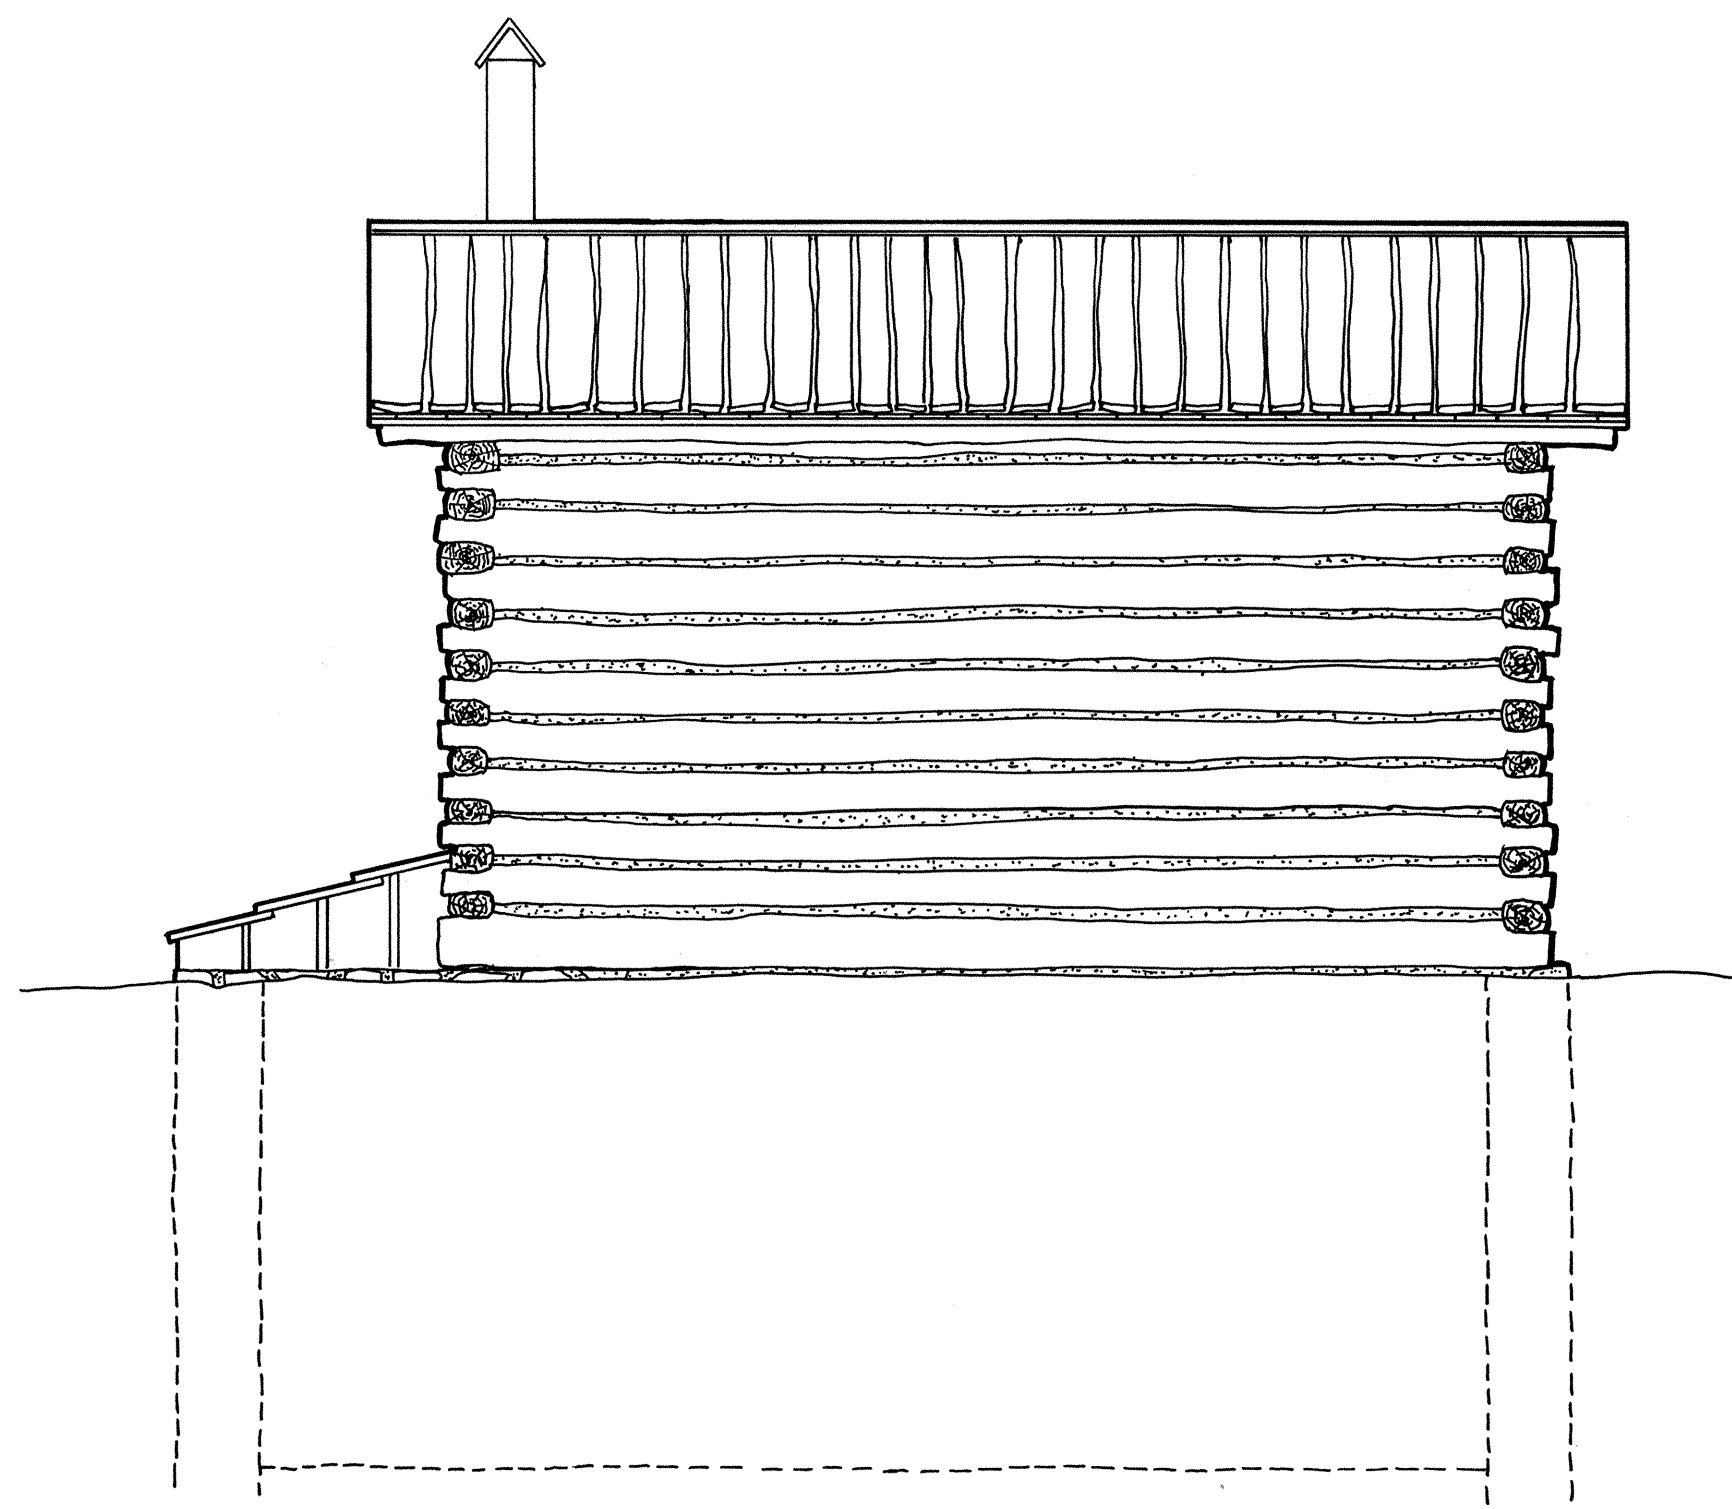

NORTH ELEVATION

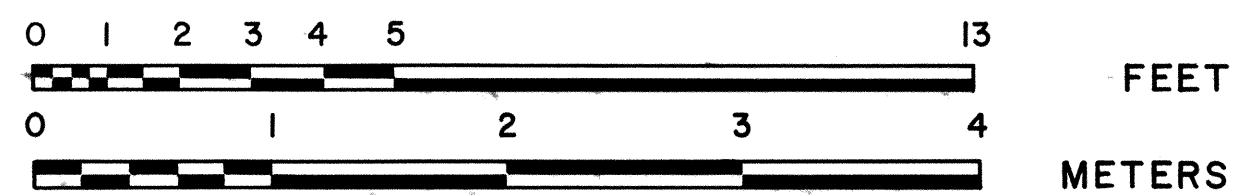

DRAWN BY: DURWARD K. SOBEK

WESTERN OFFICE
SAN FRANCISCO, CALIFORNIA
UNDER DIRECTION OF THE NATIONAL PARK SERVICE,
UNITED STATES DEPARTMENT OF THE INTERIOR

NAME AND LOCATION OF STRUCTURE

MENOR'S FERRY
GRAND TETON NATIONAL PARK MOOSE, WYOMING


SURVEY NO.
WYO 24

HISTORIC AMERICAN
BUILDINGS SURVEY
SHEET 5 OF 12 SHEETS


LIBRARY OF CONGRESS
INDEX NUMBER

S T O R A G E B U I L D I N G


S E C T I O N S

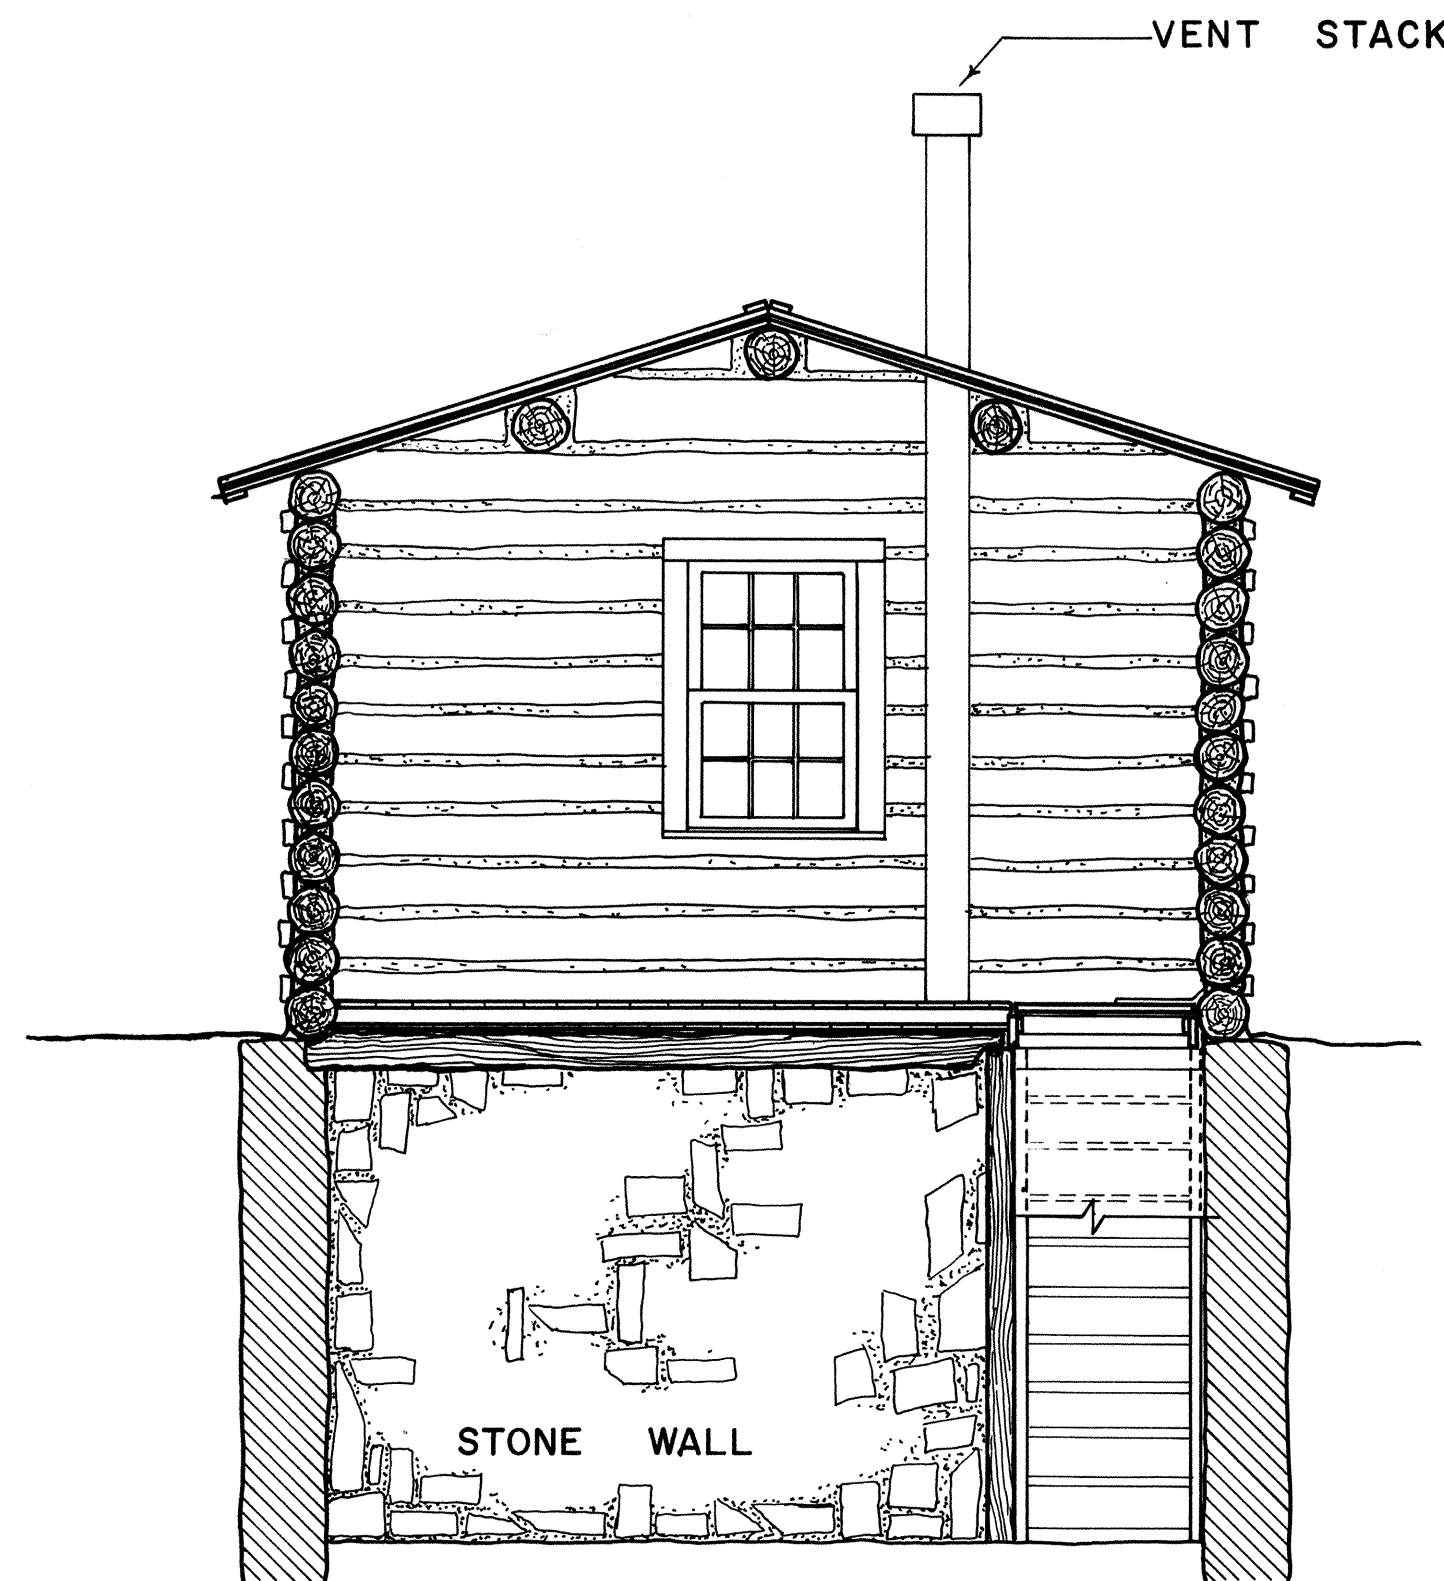

SECTION A-A

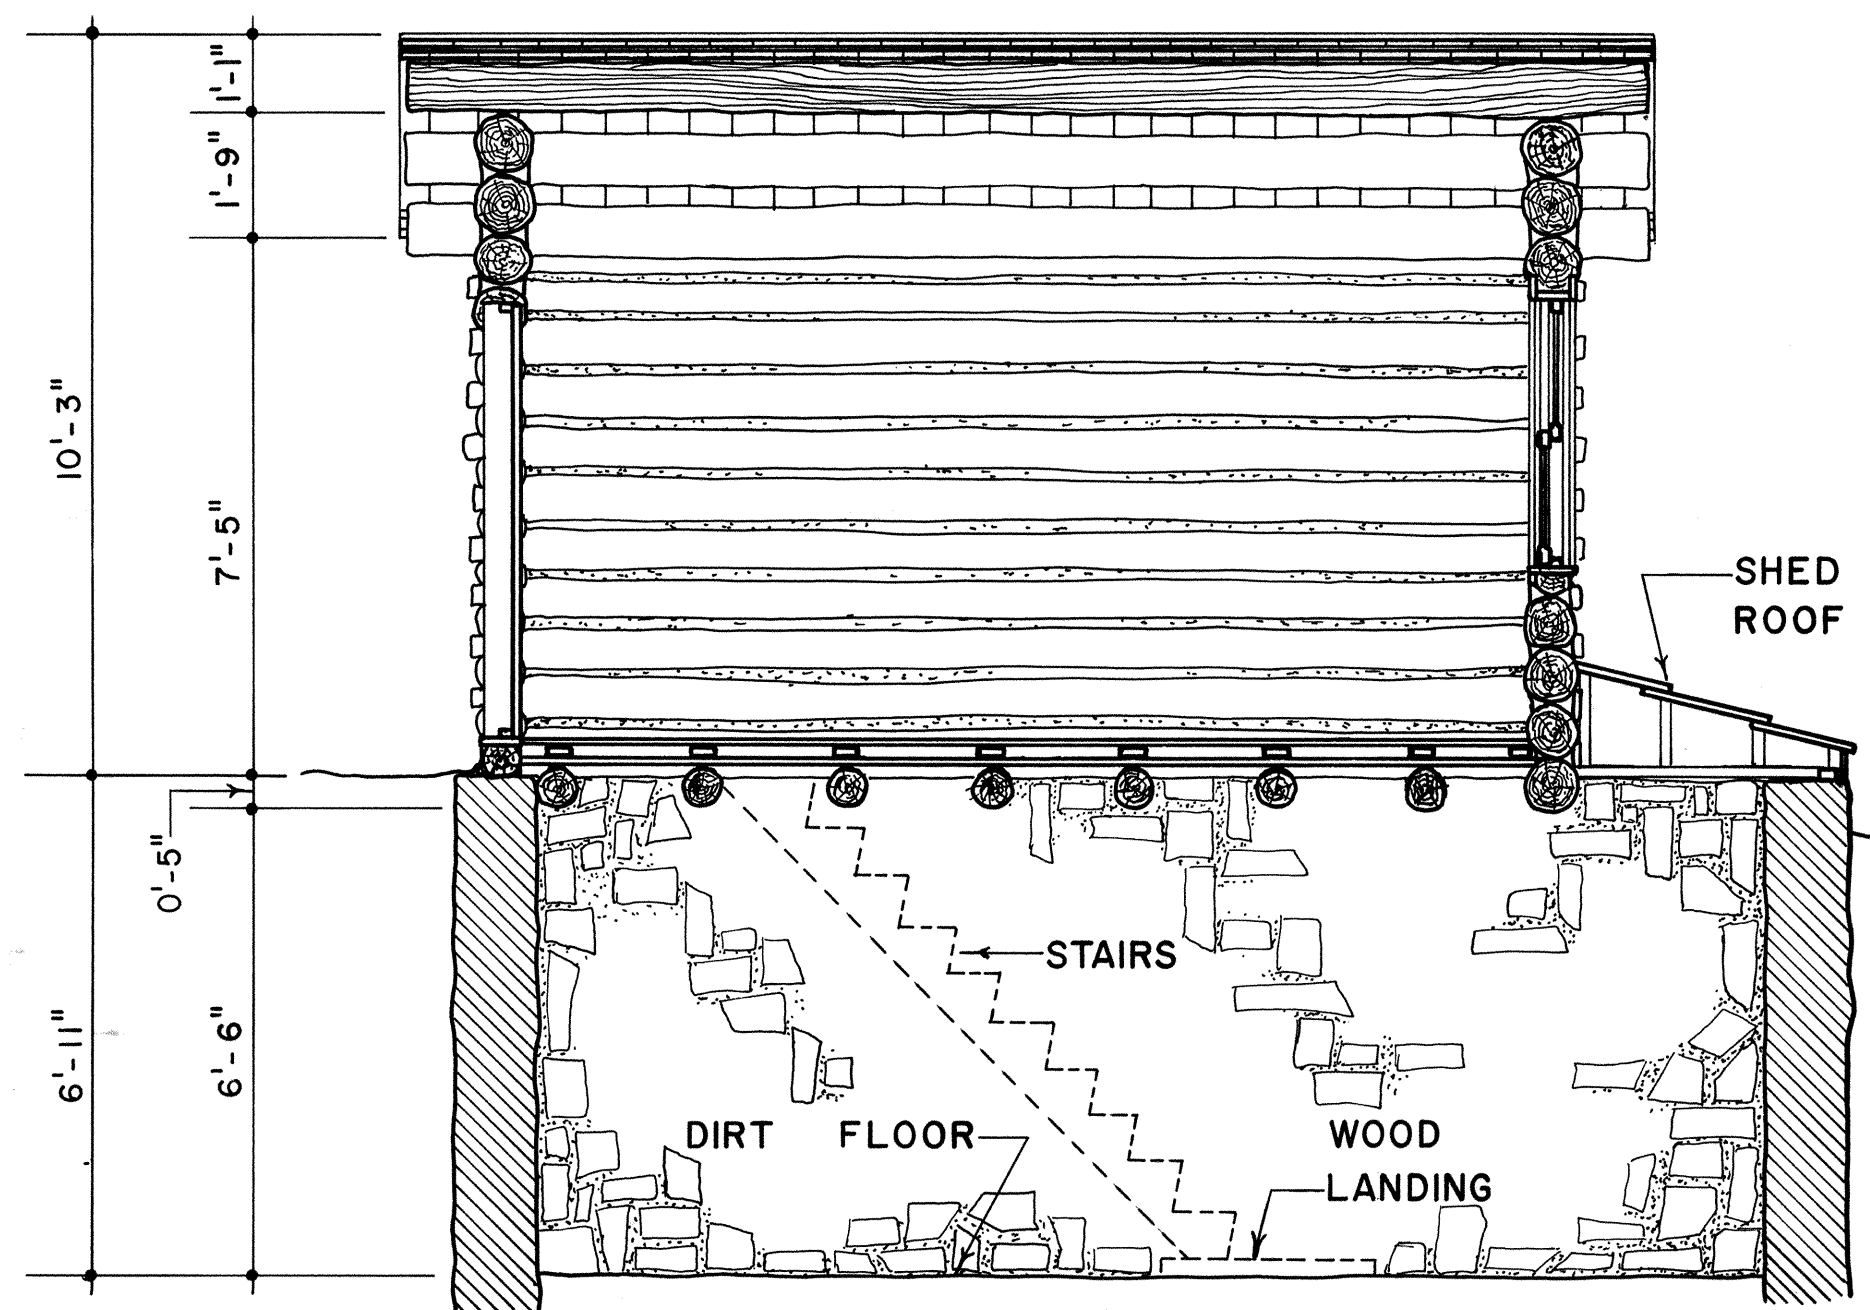

SECTION B-B

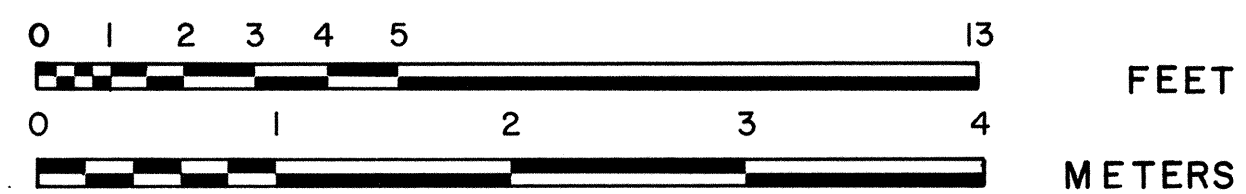

DRAWN BY: DURWARD K. SOBEK

WESTERN OFFICE
SAN FRANCISCO, CALIFORNIA
UNDER DIRECTION OF THE NATIONAL PARK SERVICE,
UNITED STATES DEPARTMENT OF THE INTERIOR

NAME AND LOCATION OF STRUCTURE

M E N O R ' S F E R R Y

GRAND TETON NATIONAL PARK MOOSE, WYOMING


SURVEY NO.
WYO 24

HISTORIC AMERICAN
BUILDINGS SURVEY
SHEET 6 OF 12 SHEETS


LIBRARY OF CONGRESS
INDEX NUMBER

S T O R A G E B U I L D I N G


D O O R D E T A I L W I N D O W D E T A I L

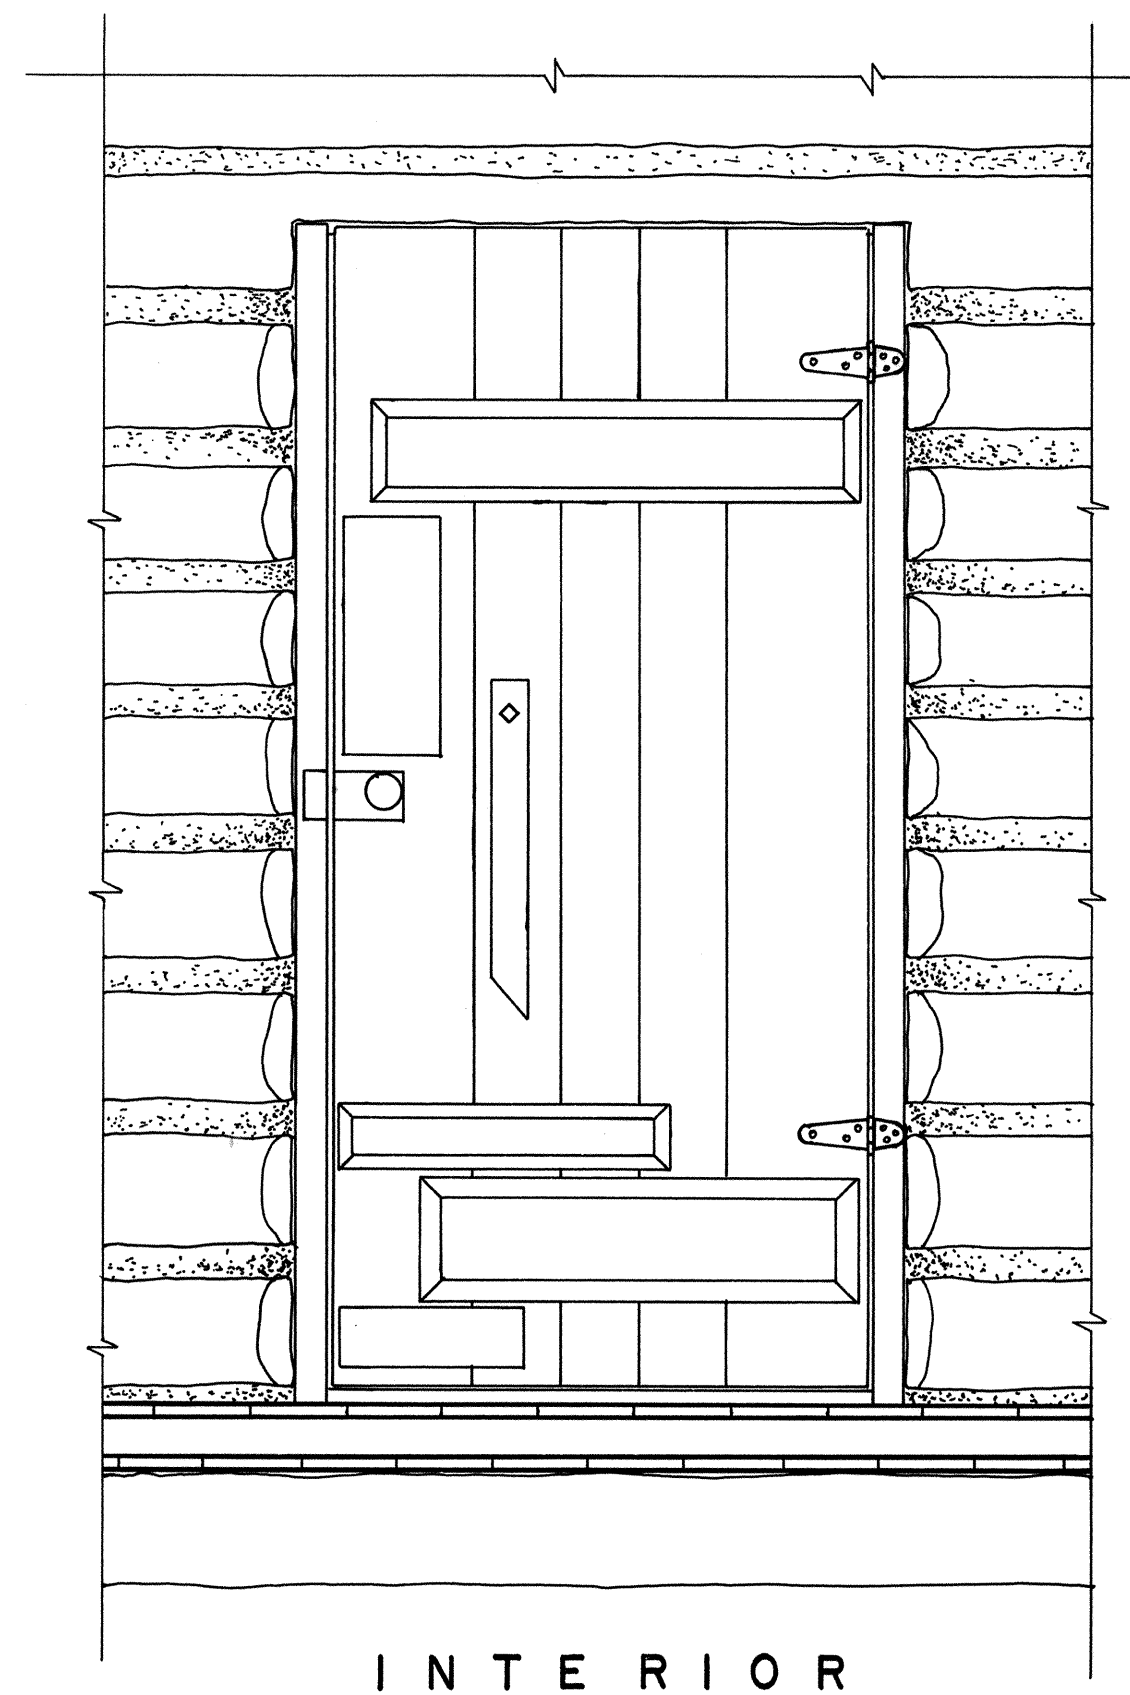

I N T E R I O R

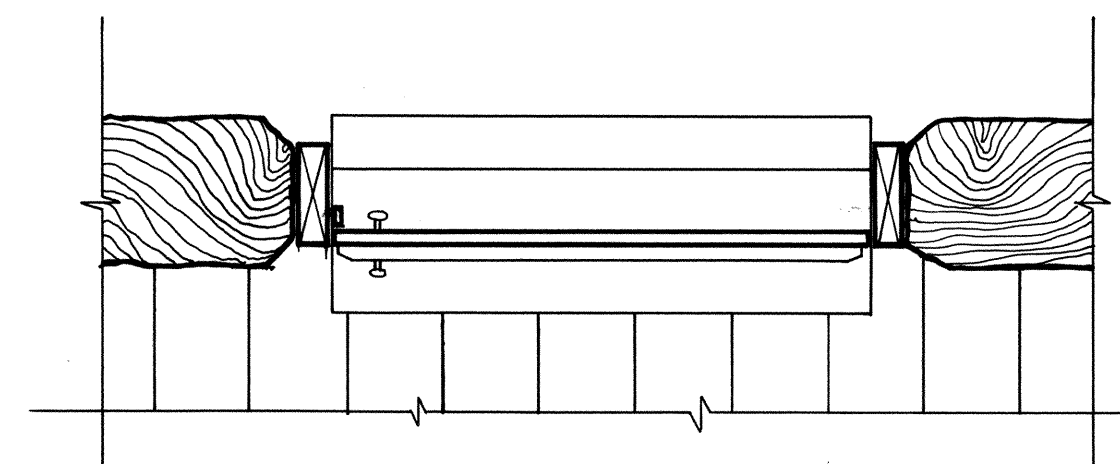


P L A N S E C T I O N

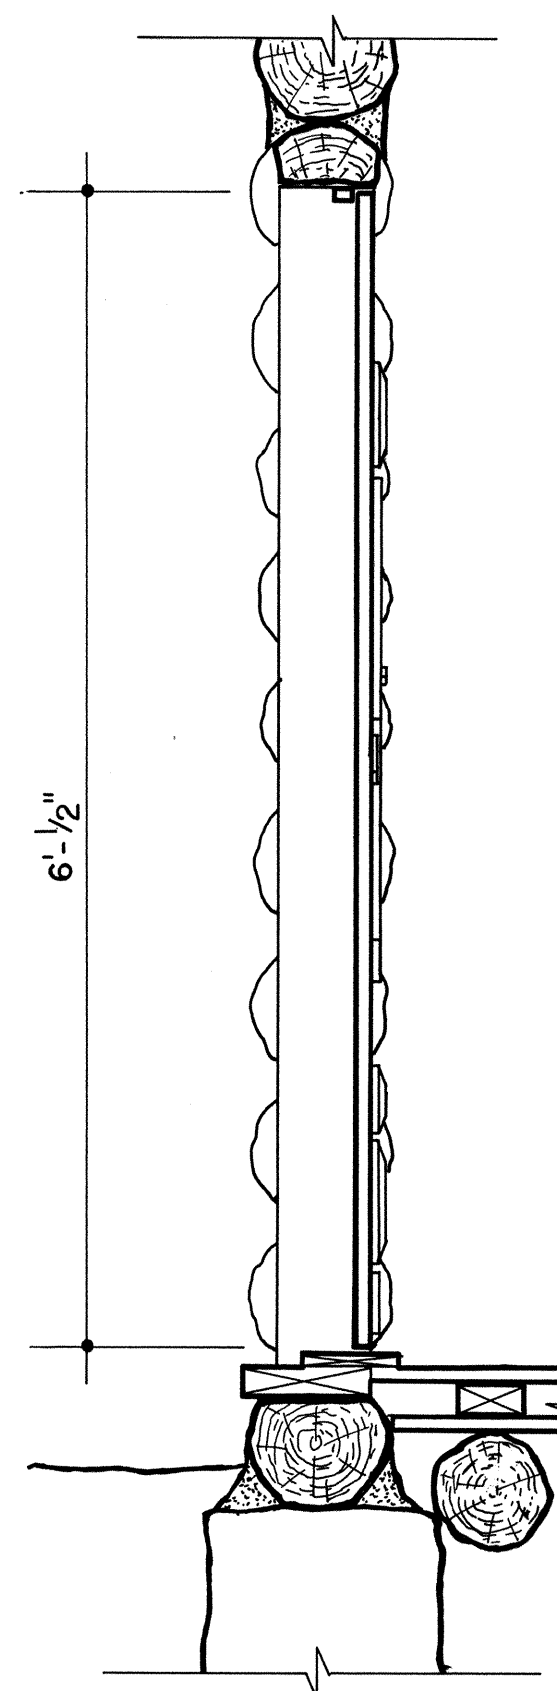


6'-1/2"


S E C T I O N

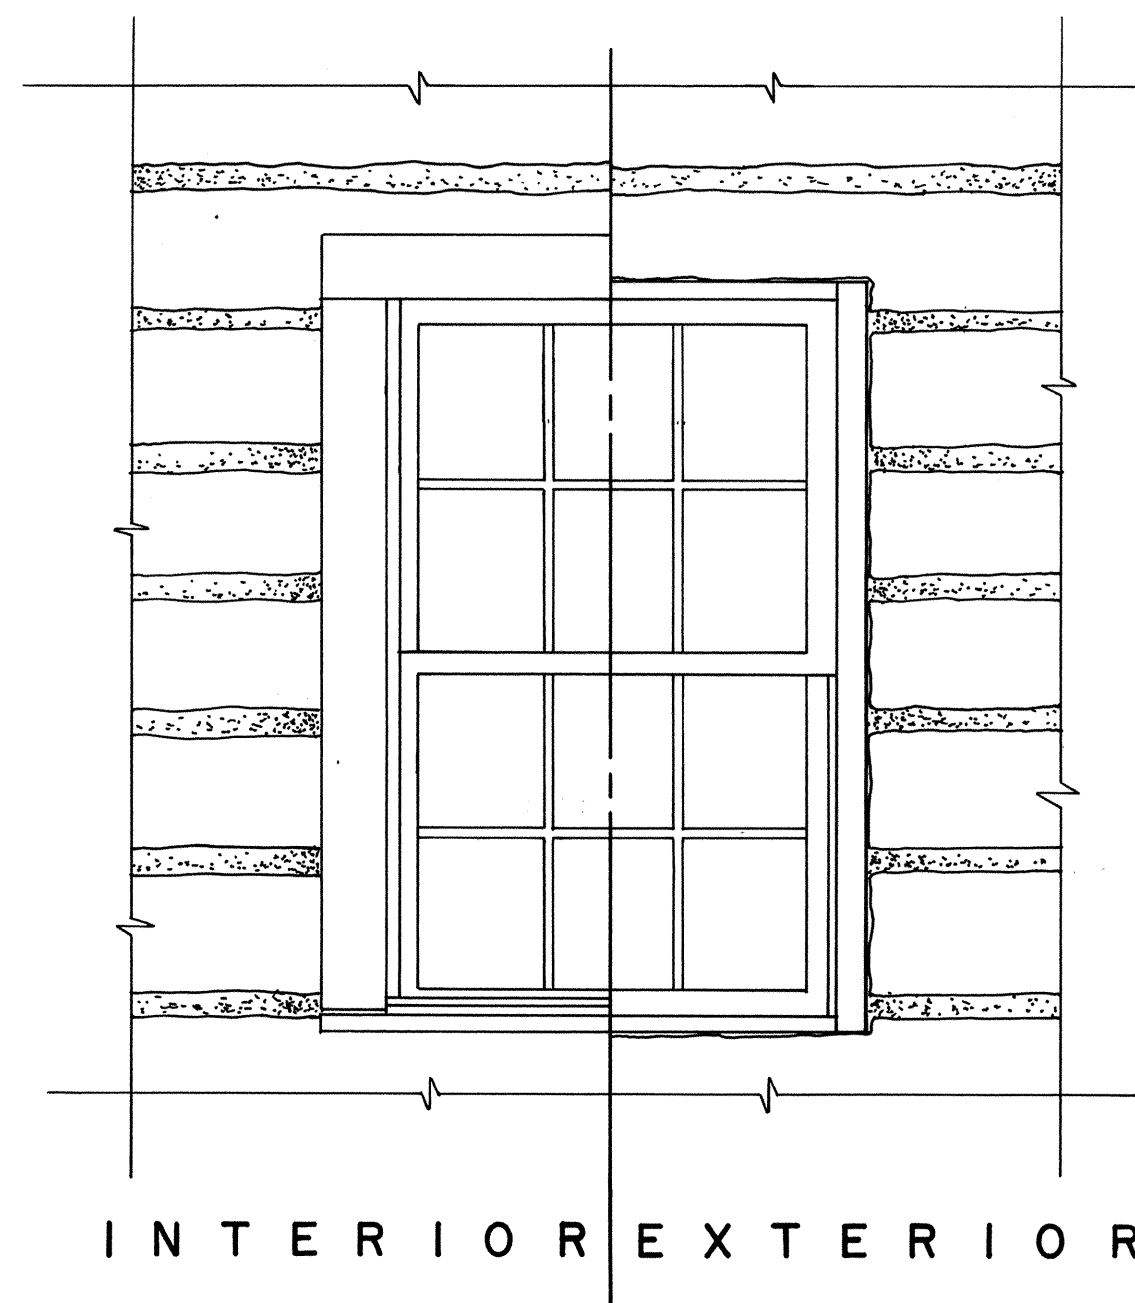


I N T E R I O R E X T E R I O R S E C T I O N

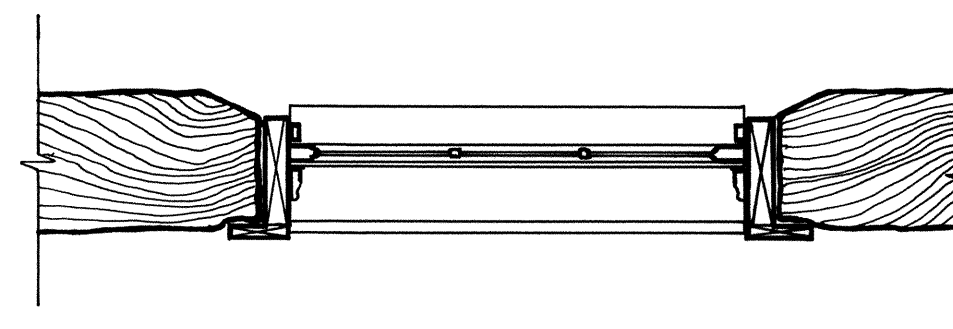

P L A N S E C T I O N

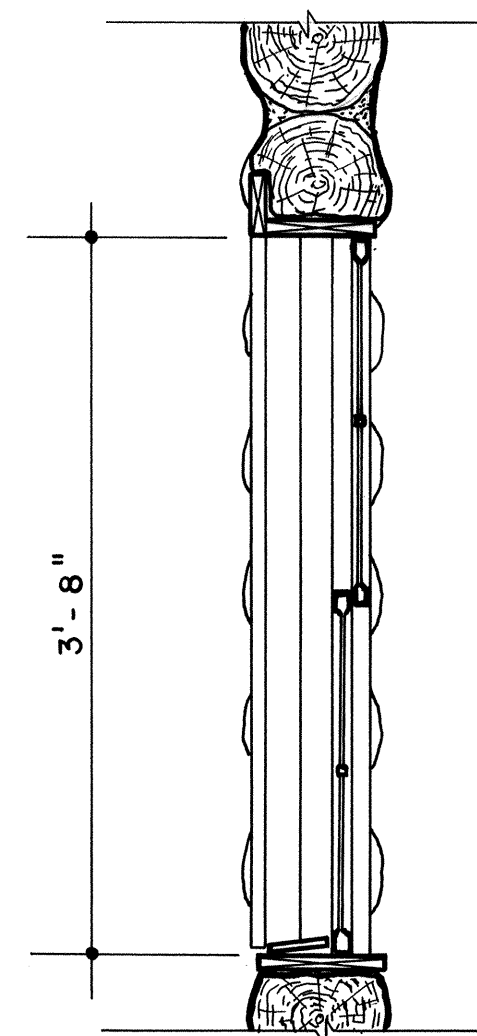

3'-8"

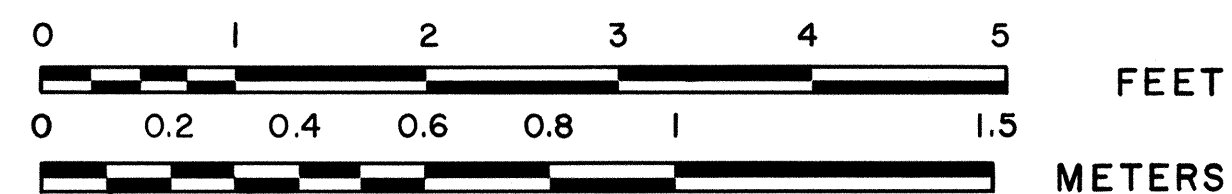

DRAWN BY: DURWARD K. SOBEK


WESTERN OFFICE
SAN FRANCISCO, CALIFORNIA
UNDER DIRECTION OF THE NATIONAL PARK SERVICE,
UNITED STATES DEPARTMENT OF THE INTERIOR

NAME AND LOCATION OF STRUCTURE
M E N O R ' S F E R R Y
GRAND TETON NATIONAL PARK MOOSE, WYOMING

SURVEY NO.
WYO 24

HISTORIC AMERICAN
BUILDINGS SURVEY
SHEET 7 OF 12 SHEETS

LIBRARY OF CONGRESS
INDEX NUMBER

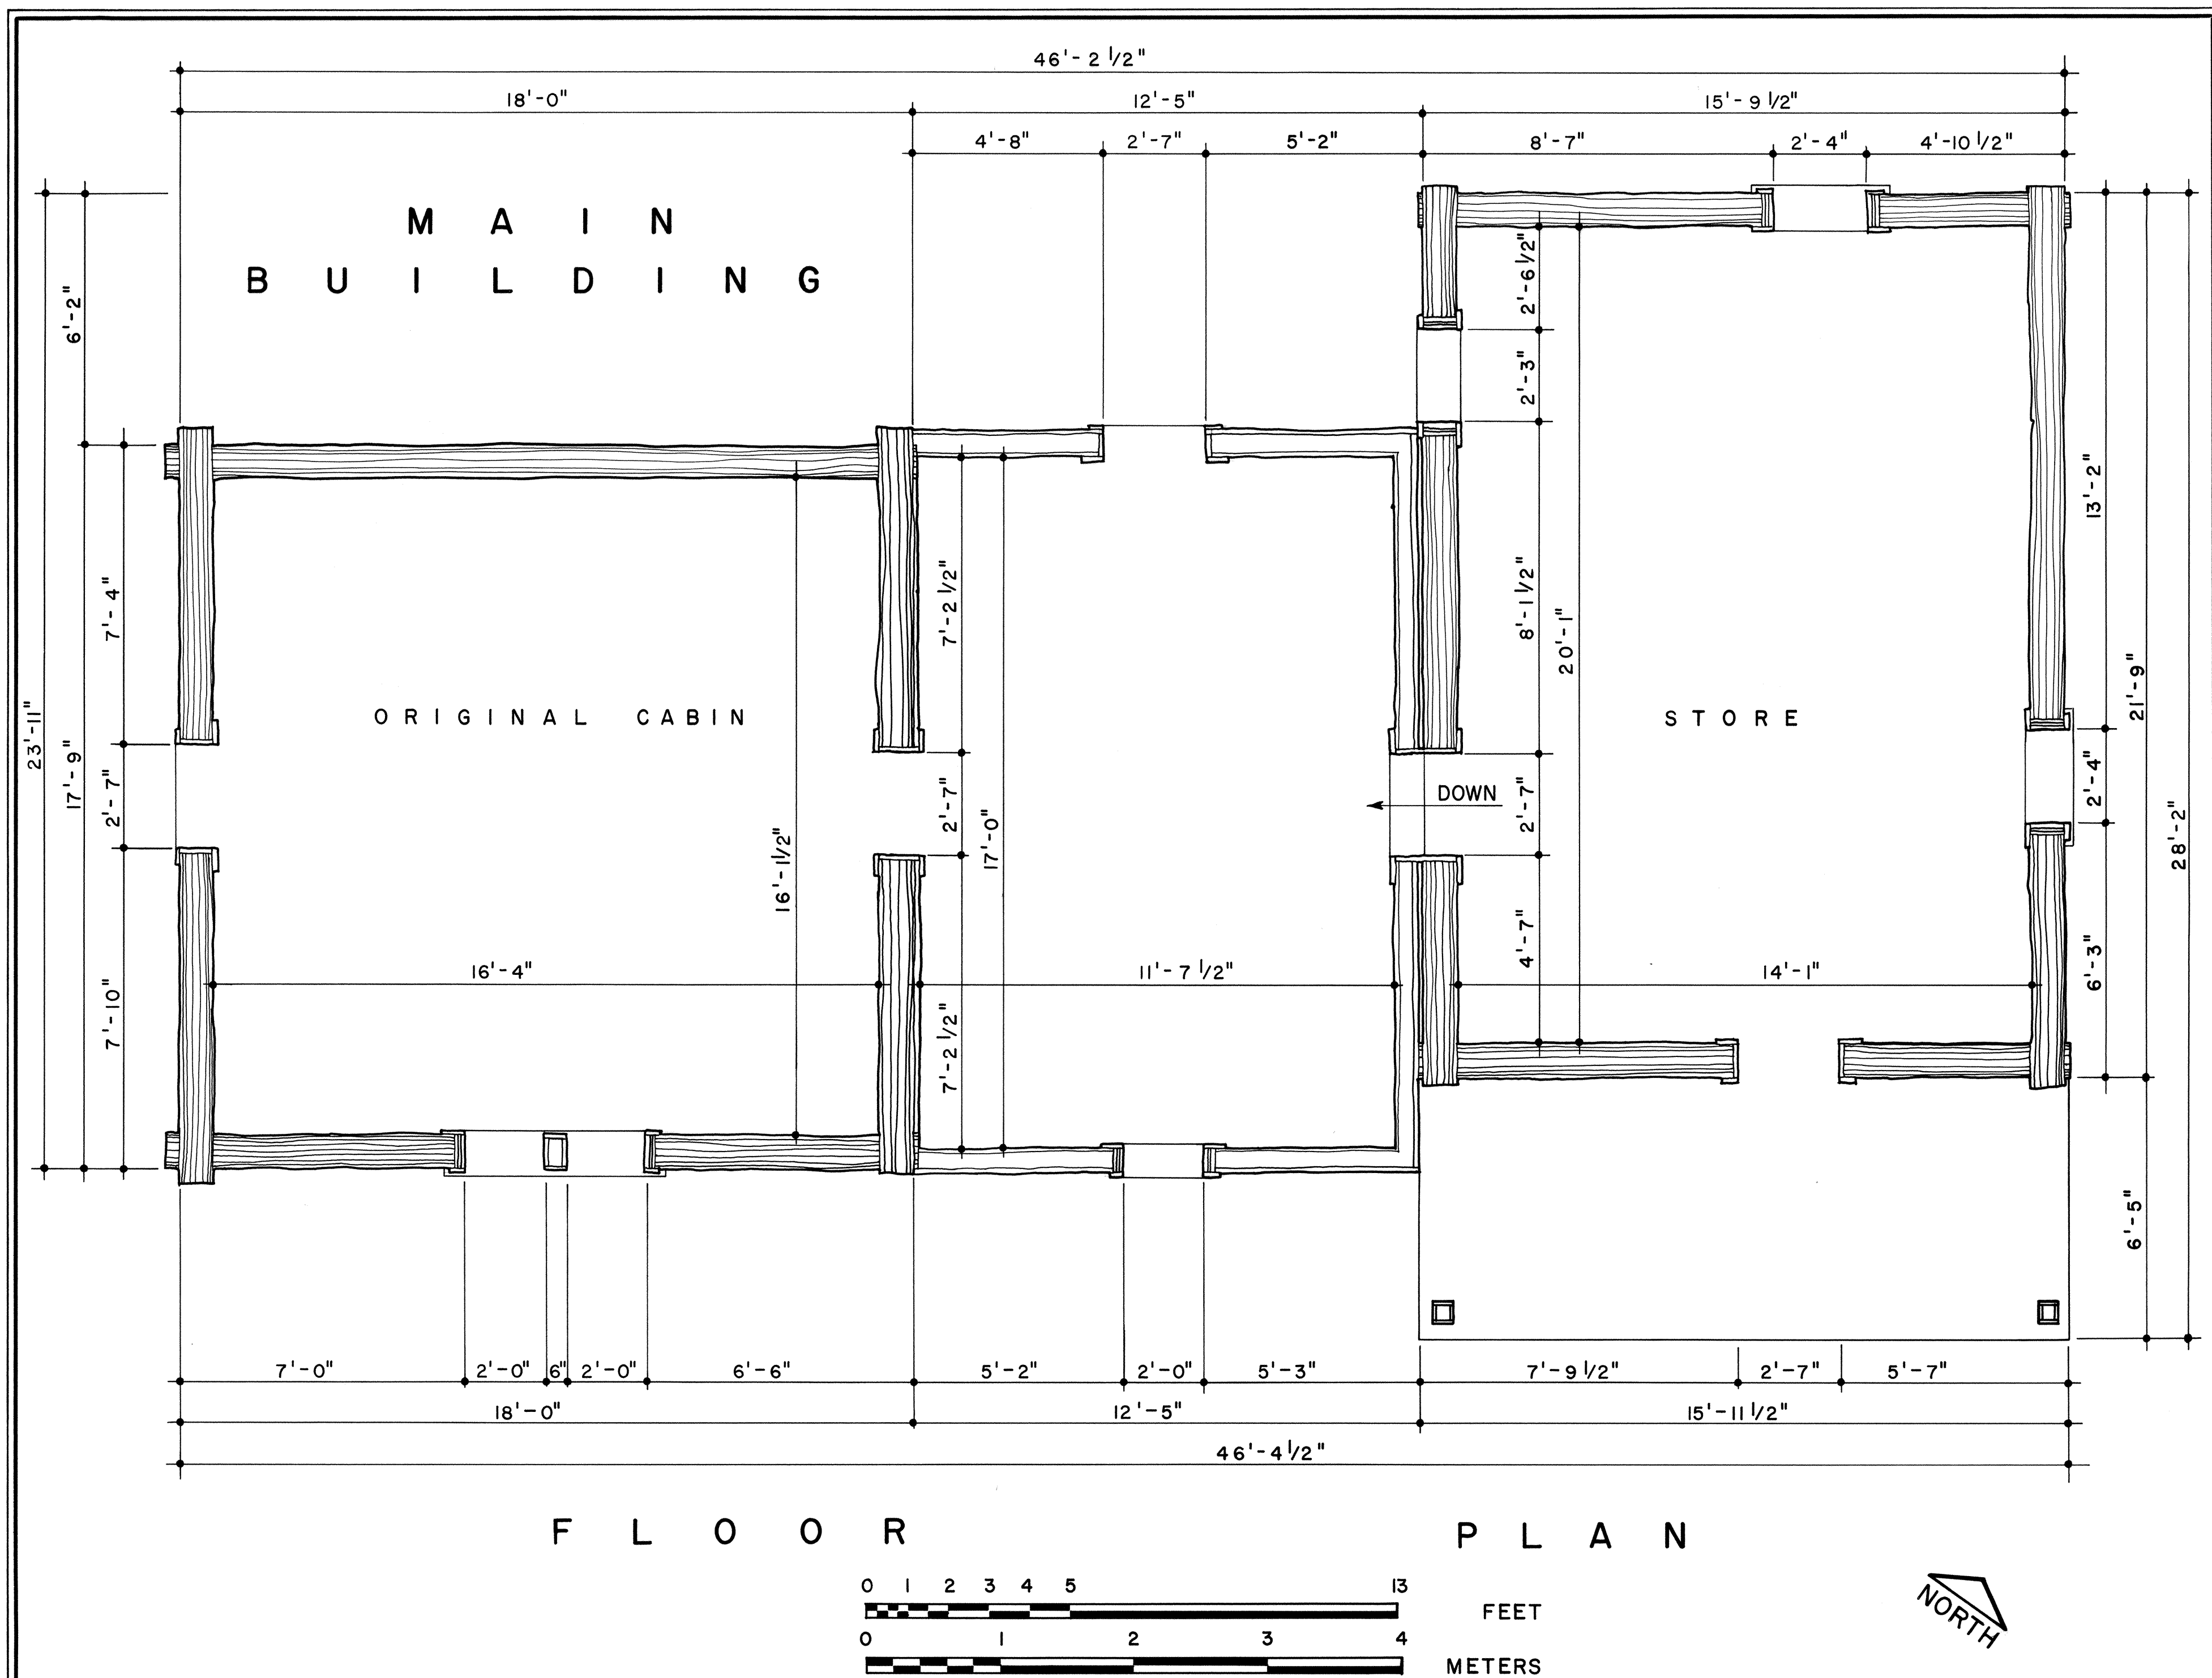

DRAWN BY: JACK OYAMA

WESTERN OFFICE
SAN FRANCISCO, CALIFORNIA
UNDER DIRECTION OF THE NATIONAL PARK SERVICE,
UNITED STATES DEPARTMENT OF THE INTERIOR



NAME AND LOCATION OF STRUCTURE
MENORS FERRY
GRAND TETON NATIONAL PARK MOOSE, WYOMING

SURVEY NO.
WYO 24

HISTORIC AMERICAN
BUILDINGS SURVEY
SHEET 8 OF 12 SHEETS


LIBRARY OF CONGRESS
INDEX NUMBER

MAIN BUILDING ELEVATIONS

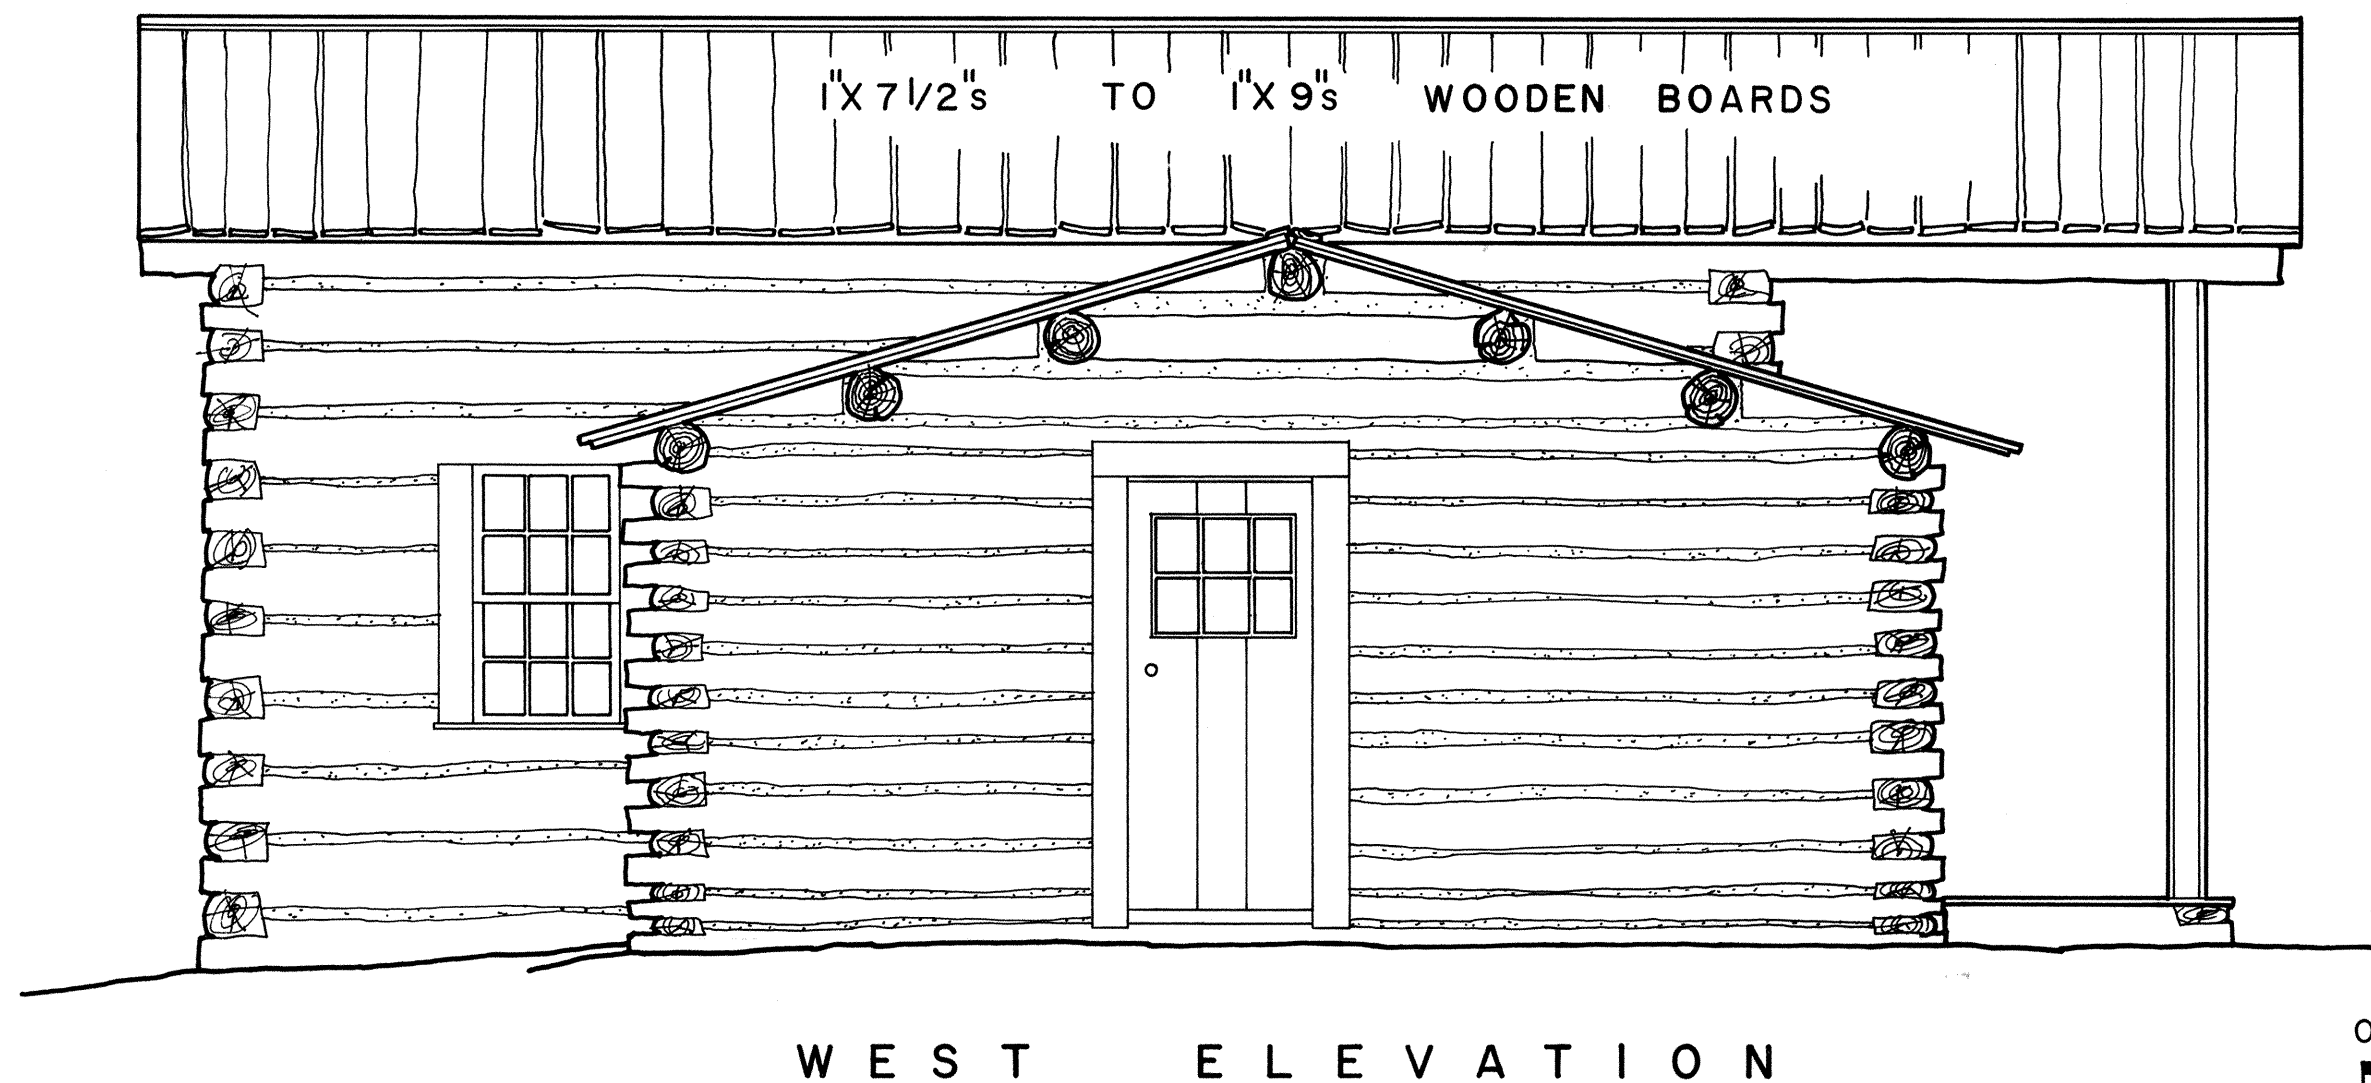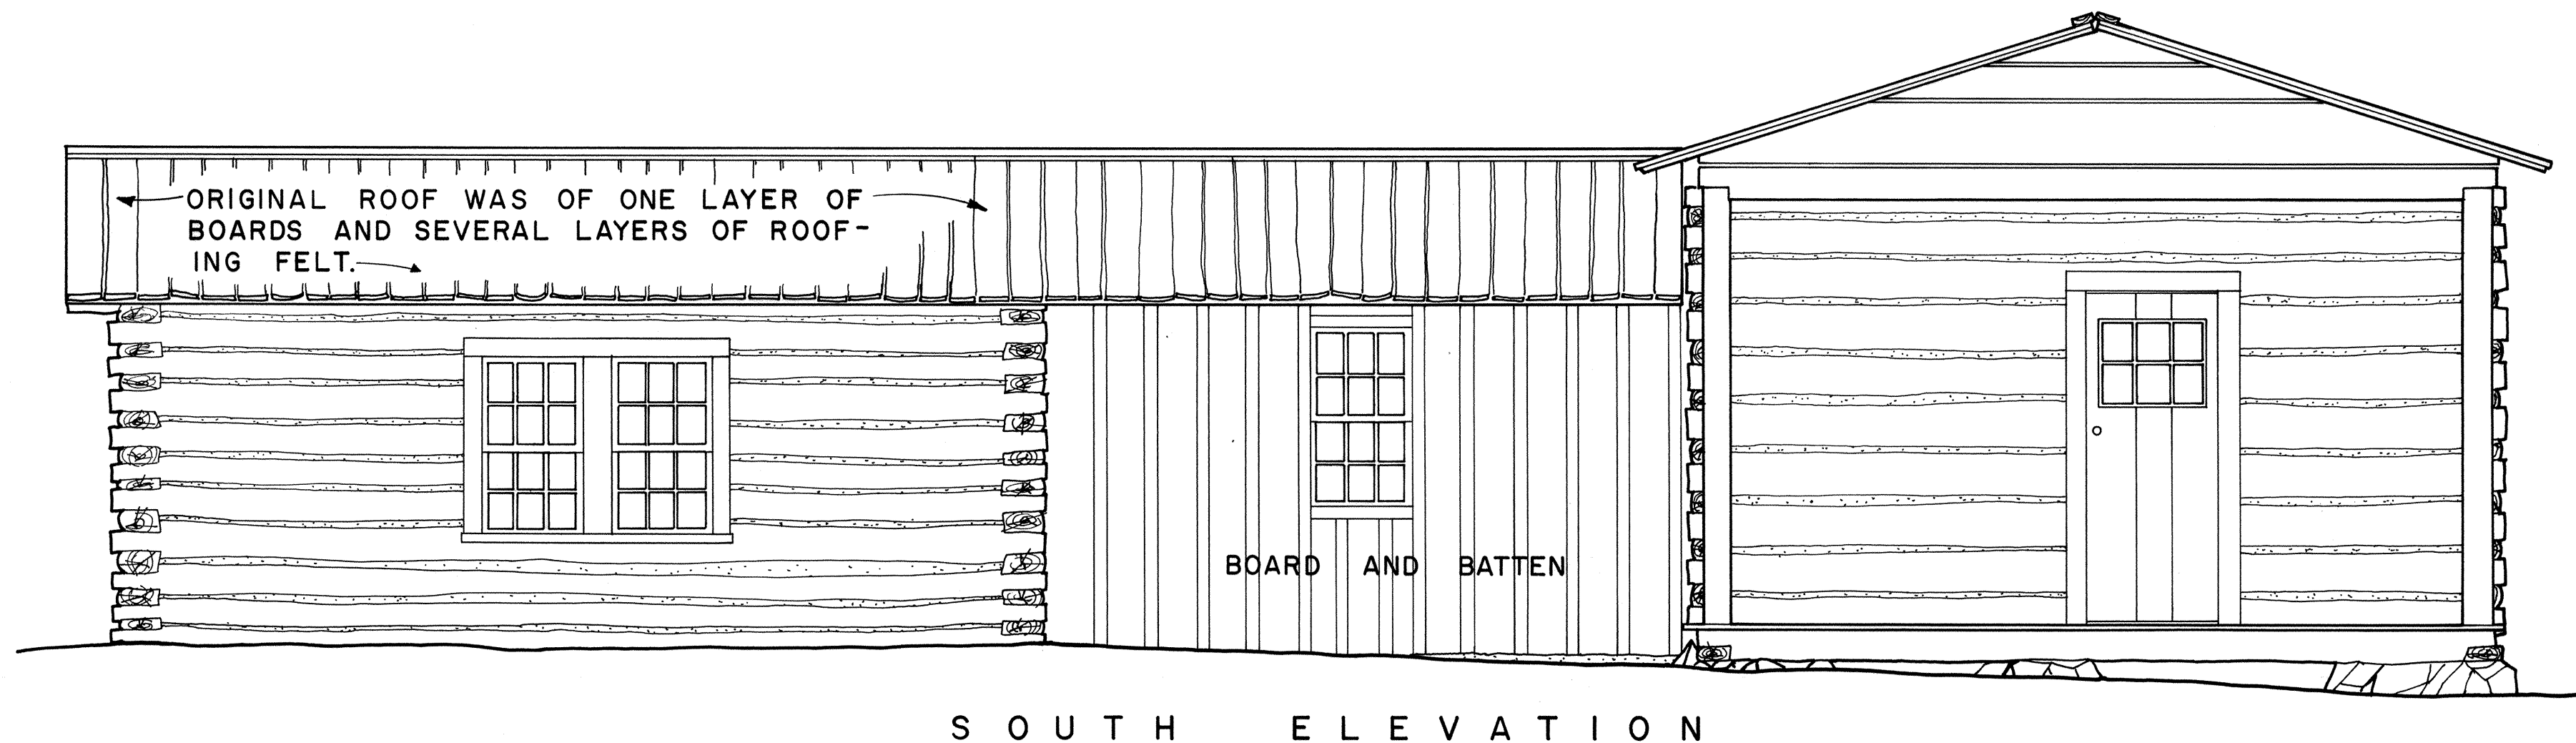

NOTES:

1. DOOR IN WEST ELEVATION NOW WINDOW.
2. DOUBLE WINDOW IN SOUTH ELEVATION NOW SINGLE.

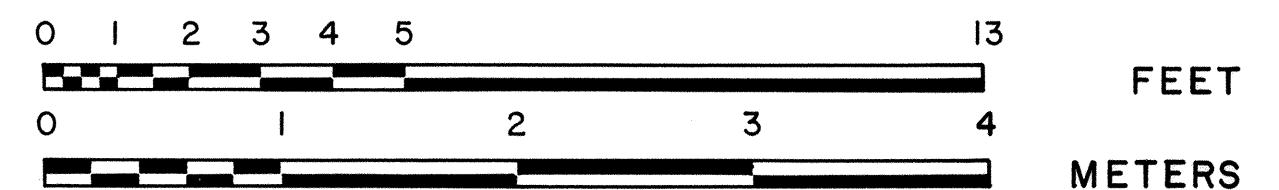

DRAWN BY: JACK OYAMA

WESTERN OFFICE
SAN FRANCISCO, CALIFORNIA
UNDER DIRECTION OF THE NATIONAL PARK SERVICE,
UNITED STATES DEPARTMENT OF THE INTERIOR

NAME AND LOCATION OF STRUCTURE


MENOR'S FERRY
GRAND TETON NATIONAL PARK MOOSE, WYOMING

SURVEY NO.
WYO 24


HISTORIC AMERICAN
BUILDINGS SURVEY
SHEET 9 OF 12 SHEETS

LIBRARY OF CONGRESS
INDEX NUMBER


MAIN BUILDING ELEVATIONS

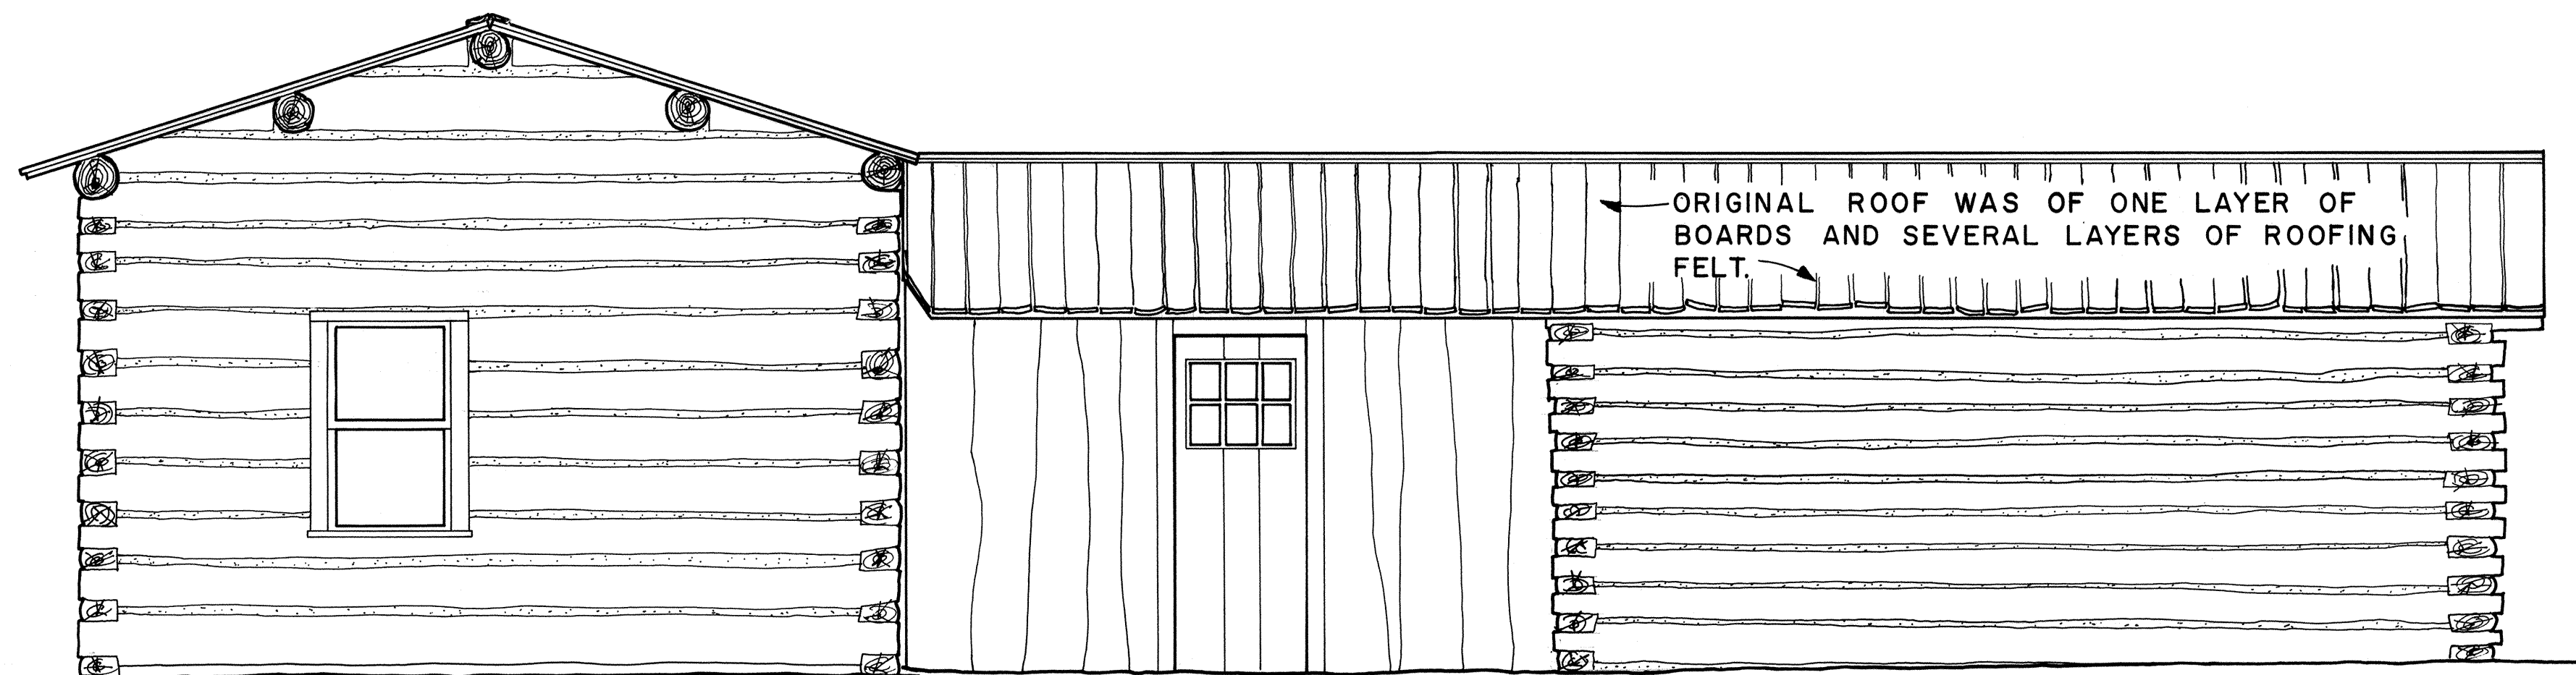

NORTH ELEVATION

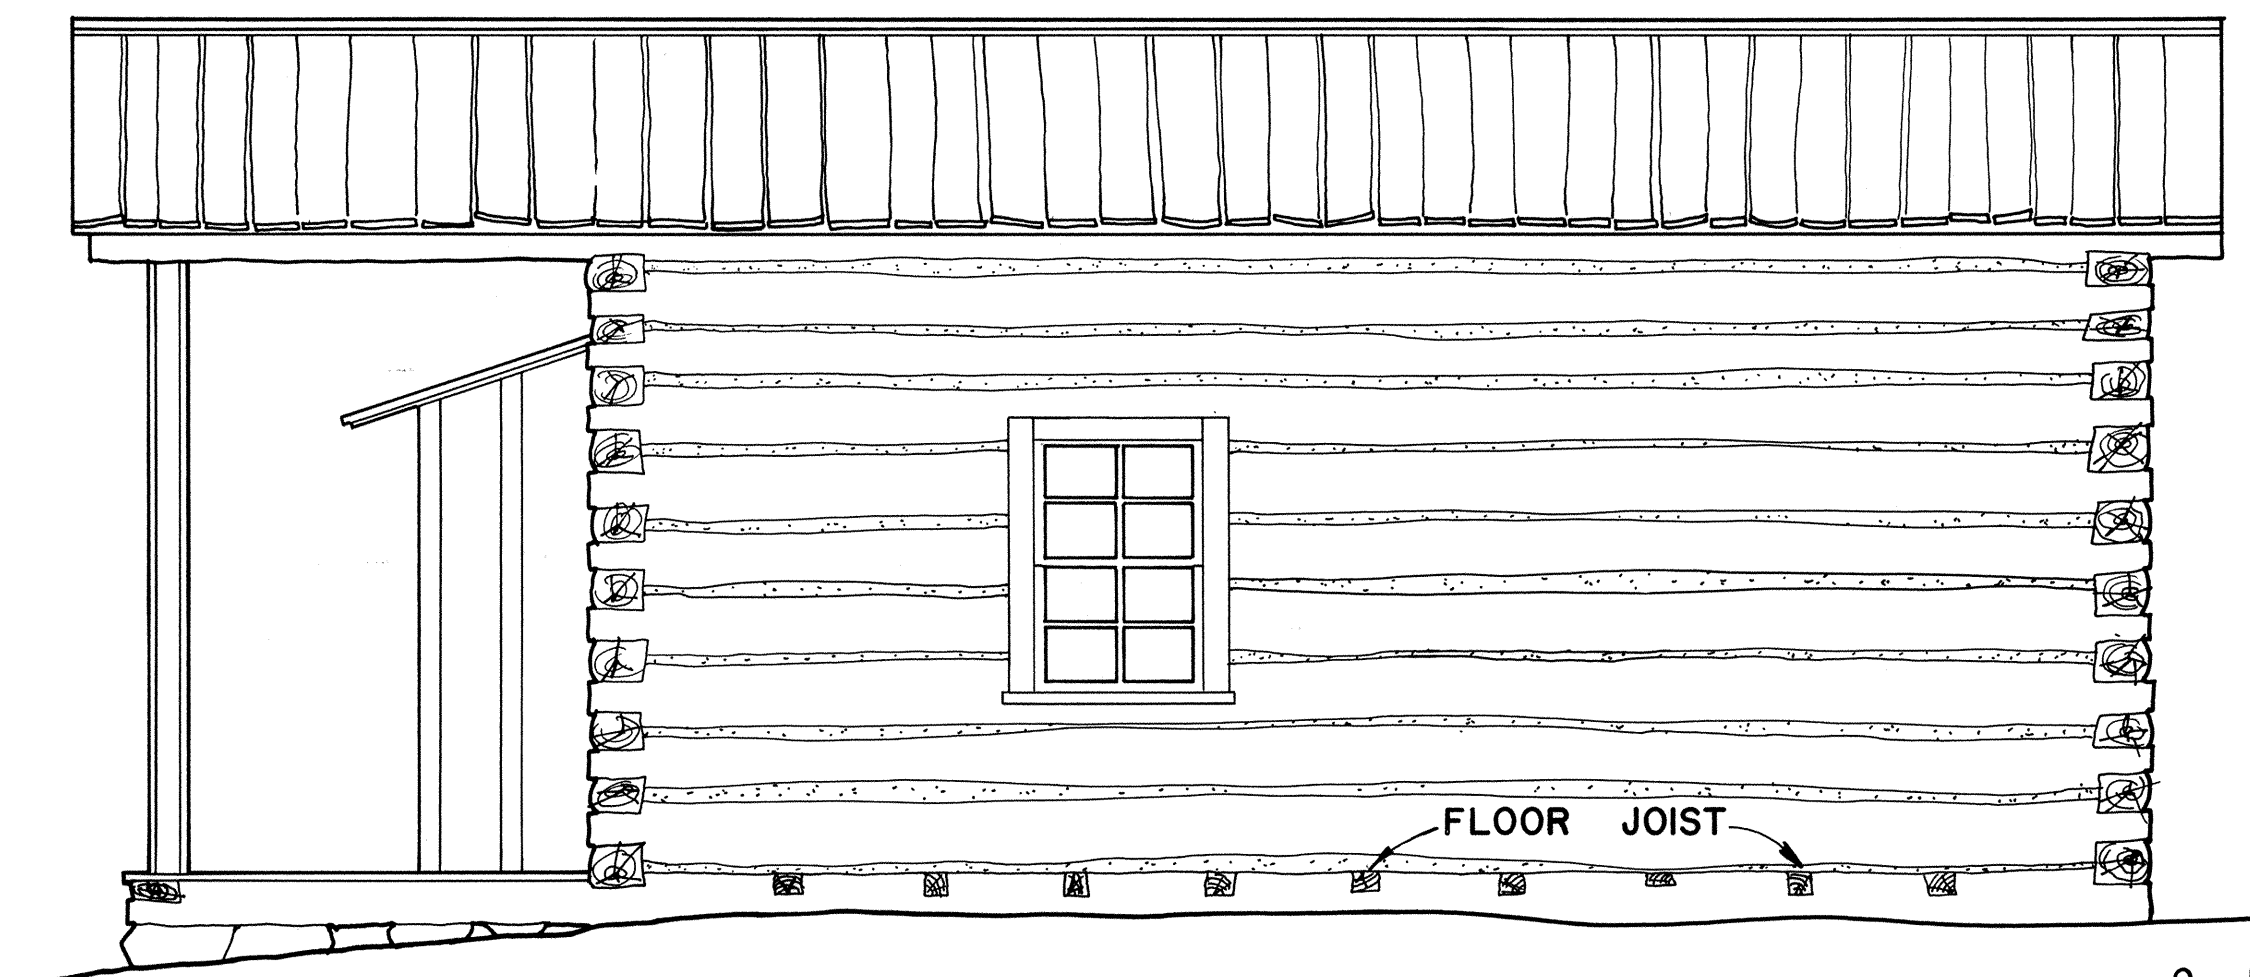

EAST ELEVATION

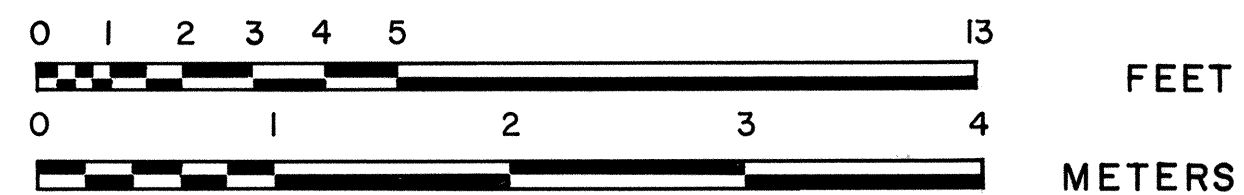

DRAWN BY: JACK OYAMA

WESTERN OFFICE
SAN FRANCISCO, CALIFORNIA
UNDER DIRECTION OF THE NATIONAL PARK SERVICE,
UNITED STATES DEPARTMENT OF THE INTERIOR

NAME AND LOCATION OF STRUCTURE

MENOR'S FERRY
GRAND TETON NATIONAL PARK MOOSE, WYOMING


SURVEY NO.

WYO 24

HISTORIC AMERICAN
BUILDINGS SURVEY
SHEET 10 OF 12 SHEETS



LIBRARY OF CONGRESS
INDEX NUMBER

M A I N B U I L D I N G S E C T I O N

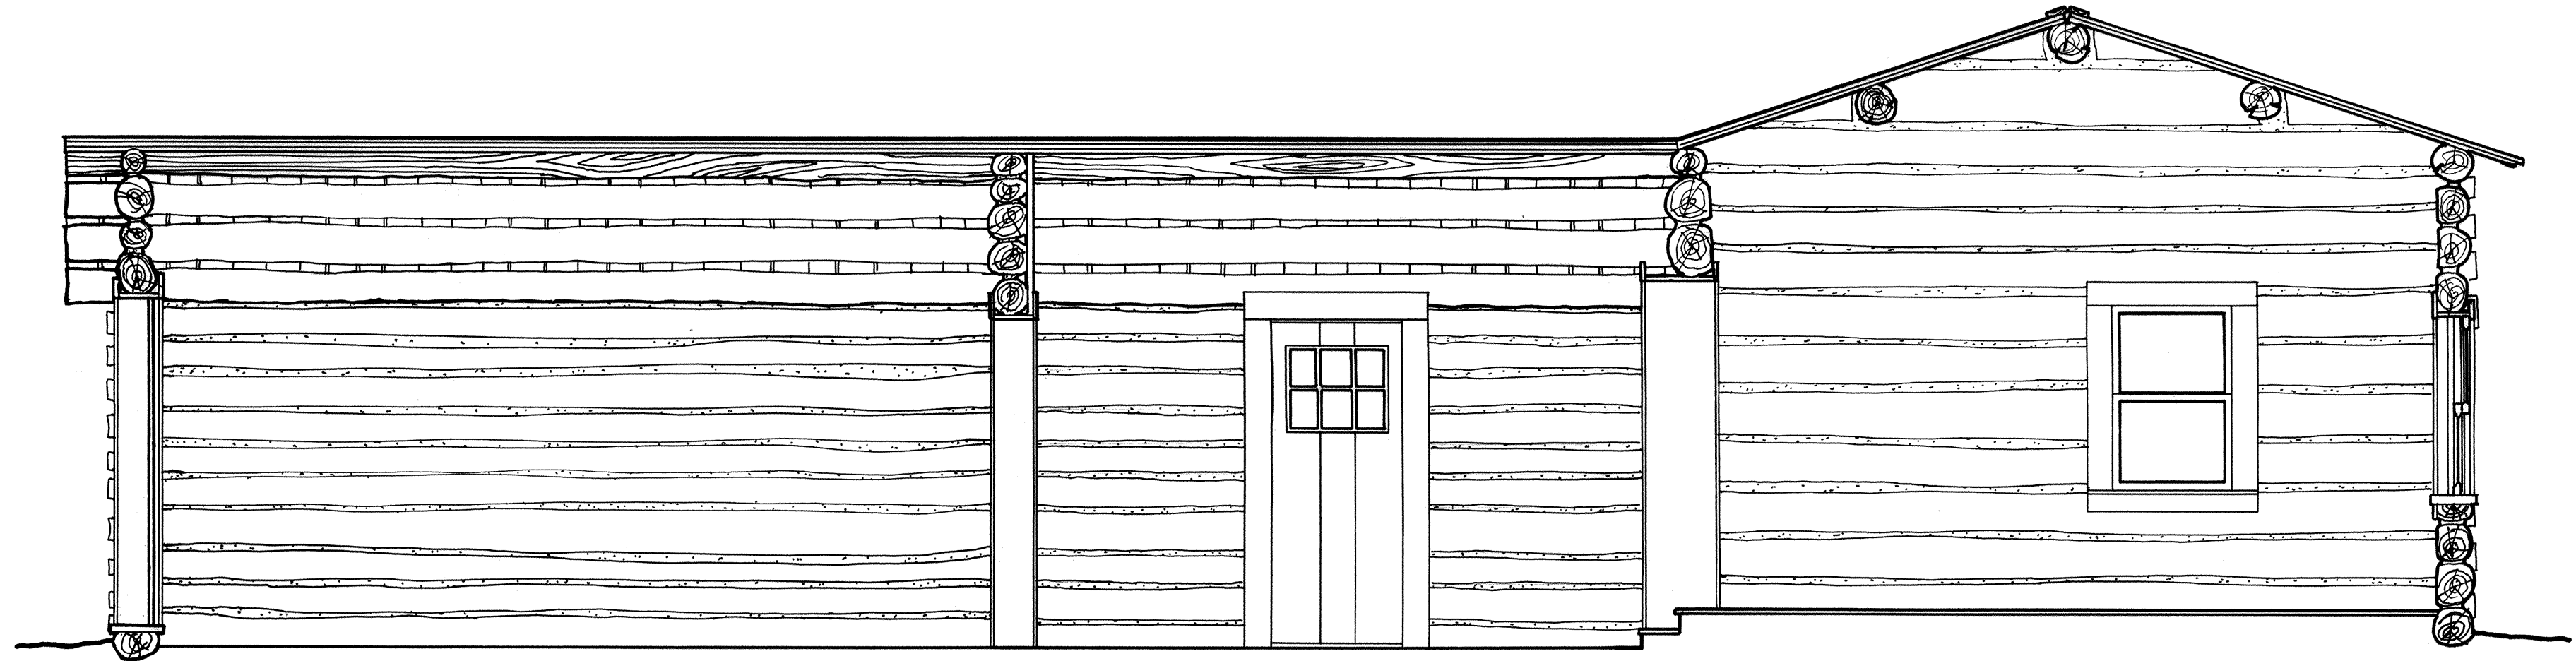


SECTION A - A
SCALE A

ORIGINAL CABIN
WALL DETAIL
SCALE B

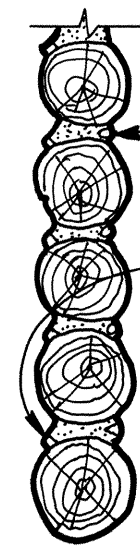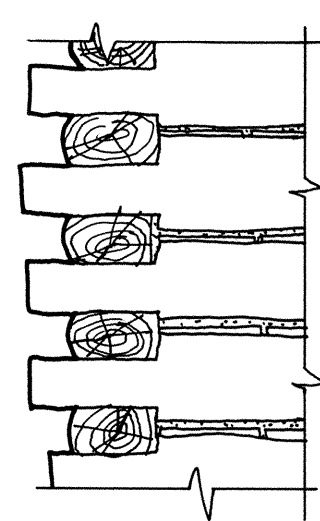

WOOD AND PLASTER
CHINKING AT JOINTS
ON INSIDE



OUTSIDE JOINTS
HAVE WOOD CLEATS
AND PLASTER.

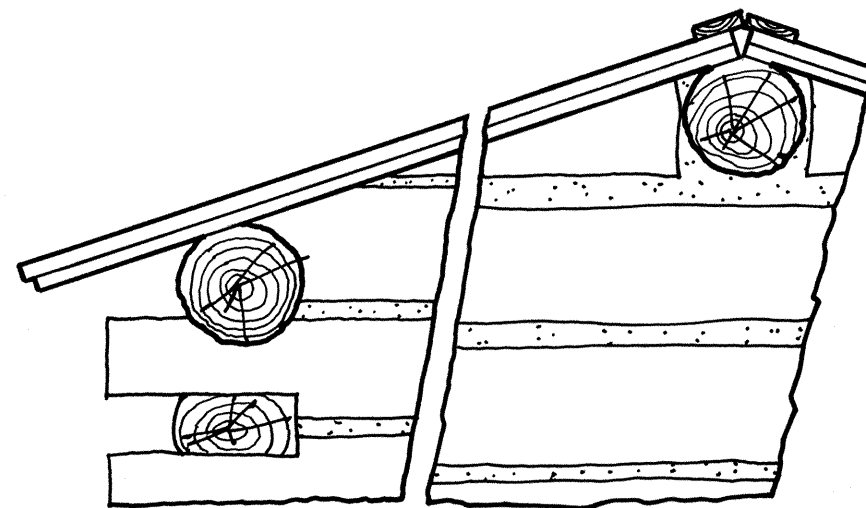

STORE WALL DETAIL
SCALE B


LOGS ARE HAND-HEWN
ON INSIDE WITH WOOD
CHINKING AT JOINTS.

OUTSIDE JOINTS ARE
FILLED WITH PLASTER
ONLY.

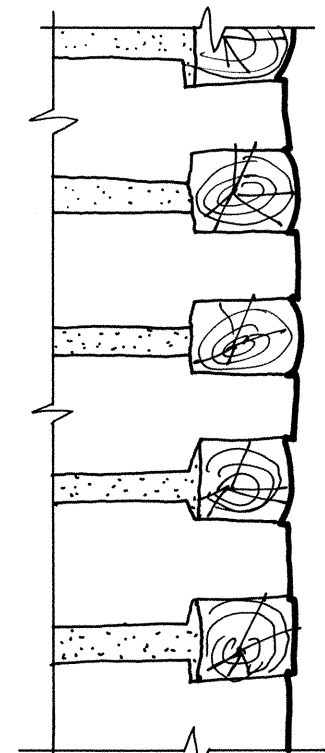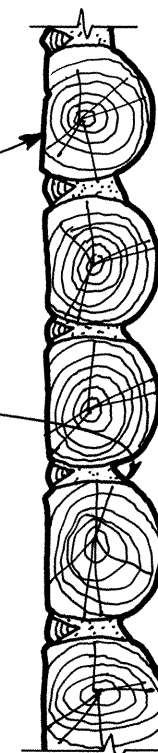


ELEVATION AT
EXTERIOR CORNER

SECTION THRU
WALL

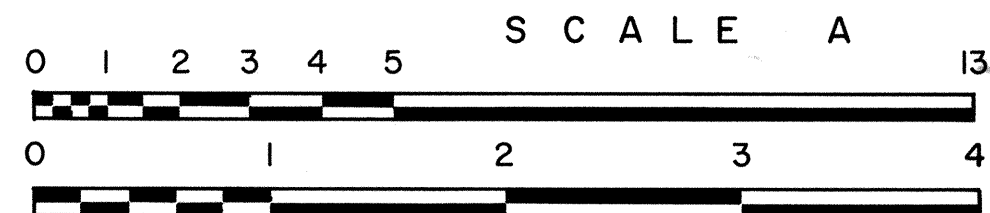

FEET

METERS

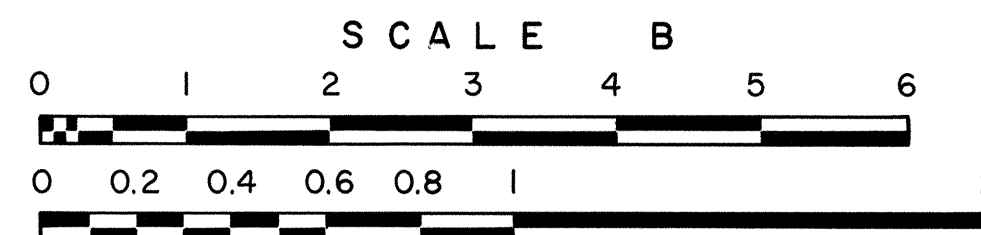

SECTION
WALL

THRU

ELEVATION AT
EXTERIOR CORNER

DRAWN BY: JACK OYAMA

WESTERN OFFICE
SAN FRANCISCO, CALIFORNIA
UNDER DIRECTION OF THE NATIONAL PARK SERVICE,
UNITED STATES DEPARTMENT OF THE INTERIOR

NAME AND LOCATION OF STRUCTURE

MENOR'S FERRY
GRAND TETON NATIONAL PARK MOOSE, WYOMING


SURVEY NO.
WYO 24

HISTORIC AMERICAN
BUILDINGS SURVEY
SHEET 11 OF 12 SHEETS


LIBRARY OF CONGRESS
INDEX NUMBER

MAIN BUILDING EXTERIOR DOOR AND HARDWARE DETAILS


NOTE: USE SCALE B FOR HARDWARE DETAILS.

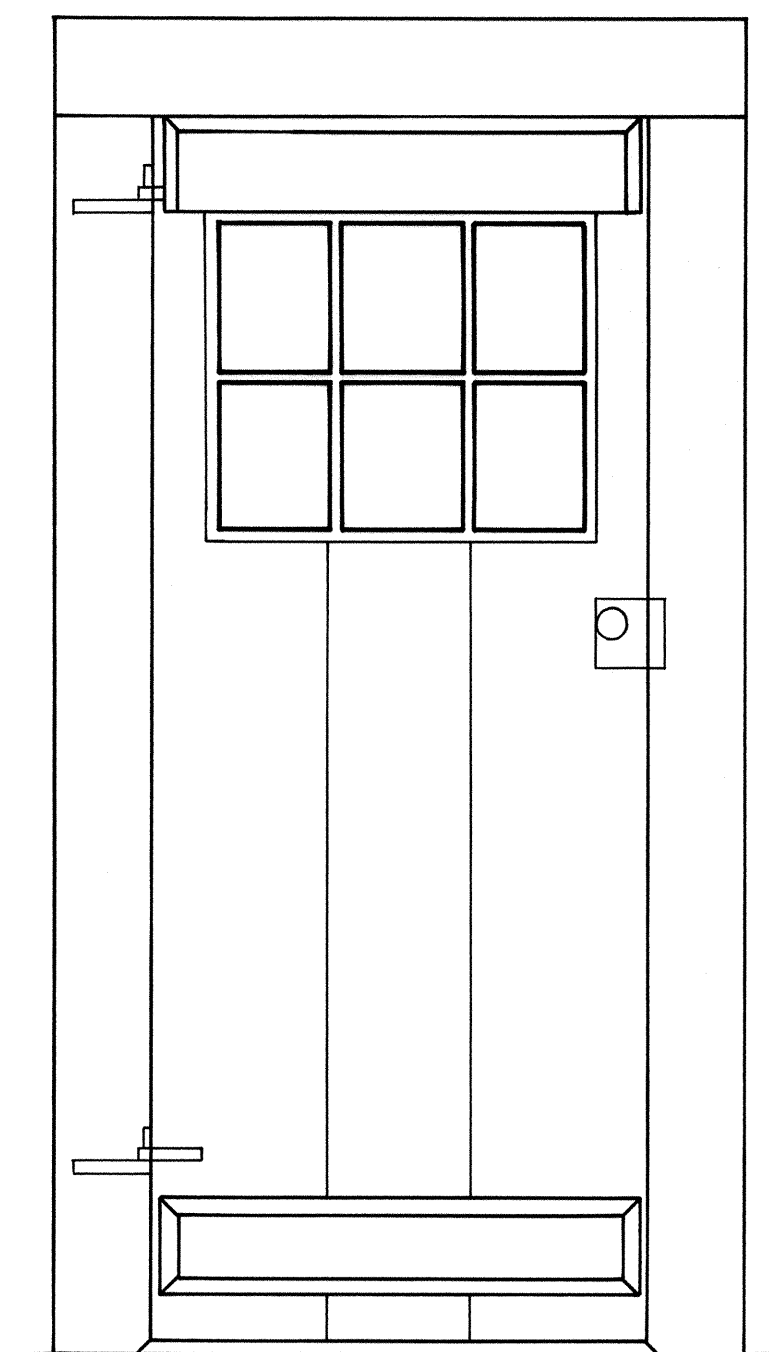

INTERIOR

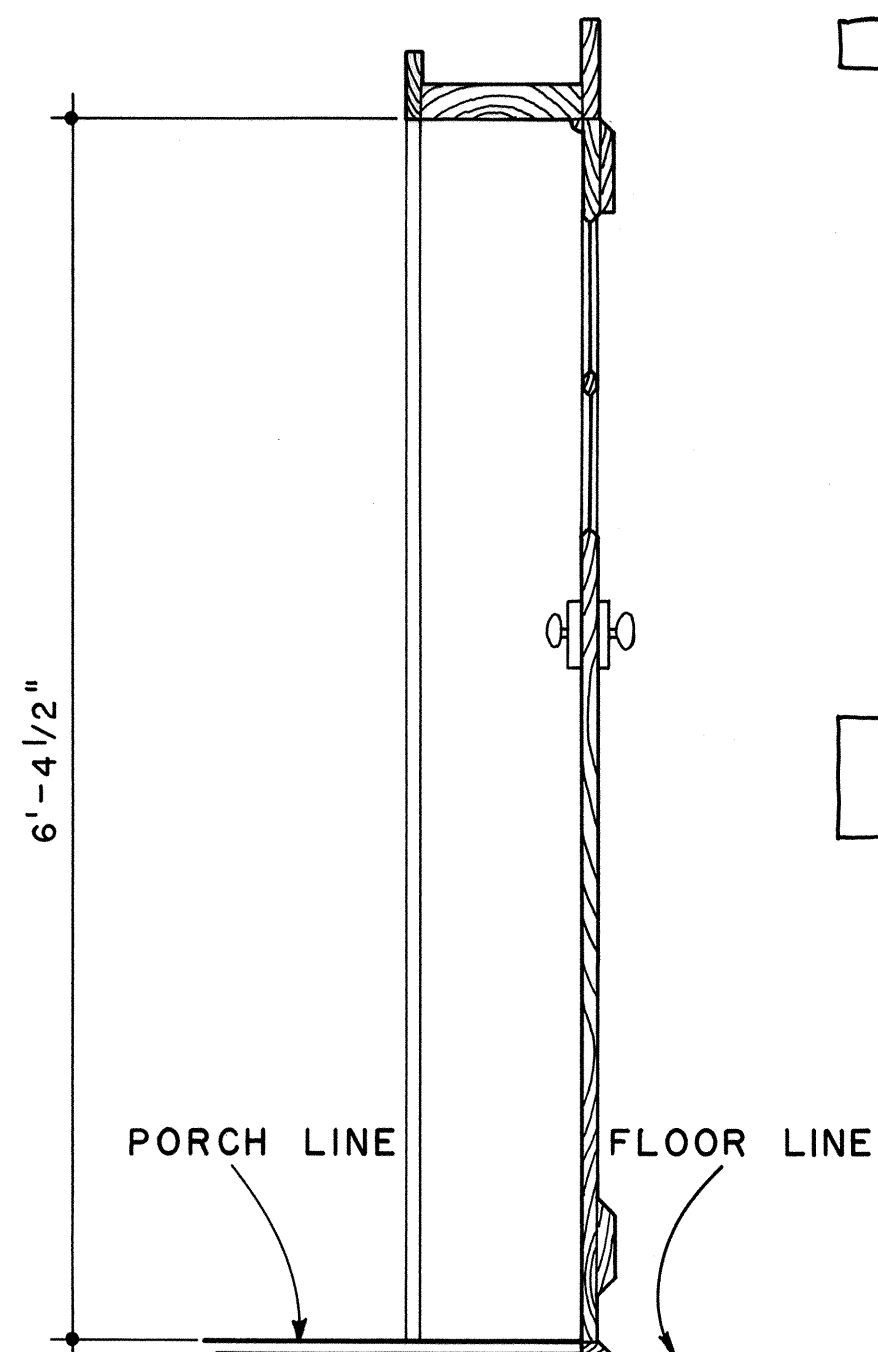


SECTION

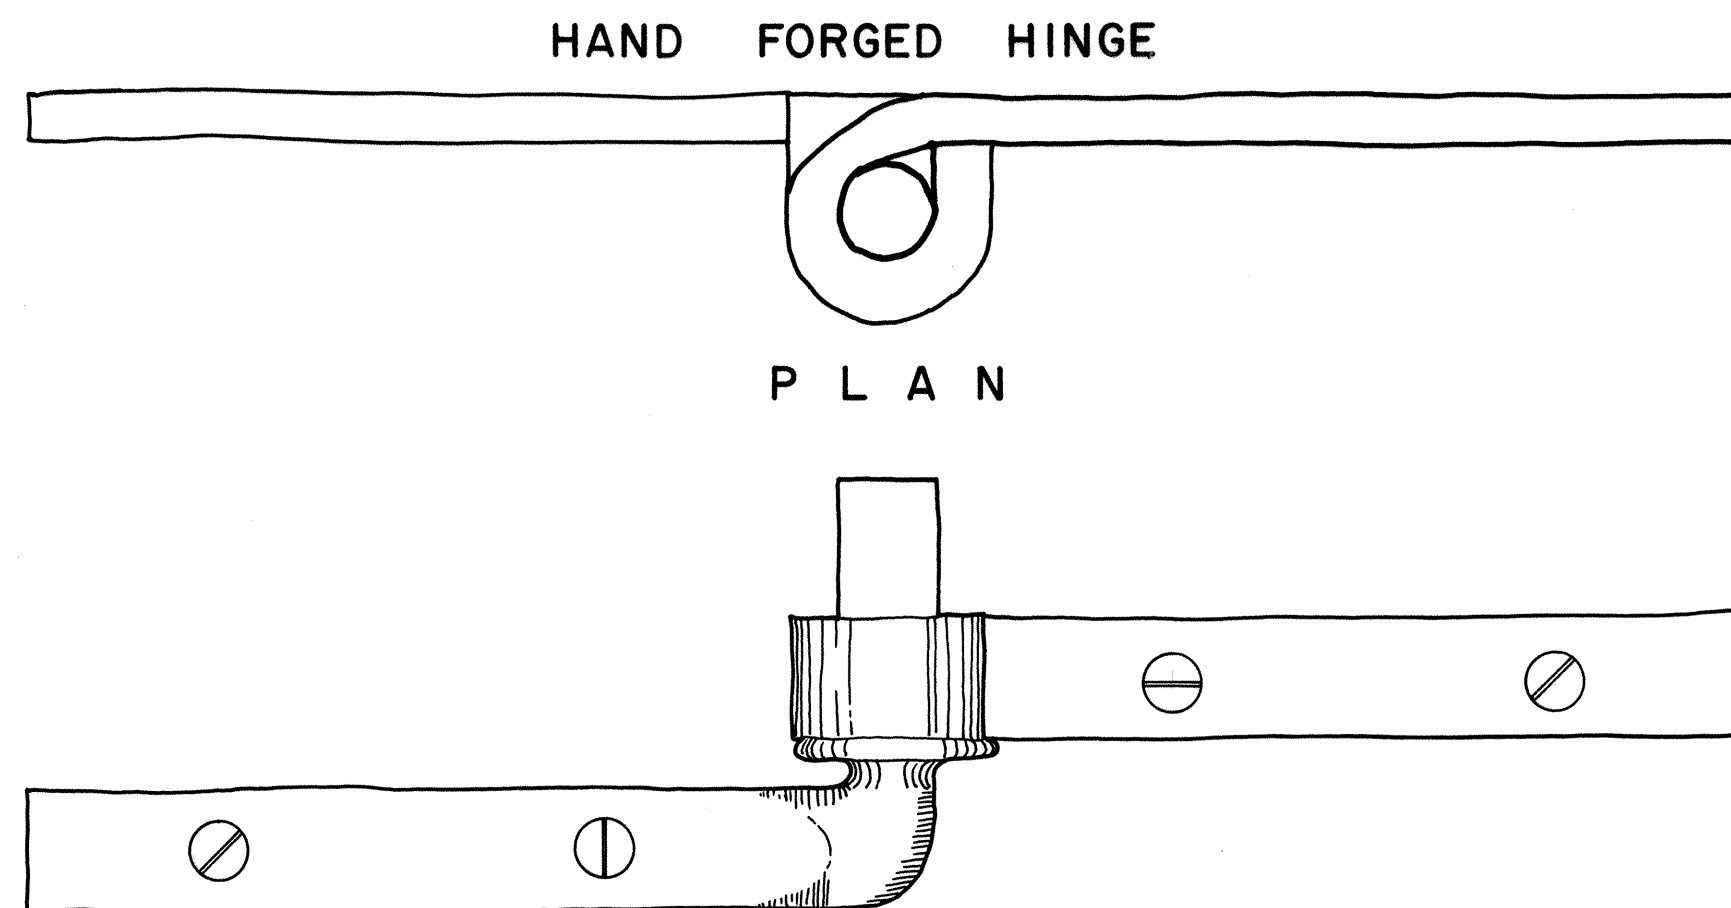

HAND FORGED HINGE

PLAN

ELEVATION

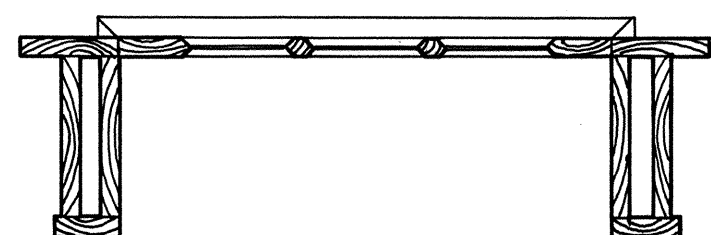


PLAN

SECTION


SCALE

A

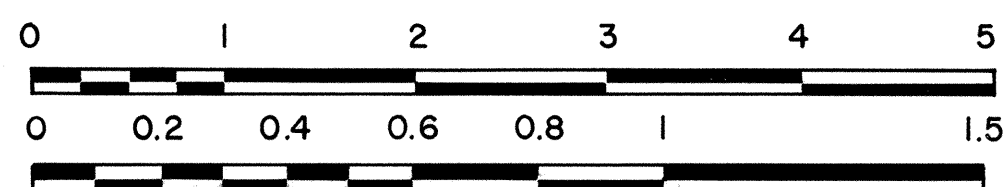

FEET

METERS

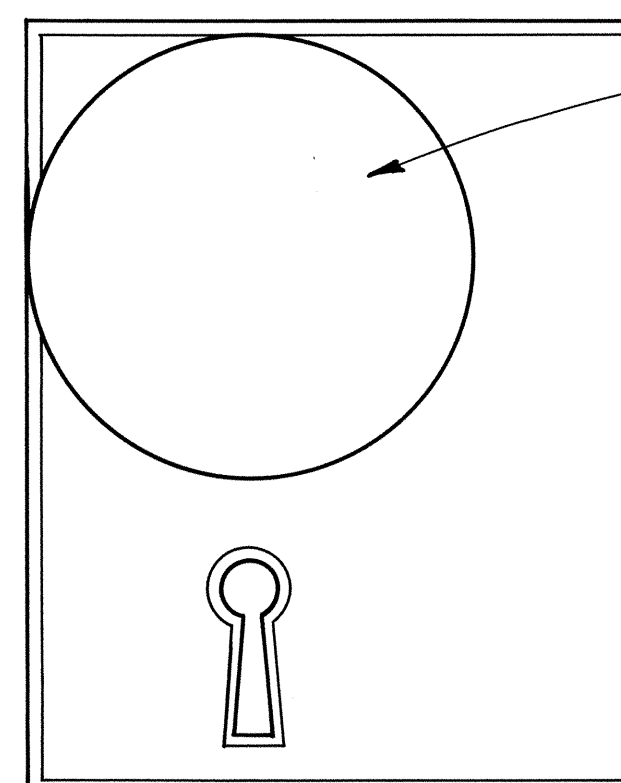

PORCELAIN KNOB


DOOR KNOB
AND PLATE

NOTES: DOOR HINGES
WERE HAND
FORGED.

ALL HARDWARE
DETAILS FROM
FRONT EXTERI-
OR DOOR.

SCALE

B

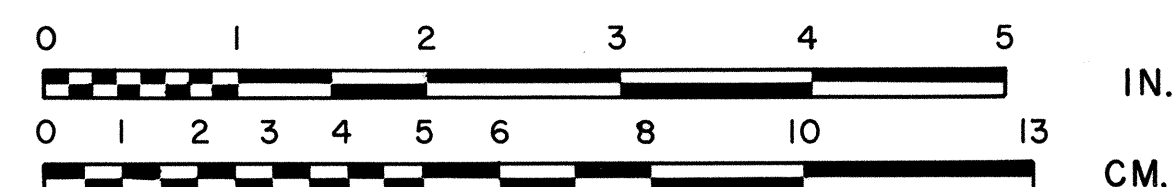

IN.

CM.

DRAWN BY: JACK OYAMA

WESTERN OFFICE
SAN FRANCISCO, CALIFORNIA
UNDER DIRECTION OF THE NATIONAL PARK SERVICE,
UNITED STATES DEPARTMENT OF THE INTERIOR

NAME AND LOCATION OF STRUCTURE

MENOR'S FERRY
GRAND TETON NATIONAL PARK MOOSE, WYOMING

SURVEY NO.
WYO 24

HISTORIC AMERICAN
BUILDINGS SURVEY
SHEET 12 OF 12 SHEETS

LIBRARY OF CONGRESS
INDEX NUMBER

WYO, 20-MOOS, 2-

WYOMING

Teton

MOOSE

(Grand Teton NP)

State

County

Town or Vicinity

12s

11P

4d

Structure MENOR'S FERRY (WYO-24)

West bank of the Snake River. Museum. Group of white-washed log buildings built by William D. Menor on land he homesteaded in 1892. Group includes cabin-store, storage building with root cellar, smokehouse, and privy, all restored 1942. Barn and blacksmith shop now destroyed. Menor operated a ferry across the Snake River from 1892 until 1918 when he sold to Naud Noble (see Maud Noble Cabin, WYO-23). 12 sheets (1965, including plans, elevations, sections, details of all extant buildings except privy); 11 photos (1965); 4 data pages (1967).

NO COVER

FILE PRINTS, INKED SKETCHES

Form 10-444 (2/62) REPRODUCIBLES

HISTORIC AMERICAN BUILDINGS SURVEY



HAOS MILL WNO-24 KODAK



HABS WYO-24





HAB - WYO 24



HABS
WYO-24

HABS WYO-24





HABS - WYO - 24



HARS
WYO-24