

Cunningham Cabin
Moose
Grand Teton National Park
Wyoming

HABS No. WYO-25

HABS
WYO
20-MOOS.V,
2-

PHOTOGRAPHS

HISTORIC AMERICAN BUILDINGS SURVEY
NATIONAL PARK SERVICE
Western Office, Division of Design and Construction
450 Golden Gate Avenue
San Francisco, California

HABS
WYO.
20. MOOSE V.

PHOTOGRAPH-DATA BOOK
HISTORIC AMERICAN BUILDINGS SURVEY

WYO-25
Page 1

CUNNINGHAM CABIN

Grand Teton National Park, Moose, Wyoming

ADDRESS: Located between the Snake River and U. S. 89,
north of Moose, Wyo., in Grand Teton National Park

OWNER: National Park Service

OCCUPANT: none

USE: Historic Point of Interest

HISTORICAL AND ARCHITECTURAL SIGNIFICANCE

This two room log structure is all that remains today of the J.P. Cunningham Ranch, one of the early homesteads in the Jackson Hole area. The other buildings, including an Indian fort built by the local inhabitants have since been torn down.

In 1893 horse thieves were surprised as they emerged from one of the buildings that stood on the Cunningham ranch and were shot down. Some say that it was this very cabin; others believe it was the barn.

The sod-roofed two room cabin was restored to its present condition in 1956. It is probably the oldest structure still standing in the area, an example of the "dog-run" log cabin plan.

HISTORICAL INFORMATION

James Pierce Cunningham was one of the early settlers in the Jackson Hole Valley. He arrived in 1888, coming from Rockport, New York, by way of Michigan where he worked in the logging business. He and a partner established a homestead on Spencer Creek and they engaged in trapping that first winter.

The following year (1889) they gave up their homestead claim. Cunningham then filed a claim on land on the east bank of the Snake River. Here he built the present cabin and a barn and other out buildings. This low two-room cabin with the rooms separated by a breezeway was probably built that year. In 1895, Mr. and Mrs.

WYO
20-11005.4
2

WYO-25
Page 2

Cunningham lived in the south room and workmen building them a new and more elaborate home occupied the room on the north. Afterwards the north room became a blacksmith shop.

There are several noteworthy events concerning the Cunningham Ranch. In 1893 horse thieves were ambushed on the ranch by a posse from Jackson. They were shot down as they emerged from one of the buildings on the ranch. Doubt remains as to whether it was this cabin, the barn, or another nearby structure.

During the Indian troubles of 1895, Cunningham, assisted by trappers and miners erected three log fort-like structures around his new home. These were torn down at a later date by Cunningham sometime after 1914 when he repurchased the land he had sold in 1909 to John "Pete" Nelson.

Records show that Cunningham received patent to 160 acres on September 5, 1906. The five-year residence period would have been established on the land in 1901; no doubt the acreage then was greatly increased over the original homestead claim. In 1909 he sold or traded 200 acres of his land to John "Pete" Nelson. It is believed that these 200 acres included the original homestead and ranch structures. The Cunninghams then operated the Victor Hotel, Victor, Idaho. In 1914 Cunningham bought back the 200 acres and the title was conveyed to Margaret Cunningham, his wife.

Pierce Cunningham was one of the early settlers who engaged in the cattle business. The tax assessment records of Teton County in 1924 show that the J. P. Cunningham Ranch included 560 acres consisting of 200 acres of irrigated cultivated land, 125 acres of natural meadow and 235 acres of grazing land. In addition, the records state that he was assessed for 3 purebred bulls, 60 stock calves coming yearlings, and 80 stock calves two years and older.

By 1926 Pierce had switched from cattle to sheep in an effort to beat the harsh economics of the cattle industry. The Cunninghams sold their holdings in 1928. Pierce Cunningham died April 17, 1934, in Idaho Falls, Idaho, closing a chapter on one of Jackson's early settlers, a trapper, rancher and Justice of the Peace.

SUPPLEMENTAL MATERIAL AND SOURCES

- Apple, Russell A., An Interpretive Prospectus for Post-Fur Trade History, Grand Teton National Park, Midwest Region, National Park Service, U.S. Dept. of the Interior, 1960, amendments 1963.
- Bonney, Orrin H. and Lorraine G., Jackson Hole and Grand Teton National Park, published by author, Houston, 1961.
- Kendrew, A. E., "Report on Owned Structures of a Historic Character, Jackson Hole, Wyoming", 1942.
- Mumey, Nolie, The Teton Mountains, Their History and Tradition, Artcraft Press, Denver, 1947.

ARCHITECTURAL INFORMATION

The sod-roofed log cabin was built entirely without the use of nails or milled lumber. Wood chinking was held in place by wooden wedges driven into the adjacent logs. The door joints are hand-hewn and held in place by wooden dowels. The structure was restored in 1956.

EXTERIOR

Overall Dimensions - 41'-5" x 15'-3"; two rooms separated by an open breezeway under a single roof.

Foundation - Stone.

Openings - Entrances: each of the two rooms has a single doorway opening onto the breezeway and opposite each other. The door to the south room is 2'-10" x 5'-4" and the door to the north room is 2'-5" x 5'-5".

Windows: each room has two, one each on the northeast and the southwest. The openings vary in width from 2'-3" to 4'-5". No window frames are evident. Jamb, head and sills are handhewn. Windows, probably without glass, were protected by shutters.

Roof - Logs of 8 to 10 inches in diameter run the length of the building -- two at the ridge and one each between the ridge and the exterior walls. These are crossed at a 90° angle by smaller logs varying in size from 3" to 4½" in diameter which are in turn covered by sod. The simple gable roof has a pitch of approximately 15½°.

WYO
20 MOOSE V.
2.

WYO-25
Page 4

Chimney - None.

INTERIOR

Floor Plan - Two rooms approximately square and of the same size with a single doorway for each opening onto a breezeway. The south room has an interior dimension of 14'-1" x 13'-10" and the north room measures 14'-1" x 13'-9". The southern room was living quarters, the north room a blacksmith shop. A work bench, forge and anvil remain today.

Floor - Earth.

Wall and Ceiling Finish - Exposed logs and chinking.


Doors - None remain.

Trim - Door bucks are hand-hewn planks 2" x 6½" anchored to the log ends by 1" round pegs.

GENERAL SETTING

The cabin is located on the original Cunningham homestead on the east bank of the Snake River, north of the towns of Moose and Jackson. The site is between the present Highway 89 and the Snake River. None of the other ranch buildings remain today.


Prepared by,

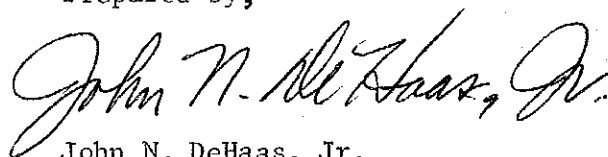

John N. DeHaas, Jr.
Architect

June 1967

Approved:

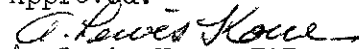
A. Lewis Koue, FAIA

Supervisory Architect
Div. Historic Architecture
National Park Service


CUNNINGHAM CABIN

GRAND
MOOSE,

TETON

NATIONAL

PARK
WYOMING

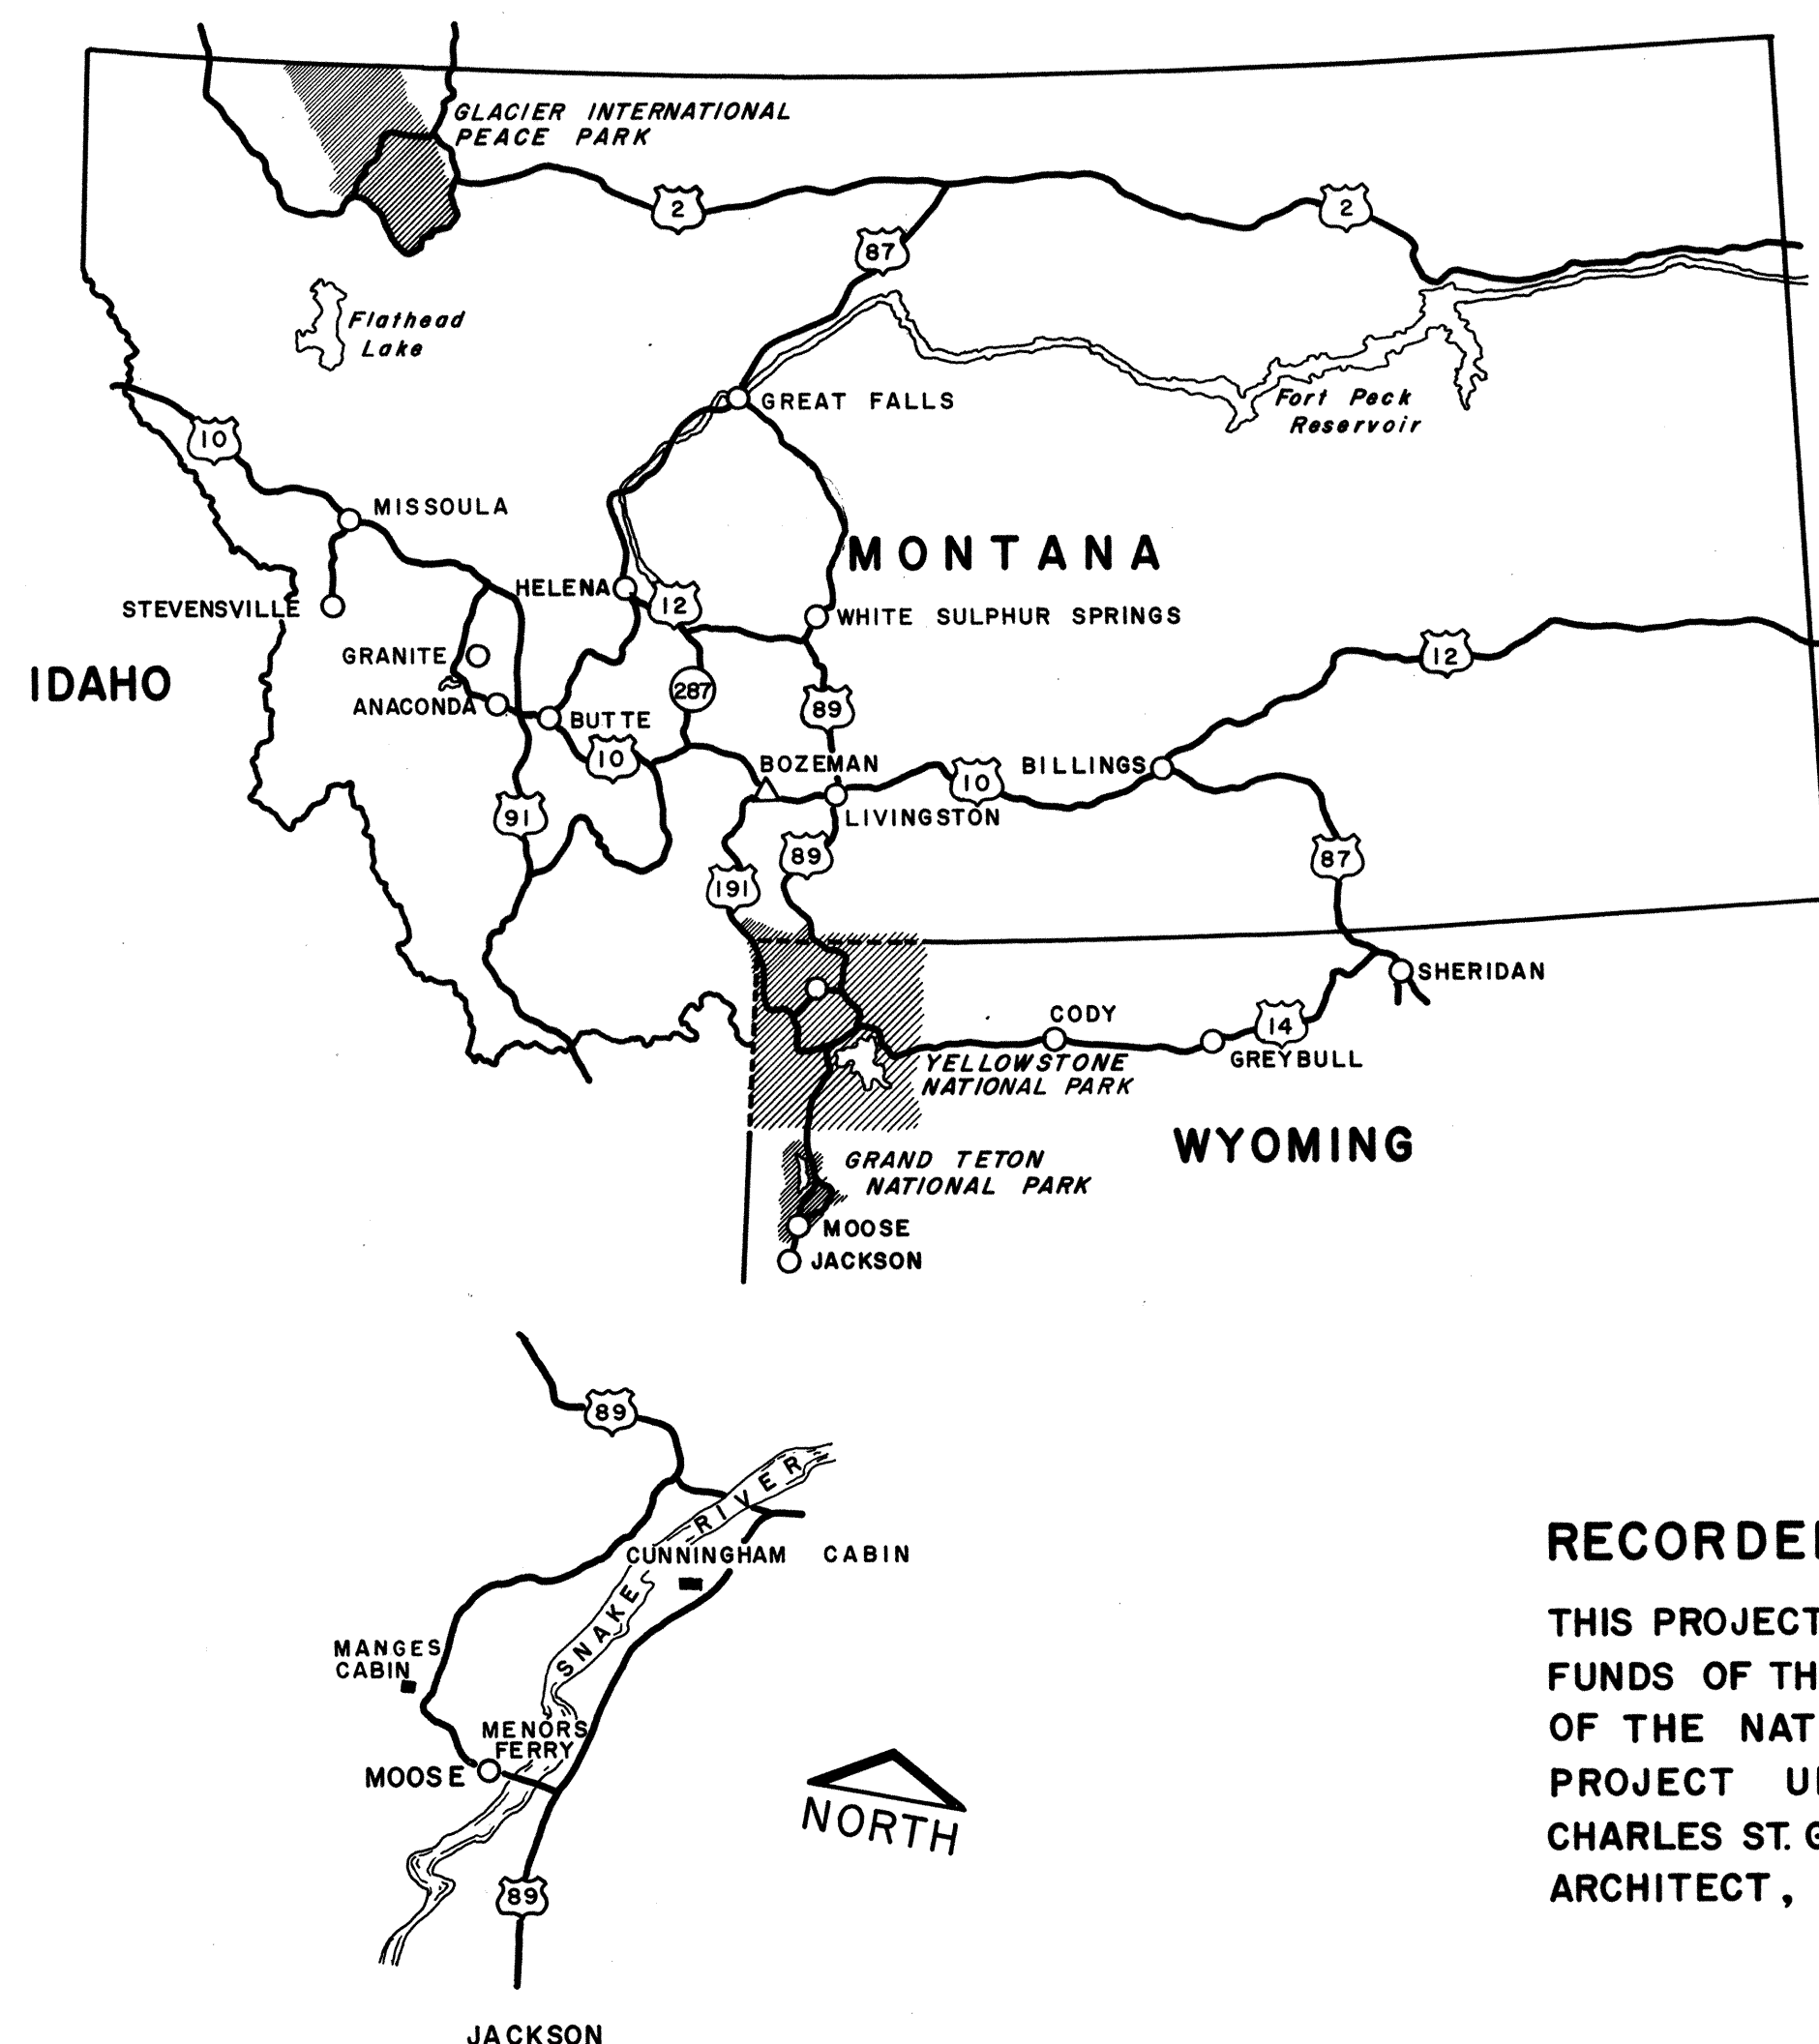

JAMES PIERRE CUNNINGHAM CAME TO JACKSON HOLE IN 1888 FROM THE STATE OF NEW YORK. IN 1889 HE FILED A HOME-STEAD CLAIM ON 160 ACRES EAST OF THE SNAKE RIVER.

THE CUNNINGHAM RANCH WAS AMONG THE EARLIEST IN THE VALLEY.

CUNNINGHAM LIVED IN A TENT HIS FIRST YEAR IN JACKSON. LATER HE BUILT A LOG CABIN ON THE LAND. THERE EXISTS SOME DOUBT IN HISTORIANS' MINDS THAT THE PRESENT RECONSTRUCTED CABIN IS THE ORIGINAL ONE.

MRS. CUNNINGHAM ARRIVED IN 1895 AND SHE AND PIERRE LIVED IN THE SOUTH ROOM OF THE PRESENT CABIN AND THE MEN, WHO WERE WORKING ON THE BUILDING OF A NEW HOUSE, LIVED IN THE NORTH ROOM. THESE ROOMS WERE SEPARATED BY A BREEZE-WAY. WHEN THE CUNNINGHAMS MOVED INTO THEIR NEW HOUSE THE NORTH ROOM OF THE CABIN WAS MADE INTO A BLACKSMITH SHOP.

HORSE THIEVES WERE SHOT ON THE CUNNINGHAM RANCH IN 1893 AS THEY EMERGED FROM THIS (OR ANOTHER) CABIN BY A POSSE IN WAITING.

THE PRESENT CABIN WAS RESTORED TO ITS PRESENT CONDITION IN 1956.

RECORDED BY THE UNITED STATES NATIONAL PARK SERVICE

THIS PROJECT WAS FINANCED FROM FUNDS OF THE "MISSION 66" PROGRAM OF THE NATIONAL PARK SERVICE PROJECT UNDER DIRECTION OF CHARLES ST. GEORGE POPE SUPERVISING ARCHITECT, HISTORIC STRUCTURES.

MEASURED AND DRAWN JUNE-SEPT 1965 UNDER THE SUPERVISION OF JOHN N. DEHAAS, JR. ARCHITECT, MONTANA STATE UNIVERSITY.

U. JAMES BLACKBURN
DURWARD K. SOBEK
JACK OYAMA
DICK SHANAHAN
CHARLES B. GOLDY, JR.

MONTANA STATE UNIVERSITY
MONTANA STATE UNIVERSITY
DRAWN BY: CHARLES B. GOLDY, JR.

WESTERN OFFICE
SAN FRANCISCO, CALIFORNIA
UNDER DIRECTION OF THE NATIONAL PARK SERVICE,
UNITED STATES DEPARTMENT OF THE INTERIOR


CUNNINGHAM CABIN

GRAND TETON NATIONAL PARK MOOSE, WYOMING

SURVEY NO.
WYO 25


HISTORIC AMERICAN
BUILDINGS SURVEY
SHEET 1 OF 5 SHEETS

LIBRARY OF CONGRESS
INDEX NUMBER

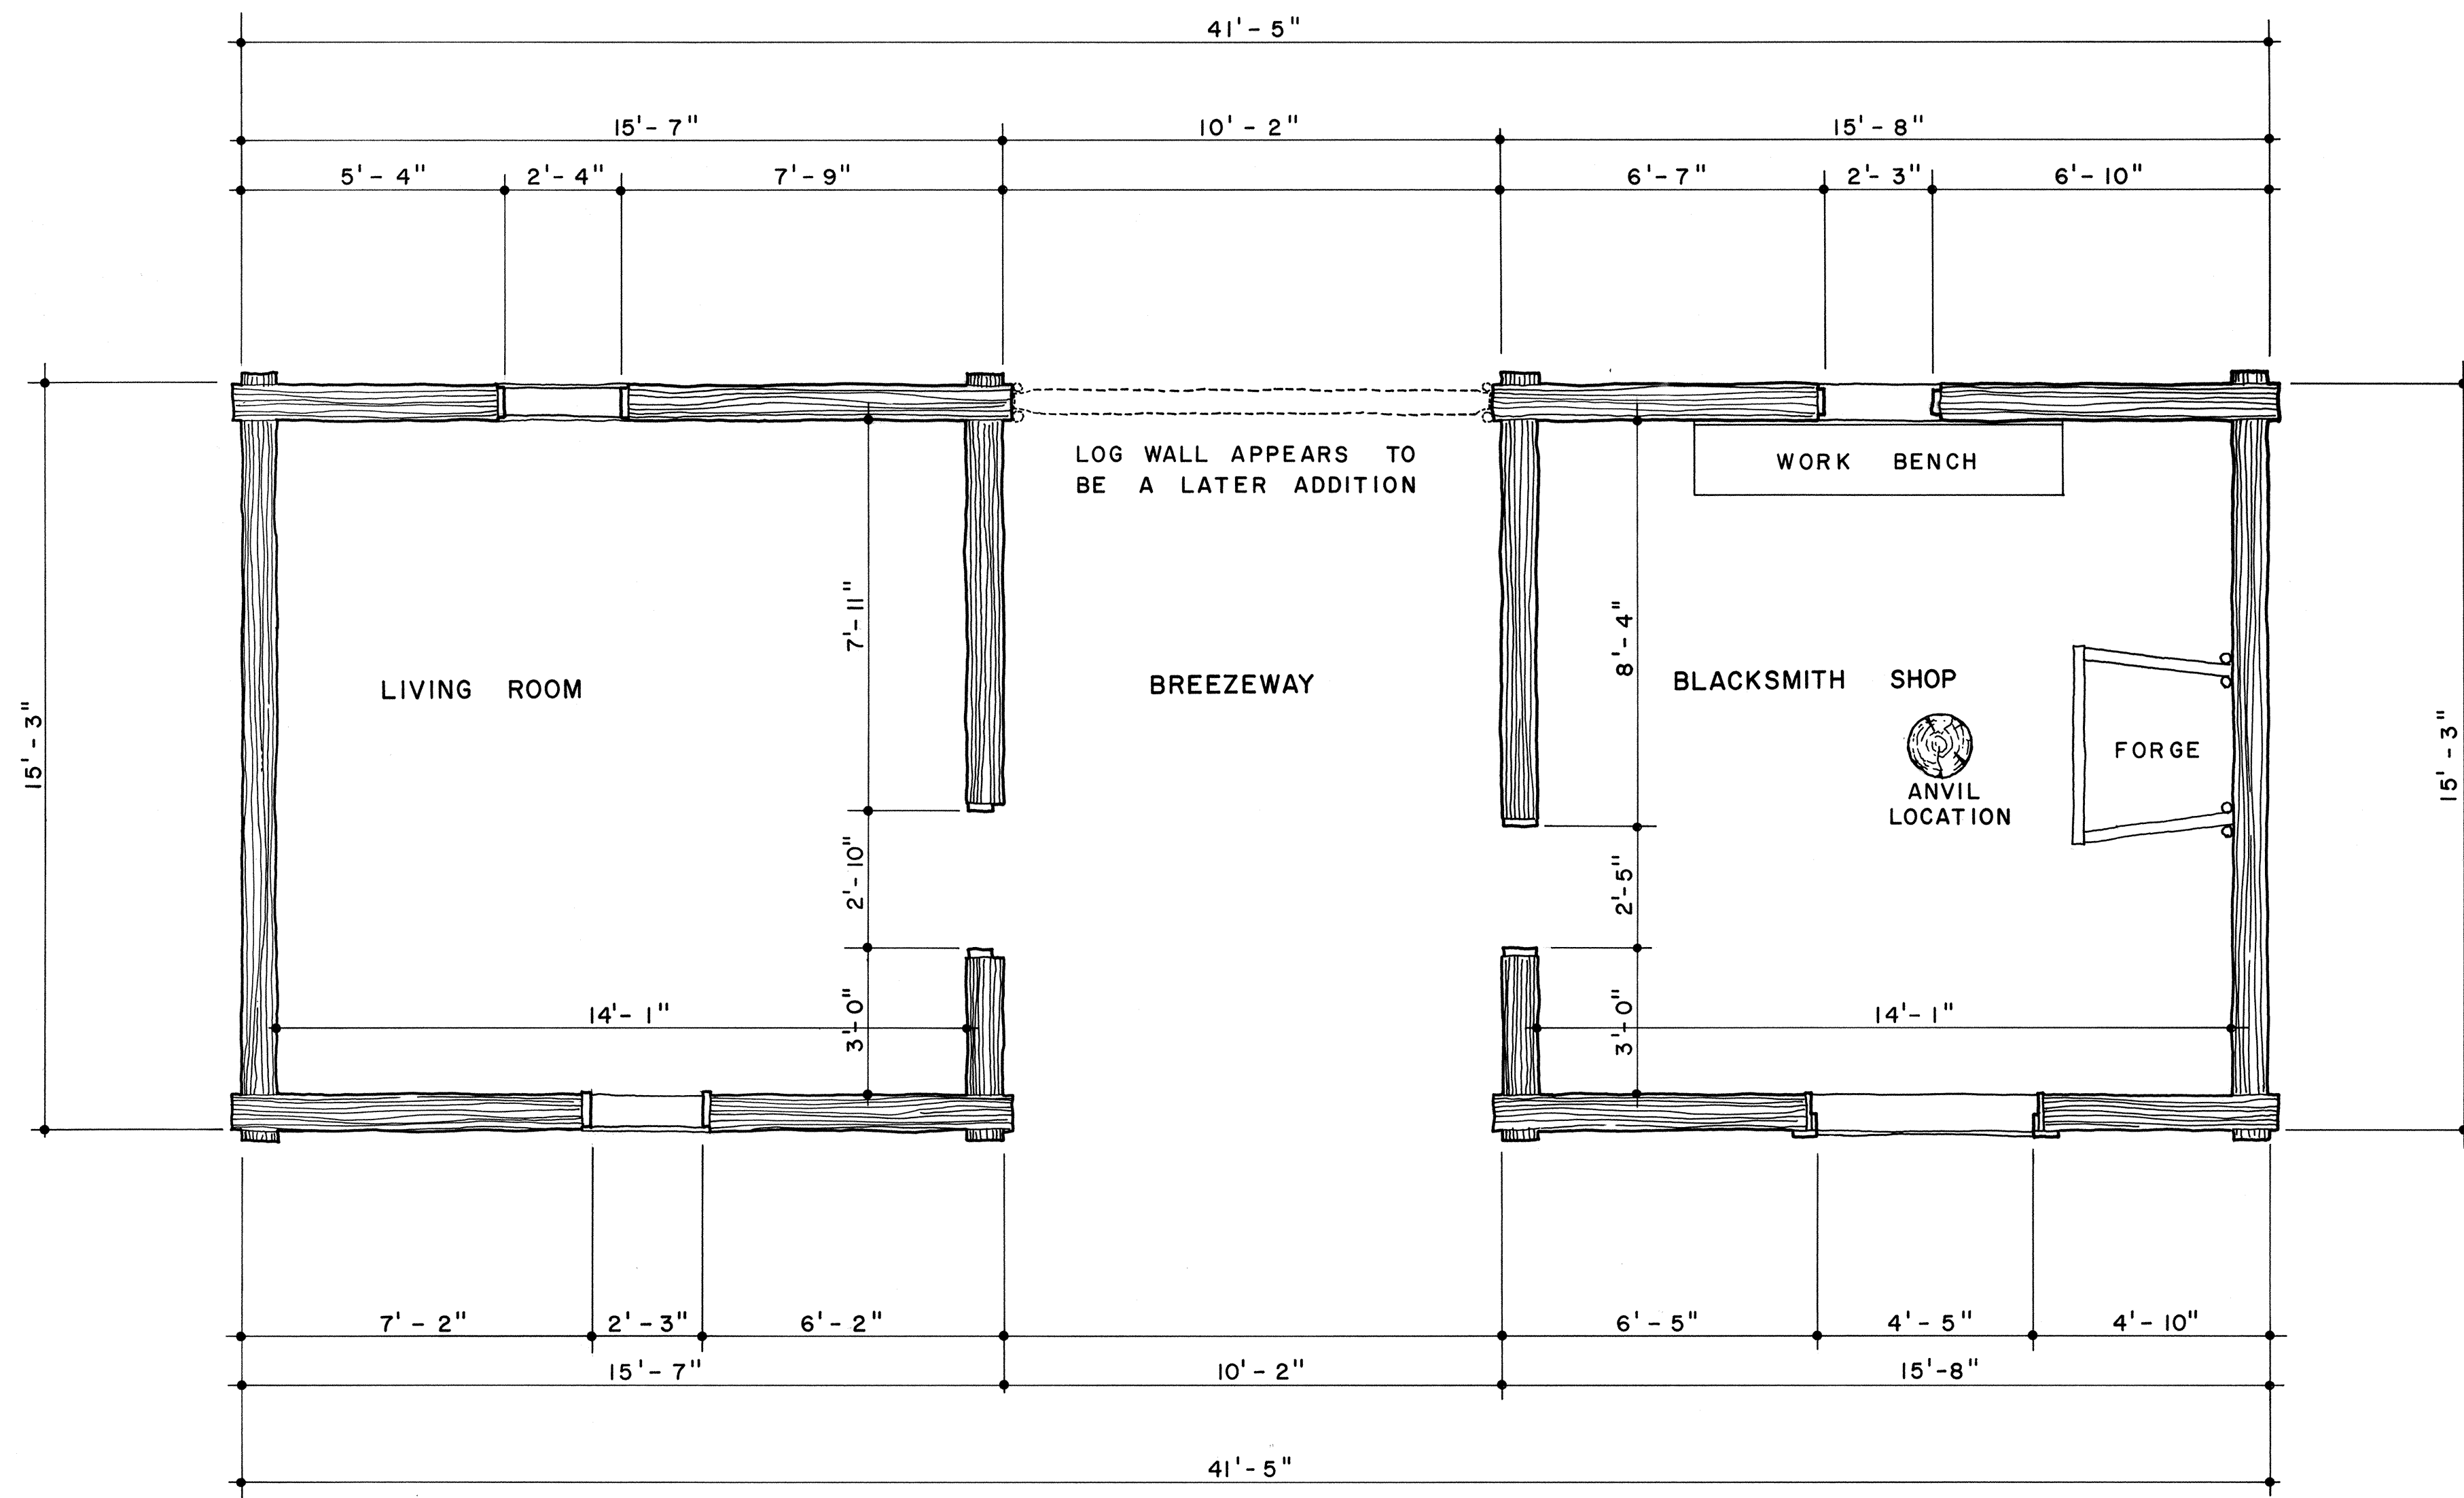

NOTE :
CABIN COMPLETELY
RESTORED IN 1956.

FLOOR PLAN

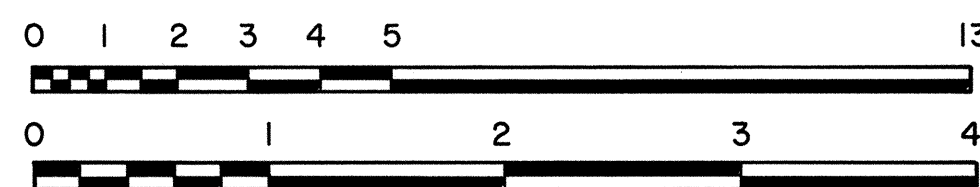

FEET

METERS



DRAWN BY: CHARLES B. GOLDY, JR.

WESTERN OFFICE
SAN FRANCISCO, CALIFORNIA
UNDER DIRECTION OF THE NATIONAL PARK SERVICE,
UNITED STATES DEPARTMENT OF THE INTERIOR

NAME AND LOCATION OF STRUCTURE

CUNNINGHAM CABIN

GRAND TETON NATIONAL PARK

MOOSE, WYOMING

SURVEY NO.

WYO 25


HISTORIC AMERICAN

BUILDINGS SURVEY

SHEET 2 OF 5 SHEETS



LIBRARY OF CONGRESS

INDEX NUMBER

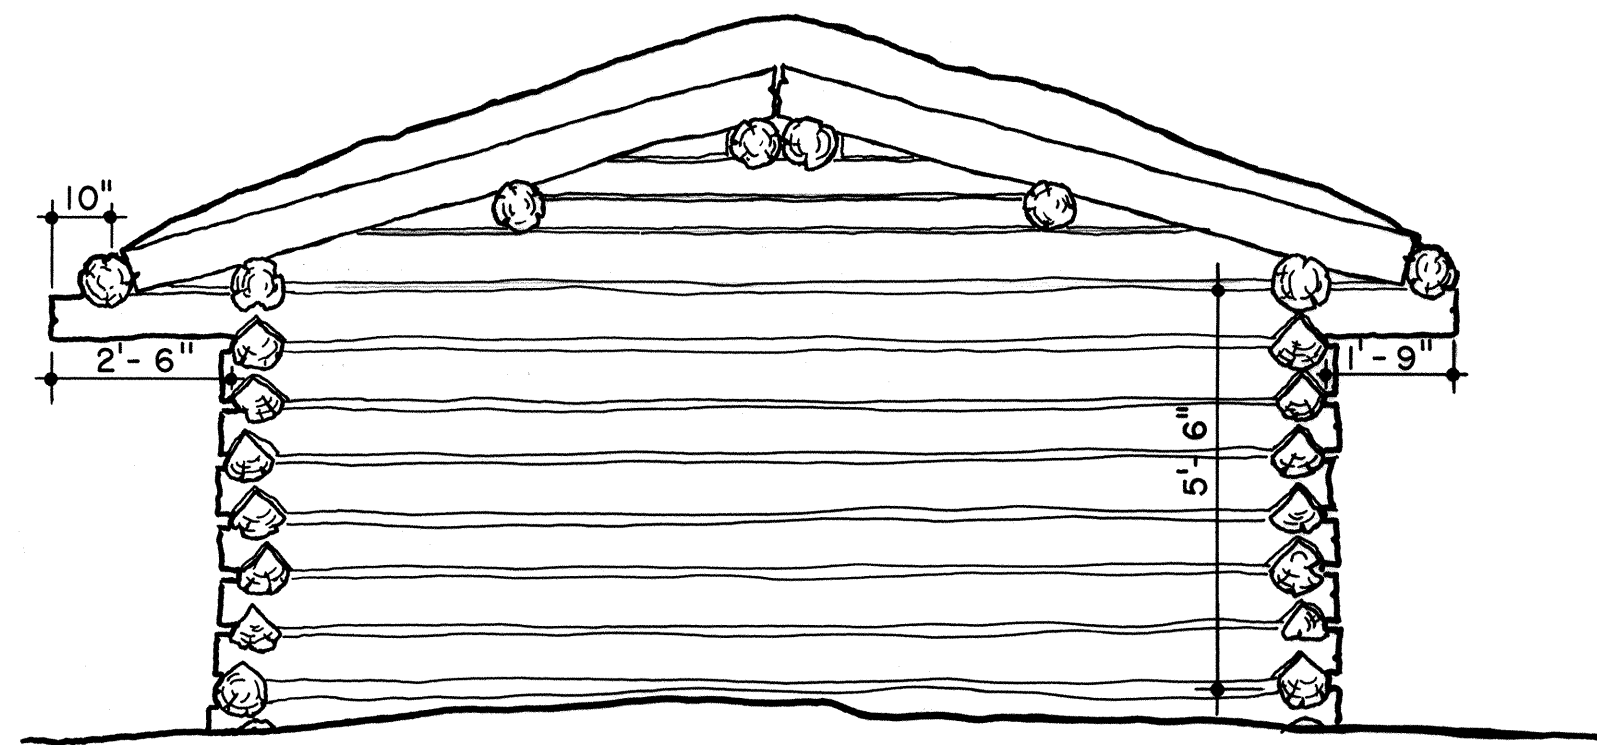

S O U T H E L E V A T I O N

E L E V A T I O N S

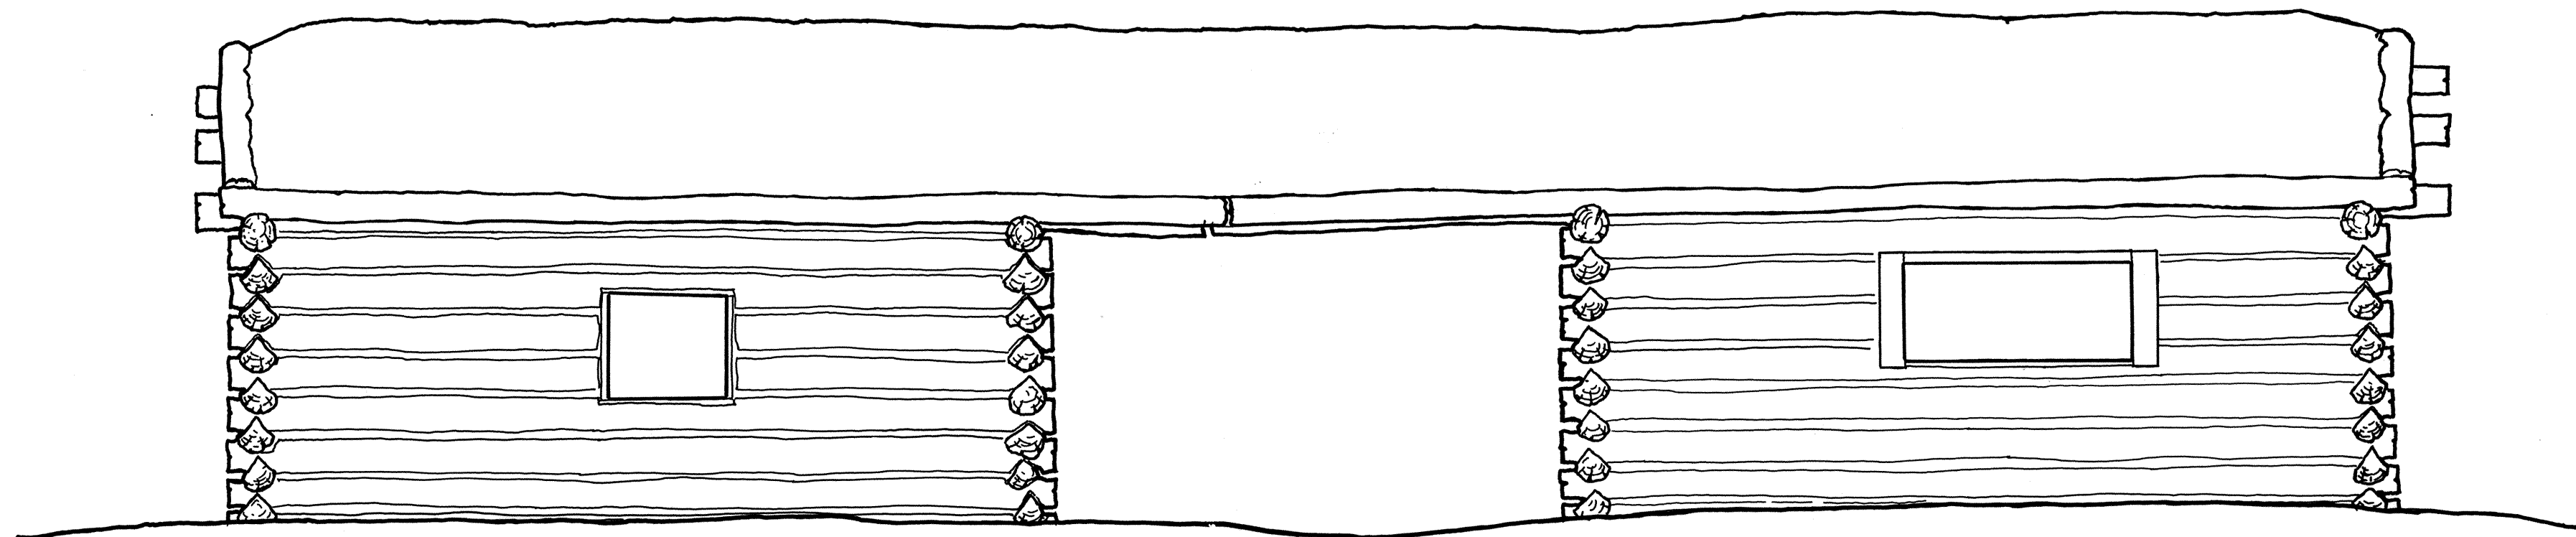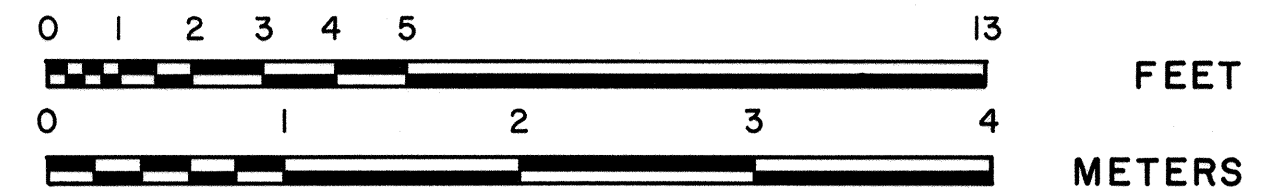

E A S T E L E V A T I O N

DRAWN BY: CHARLES B. GOLDY, JR.

WESTERN OFFICE
SAN FRANCISCO, CALIFORNIA
UNDER DIRECTION OF THE NATIONAL PARK SERVICE,
UNITED STATES DEPARTMENT OF THE INTERIOR

NAME AND LOCATION OF STRUCTURE

CUNNINGHAM CABIN

GRAND TETON NATIONAL PARK MOOSE, WYOMING


SURVEY NO.

WYO 25


HISTORIC AMERICAN
BUILDINGS SURVEY
SHEET 3 OF 5 SHEETS

LIBRARY OF CONGRESS
INDEX NUMBER


E L E V A T I O N S

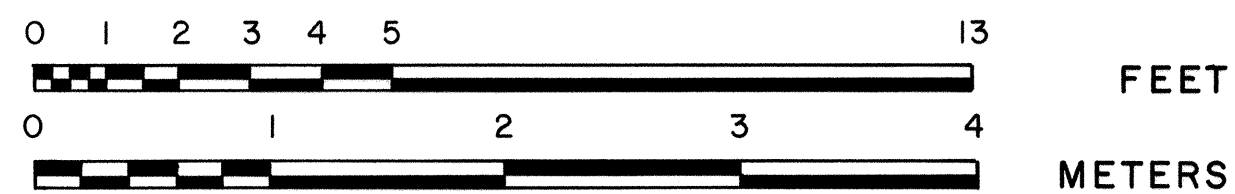

NOTE:
OPENING WAS WALLED UP WITH LOGS
AT A LATER DATE.

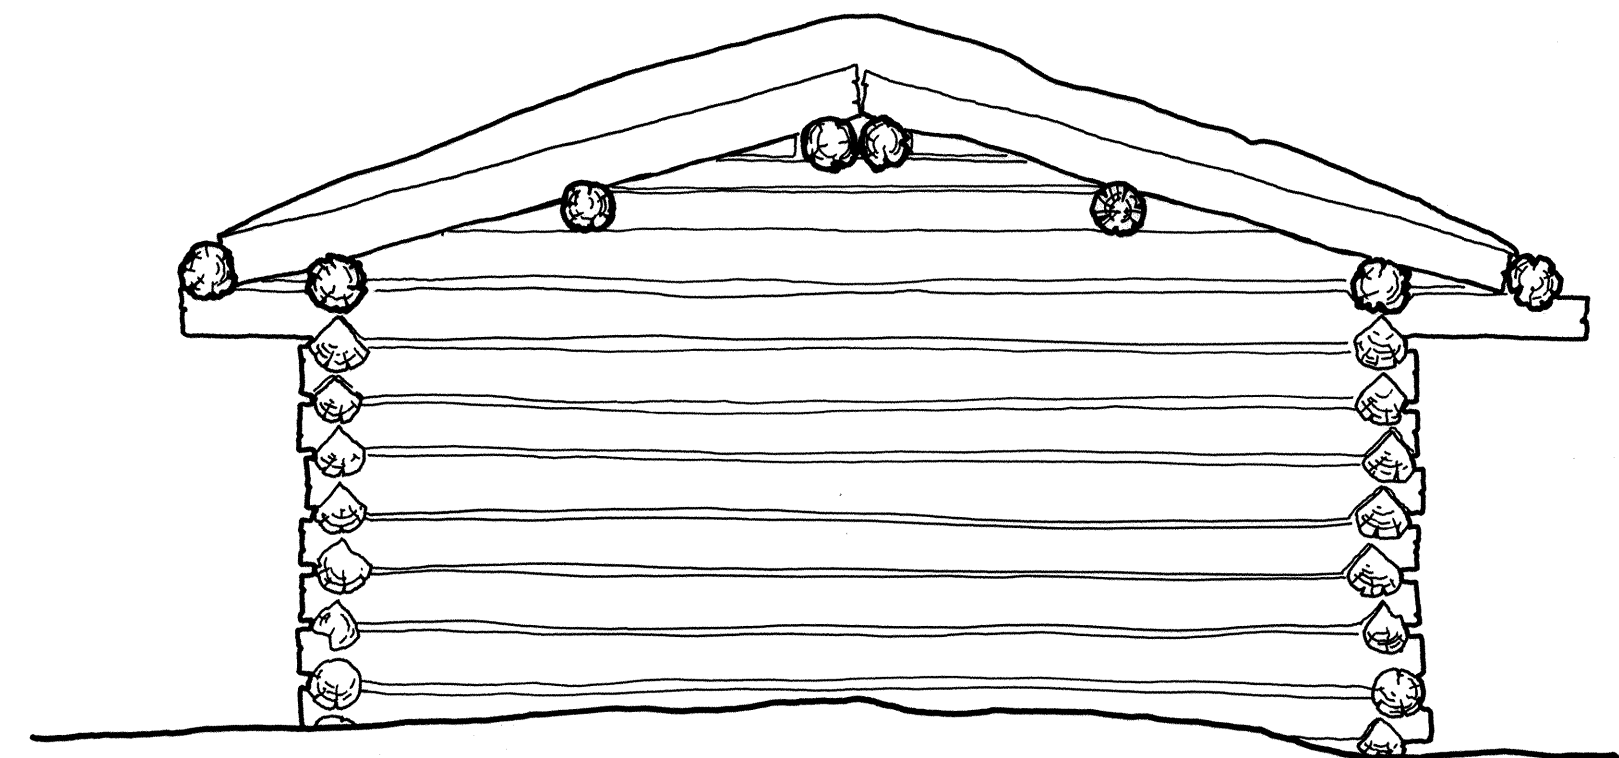

N O R T H E L E V A T I O N

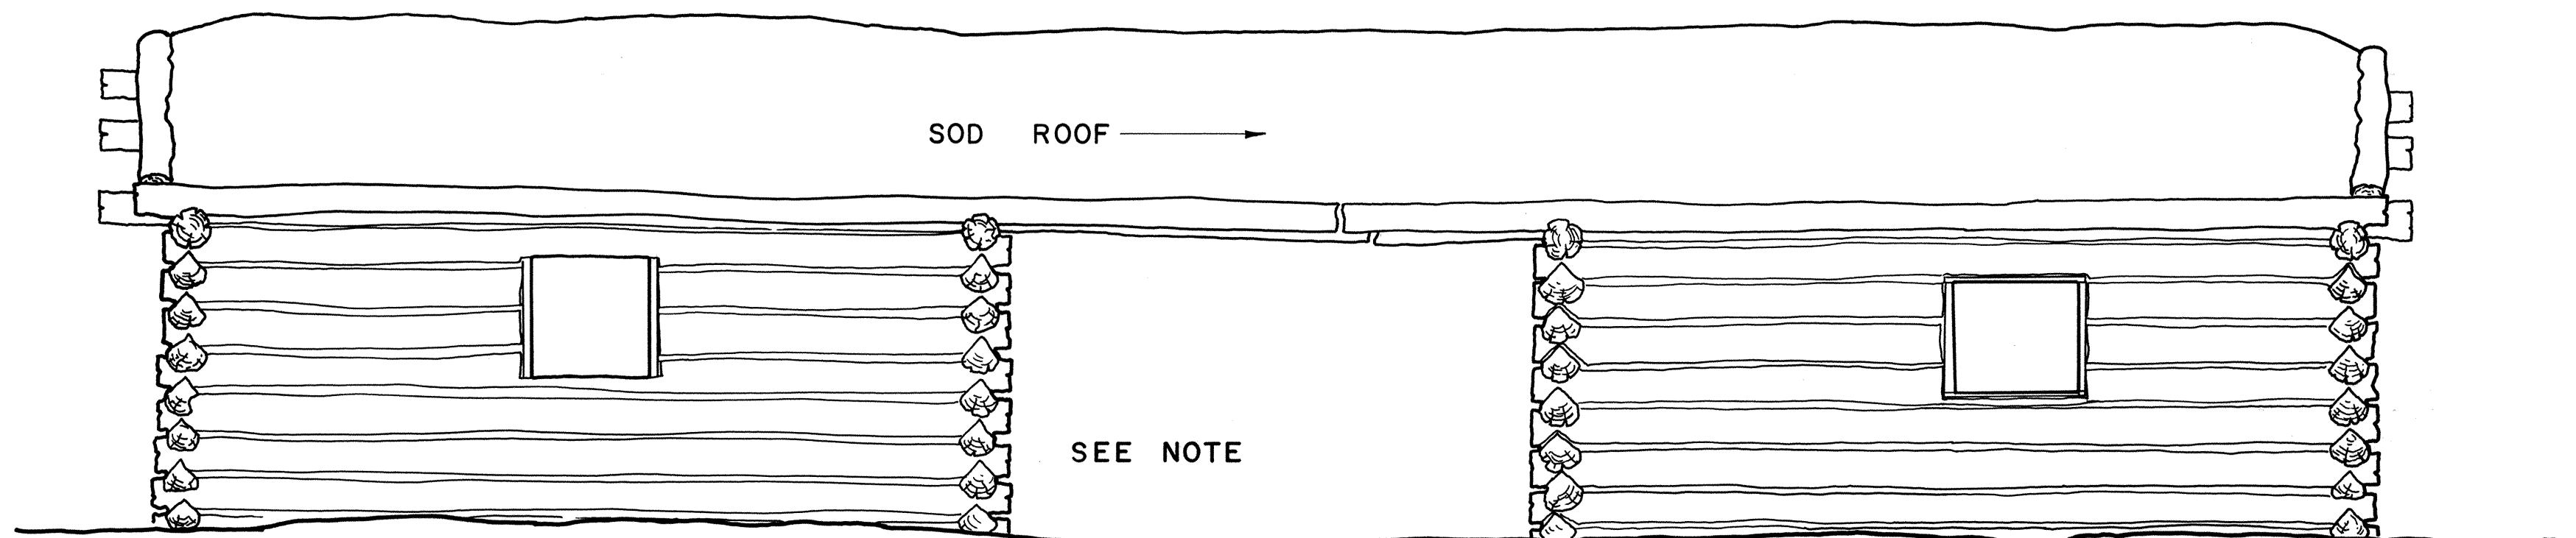

W E S T E L E V A T I O N

DRAWN BY: CHARLES B. GOLDY, JR.

WESTERN OFFICE
SAN FRANCISCO, CALIFORNIA
UNDER DIRECTION OF THE NATIONAL PARK SERVICE,
UNITED STATES DEPARTMENT OF THE INTERIOR

NAME AND LOCATION OF STRUCTURE


CUNNINGHAM CABIN

GRAND TETON NATIONAL PARK MOOSE, WYOMING

SURVEY NO.
WYO 25

HISTORIC AMERICAN
BUILDINGS SURVEY
SHEET 4 OF 5 SHEETS

LIBRARY OF CONGRESS
INDEX NUMBER

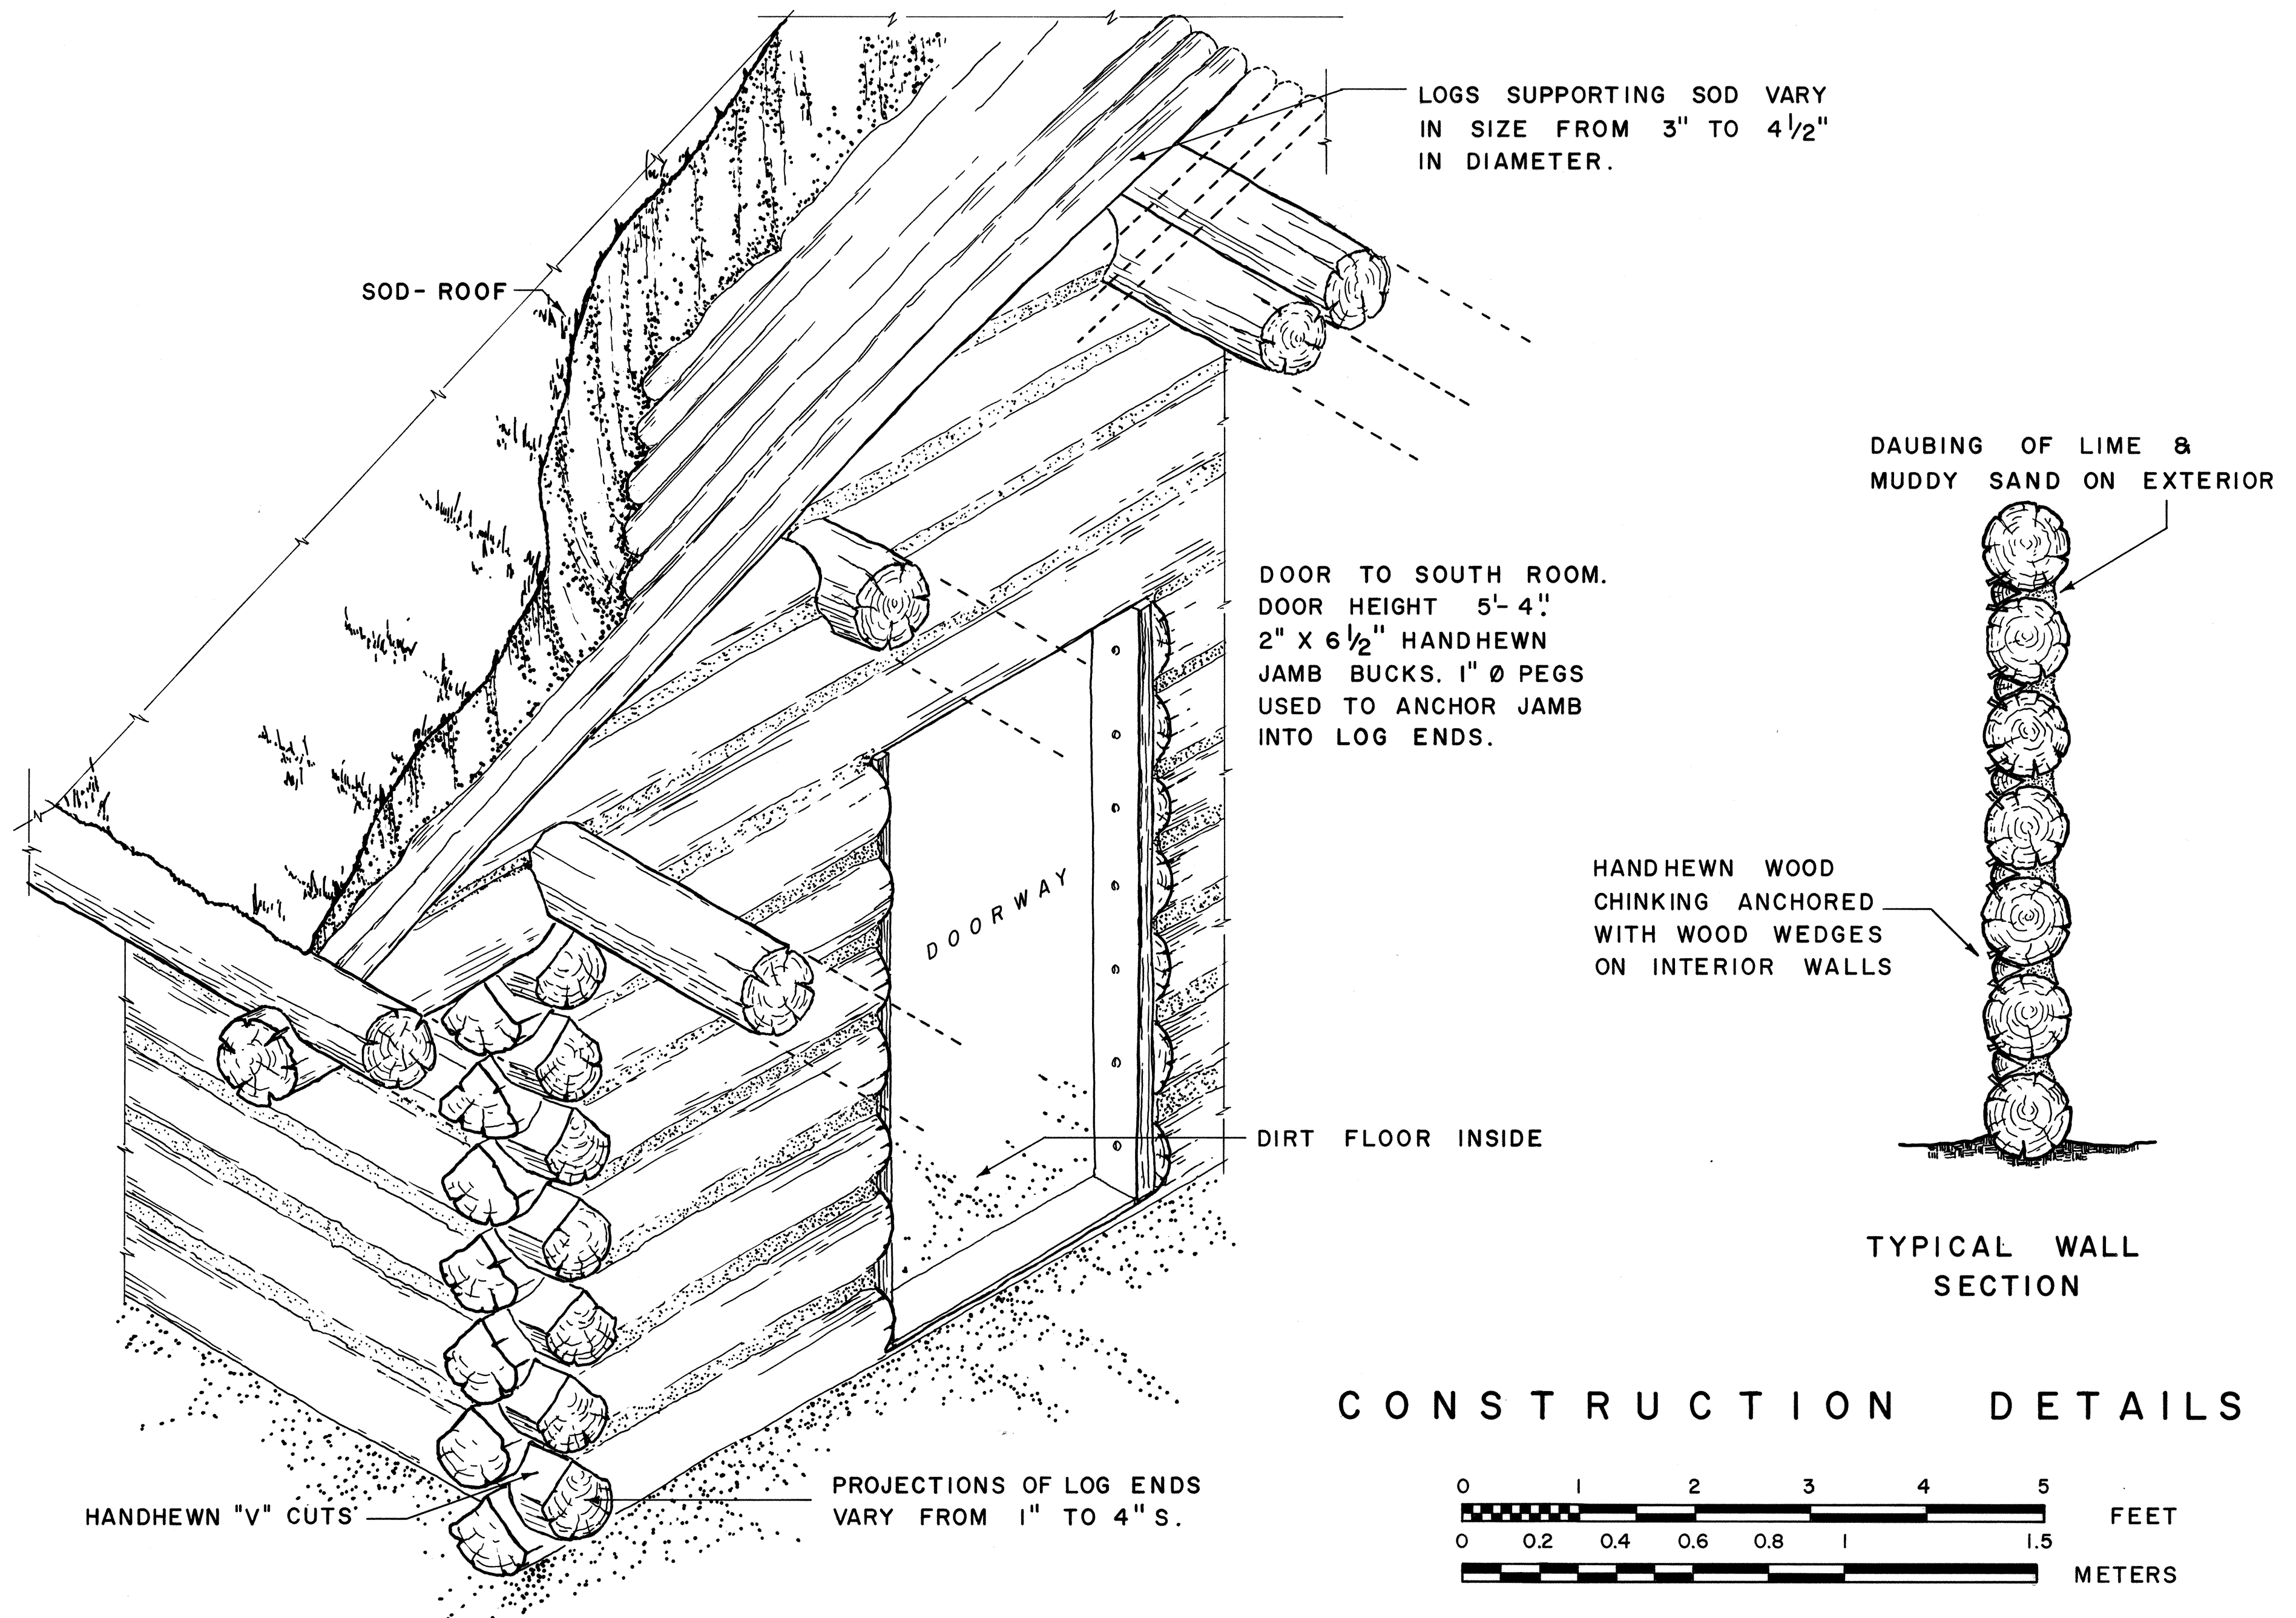

DRAWN BY: CHARLES B. GOLDY, JR.

WESTERN OFFICE
SAN FRANCISCO, CALIFORNIA
UNDER DIRECTION OF THE NATIONAL PARK SERVICE,
UNITED STATES DEPARTMENT OF THE INTERIOR

NAME AND LOCATION OF STRUCTURE

CUNNINGHAM CABIN

GRAND TETON NATIONAL PARK MOOSE, WYOMING

SURVEY NO.

WYO 25

HISTORIC AMERICAN
BUILDINGS SURVEY
SHEET 5 OF 5 SHEETS

LIBRARY OF CONGRESS
INDEX NUMBER

WYO, 20-MOOS.V, 2-

WYOMING

State

Teton

County

MOOSE VICINITY Nat'l Park) 4d

Town or Vicinity

(Grand Teton 3P

Structure CUNNINGHAM CABIN (WYO-25)

Between the Snake River and US Route 89, north of Moose Museum. Log, rectangular, 41'-5"X15'-3", sod roof, dog-trot plan. Built 1889 by James P. Cunningham, restored 1956. Only structure remaining on one of the oldest homesteads in the Jackson Hole area.

5 sheets (1965, including plan, elevations, details);
3 photos (1965); 4 data pages (1967).

NO COVER

REPRODUCIBLES

INKED CRONARS

FILE PRINTS

Form 10-444 (2/62)

HISTORIC AMERICAN BUILDINGS SURVEY



HABS WYO-25

HABS - WY6-25





28411 KODAK M10-52