Hubbell Trading Post, Gazebo
Ganado
Apache County
Arizona

HABS No. AZ-137-C

HABS
ARIZ,
1-GANA,
1G-

REDUCED COPIES OF MEASURED DRAWINGS

Historic American Buildings Survey
National Park Service
U.S. Department of the Interior
Washington, D.C. 20013-7127

TRIM LINE

K&E 19 1253

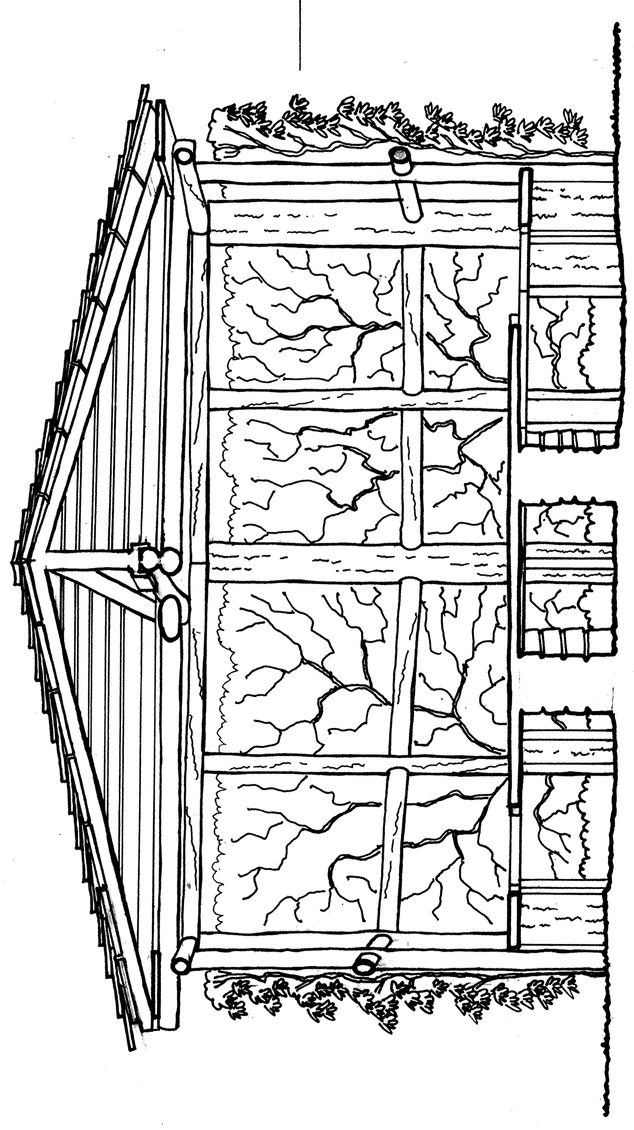

SECTION A-A

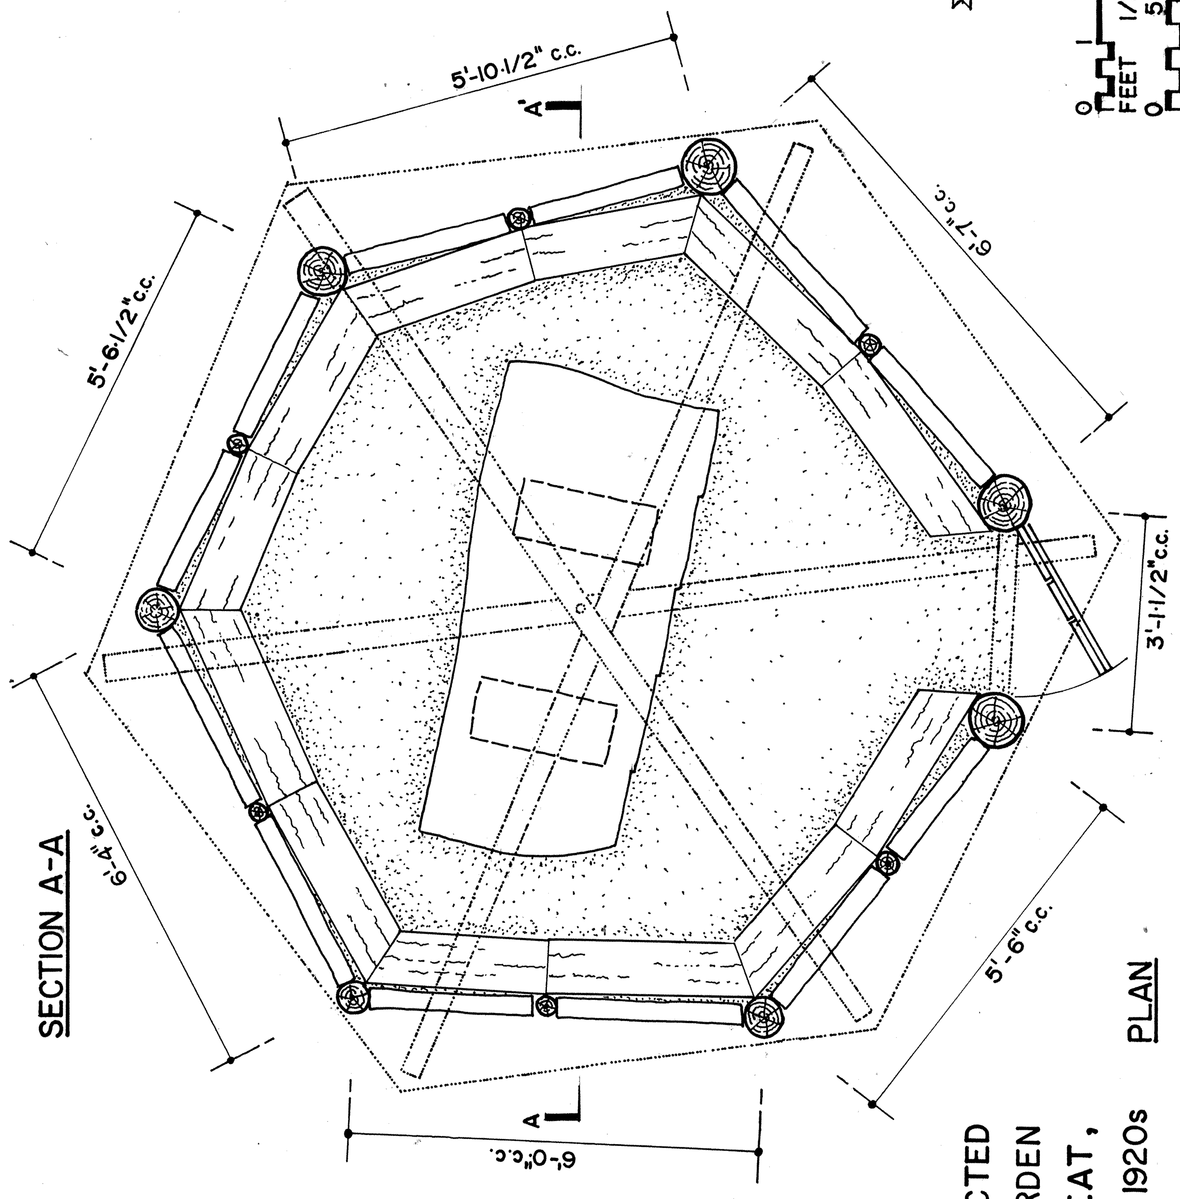

PLAN

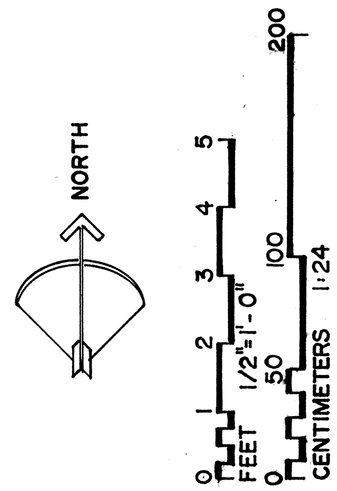

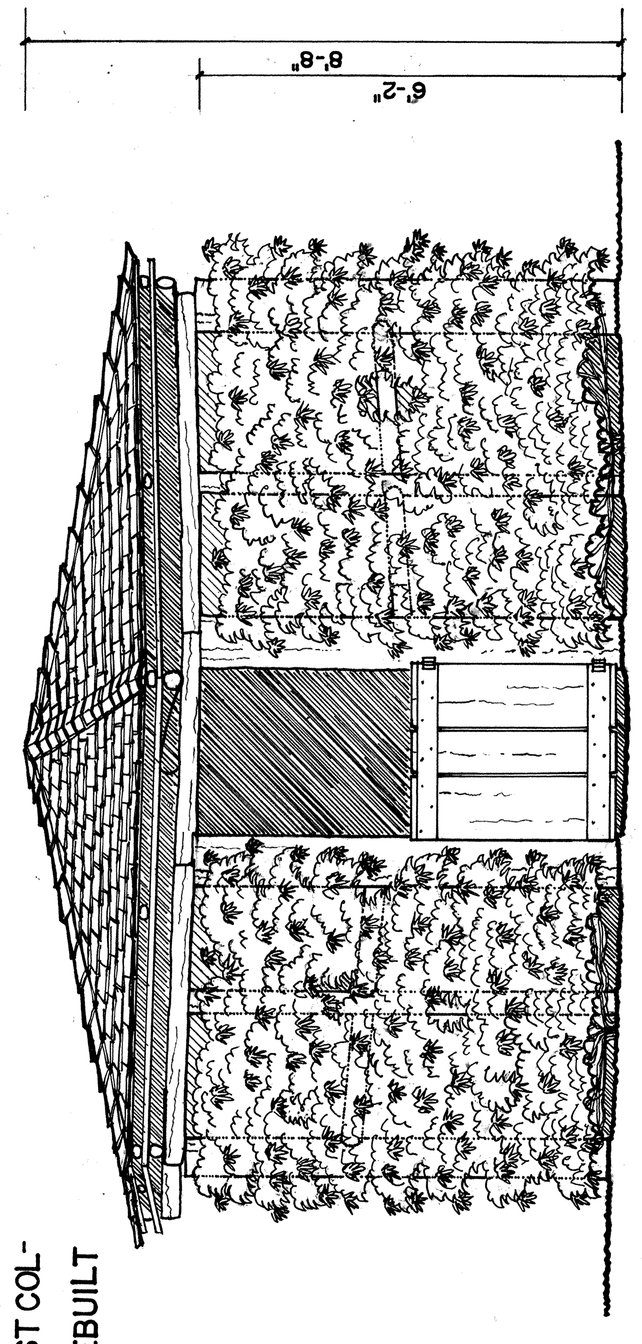

EAST ELEVATION

THE GAZEBO WAS CONSTRUCTED IN THE HUBBELL FAMILY GARDEN AS A COOL SUMMER RETREAT, PERHAPS AS EARLY AS THE 1920s ACCORDING TO PHOTOGRAPHS IN THE HUBBELL TRADING POST COLLECTION. THE ROOF WAS REBUILT IN 1985.

DRAWN BY: ANDREW WENCHEL

HUBBELL TRADING POST - 1985 NATIONAL PARK SERVICE UNITED STATES DEPARTMENT OF THE INTERIOR	NAME AND LOCATION OF STRUCTURE HUBBELL TRADING POST - GAZEBO GANADO APACHE COUNTY ARIZONA	SURVEY NO. AZ-137-C	HISTORIC AMERICAN BUILDINGS SURVEY SHEET 1 OF 1 SHEETS	LIBRARY OF CONGRESS INDEX NUMBER

IF REPRODUCED, PLEASE CREDIT: HISTORIC AMERICAN BUILDINGS SURVEY, NATIONAL PARK SERVICE, NAME OF DELINEATOR, DATE OF THE DRAWING

TRIM LINE

ORIGINAL — NOT FOR REPRODUCTION