Hubbell Trading Post, Root Cellar
Ganado
Apache County
Arizona

HABS No. AZ-137-F

HABS
ARIZ,
1-GANA,
1J-

REDUCED COPIES OF MEASURED DRAWINGS

Historic American Buildings Survey
National Park Service
U.S. Department of the Interior
Washington, D.C. 20013-7127

TRIM LINE

K&E 19 1253

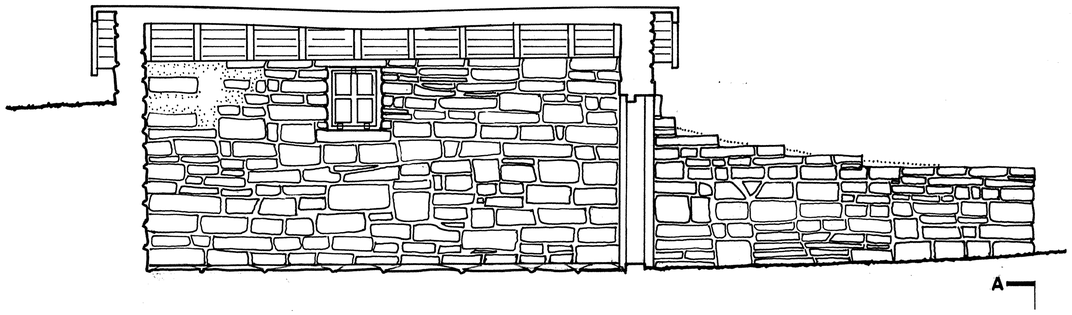

SECTION A-A

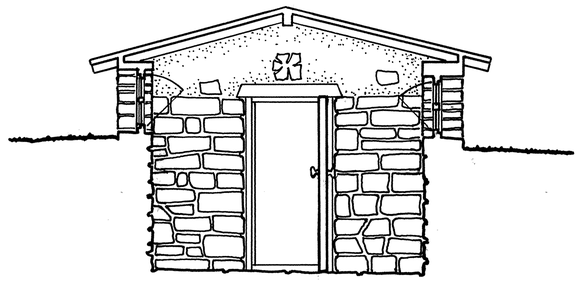

SECTION B-B

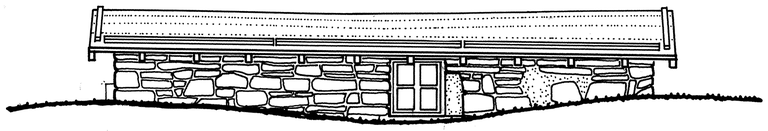

WEST ELEVATION

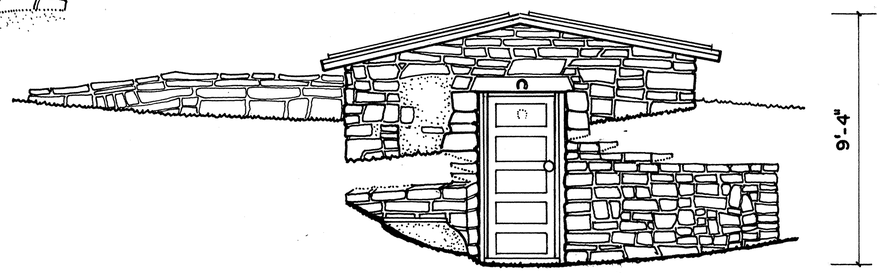

NORTH ELEVATION

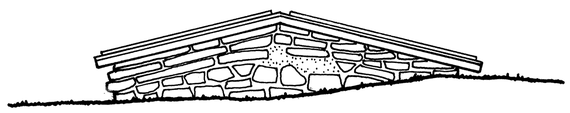

SOUTH ELEVATION

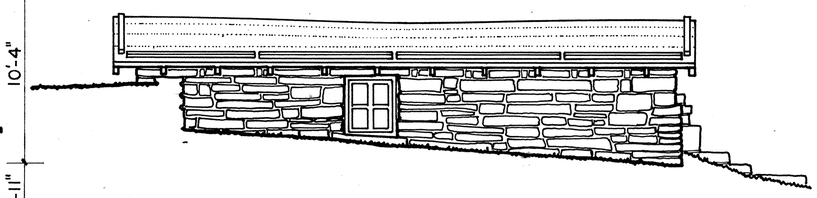

EAST ELEVATION

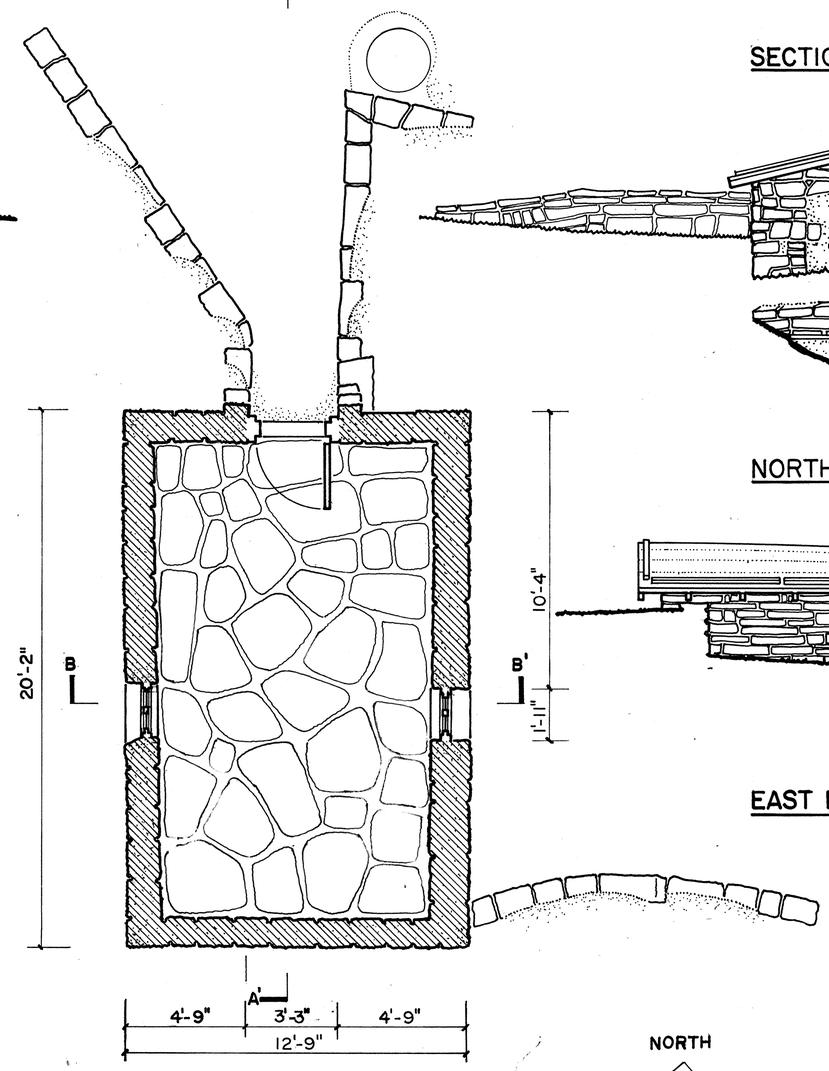

PLAN

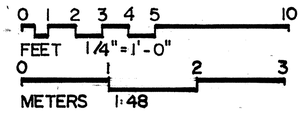

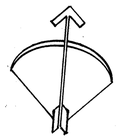

THE ROOT CELLAR WAS CONSTRUCTED BY THE NAVAJO TRIBE ON THE FORMER NAVAJO DAY SCHOOL TRACT FOR STORAGE USE. NOTEWORTHY FEATURES ARE THE RETAINING WALLS INTEGRAL WITH THE BUILDING.

MATERIALS

ROOF : COMPOSITION ROLL ROOFING OVER LOW PITCHED WOOD FRAMED GABLE

WALLS : SANDSTONE

FLOOR : SANDSTONE FLAGGING

DRAWN BY: ANDREW WENCHEL

HUBBELL TRADING POST - 1985

NATIONAL PARK SERVICE
UNITED STATES DEPARTMENT OF THE INTERIOR

NAME AND LOCATION OF STRUCTURE

HUBBELL TRADING POST - ROOT CELLAR

GANADO APACHE COUNTY ARIZONA

SURVEY NO. AZ-137-F

HISTORIC AMERICAN BUILDINGS SURVEY

SHEET 1 OF 1 SHEETS

LIBRARY OF CONGRESS INDEX NUMBER

IF REPRODUCED, PLEASE CREDIT: HISTORIC AMERICAN BUILDINGS SURVEY, NATIONAL PARK SERVICE, NAME OF DELINEATOR, DATE OF THE DRAWING

TRIM LINE