MEYER MEAT MARKET BUILDING
Klondike Gold Rush National Historical Park
Skagway Historic District and White Pass
495 State Street
Skagway
Skagway-Hoonah-Angoon Census Area
Alaska

HABS AK-228
HABS AK-228

PHOTOGRAPHS

REDUCED COPIES OF MEASURED DRAWINGS

FIELD RECORDS

HISTORIC AMERICAN BUILDINGS SURVEY
ALASKA SUPPORT OFFICE
National Park Service
U.S. Department of the Interior
240 West 5th Avenue, Room 114
Anchorage, AK 99501

ADDENDUM TO:
MEYER MEAT MARKET BUILDING
Klondike Gold Rush National Historical Park
Skagway and White Pass Historic District
495 State Street (southwest corner at 5th Avenue)
Skagway
Municipality of Skagway Borough
Alaska

HABS AK-228
HABS AK-228

PHOTOGRAPHS

HISTORIC AMERICAN BUILDINGS SURVEY
National Park Service
U.S. Department of the Interior
1849 C Street NW
Washington, DC 20240

MEYER BUILDING

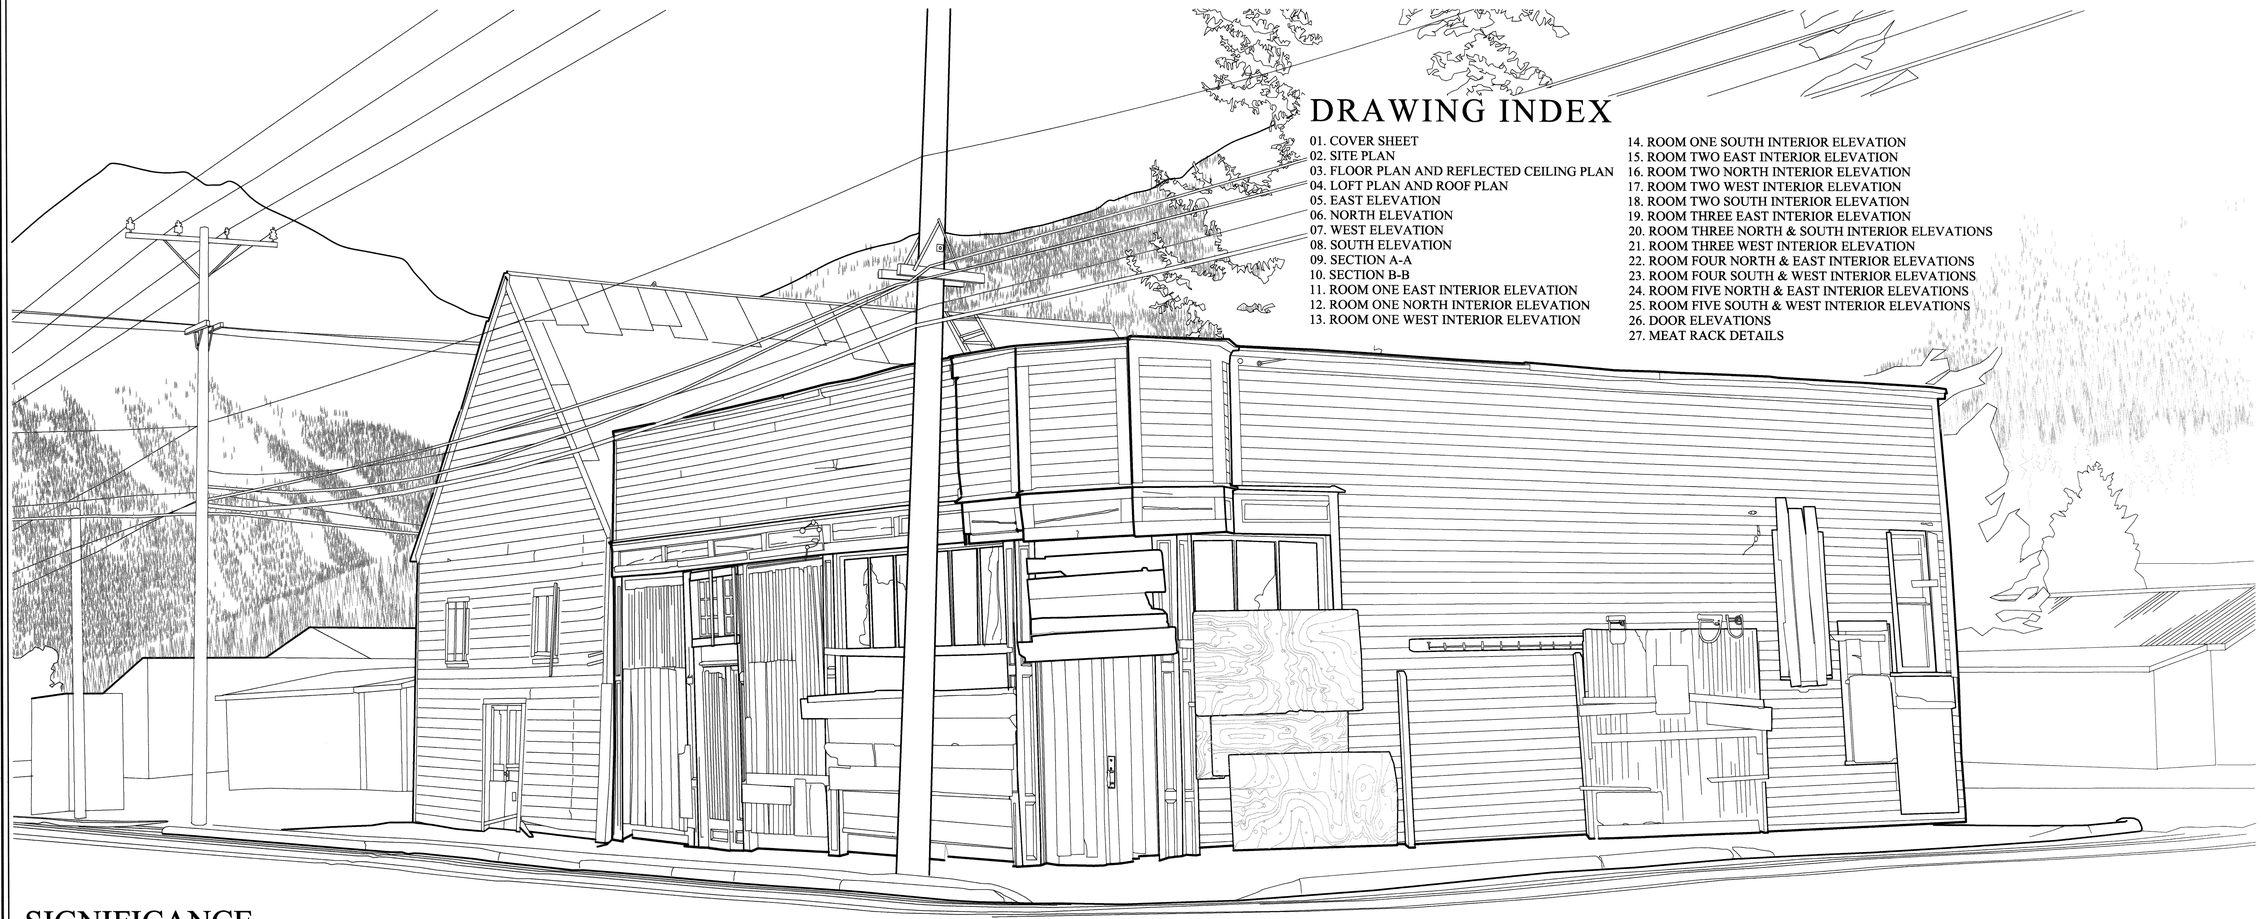

DRAWING INDEX

01. COVER SHEET
02. SITE PLAN
03. FLOOR PLAN AND REFLECTED CEILING PLAN
04. LOFT PLAN AND ROOF PLAN
05. EAST ELEVATION
06. NORTH ELEVATION
07. WEST ELEVATION
08. SOUTH ELEVATION
09. SECTION A-A
10. SECTION B-B
11. ROOM ONE EAST INTERIOR ELEVATION
12. ROOM ONE NORTH INTERIOR ELEVATION
13. ROOM ONE WEST INTERIOR ELEVATION
14. ROOM ONE SOUTH INTERIOR ELEVATION
15. ROOM TWO EAST INTERIOR ELEVATION
16. ROOM TWO NORTH INTERIOR ELEVATION
17. ROOM TWO WEST INTERIOR ELEVATION
18. ROOM TWO SOUTH INTERIOR ELEVATION
19. ROOM THREE EAST INTERIOR ELEVATION
20. ROOM THREE NORTH & SOUTH INTERIOR ELEVATIONS
21. ROOM THREE WEST INTERIOR ELEVATION
22. ROOM FOUR NORTH & EAST INTERIOR ELEVATIONS
23. ROOM FOUR SOUTH & WEST INTERIOR ELEVATIONS
24. ROOM FIVE NORTH & EAST INTERIOR ELEVATIONS
25. ROOM FIVE SOUTH & WEST INTERIOR ELEVATIONS
26. DOOR ELEVATIONS
27. MEAT RACK DETAILS

SIGNIFICANCE

IN 1899, HERMAN MEYER, A BUTCHER FROM SEATTLE, WASHINGTON, BUILT A NEW STRUCTURE FOR HIS MEAT BUSINESS AT THE CORNER OF STATE STREET AND FIFTH AVENUE IN SKAGWAY, ALASKA. HE RENTED OUT THE FIFTH AVENUE STOREFRONT TO THE BROWN SHOE COMPANY WHICH OPERATED HERE FROM 1900 TO 1902. IN 1900, A NEW RUSH TO NOME DIVERTED MINERS FROM THE KLONDIKE AND SKAGWAY'S ECONOMY FALTERED. THE BROWN SHOE COMPANY WENT OUT OF BUSINESS IN 1902. IN 1900, MEYER FOUNDED THE ARCTIC TELEPHONE COMPANY AND BEGAN INSTALLING TELEPHONE POLES AND LINES WITH THE INTENT TO SERVE AT LEAST 200 TELEPHONES. HE OPERATED THIS BUSINESS OUT OF HIS MEAT MARKET. MEYER SOLD HIS MEAT BUSINESS IN 1902 TO THE CARSTENS BROTHERS PACKING COMPANY OF SEATTLE, WHO CONTINUED TO OPERATE THE ARCTIC MEAT COMPANY UNTIL AT LEAST 1909. CARSTENS PURCHASED THE ADJACENT YMCA GYMNASIUM (BUILT 1900), MOVED IT TO FACE STATE STREET AND CONNECTED IT TO THE SOUTH ELEVATION OF THE MEYER BUILDING WITH A PASSAGEWAY. THE GYMNASIUM WAS CONVERTED TO A COLD STORAGE FACILITY TO SERVE THE ARCTIC MEAT COMPANY. IN 1921, GEORGE RAPUZZI PURCHASED THE YMCA GYMNASIUM FROM THE CITY OF SKAGWAY, WHICH HAD TAKEN OWNERSHIP. IN 1922, HE BOUGHT THE MEYER BUILDING FROM CARSTENS AND USED BOTH AS A GARAGE AND LATER STORAGE. THE RASMUSON FOUNDATION OF ANCHORAGE, ALASKA, PURCHASED BOTH BUILDINGS AND DONATED THEM TO THE NATIONAL PARK SERVICE IN 2008. THE MEYER BUILDING IS A CONTRIBUTING RESOURCE TO THE SKAGWAY AND WHITE PASS NATIONAL HISTORIC LANDMARK. THE NATIONAL PARK SERVICE PLANS TO REHABILITATE IT FOR A CONTEMPORARY USE.

TEAM MEMBERS

DANIELLE CAMPBELL	B.ARCH CANDIDATE '11	UNIVERSITY OF OREGON
MICHELLE CHIRCOP	M.S HPRES CANDIDATE '13	SCHOOL OF THE ART INSTITUTE CHICAGO
GRANT CROSBY	HISTORICAL ARCHITECT	NATIONAL PARK SERVICE
ROBERT LYON	HISTORIAN	NATIONAL PARK SERVICE
REBECCA SHAFFER	HISTORICAL ARCHITECT	NATIONAL PARK SERVICE
AARON WOOD	B.ARTS CANDIDATE '11	UNIVERSITY OF MINNESOTA

1 STATE MAP — SCALE 1" = 375 MILES (0 100 200 300 400 500 MI); 1 CM = 322 KM (0 200 400 600 800 KM)

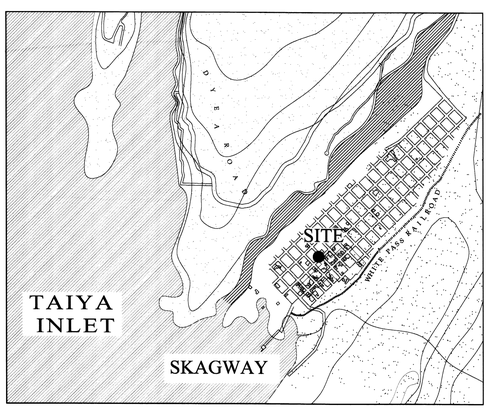

2 TOWN MAP — SCALE 1" = 2000 FT (0 500 1000 2000); CENTIMETERS 1:24,000 (0 200 400 600)

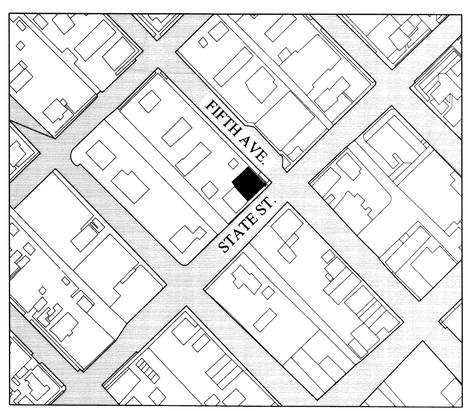

3 VICINITY MAP — SCALE 1" = 135 FT (0 100 200 300); CENTIMETERS 1:1600 (0 10 20 40 60 80)

DRAWN BY: DANIELLE CAMPBELL AND REBECCA SHAFFER (2010) MICHELLE CHIRCOP (2012)

MEYER BUILDING
NATIONAL PARK SERVICE
UNITED STATES DEPARTMENT OF THE INTERIOR

MEYER BUILDING
KLONDIKE GOLD RUSH NATIONAL HISTORICAL PARK
SKAGWAY
ALASKA

SURVEY NO. AK-228

HISTORIC AMERICAN BUILDINGS SURVEY
SHEET 1 OF 27 SHEETS

LIBRARY OF CONGRESS PRINTS AND PHOTOGRAPHS

IF REPRODUCED, PLEASE CREDIT THE HISTORIC AMERICAN BUILDINGS SURVEY, NATIONAL PARK SERVICE, NAME OF DELINEATOR, DATE OF DRAWING

SITE PLAN

SITE KEY

1. MEYER BUILDING (1899)
2. YMCA (1900 - RELOCATED 1903-1905)
3. SKAGWAY VOLUNTEER FIRE DEPARTMENT
4. PRIVATE RESIDENCE
5. PORTLAND HOUSE (CA. 1897)
6. TANNER BUILDING (CA. 1900)
7. CITY HALL (1897)
8. BOARD OF TRADE (1898)
9. TANNER RESIDENCE (CA. 1900s)
10. ELKS MEETING HALL
11. SEATTLE HOTEL, FRYE-BRUHN MEAT MARKET (1897)
12. HOUSE OF RICH (1906)

N

SCALE: FEET 1/16" = 1'-0" 0 4' 8' 16' 32'

CENTIMETERS 1:192 0 1 2 4 6 10

DRAWN BY: DANIELLE CAMPBELL AND REBECCA SHAFFER (2010)

MEYER BUILDING
NATIONAL PARK SERVICE
UNITED STATES DEPARTMENT OF THE INTERIOR

MEYER BUILDING
KLONDIKE GOLD RUSH NATIONAL HISTORICAL PARK
SKAGWAY ALASKA

STUDY NO. AK-228

HISTORIC AMERICAN BUILDINGS SURVEY
SHEET 2 OF 27 SHEETS

LIBRARY OF CONGRESS PRINTS & PHOTOGRAPHS

IF REPRODUCED, PLEASE CREDIT THE HISTORIC AMERICAN BUILDINGS SURVEY, NATIONAL PARK SERVICE, NAME OF DELINEATOR, DATE OF DRAWING

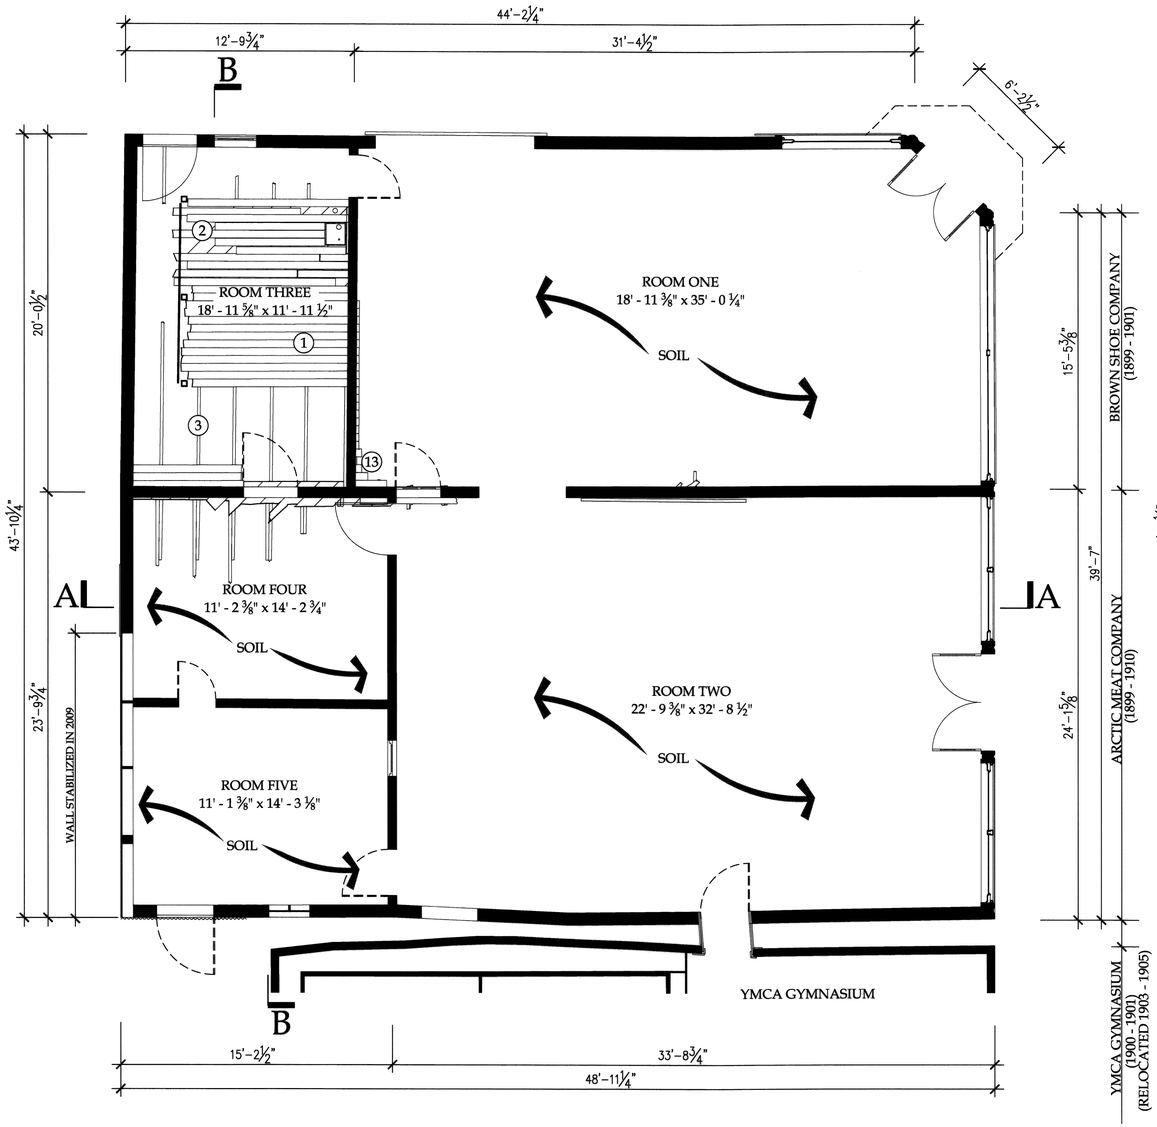

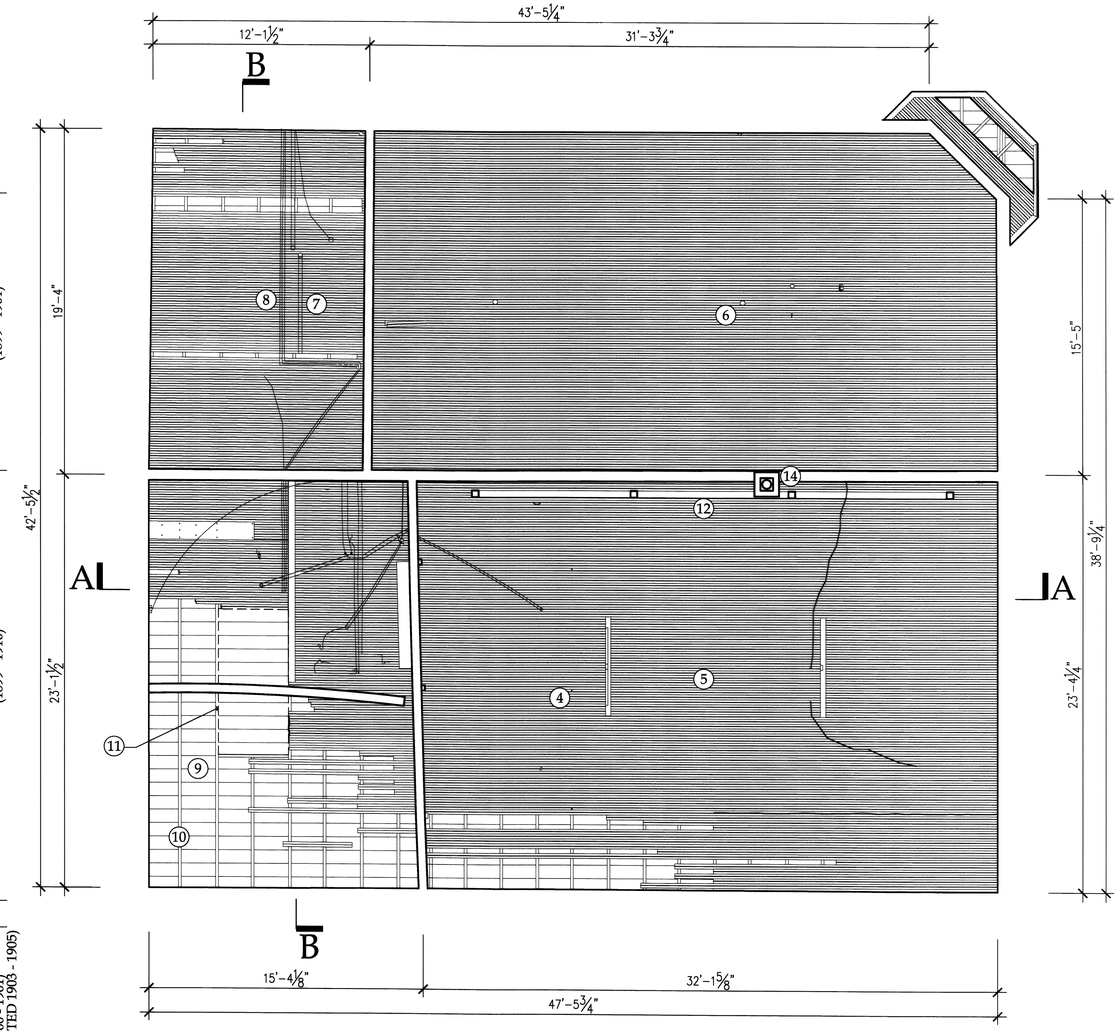

FLOOR PLAN

SCALE: ¼" = 1' - 0"

0 1' 2' 5' 10' FEET

0 0.5 1 2 3 METERS

REFLECTED CEILING PLAN

SCALE: ¼" = 1' - 0"

0 1' 2' 5' 10' FEET

0 0.5 1 2 3 METERS

MATERIAL NOTES

1. 5 ¼" x ¾" TONGUE & GROOVE FLOORING, DETERIORATED
2. 9" x ¾" SHIPLAP SUBFLOOR, DETERIORATED
3. 1⅞" x 6" FLOOR JOISTS, DETERIORATED
4. ½" DIA. STEEL RODS, ROW OF THREE
5. 3 ⅜" BEAD BOARD
6. PORCELAIN LIGHT SOCKETS
7. INSULATED COPPER ELECTRICAL WIRING
8. TELECOMMUNICATIONS WIRING
9. ¾" x 9" SHIPLAP DECKING
10. 1⅞" x 13¼" ROOF RAFTERS
11. ROOF ACCESS HATCH
12. MEAT RACK
13. REMNANTS OF ORIGINAL FLOORING, REMOVED IN 2009 STABILIZATION EFFORT
14. CHIMNEY

LIBRARY OF CONGRESS PRINTS & PHOTOGRAPHS

HISTORIC AMERICAN BUILDINGS SURVEY
SHEET 3 OF 27 SHEETS

SURVEY NO. AK-228

ALASKA

MEYER BUILDING

KLONDIKE GOLD RUSH NATIONAL HISTORICAL PARK

SKAGWAY

DRAWN BY: DANIELLE CAMPBELL AND REBECCA SHAFFER (2010) MICHELLE CHIRCOP (2012)

MEYER BUILDING
NATIONAL PARK SERVICE
UNITED STATES DEPARTMENT OF THE INTERIOR

IF REPRODUCED, PLEASE CREDIT THE HISTORIC AMERICAN BUILDINGS SURVEY, NATIONAL PARK SERVICE, NAME OF DELINEATOR, DATE OF DRAWING

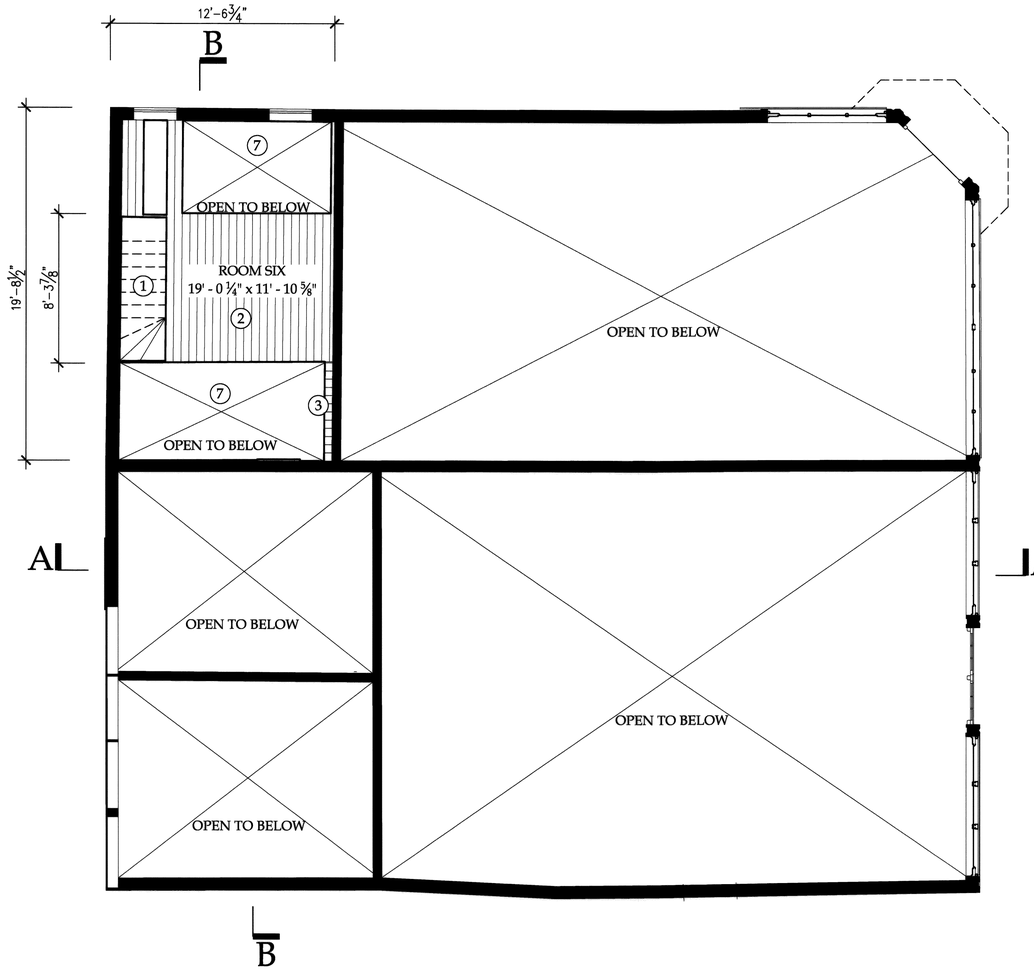

LOFT PLAN

SCALE: ¼" = 1' - 0"

0 1' 2' 5' 10' FEET

0 0.5 1 2 3 METERS

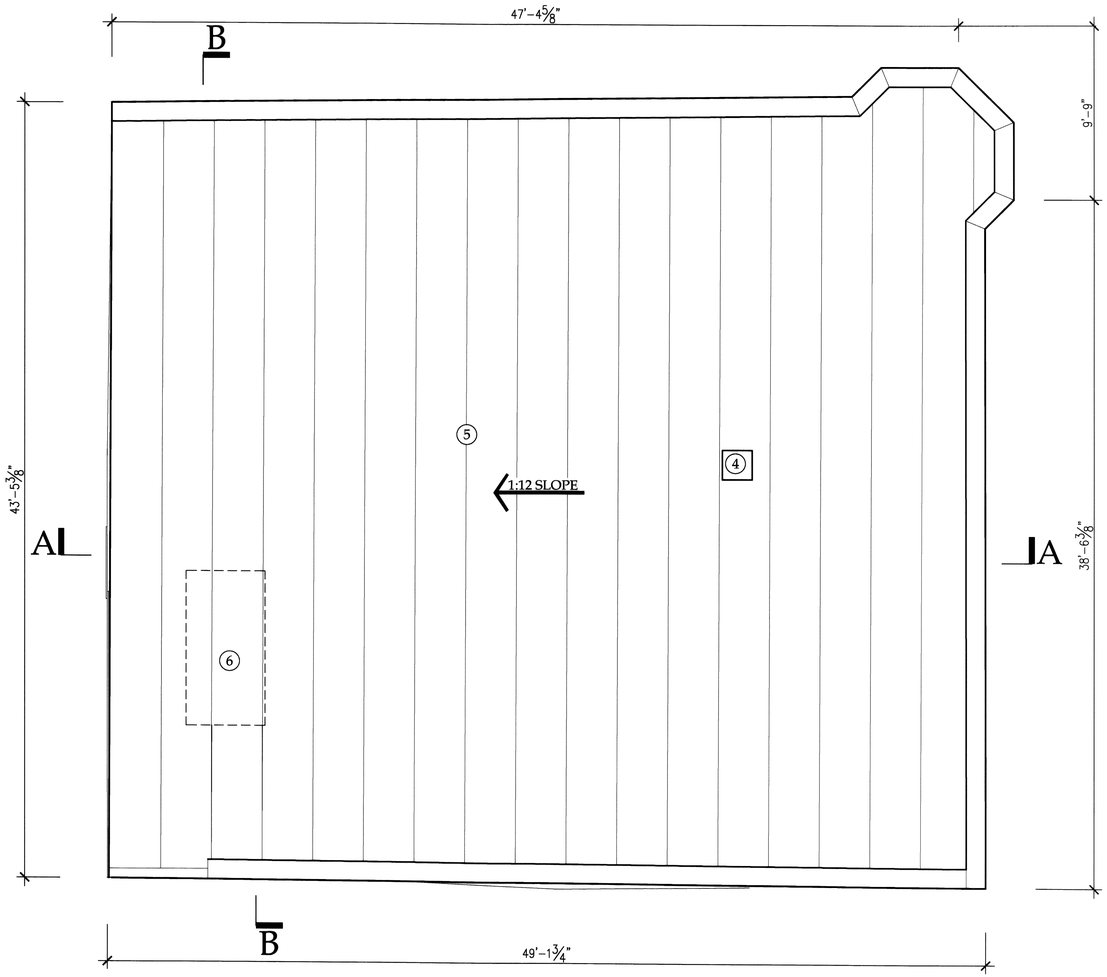

ROOF PLAN

SCALE: ¼" = 1' - 0"

0 1' 2' 5' 10' FEET

0 0.5 1 2 3 METERS

MATERIAL NOTES

1. STAIR, 11 RISERS @ 7⅝", 8 TREADS @ 9½", 1" NOSING, FOUR RADIAL TREADS
2. 1"x5½" DOUGLAS FIR TONGUE & GROOVE FLOOR
3. 1"x5½" DOUGLAS FIR TONGUE & GROOVE FLOOR, REMNANT
4. BRICK CHIMNEY, 6" FLUE PIPE, CAPPED WITH METAL
5. ROLLED ASPHALT ROOFING, 34" TO WEATHER
6. 8'-7" x 4'-5" ROOF ACCESS HATCH, REMOVED, 2009 STABILIZATION
7. FLOORING REMOVED DURING 2009 STABILIZATION EFFORT

DRAWN BY: DANIELLE CAMPBELL AND REBECCA SHAFFER (2010) MICHELLE CHIRCOP (2012)

MEYER BUILDING
NATIONAL PARK SERVICE
UNITED STATES DEPARTMENT OF THE INTERIOR

MEYER BUILDING

KLONDIKE GOLD RUSH NATIONAL HISTORICAL PARK

SKAGWAY ALASKA

SURVEY NO. AK-228

HISTORIC AMERICAN BUILDINGS SURVEY
SHEET 4 OF 27 SHEETS

LIBRARY OF CONGRESS PRINT ROOMS

IF REPRODUCED, PLEASE CREDIT THE HISTORIC AMERICAN BUILDINGS SURVEY, NATIONAL PARK SERVICE, NAME OF DELINEATOR, DATE OF DRAWING

EAST ELEVATION

SCALE: ½" = 1' - 0"

0 1' 2' 4' FEET

0 .25 0.5 1 METERS

MATERIAL NOTES

1. 5 ¼" x ¾" SHIPLAP SIDING
2. WINDOWS BOARDED UP AS LATE AS 1930
3. CHICKEN WIRE

DRAWN BY: DANIELLE CAMPBELL AND REBECCA SHAFFER (2010) MICHELLE CHIRCOP (2012)

MEYER BUILDING
KLONDIKE GOLD RUSH NATIONAL HISTORICAL PARK
SKAGWAY ALASKA

MEYER BUILDING
NATIONAL PARK SERVICE
UNITED STATES DEPARTMENT OF THE INTERIOR

SURVEY NO. AK-228

HISTORIC AMERICAN BUILDINGS SURVEY
SHEET 5 OF 27 SHEETS

LIBRARY OF CONGRESS PRINTS & PHOTOGRAPHS

IF REPRODUCED, PLEASE CREDIT THE HISTORIC AMERICAN BUILDINGS SURVEY, NATIONAL PARK SERVICE, NAME OF DELINEATOR, DATE OF DRAWING

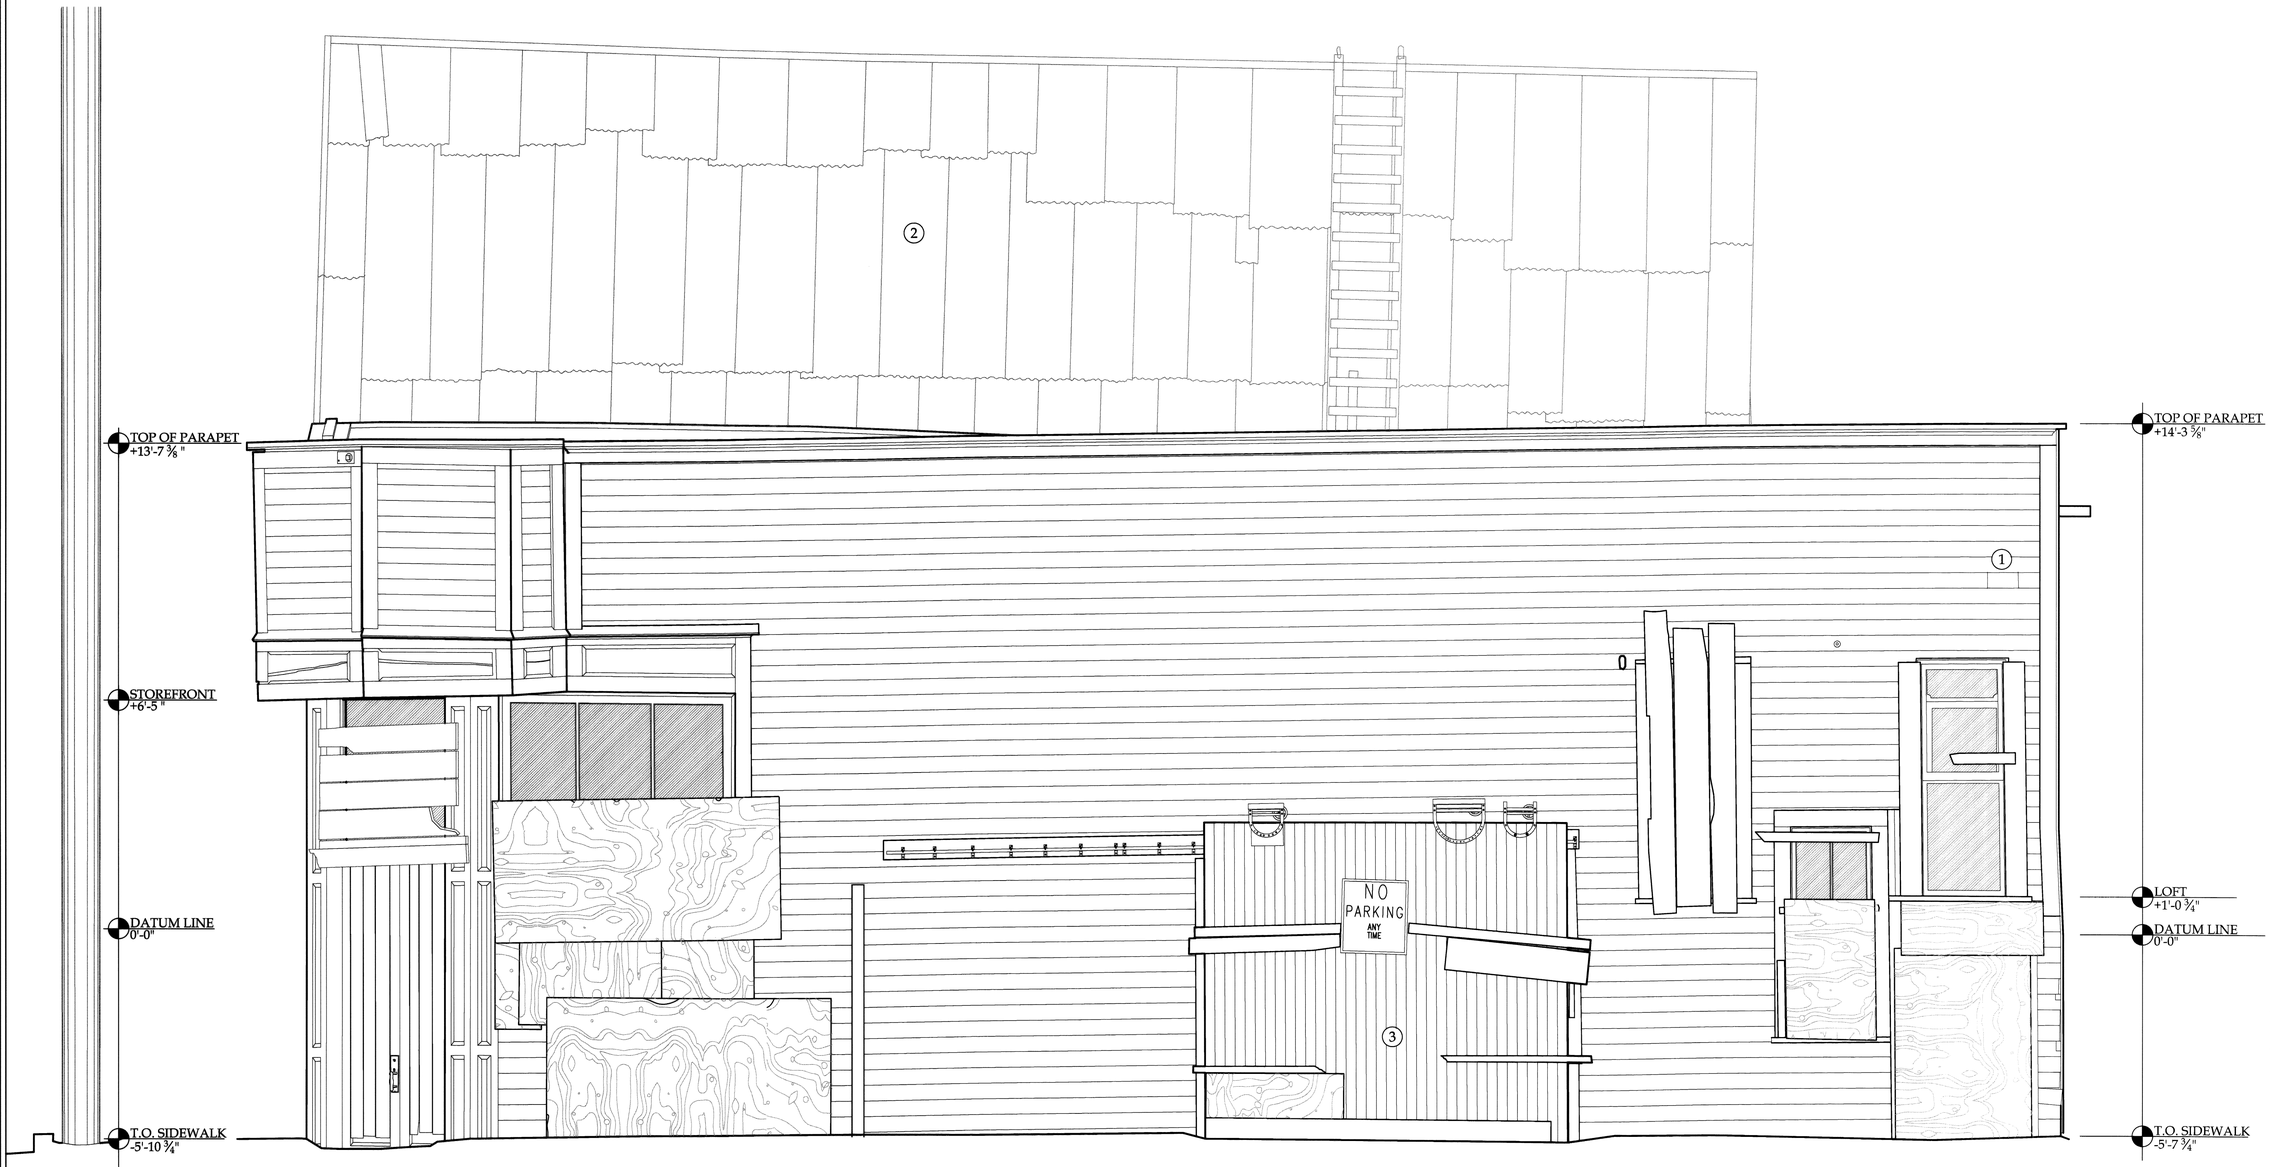

NORTH ELEVATION

SCALE: ½" = 1' - 0"

0 1' 2' 4' FEET

0 .25 0.5 1 METERS

MATERIAL NOTES

1. LOCATION OF ORIGINAL ROOF SCUPPER
2. YMCA GYMNASIUM ROOF BEYOND
3. SLIDING GARAGE DOOR ADDED BY GEORGE RAPUZZI CIRCA 1946 OR LATER

DRAWN BY: DANIELLE CAMPBELL AND REBECCA SHAFFER (2010) MICHELLE CHIRCOP (2012)

MEYER BUILDING

KLONDIKE GOLD RUSH NATIONAL HISTORICAL PARK

SKAGWAY ALASKA

SURVEY NO. AK-228

HISTORIC AMERICAN BUILDINGS SURVEY
SHEET 6 OF 27 SHEETS

LIBRARY OF CONGRESS PRINTS & PHOTOGRAPHS

MEYER BUILDING
NATIONAL PARK SERVICE
UNITED STATES DEPARTMENT OF THE INTERIOR

IF REPRODUCED, PLEASE CREDIT THE HISTORIC AMERICAN BUILDINGS SURVEY, NATIONAL PARK SERVICE, NAME OF DELINEATOR, DATE OF DRAWING

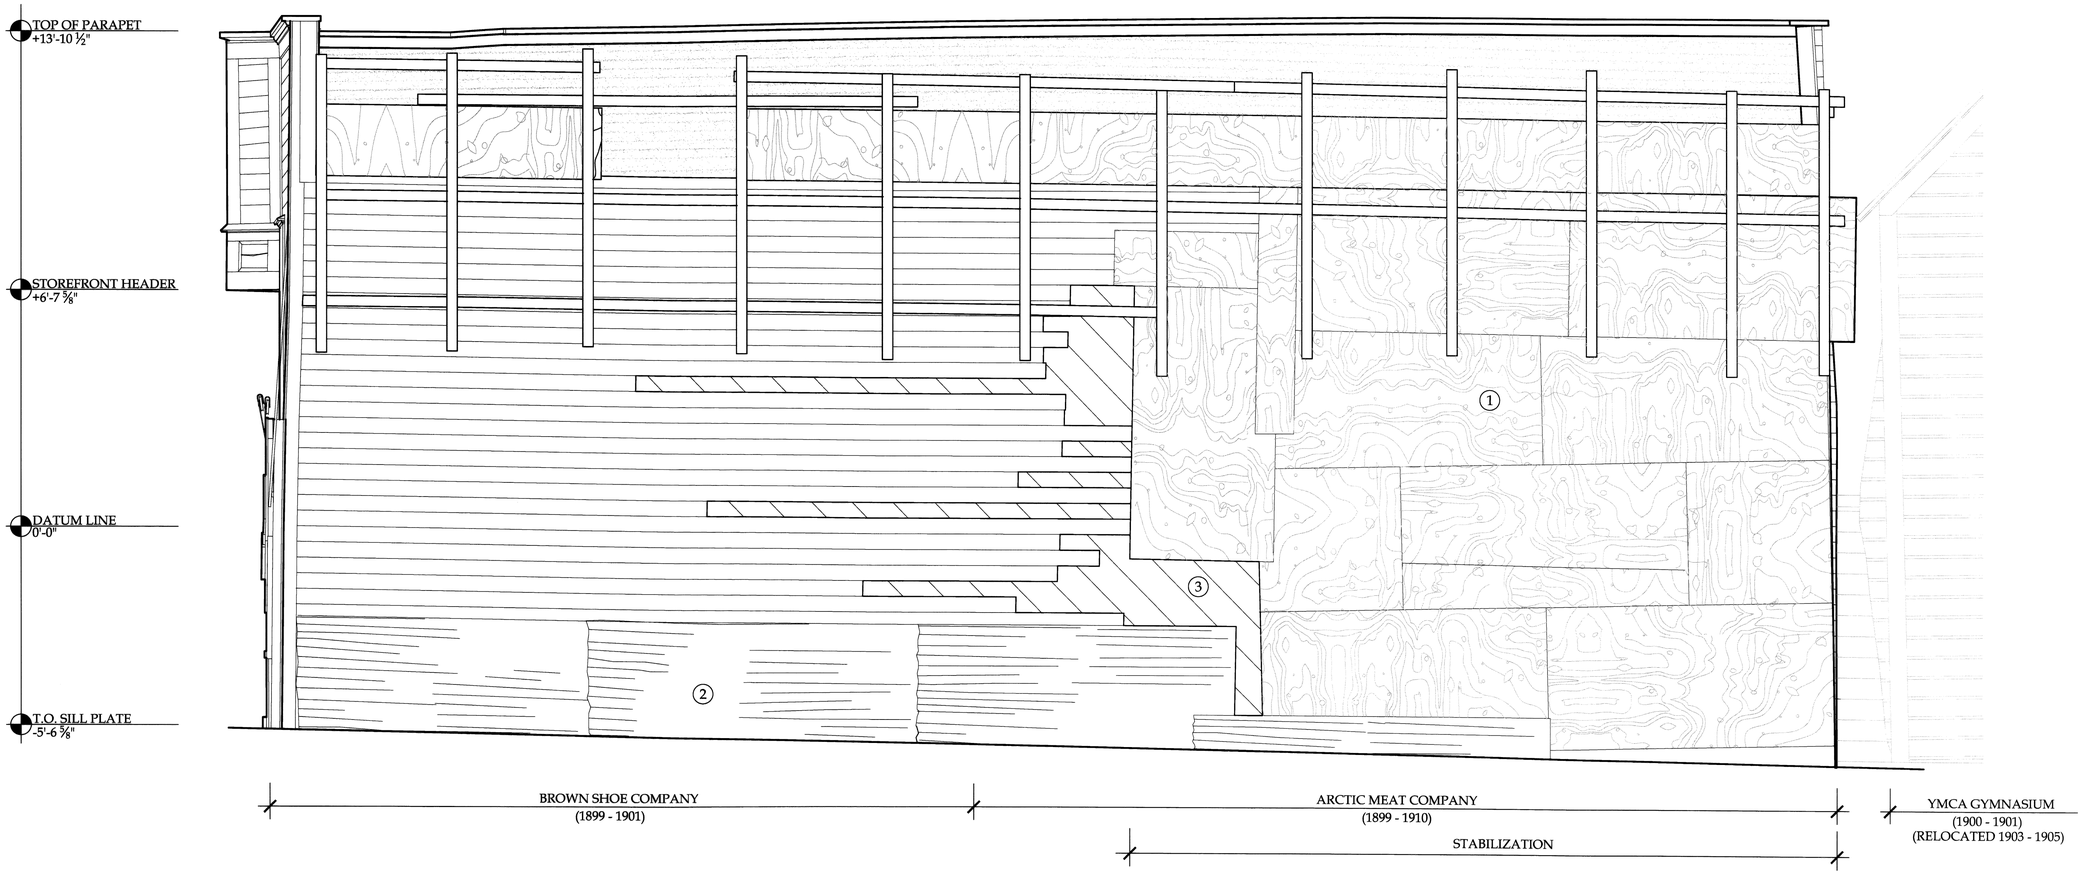

WEST ELEVATION

SCALE: ½" = 1' - 0"

0 1' 2' 4' FEET
0 .25 0.5 1 METERS

MATERIAL NOTES

1. NATIONAL PARK SERVICE STABILIZATION IN 2005 & 2009
2. CORRUGATED METAL PANELS
3. 1" x 10" DIAGONAL SHIPLAP SHEATHING

DRAWN BY: DANIELLE CAMPBELL AND REBECCA SHAFFER (2010) MICHELLE CHIRCOP (2012)

MEYER BUILDING
NATIONAL PARK SERVICE
UNITED STATES DEPARTMENT OF THE INTERIOR

MEYER BUILDING
KLONDIKE GOLD RUSH NATIONAL HISTORICAL PARK
SKAGWAY ALASKA

SURVEY NO. AK-228

HISTORIC AMERICAN BUILDINGS SURVEY
SHEET 7 OF 27 SHEETS

LIBRARY OF CONGRESS PRINTS & PHOTOGRAPHS

IF REPRODUCED, PLEASE CREDIT THE HISTORIC AMERICAN BUILDINGS SURVEY, NATIONAL PARK SERVICE, NAME OF DELINEATOR, DATE OF DRAWING

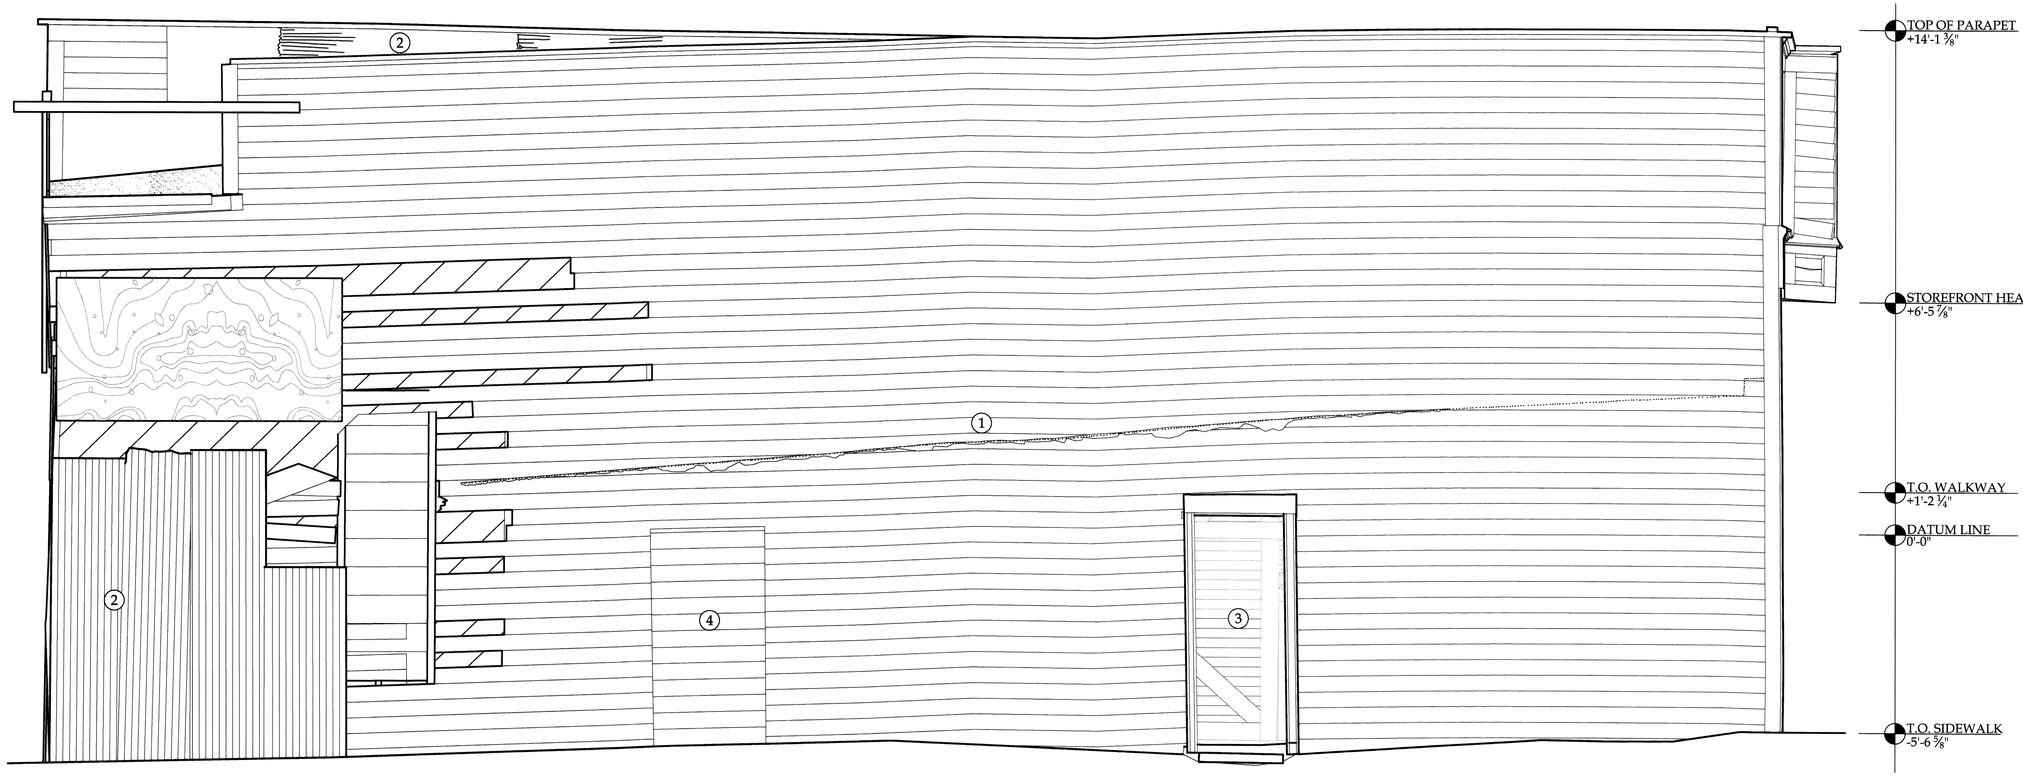

SOUTH ELEVATION

SCALE: ½" = 1' - 0"

0 1' 2' 4' FEET

0 .25 0.5 1 METERS

MATERIAL NOTES

1. REMNANT OF BUTTER STORE ROOF LINE, ROW OF TACKS AND ROOFING PAPER
2. CORRUGATED METAL PANELS
3. PASSAGE WAY TO YMCA GYMNASIUM
4. PATCH FROM PREVIOUS DOOR

DRAWN BY: DANIELLE CAMPBELL AND REBECCA SHAFFER (2010) MICHELLE CHIRCOP (2012)

MEYER BUILDING

KLONDIKE GOLD RUSH NATIONAL HISTORICAL PARK

SKAGWAY ALASKA

MEYER BUILDING
NATIONAL PARK SERVICE
UNITED STATES DEPARTMENT OF THE INTERIOR

SURVEY NO. AK-228

HISTORIC AMERICAN BUILDINGS SURVEY
SHEET 8 OF 27 SHEETS

LIBRARY OF CONGRESS PRINTS & PHOTOGRAPHS

IF REPRODUCED, PLEASE CREDIT THE HISTORIC AMERICAN BUILDINGS SURVEY, NATIONAL PARK SERVICE, NAME OF DELINEATOR, DATE OF DRAWING

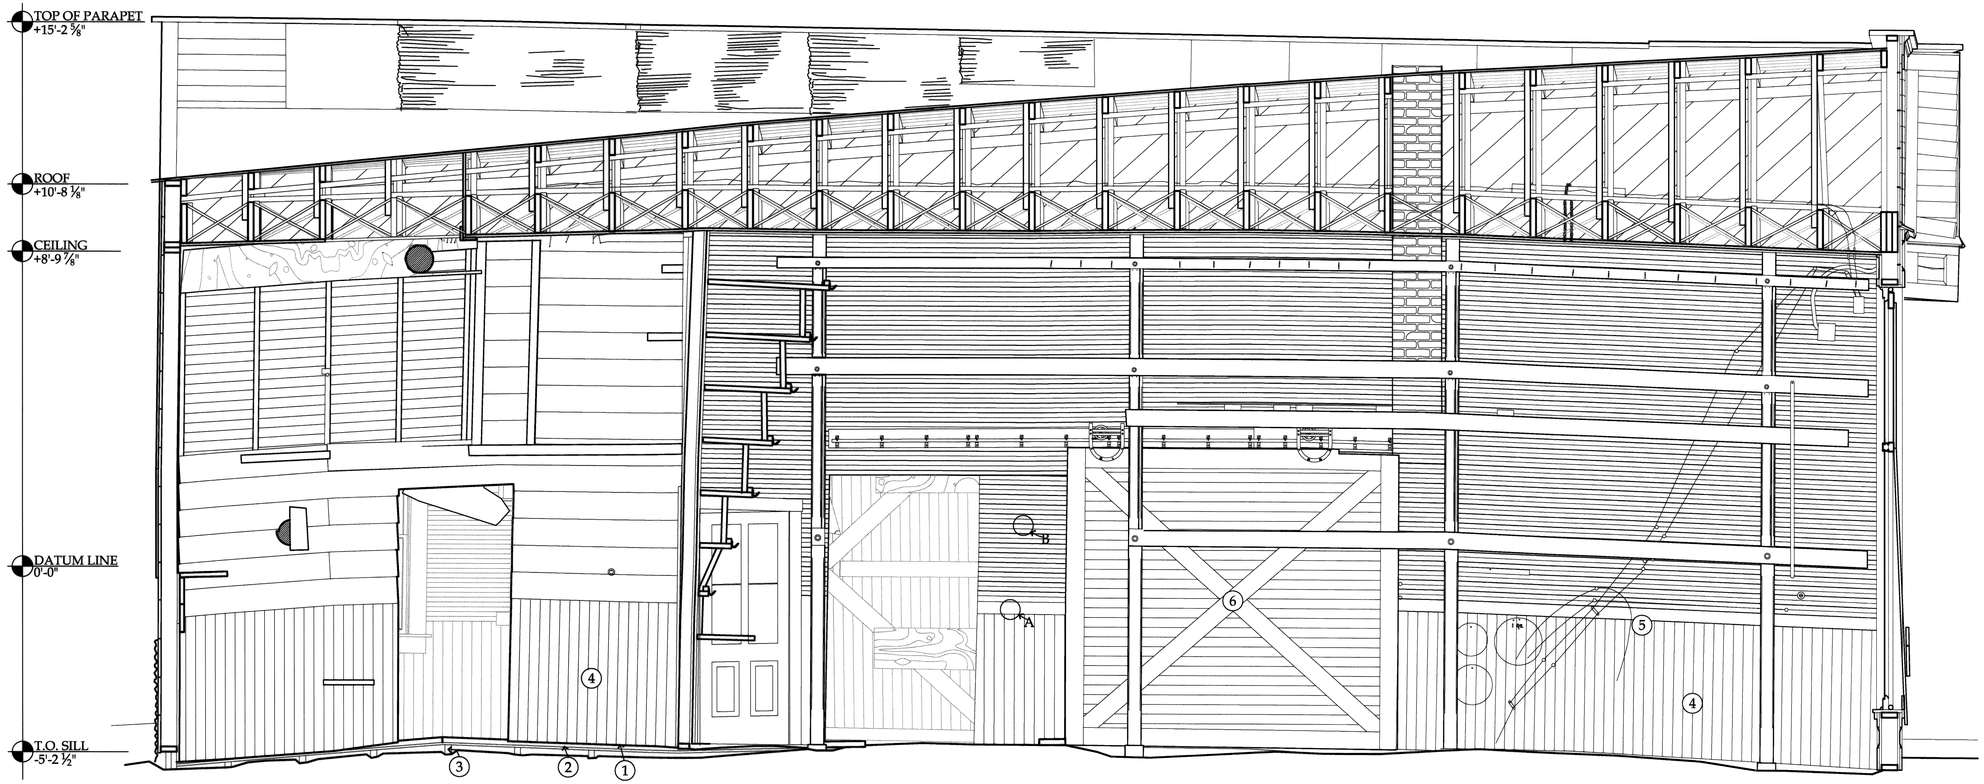

SECTION A-A

SCALE: ½" = 1' - 0"

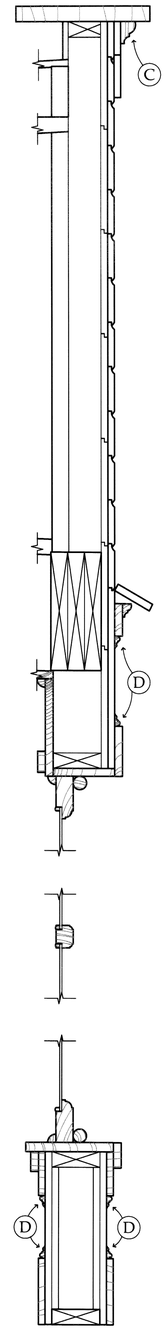

0 1' 2' 4' FEET

0 .25 0.5 1 METERS

MATERIAL NOTES

1. 5 ¼" x ¾" TONGUE & GROOVE FLOORING, DETERIORATED
2. 9" x ¾" SHIPLAP SUBFLOOR, DETERIORATED
3. 1⅞" x 6" FLOOR JOISTS, DETERIORATED
4. 3 ¼" X ¾" TONGUE & GROOVE BEAD BOARD
5. ELECTRICAL WIRES
6. SLIDING GARAGE DOOR ADDED BY GEORGE RAPUZZI CIRCA 1946 OR LATER

A. WAINSCOT TRIM CAP
B. INTERIOR WALL BOARD
C. MOULDINGS ON EXTERIOR AND INTERIOR FACADE
D. MOULDINGS ON EXTERIOR AND INTERIOR FACADE

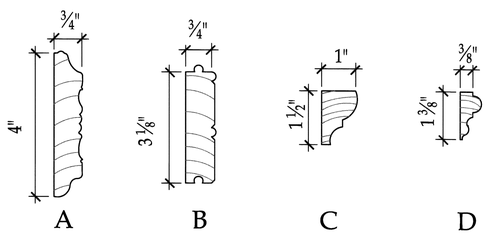

TRIM PROFILES

SCALE: 6" = 1' - 0"

WALL DETAIL

SCALE: 1 ½" = 1' - 0"

DRAWN BY: DANIELLE CAMPBELL AND REBECCA SHAFFER (2010) MICHELLE CHIRCOP (2012)

MEYER BUILDING

KLONDIKE GOLD RUSH NATIONAL HISTORICAL PARK

SKAGWAY ALASKA

SURVEY NO. AK-228

HISTORIC AMERICAN BUILDINGS SURVEY

SHEET 9 OF 27 SHEETS

LIBRARY OF CONGRESS PRINTS & PHOTOGRAPHS

MEYER BUILDING
NATIONAL PARK SERVICE
UNITED STATES DEPARTMENT OF THE INTERIOR

IF REPRODUCED, PLEASE CREDIT THE HISTORIC AMERICAN BUILDINGS SURVEY, NATIONAL PARK SERVICE, NAME OF DELINEATOR, DATE OF DRAWING

SECTION B-B

SCALE: ½" = 1' - 0"

0 1' 2' 4' FEET

0 .25 0.5 1 METERS

MATERIAL NOTES

1. METAL TRAY NAILED OVER WINDOW FROM REVERSE SIDE WITH LABEL "NO. 6 CRYSTALLIZED MADE BY WABASH SCREEN DOOR CO. MINNEAPOLIS MINN. 26 X 32 WABASH TRADE MARK GUARANTEES FIRST QUALITY"
2. HAND PAINTED LETTERING "JULY 18 1901 APRIL APR 27"
3. YMCA GYNMASIUM
4. IRON PIPE PROTRUDING FROM FLOOR

DRAWN BY: DANIELLE CAMPBELL AND REBECCA SHAFFER (2010) MICHELLE CHIRCOP (2012)

MEYER BUILDING

KLONDIKE GOLD RUSH NATIONAL HISTORICAL PARK

SKAGWAY

ALASKA

SURVEY NO. AK-228

HISTORIC AMERICAN BUILDINGS SURVEY
SHEET 10 OF 27 SHEETS

LIBRARY OF CONGRESS PRINTS & PHOTOGRAPHS

MEYER BUILDING
NATIONAL PARK SERVICE
UNITED STATES DEPARTMENT OF THE INTERIOR

IF REPRODUCED, PLEASE CREDIT THE HISTORIC AMERICAN BUILDINGS SURVEY, NATIONAL PARK SERVICE, NAME OF DELINEATOR, DATE OF DRAWING

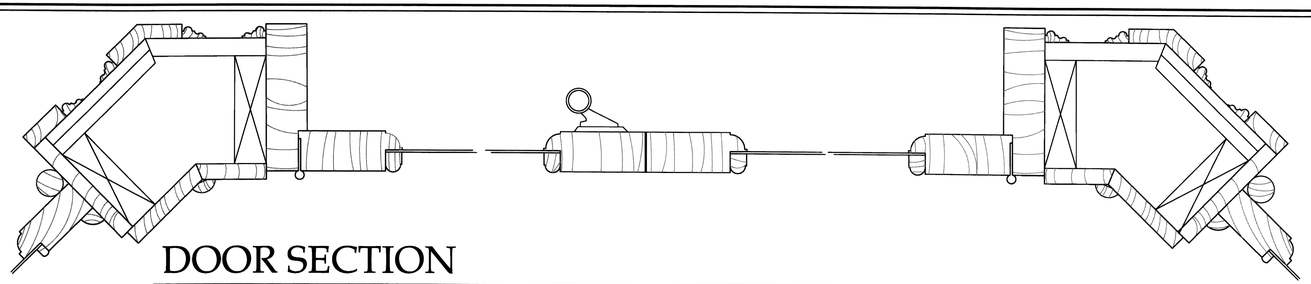

DOOR SECTION

SCALE: 3" = 1' - 0"

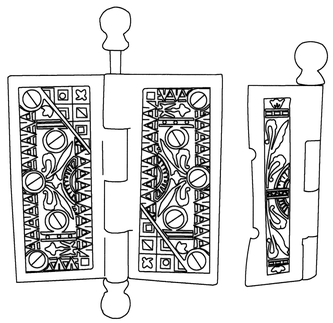

DOOR HARDWARE

SCALE: 6" = 1' - 0"

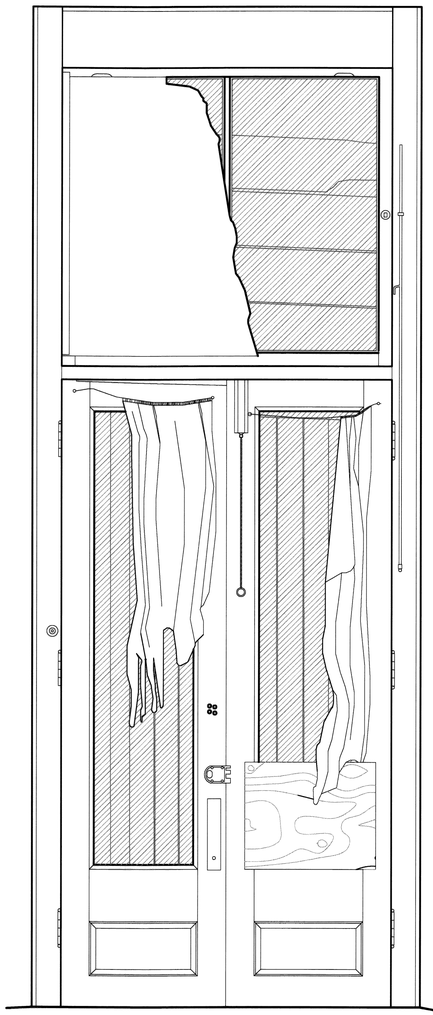

MATERIAL NOTES

(1) CARDBOARD WITH LABEL "MADE BY THE MILWAUKEE CHAIR COMPANY MILWAUKEE WISC"

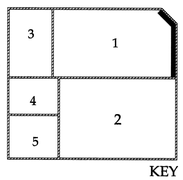

KEY

ROOM ONE EAST INTERIOR ELEVATION

SCALE: 1" = 1' - 0"

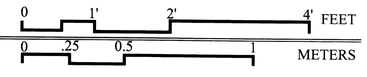

DRAWN BY: DANIELLE CAMPBELL AND REBECCA SHAFFER (2010) MICHELLE CHIRCOP (2012)

MEYER BUILDING

KLONDIKE GOLD RUSH NATIONAL HISTORICAL PARK

SKAGWAY ALASKA

MEYER BUILDING
NATIONAL PARK SERVICE
UNITED STATES DEPARTMENT OF THE INTERIOR

SURVEY NO. AK-228

HISTORIC AMERICAN BUILDINGS SURVEY
SHEET 11 OF 27 SHEETS

LIBRARY OF CONGRESS PRINTS & PHOTOGRAPHS

IF REPRODUCED, PLEASE CREDIT THE HISTORIC AMERICAN BUILDINGS SURVEY, NATIONAL PARK SERVICE, NAME OF DELINEATOR, DATE OF DRAWING

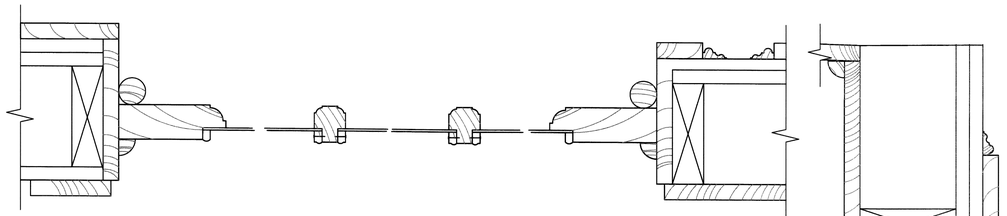

WINDOW SECTION

SCALE: 3" = 1' - 0"

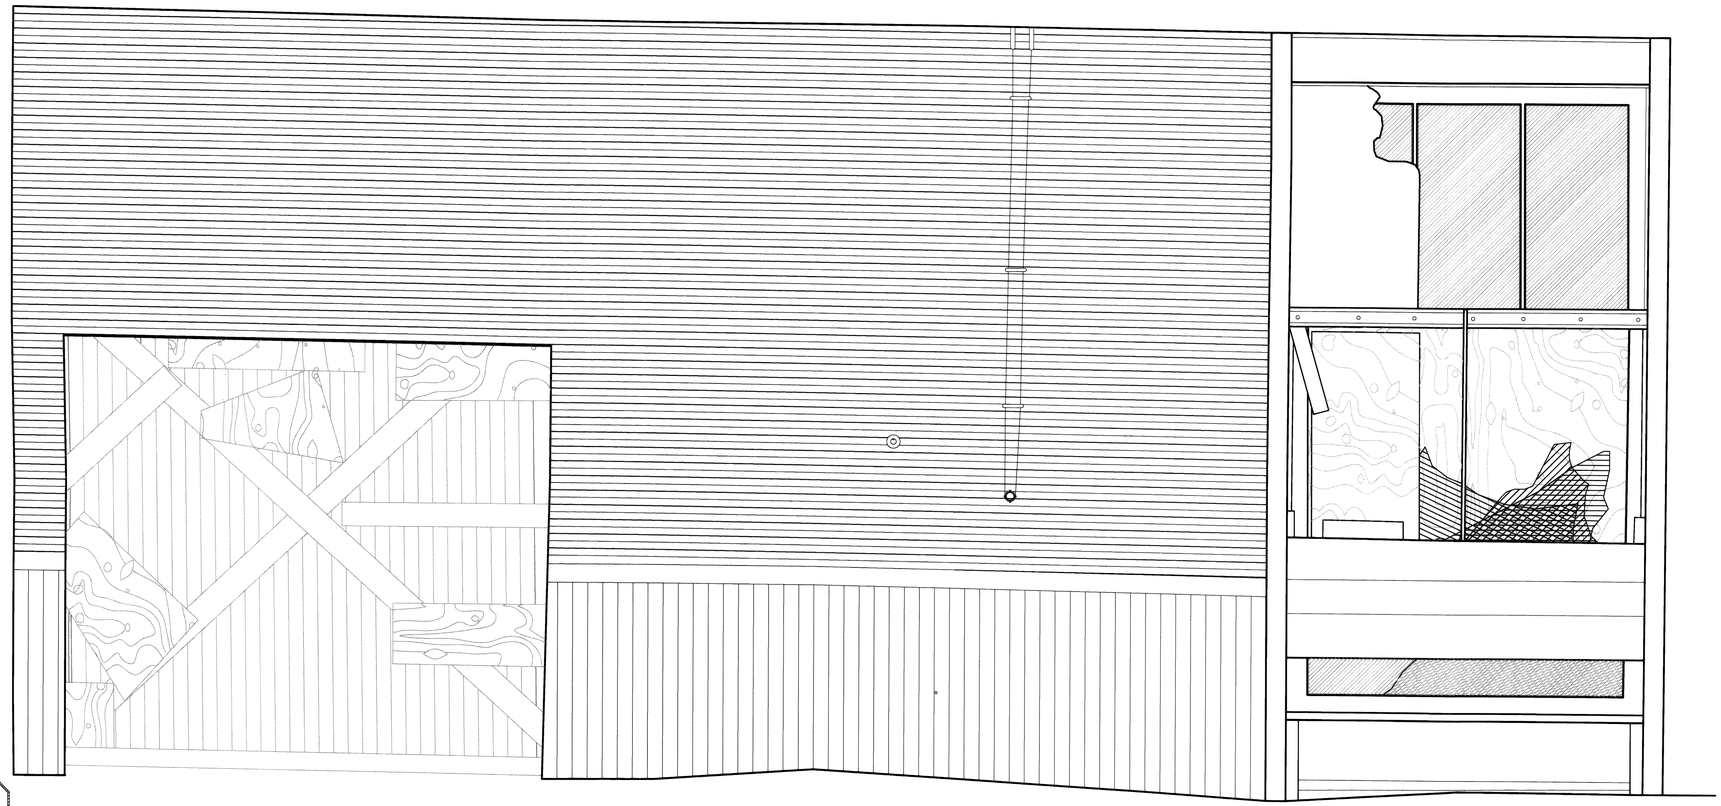

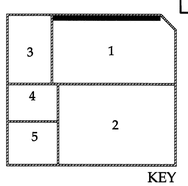

KEY

ROOM ONE NORTH INTERIOR ELEVATION

SCALE: ¾" = 1' - 0"

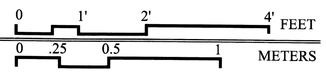

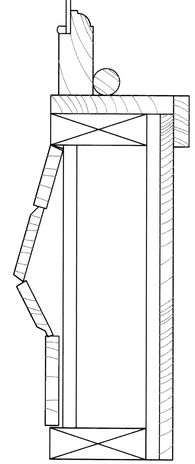

WALL SECTION AT WINDOW

SCALE: 3" = 1' - 0"

DRAWN BY: DANIELLE CAMPBELL AND REBECCA SHAFFER (2010) MICHELLE CHIRCOP (2012)

MEYER BUILDING

KLONDIKE GOLD RUSH NATIONAL HISTORICAL PARK

SKAGWAY ALASKA

MEYER BUILDING
NATIONAL PARK SERVICE
UNITED STATES DEPARTMENT OF THE INTERIOR

SURVEY NO. AK-228

HISTORIC AMERICAN BUILDINGS SURVEY
SHEET 12 OF 27 SHEETS

LIBRARY OF CONGRESS PRINTS & PHOTOGRAPHS

IF REPRODUCED, PLEASE CREDIT THE HISTORIC AMERICAN BUILDINGS SURVEY, NATIONAL PARK SERVICE, NAME OF DELINEATOR, DATE OF DRAWING

KEY

ROOM ONE WEST INTERIOR ELEVATION

SCALE: 1" = 1' - 0"

0 1' 2' 4' FEET

0 .25 0.5 1 METERS

DRAWN BY: DANIELLE CAMPBELL AND REBECCA SHAFFER (2010) MICHELLE CHIRCOP (2012)

MEYER BUILDING
NATIONAL PARK SERVICE
UNITED STATES DEPARTMENT OF THE INTERIOR

MEYER BUILDING

KLONDIKE GOLD RUSH NATIONAL HISTORICAL PARK

SKAGWAY ALASKA

SURVEY NO. AK-228

HISTORIC AMERICAN BUILDINGS SURVEY
SHEET 13 OF 27 SHEETS

LIBRARY OF CONGRESS PRINTS & PHOTOGRAPHS

IF REPRODUCED, PLEASE CREDIT THE HISTORIC AMERICAN BUILDINGS SURVEY, NATIONAL PARK SERVICE, NAME OF DELINEATOR, DATE OF DRAWING

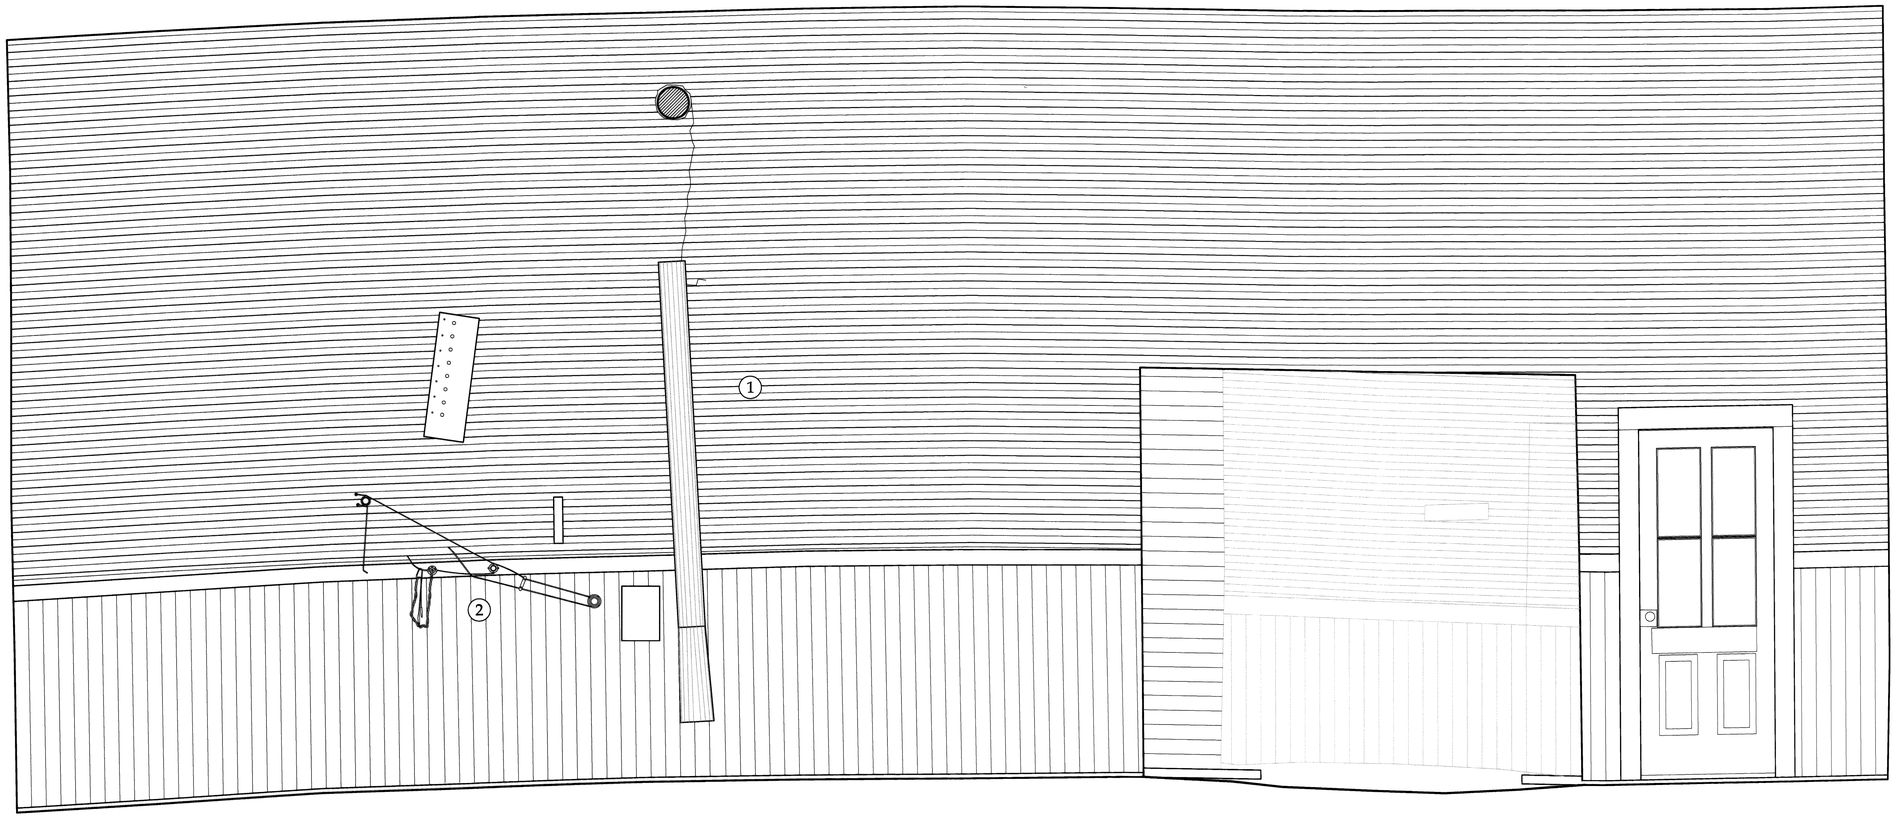

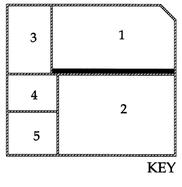

KEY

ROOM ONE SOUTH INTERIOR ELEVATION

SCALE: ¾" = 1' - 0"

0 1' 2' 4' FEET

0 .25 0.5 1 METERS

MATERIAL NOTES

① STOVE PIPE
② CERAMIC LIGHT SOCKETS AND ELECTRICAL WIRING

DRAWN BY: DANIELLE CAMPBELL AND REBECCA SHAFFER (2010) MICHELLE CHIRCOP (2012)

MEYER BUILDING
NATIONAL PARK SERVICE
UNITED STATES DEPARTMENT OF THE INTERIOR

MEYER BUILDING
KLONDIKE GOLD RUSH NATIONAL HISTORICAL PARK
SKAGWAY ALASKA

SURVEY NO. AK-228

HISTORIC AMERICAN BUILDINGS SURVEY
SHEET 14 OF 27 SHEETS

LIBRARY OF CONGRESS PRINTS & PHOTOGRAPHS

IF REPRODUCED, PLEASE CREDIT THE HISTORIC AMERICAN BUILDINGS SURVEY, NATIONAL PARK SERVICE, NAME OF DELINEATOR, DATE OF DRAWING

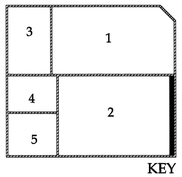

ROOM TWO EAST INTERIOR ELEVATION

SCALE: 1" = 1' - 0"

0 1' 2' 4' FEET

0 .25 0.5 1 METERS

MATERIAL NOTES

① CARDBOARD

② WINDOWS NAILED OVER ORIGINAL WINDOW OPENINGS

DRAWN BY: DANIELLE CAMPBELL AND REBECCA SHAFFER (2010) MICHELLE CHIRCOP (2012)

MEYER BUILDING

KLONDIKE GOLD RUSH NATIONAL HISTORICAL PARK

SKAGWAY ALASKA

MEYER BUILDING
NATIONAL PARK SERVICE
UNITED STATES DEPARTMENT OF THE INTERIOR

SURVEY NO. AK-228

HISTORIC AMERICAN BUILDINGS SURVEY
SHEET 15 OF 27 SHEETS

LIBRARY OF CONGRESS PRINTS & PHOTOGRAPHS DIVISION

IF REPRODUCED, PLEASE CREDIT THE HISTORIC AMERICAN BUILDINGS SURVEY, NATIONAL PARK SERVICE, NAME OF DELINEATOR, DATE OF DRAWING

KEY

ROOM TWO NORTH INTERIOR ELEVATION

SCALE: ¾" = 1' - 0"

DRAWN BY: DANIELLE CAMPBELL AND REBECCA SHAFFER (2010) MICHELLE CHIRCOP (2012)

MEYER BUILDING

KLONDIKE GOLD RUSH NATIONAL HISTORICAL PARK

SKAGWAY

ALASKA

SURVEY NO. AK-228

HISTORIC AMERICAN BUILDINGS SURVEY

SHEET 16 OF 27 SHEETS

LIBRARY OF CONGRESS PRINTS AND PHOTOGRAPHS

MEYER BUILDING
NATIONAL PARK SERVICE
UNITED STATES DEPARTMENT OF THE INTERIOR

IF REPRODUCED, PLEASE CREDIT THE HISTORIC AMERICAN BUILDINGS SURVEY, NATIONAL PARK SERVICE, NAME OF DELINEATOR, DATE OF DRAWING

KEY

ROOM TWO WEST INTERIOR ELEVATION

SCALE: 1" = 1' - 0"

MATERIAL NOTES

① MEAT RACKS

DRAWN BY: DANIELLE CAMPBELL AND REBECCA SHAFFER (2010) MICHELLE CHIRCOP (2012)

MEYER BUILDING

NATIONAL PARK SERVICE
UNITED STATES DEPARTMENT OF THE INTERIOR

MEYER BUILDING

KLONDIKE GOLD RUSH NATIONAL HISTORICAL PARK

SKAGWAY ALASKA

SURVEY NO. AK-228

HISTORIC AMERICAN BUILDINGS SURVEY
SHEET 17 OF 27 SHEETS

LIBRARY OF CONGRESS PRINTS & PHOTOGRAPHS

IF REPRODUCED, PLEASE CREDIT THE HISTORIC AMERICAN BUILDINGS SURVEY, NATIONAL PARK SERVICE, NAME OF DELINEATOR, DATE OF DRAWING

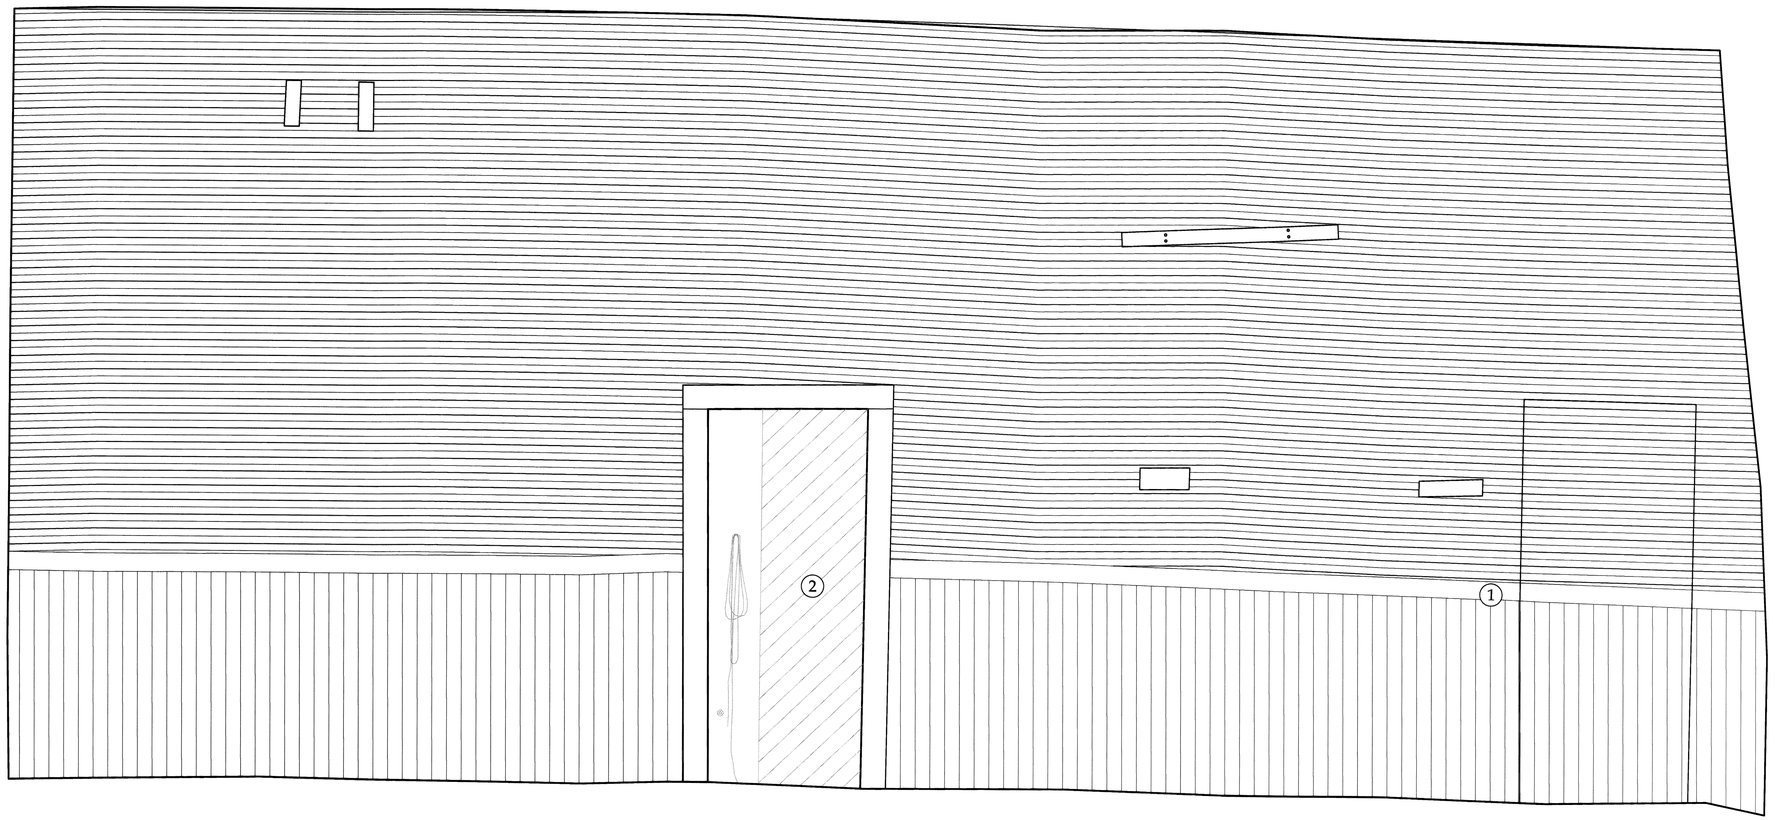

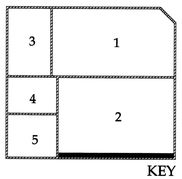

KEY

ROOM TWO SOUTH INTERIOR ELEVATION

SCALE: ¾" = 1' - 0"

0 1' 2' 4' FEET

0 .25 0.5 1 METERS

MATERIAL NOTES

(1) PATCHED DOOR

(2) PASSAGEWAY TO YMCA GYMNASIUM

DRAWN BY: DANIELLE CAMPBELL AND REBECCA SHAFFER (2010) MICHELLE CHIRCOP (2012)

MEYER BUILDING
NATIONAL PARK SERVICE
UNITED STATES DEPARTMENT OF THE INTERIOR

MEYER BUILDING
KLONDIKE GOLD RUSH NATIONAL HISTORICAL PARK
SKAGWAY ALASKA

SURVEY NO. AK-228

HISTORIC AMERICAN BUILDINGS SURVEY
SHEET 18 OF 27 SHEETS

LIBRARY OF CONGRESS PRINTS & PHOTOGRAPHS

IF REPRODUCED, PLEASE CREDIT THE HISTORIC AMERICAN BUILDINGS SURVEY, NATIONAL PARK SERVICE, NAME OF DELINEATOR, DATE OF DRAWING

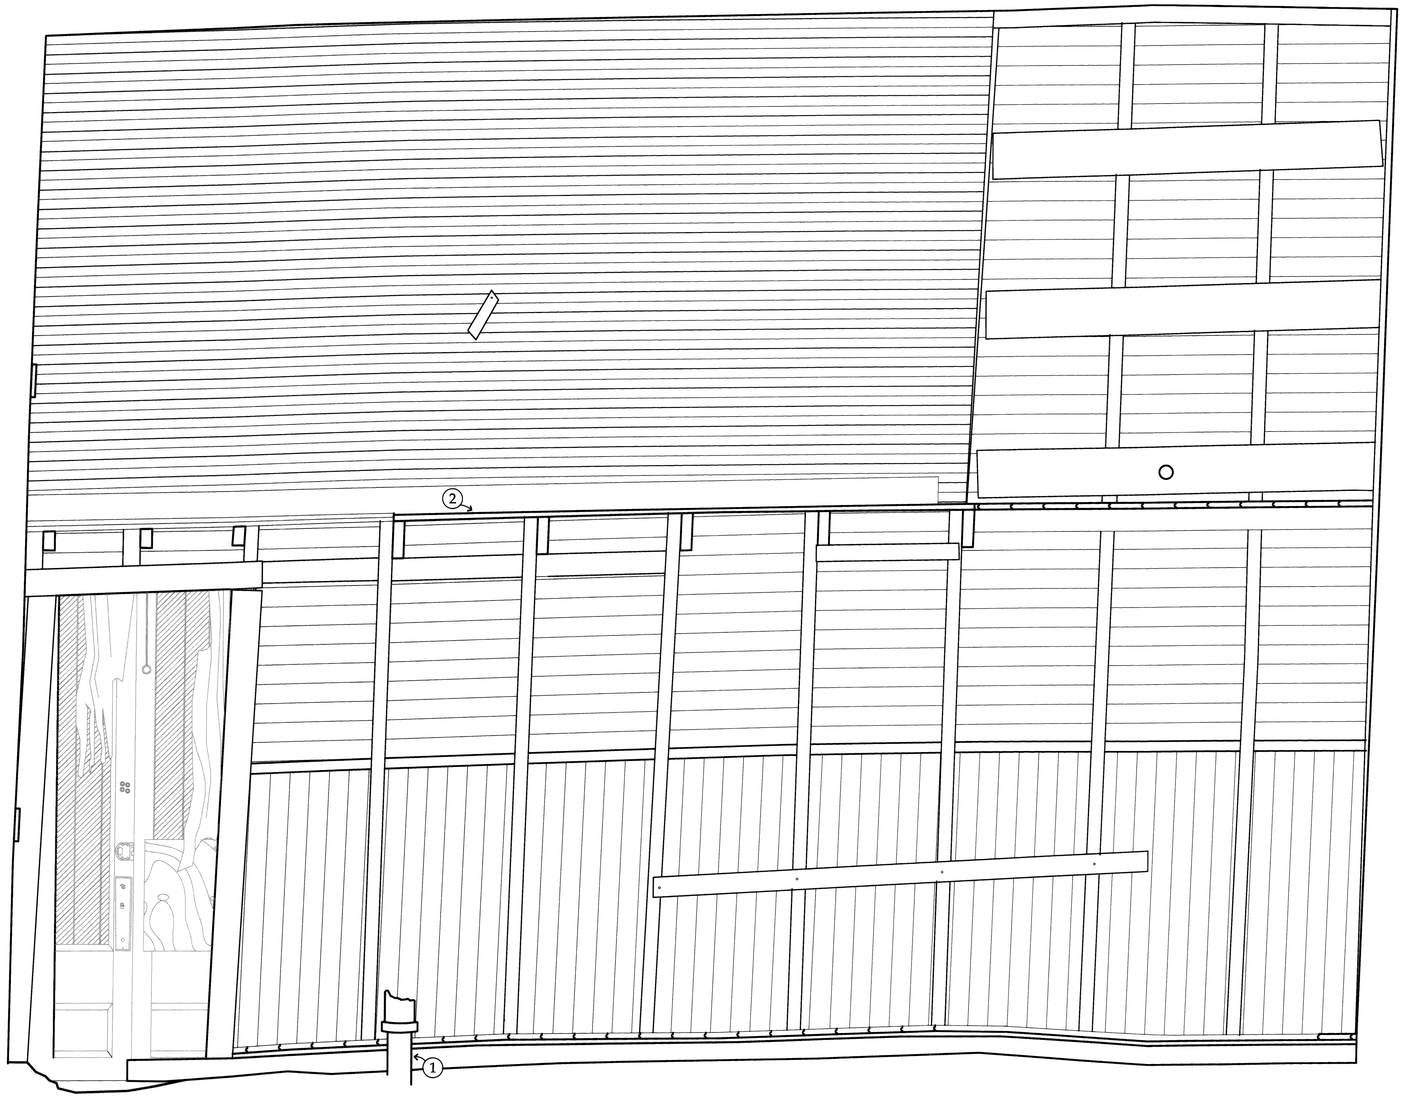

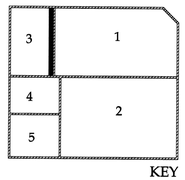

KEY

ROOM THREE EAST INTERIOR ELEVATION

SCALE: 1" = 1' - 0"

0 1' 2' 4' FEET

0 .25 0.5 1 METERS

MATERIAL NOTES

(1) IRON SEWER PIPE PROTRUDING THROUGH FLOOR

(2) REMNANTS OF SECOND FLOOR REMOVED IN 2009 STABILIZATION EFFORT

DRAWN BY: DANIELLE CAMPBELL AND REBECCA SHAFFER (2010) MICHELLE CHIRCOP (2012)

MEYER BUILDING

NATIONAL PARK SERVICE

UNITED STATES DEPARTMENT OF THE INTERIOR

MEYER BUILDING

KLONDIKE GOLD RUSH NATIONAL HISTORICAL PARK

SKAGWAY ALASKA

SURVEY NO. AK-228

HISTORIC AMERICAN BUILDINGS SURVEY

SHEET 19 OF 27 SHEETS

LIBRARY OF CONGRESS PRINTS & PHOTOGRAPHS

IF REPRODUCED, PLEASE CREDIT THE HISTORIC AMERICAN BUILDINGS SURVEY, NATIONAL PARK SERVICE, NAME OF DELINEATOR, DATE OF DRAWING

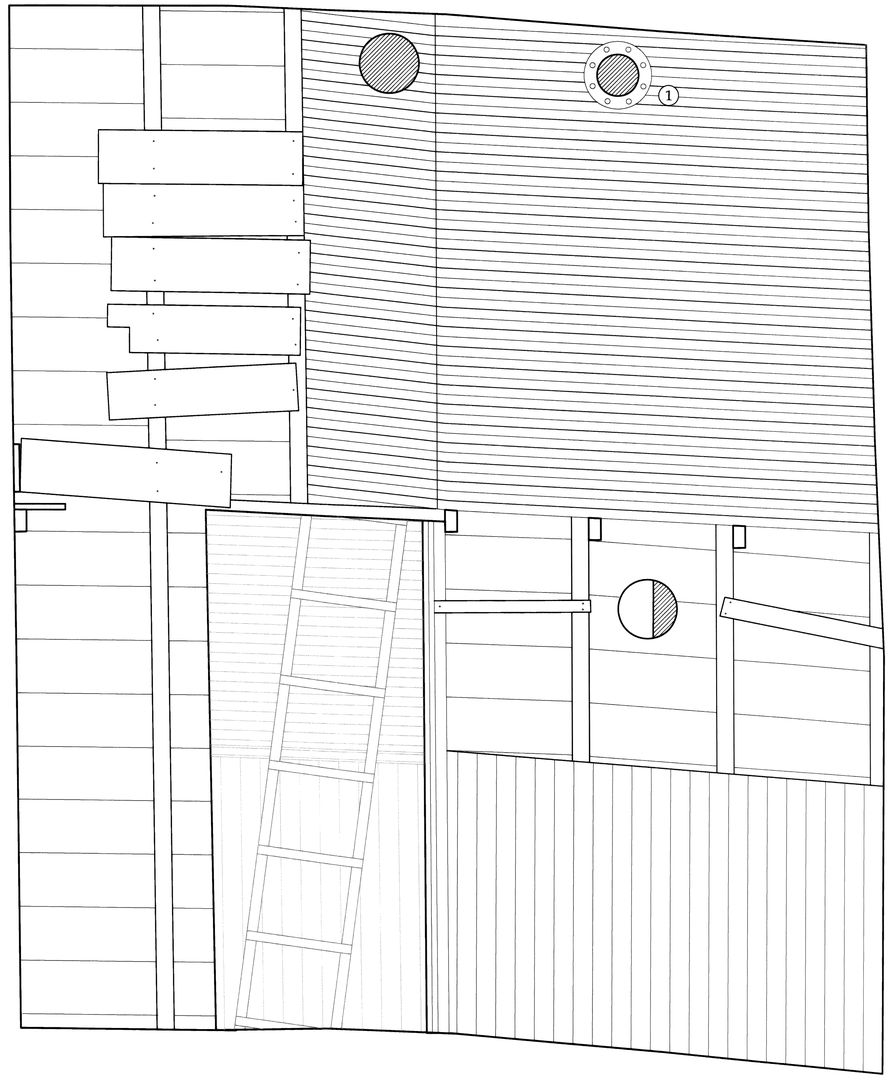

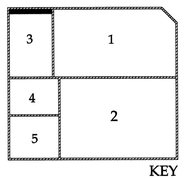

KEY

ROOM THREE NORTH INTERIOR ELEVATION

SCALE: 1" = 1' - 0"

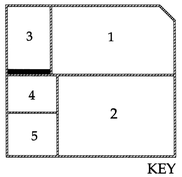

KEY

ROOM THREE SOUTH INTERIOR ELEVATION

SCALE: 1" = 1' - 0"

MATERIAL NOTES

① STOVE PIPE THIMBLE

0 1' 2' 4' FEET

0 .25 0.5 1 METERS

DRAWN BY: DANIELLE CAMPBELL AND REBECCA SHAFFER (2010) MICHELLE CHIRCOP (2012)

MEYER BUILDING
NATIONAL PARK SERVICE
UNITED STATES DEPARTMENT OF THE INTERIOR

MEYER BUILDING

KLONDIKE GOLD RUSH NATIONAL HISTORICAL PARK

SKAGWAY ALASKA

SURVEY NO.	AK-228
HISTORIC AMERICAN BUILDINGS SURVEY	SHEET 20 OF 27 SHEETS
LIBRARY OF CONGRESS PRINTS & PHOTOGRAPHS	

IF REPRODUCED, PLEASE CREDIT THE HISTORIC AMERICAN BUILDINGS SURVEY, NATIONAL PARK SERVICE, NAME OF DELINEATOR, DATE OF DRAWING

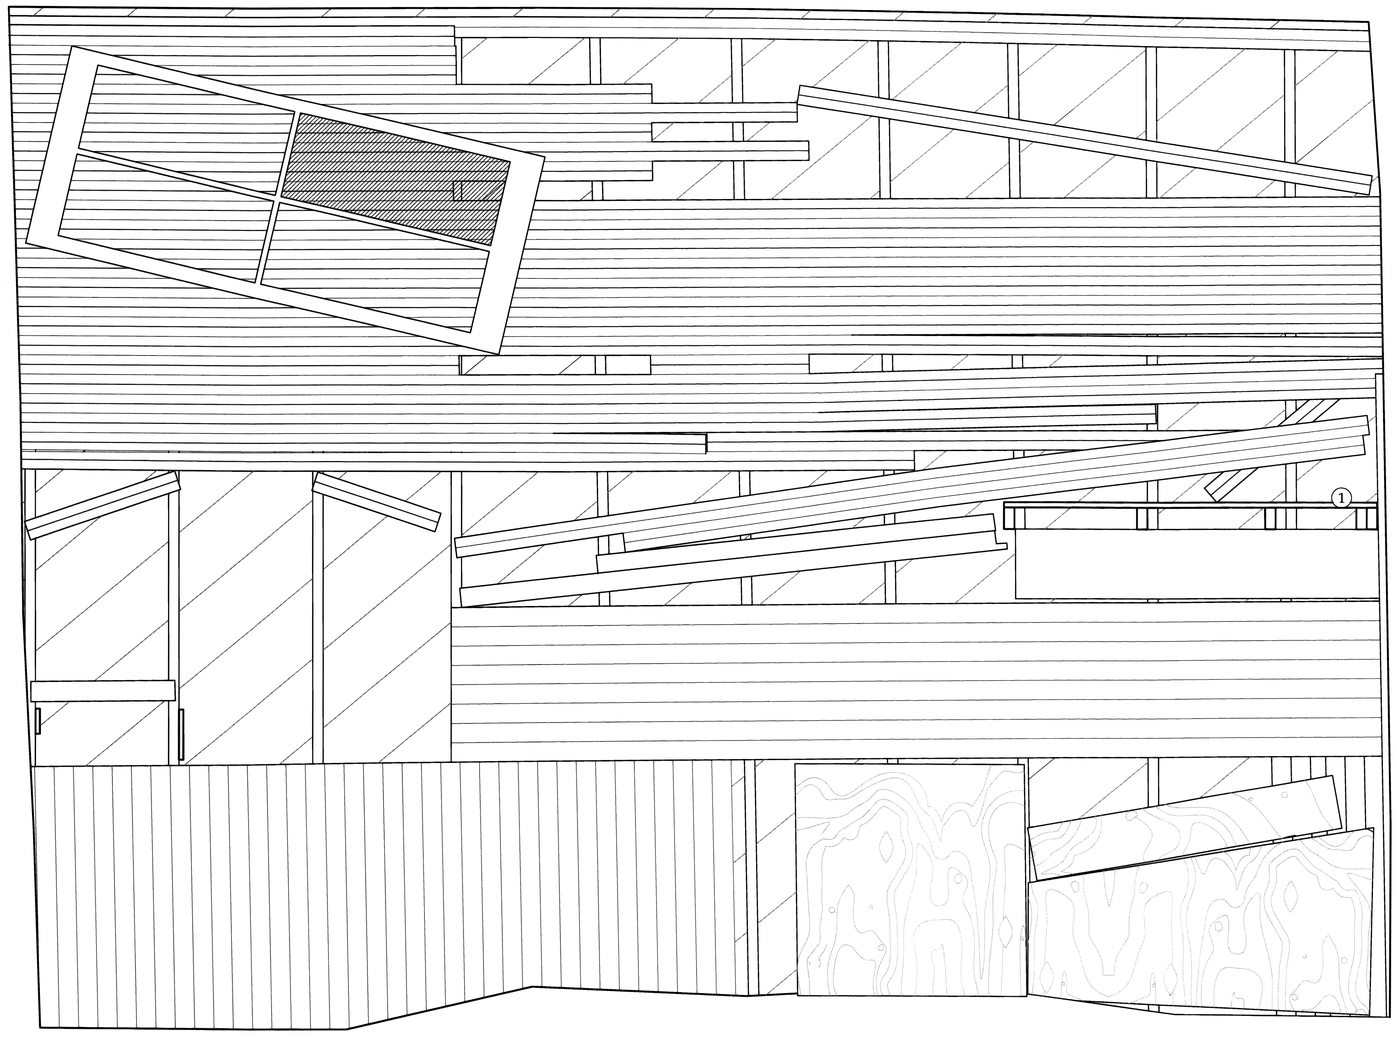

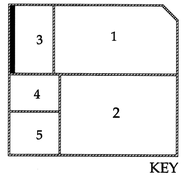

KEY

ROOM THREE WEST INTERIOR ELEVATION

SCALE: 1" = 1' - 0"

0 1' 2' 4' FEET

0 .25 0.5 1 METERS

MATERIAL NOTES

① REMNANTS OF SECOND FLOOR REMOVED IN 2009 STABILIZATION EFFORT

DRAWN BY: DANIELLE CAMPBELL AND REBECCA SHAFFER (2010) MICHELLE CHIRCOP (2012)

MEYER BUILDING
NATIONAL PARK SERVICE
UNITED STATES DEPARTMENT OF THE INTERIOR

MEYER BUILDING
KLONDIKE GOLD RUSH NATIONAL HISTORICAL PARK
SKAGWAY ALASKA

SURVEY NO. AK-228

HISTORIC AMERICAN BUILDINGS SURVEY
SHEET 21 OF 27 SHEETS

LIBRARY OF CONGRESS PRINTS & PHOTOGRAPHS

IF REPRODUCED, PLEASE CREDIT THE HISTORIC AMERICAN BUILDINGS SURVEY, NATIONAL PARK SERVICE, NAME OF DELINEATOR, DATE OF DRAWING

3 1
4 2
5
KEY

ROOM FOUR NORTH INTERIOR ELEVATION

SCALE: 1" = 1' - 0"

3 1
4 2
5
KEY

ROOM FOUR EAST INTERIOR ELEVATION

SCALE: 1" = 1' - 0"

MATERIAL NOTES

1. HAND PAINTED LETTERING "JULY 18 1901 APRIL APR 27"
2. PORCELAIN WIRE INSULATORS

0 1' 2' 4' FEET
0 .25 0.5 1 METERS

DRAWN BY: DANIELLE CAMPBELL AND REBECCA SHAFFER (2010) MICHELLE CHIRCOP (2012)

MEYER BUILDING
KLONDIKE GOLD RUSH NATIONAL HISTORICAL PARK

MEYER BUILDING
NATIONAL PARK SERVICE
UNITED STATES DEPARTMENT OF THE INTERIOR

SKAGWAY
ALASKA

SURVEY NO. AK-228

HISTORIC AMERICAN BUILDINGS SURVEY
SHEET 22 OF 27 SHEETS

LIBRARY OF CONGRESS PRINTS & PHOTOGRAPHS

IF REPRODUCED, PLEASE CREDIT THE HISTORIC AMERICAN BUILDINGS SURVEY, NATIONAL PARK SERVICE, NAME OF DELINEATOR, DATE OF DRAWING

KEY

ROOM FOUR SOUTH INTERIOR ELEVATION

SCALE: 1" = 1' - 0"

KEY

ROOM FOUR WEST INTERIOR ELEVATION

SCALE: 1" = 1' - 0"

DRAWN BY: DANIELLE CAMPBELL AND REBECCA SHAFFER (2010) MICHELLE CHIRCOP (2012)

MEYER BUILDING

KLONDIKE GOLD RUSH NATIONAL HISTORICAL PARK

SKAGWAY ALASKA

MEYER BUILDING
NATIONAL PARK SERVICE
UNITED STATES DEPARTMENT OF THE INTERIOR

SURVEY NO. AK-228

HISTORIC AMERICAN BUILDINGS SURVEY
SHEET 23 OF 27 SHEETS

LIBRARY OF CONGRESS PRINTS & PHOTOGRAPHS

IF REPRODUCED, PLEASE CREDIT THE HISTORIC AMERICAN BUILDINGS SURVEY, NATIONAL PARK SERVICE, NAME OF DELINEATOR, DATE OF DRAWING

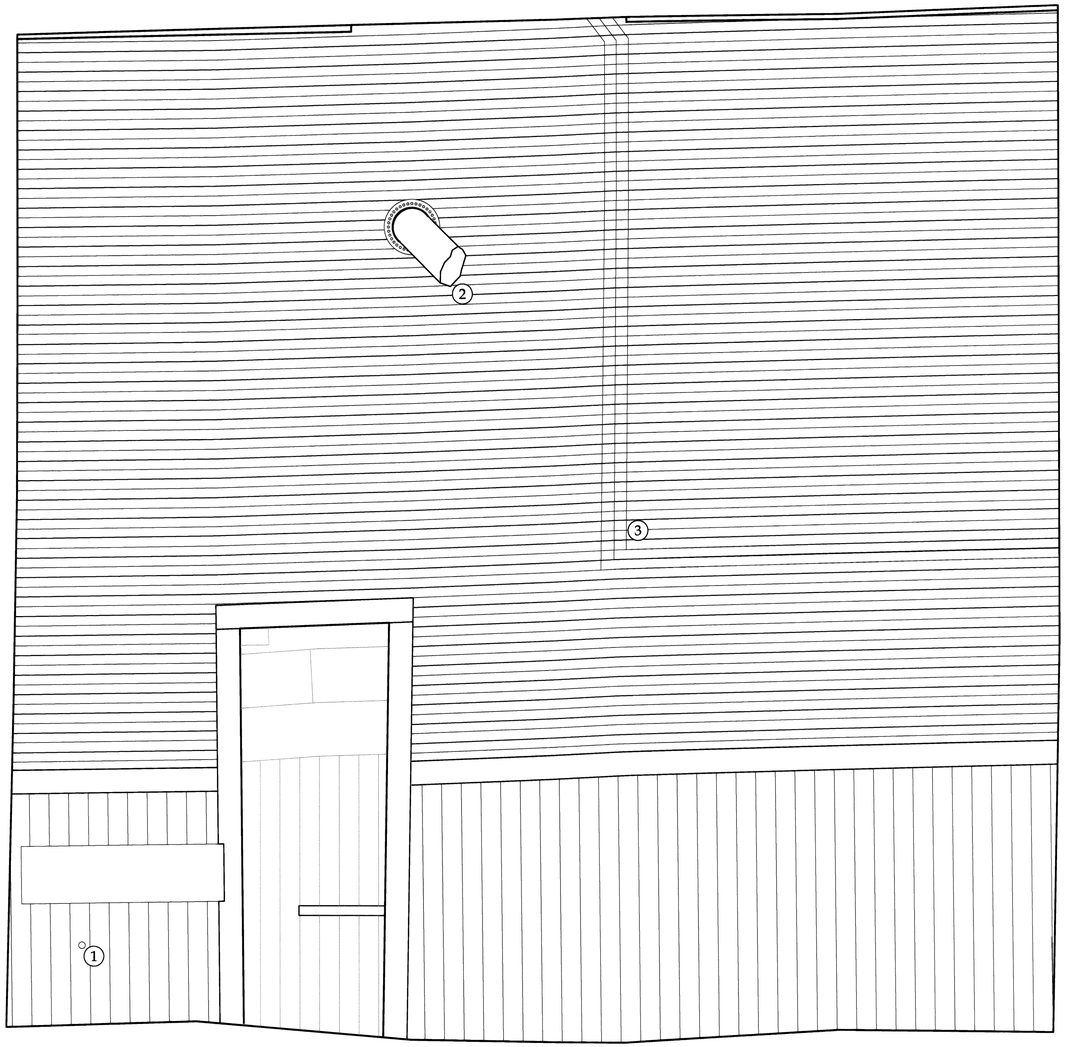

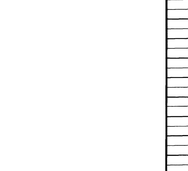

ROOM FIVE NORTH INTERIOR ELEVATION

SCALE: 1" = 1' - 0"

MATERIAL NOTES

1. BURST LEAD WATER PIPE
2. STOVE PIPE
3. ELECTRICAL WIRES

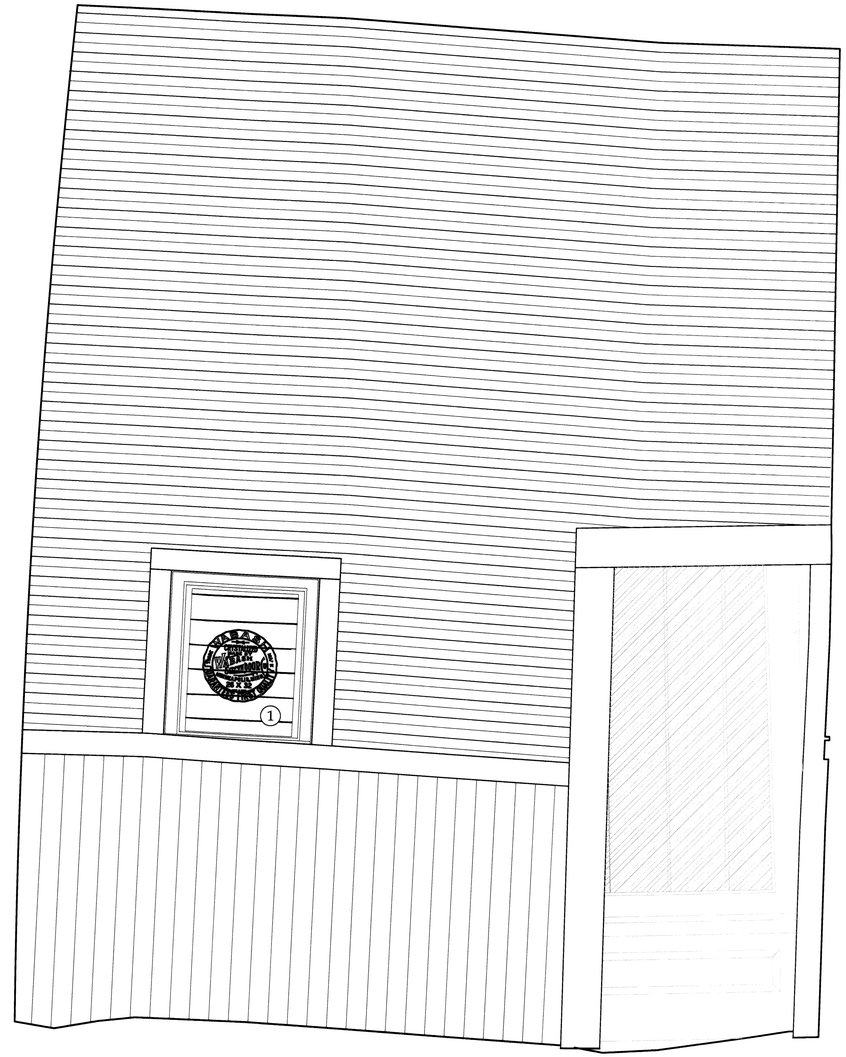

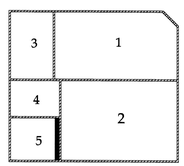

ROOM FIVE EAST INTERIOR ELEVATION

SCALE: 1" = 1' - 0"

MATERIAL NOTES

1. METAL TRAY NAILED OVER WINDOW FROM REVERSE SIDE WITH LABEL "NO. 6 CRYSTALLIZED MADE BY WABASH SCREEN DOOR CO. MINNEAPOLIS MINN. 26 X 32 WABASH TRADE MARK GUARANTEES FIRST QUALITY"

0 1' 2' 4' FEET

0 .25 0.5 1 METERS

DRAWN BY: DANIELLE CAMPBELL AND REBECCA SHAFFER (2010) MICHELLE CHIRCOP (2012)

MEYER BUILDING
NATIONAL PARK SERVICE
UNITED STATES DEPARTMENT OF THE INTERIOR

MEYER BUILDING
KLONDIKE GOLD RUSH NATIONAL HISTORICAL PARK
SKAGWAY ALASKA

STUDY NO. AK-22B

HISTORIC AMERICAN BUILDINGS SURVEY
SHEET 24 OF 27 SHEETS

LIBRARY OF CONGRESS PRINTS & PHOTOGRAPHS

IF REPRODUCED, PLEASE CREDIT THE HISTORIC AMERICAN BUILDINGS SURVEY, NATIONAL PARK SERVICE, NAME OF DELINEATOR, DATE OF DRAWING

KEY

ROOM FIVE SOUTH INTERIOR ELEVATION

SCALE: 1" = 1' - 0"

KEY

ROOM FIVE WEST INTERIOR ELEVATION

SCALE: 1" = 1' - 0"

MATERIAL NOTES

① PLYWOOD FROM 2009 STABILIZATION EFFORT

DRAWN BY: DANIELLE CAMPBELL AND REBECCA SHAFFER (2010) MICHELLE CHIRCOP (2012)

MEYER BUILDING

KLONDIKE GOLD RUSH NATIONAL HISTORICAL PARK

SKAGWAY ALASKA

MEYER BUILDING
NATIONAL PARK SERVICE
UNITED STATES DEPARTMENT OF THE INTERIOR

SURVEY NO. AK-228

HISTORIC AMERICAN BUILDINGS SURVEY
SHEET 25 OF 27 SHEETS

IF REPRODUCED, PLEASE CREDIT THE HISTORIC AMERICAN BUILDINGS SURVEY, NATIONAL PARK SERVICE, NAME OF DELINEATOR, DATE OF DRAWING

DOOR ONE

DOOR TWO

DOOR THREE

DOOR FOUR

DOOR FIVE

DOOR SIX

DOOR ELEVATIONS

SCALE: 1" = 1' - 0"

DRAWN BY: DANIELLE CAMPBELL AND REBECCA SHAFFER (2010) MICHELLE CHIRCOP (2012)

MEYER BUILDING
NATIONAL PARK SERVICE
UNITED STATES DEPARTMENT OF THE INTERIOR

MEYER BUILDING

KLONDIKE GOLD RUSH NATIONAL HISTORICAL PARK
SKAGWAY ALASKA

SURVEY NO.
AK-228

HISTORIC AMERICAN BUILDINGS SURVEY
SHEET 26 OF 27 SHEETS

LIBRARY OF CONGRESS PRINTS & PHOTOGRAPHS

IF REPRODUCED, PLEASE CREDIT THE HISTORIC AMERICAN BUILDINGS SURVEY, NAME OF DELINEATOR, DATE OF DRAWING

ARCTIC MEAT CO.

THE ARCTIC MEAT COMPANY WAS LOCATED IN THE SOUTHEAST ROOM OF THE MEYER BUILDING FROM 1899 TO 1910. THE MEAT MARKET BUILDING'S HIGH PROFILE LOCATION AT THE CORNER OF FIFTH AVENUE AND STATE STREET PUT THE BUSINESS AT THE HEART OF THE HUSTLE AND BUSTLE OF THE CITY AT THE PEAK OF THE GOLD RUSH. HERMAN MEYER SOLD HIS MEAT BUSINESS IN 1902 TO THE CARSTEN BROTHERS PACKING COMPANY OF SEATTLE WA, WHO CONTINUED TO OPERATE THE ARCTIC MEAT COMPANY UNTIL 1910. FOR PRESERVATION AND STORAGE, THE ORIGINAL MEAT RACKS ON THE NORTH, SOUTH AND WEST WALLS OF ROOM TWO WERE REMOVED TEMPORARILY AND STORED BY THE KLONDIKE GOLD RUSH NATIONAL HISTORICAL PARK (KLGO) STAFF IN JULY 2009, DURING STABILIZATION EFFORTS.

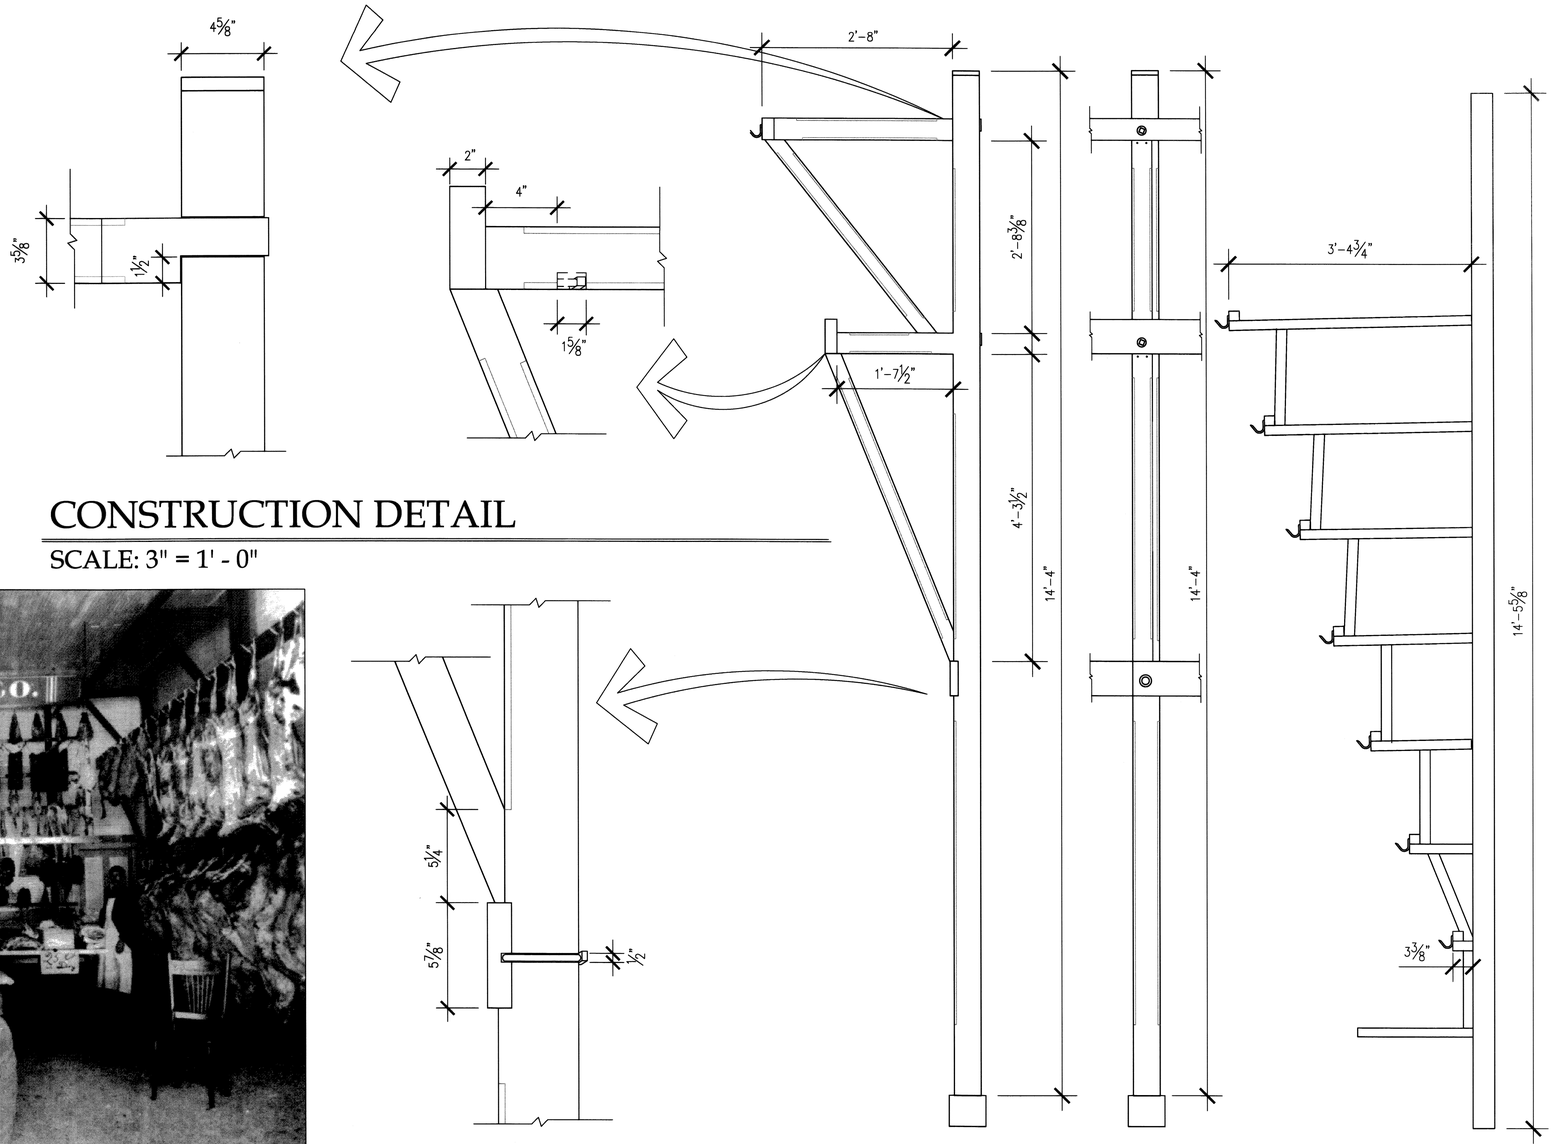

CONSTRUCTION DETAIL

SCALE: 3" = 1' - 0"

PHOTO COURTESY OF STAN B. COHEN. QUEEN CITY OF THE NORTH: DAWSON CITY, YUKON A PICTORIAL HISTORY. PICTORIAL HISTORIES PUBLISHING COMPANY INCORPORATED, 1996.

CONSTRUCTION DETAIL

SCALE: 3" = 1' - 0"

RACK ONE RACK TWO RACK THREE

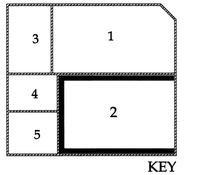

KEY

MEAT RACKS

SCALE: 1" = 1' - 0"

0 1' 2' 4' FEET

0 .25 0.5 1 METERS

NOTES

1. NORTH-SOUTH SECTION, SHOWN IN PHOTO TO HOLD PIGS AND BEEF
2. NORTH ELEVATION, SHOWN IN PHOTO TO HOLD PIGS, BEEF AND HALIBUT
3. EAST-WEST SECTION, SHOWN IN PHOTO TO HOLD CHICKENS, GOOSE AND HAMS
4. ORIGINAL ARCTIC MEAT CO. SIGH HAS BEEN ACCESSIONED INTO THE KLONDIKE GOLD RUSH NATIONAL HISTORICAL PARK MUSEUM COLLECTION AND CATALOGED AS KLGO 58282

DRAWN BY: DANIELLE CAMPBELL AND REBECCA SHAFFER (2010) MICHELLE CHIRCOP (2012)

MEYER BUILDING

KLONDIKE GOLD RUSH NATIONAL HISTORICAL PARK

SKAGWAY ALASKA

SURVEY NO. AK-228

HISTORIC AMERICAN BUILDINGS SURVEY SHEET 27 OF 27 SHEETS

LIBRARY OF CONGRESS PRINTS & PHOTOGRAPHS DIVISION

IF REPRODUCED, PLEASE CREDIT THE HISTORIC AMERICAN BUILDINGS SURVEY, NATIONAL PARK SERVICE, NAME OF DELINEATOR, DATE OF DRAWING

HISTORIC AMERICAN BUILDINGS SURVEY

INDEX TO PHOTOGRAPHS

MEYER MEAT MARKET BUILDING HABS AK-228
Klondike Gold Rush National Historical Park
Skagway Historic District and White Pass
495 State Street
Skagway
Skagway-Hoonah-Angoon Census Area
Alaska

INDEX TO BLACK AND WHITE PHOTOGRAPHS

Robert Lyon, photographer, October 2009

AK-228-1	Exterior east and north elevations, double door at northeast corner
AK-228-2	Exterior north and west elevations, view towards southeast
AK-228-3	Exterior east elevation, view towards northwest

Ron Klein, photographer, May 2010

AK-228-4	Room One west elevation, view towards northwest
AK-228-5	Room One east elevation, view towards southeast
AK-228-6	Room One northwest corner, view towards north
AK-228-7	Room One sliding door north elevation, view towards east
AK-228-8	Room One floor, showing artifacts on the floor, view towards north
AK-228-9	Room One double doors at northeast corner, view towards northeast
AK-228-10	Room Two west elevation, meat racks, view towards northwest
AK-228-11	Room Two west and north elevations, doors to Rooms Four and One, view towards north
AK-228-12	Room Two door detail at west end of north elevation, view towards northeast

AK-228-13	Room Two west and north elevations, ceiling and meat racks, view towards north
AK-228-14	Room Two west and south elevations, meat racks, door to Room Four, sliding door to Room One, view towards north
AK-228-15	Room Two sliding door hardware at west end of south elevation, view towards northeast
AK-228-16	Room Two east elevation, double doors, view towards southeast
AK-228-17	Room Four east elevation, graffiti, view towards southeast

HISTORIC AMERICAN BUILDINGS SURVEY

INDEX TO PHOTOGRAPHS

ADDENDUM TO: HABS AK-228
MEYER MEAT MARKET BUILDING
Klondike Gold Rush National Historical Park
Skagway and White Pass Historic District
495 State Street (southwest corner at 5th Avenue)
Skagway
Municipality of Skagway Borough
Alaska

Photographs no. HABS AK-228-1 through HABS AK-228-17 were previously transmitted to the Library of Congress.

Note: Within Skagway, cardinal directions are colloquially oriented with reference to the city's street grid instead of true north. The north-south axis is aligned with State Street, making "north" closer to northeast. The photo captions follow this convention.

Captions written by Susannah Dowds, Historian, Klondike Gold Rush National Historical Park, 2018.

INDEX TO BLACK AND WHITE PHOTOGRAPHS

Robert Lyon, photographer, September 2015

AK-228-18	North and east facades of Meyer Meat Market Building. The building was constructed in 1899. The front entrance is an angled corner entry at the intersection of 5th Avenue and State Street marked by a five-sided, cantilevered corner cap over the entrance. The north facade is covered in horizontal tongue-and-groove drop sliding. The storefront windows that front State Street wrap around the northeast corner of the building. Centered on the north facade is a garage door, added by George Rapuzzi ca. 1946. At the west end of the north facade is a door and three one-over-one, double-hung windows covered by plywood and horizontal boards. The east facade is covered by plywood, showing building stabilization efforts undertaken by the National Park Service starting in 2008. As of 2017, the building is vacant and undergoing restoration.
AK-228-19	North facade of Meyer Meat Market Building.

Location Map

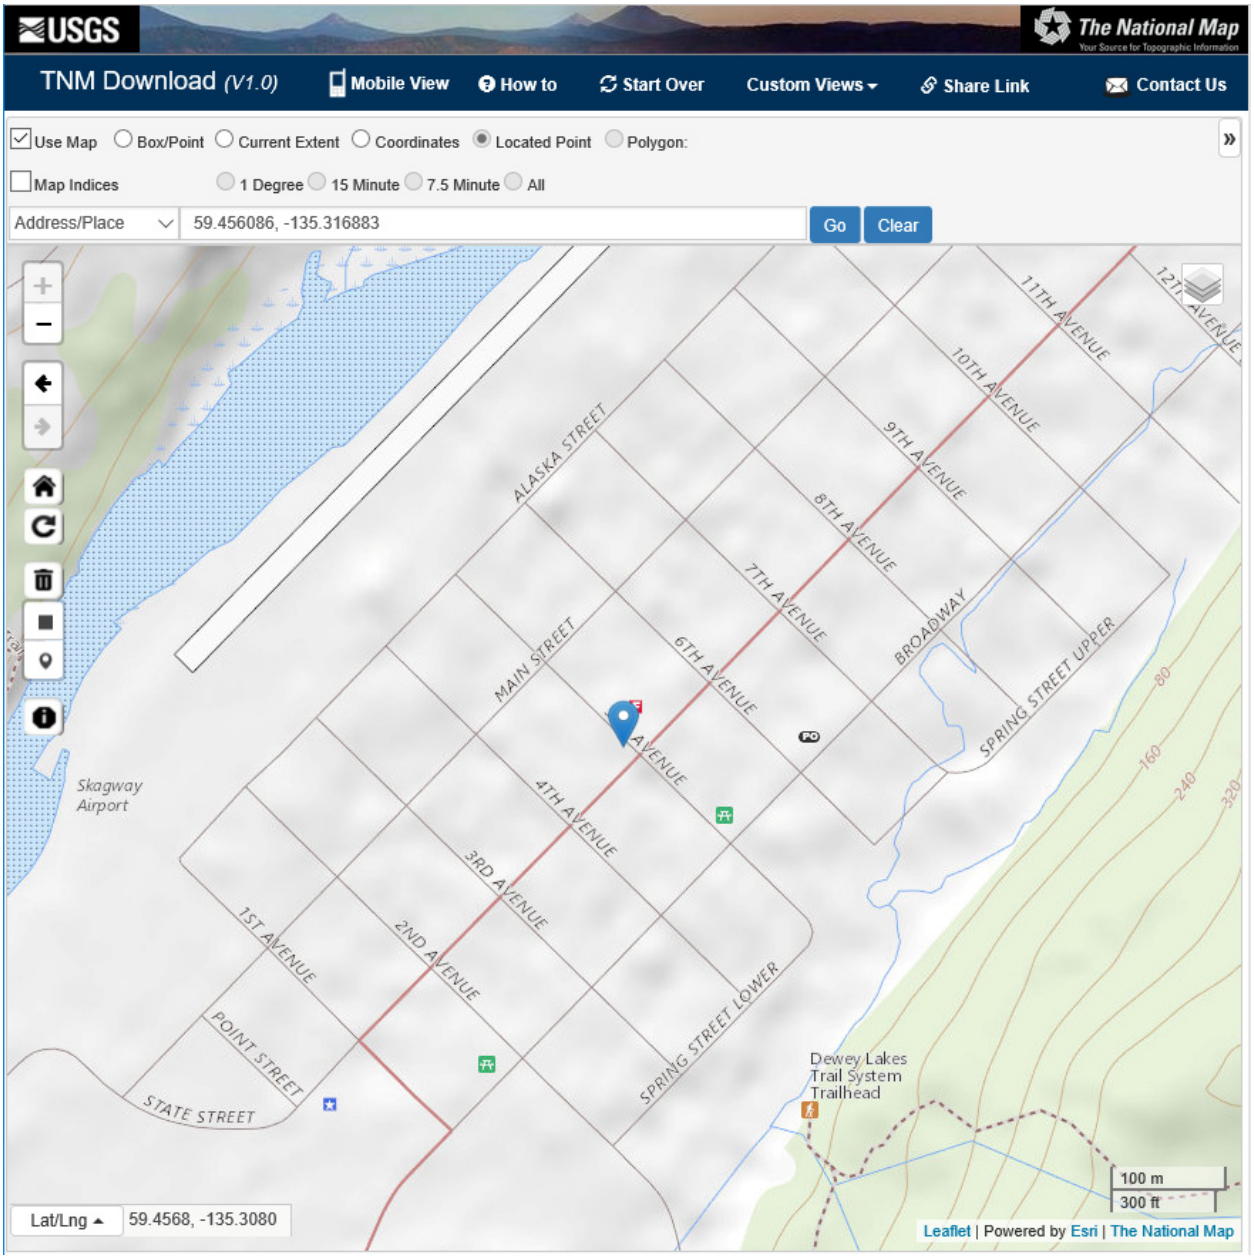

The Meyer Meat Market Building is located at longitude: 59.456086, latitude: -135.316883. This point represents the front door. It was obtained by Jen Larsen, Biological Wildlife Technician & GIS Specialist, Klondike Gold Rush National Historical Park, in August 2019 working with historical building spatial layers within ArcMap (NAD83).

Map source: The National Map, U.S. Geological Survey, accessed August 23, 2019, https://viewer.nationalmap.gov/basic/.

HABS AK-228 -1
Kodak 400TMY-2

STOP
NO PARKING

HABS AK-228-3

HABS AK-228-4
Kodak 400TMY-2

HABS AK-228-5
Kodak 400TMY-2

HABS AK-228-6

Kodak 400TMY-2

Kodak 400TMY-2

HABS AK-228-7

HABS AK-228-8

HABS
Kodak 400TMY-2
AR-228-9

HABS
Kodak 400TMY-2
AK-228-10

HABS AK-228-C 11
Kodak 400TMY-2

HABS AK-228-B 12

Kodak 400TMY-2

HABS AK-228-B 13 Kodak 400TMY-2

HABS AK-228-C 14
Kodak 400TMY-2

Kodak 400TMY-2

HABS AK-228-B 15

HABS AK-228-G.16
Kodak 400TMY-2

HAB S AK-227-17
Kodak 400TMY-2
Tuesday 18 1901
APRIL