YMCA GYMNASIUM
(Young Men's Christian Association Building)
Klondike Gold Rush National Historical Park
~~Skagway Historic District and White Pass~~
475 State Street
Skagway
Skagway-Hoonah-Angoon Census Area
Alaska

HABS AK-229
HABS AK-229


PHOTOGRAPHS

REDUCED COPIES OF MEASURED DRAWINGS

FIELD RECORDS

HISTORIC AMERICAN BUILDINGS SURVEY
ALASKA SUPPORT OFFICE
National Park Service
U.S. Department of the Interior
240 West 5th Avenue, Room 114
Anchorage, AK 99501

YOUNG MEN'S CHRISTIAN ASSOCIATION GYMNASIUM

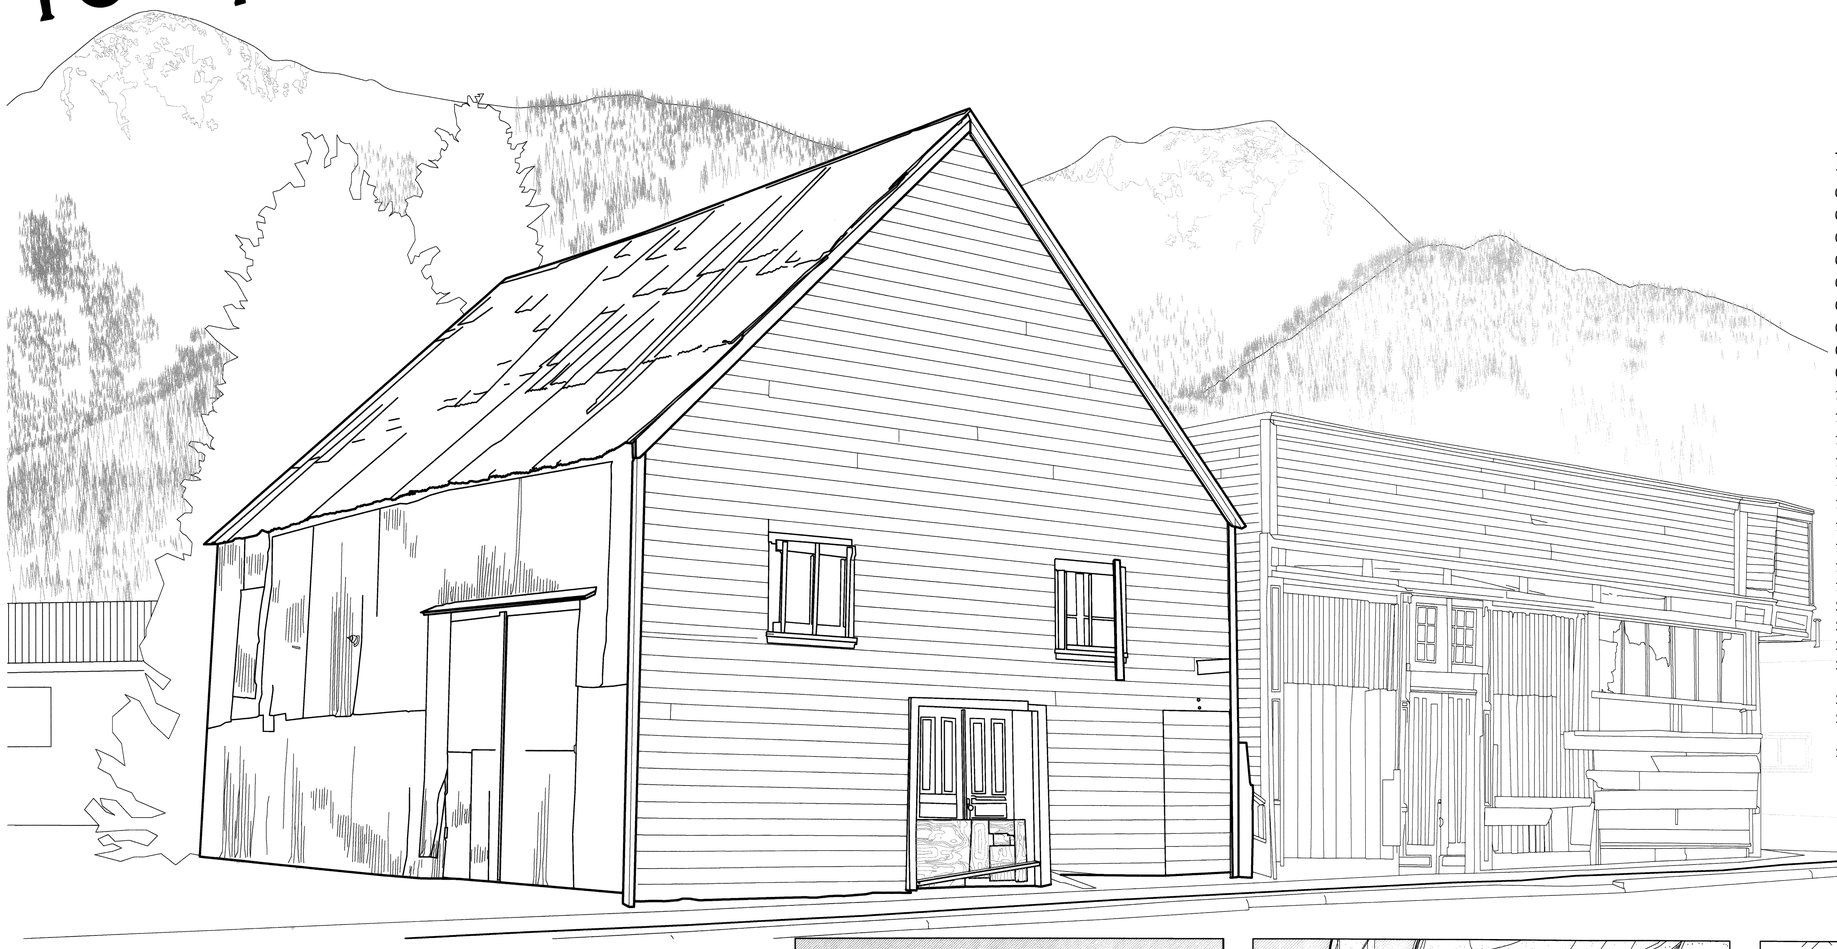

Drawing Index


01. COVER SHEET
02. SITE PLAN
03. FLOOR PLAN
04. ROOM FIVE ICE RACK AND REFLECTED CEILING PLAN
05. LOFT PLAN
06. FLOOR FRAMING PLAN
07. GYMNASIUM FLOOR PLAN
08. REFLECTED CEILING PLAN
09. ROOF PLAN
10. EAST ELEVATION
11. NORTH ELEVATION
12. WEST ELEVATION
13. SOUTH ELEVATION
14. SECTION A-A
15. SECTION B-B
16. EAST INTERIOR ELEVATION
17. NORTH INTERIOR ELEVATION
18. WEST INTERIOR ELEVATION
19. SOUTH INTERIOR ELEVATION
20. COLD STORAGE ELEVATION
21. ROOM TWO NORTH & EAST INTERIOR ELEVATIONS
22. ROOM TWO SOUTH & WEST INTERIOR ELEVATIONS
23. ROOMS THREE, FOUR & FIVE NORTH & SOUTH INTERIOR ELEVATIONS
24. ROOM THREE EAST &WEST INTERIOR ELEVATIONS
25. ROOMS FOUR & FIVE EAST & WEST INTERIOR ELEVATIONS
26. COLD STORAGE DOOR DETAILS

SIGNIFICANCE


THE YMCA GYMNASIUM IN SKAGWAY, ALASKA, WAS FOUNDED IN 1898 BY MICHIGAN NATIVE, WILLIAM REID, WHO WAS HEADED TO DAWSON, YUKON TERRITORY, TO START A BRANCH THERE. DIFFICULTIES ON THE CHILKOOT TRAIL KEPT REID IN SKAGWAY WHERE HE SET UP A TENT AND ESTABLISHED THE FIRST YMCA IN ALASKA. THE ORGANIZATION OPERATED OUT OF THE PRESBYTERIAN CHURCH AND BY 1900 BOASTED A MEMBERSHIP OF ALMOST 1,000, PROMPTING THE YMCA TO CONTRACT WITH G.N. HENSLEY TO CONSTRUCT A GYMNASIUM. THE YMCA OPERATED THE GYMNASIUM UNTIL 1902 WHEN ITS MEMBERSHIP DECLINED FOLLOWING THE WANING GOLD RUSH. THE CARSTENS BROTHERS, PROPRIETORS OF THE ARCTIC MEAT COMPANY, PURCHASED THE BUILDING AND MOVED IT FORWARD TO FRONT STATE STREET AND CONNECTED IT TO THE MEYER BUILDING (1899). THE CARSTENS CONVERTED THE GYMNASIUM TO A COLD STORAGE FACILITY AND OPERATED THE ARCTIC MEAT COMPANY UNTIL AT LEAST 1909. IN 1921, GEORGE RAPUZZI PURCHASED THE GYMNASIUM FROM THE CITY OF SKAGWAY, WHICH HAD TAKEN OWNERSHIP. IN 1922, RAPUZZI BOUGHT THE MEYER BUILDING FROM THE CARSTENS AND USED BOTH BUILDINGS AS A GARAGE AND LATER STORAGE. THE RASMUSON FOUNDATION OF ANCHORAGE, ALASKA, PURCHASED BOTH BUILDINGS AND DONATED THEM TO THE NATIONAL PARK SERVICE IN 2008. THE YMCA GYMNASIUM IS A CONTRIBUTING RESOURCE TO THE SKAGWAY HISTORIC DISTRICT AND WHITE PASS NATIONAL HISTORIC LANDMARK. THE NATIONAL PARK SERVICE PLANS TO REHABILITATE THE BUILDING FOR A CONTEMPORARY USE.

TEAM MEMBERS


DANIELLE CAMPBELL	B.ARCH CANDIDATE '11	UNIVERSITY OF OREGON
MICHELLE CHIRCOP	M.S HPRES CANDIDATE '13	SCHOOL OF THE ART INSTITUTE CHICAGO
GRANT CROSBY	HISTORICAL ARCHITECT	NATIONAL PARK SERVICE
ROBERT LYON	HISTORIAN	NATIONAL PARK SERVICE
REBECCA SHAFFER	HISTORICAL ARCHITECT	NATIONAL PARK SERVICE
AARON WOOD	B.ARTS CANDIDATE '11	UNIVERSITY OF MINNESOTA

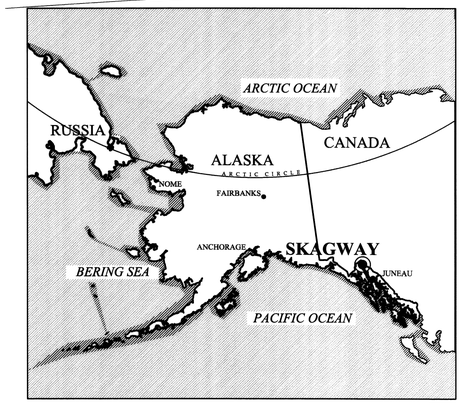

1 STATE MAP
SCALE: 1:40000
SCALE 1" = 375 MILES
1 CM = 322 KM

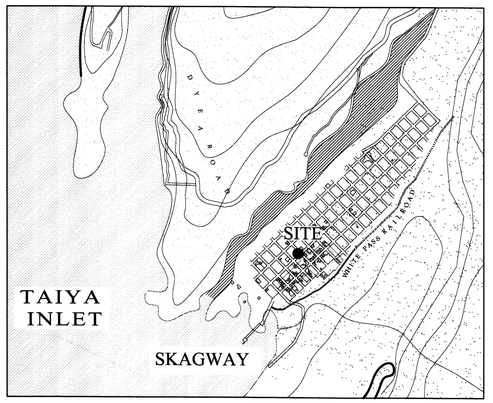

2 TOWN MAP
SCALE: 1:25000
SCALE 1" = 2000 FT
CENTIMETERS 1:24,000

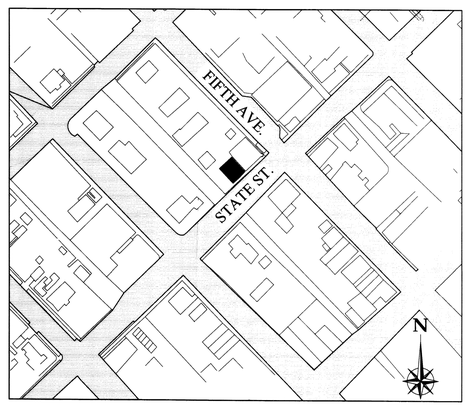

3 VICINITY MAP
SCALE: 1:2500
SCALE 1" = 135 FT
CENTIMETERS 1:1600

DRAWN BY: REBECCA SHAFFER (2010) MICHELLE CHIRCOP (2012)

YMCA GYMNASIUM
NATIONAL PARK SERVICE
UNITED STATES DEPARTMENT OF THE INTERIOR


YMCA GYMNASIUM
KLONDIKE GOLD RUSH NATIONAL HISTORICAL PARK
SKAGWAY
ALASKA

SURVEY NO. AK-229

HISTORIC AMERICAN BUILDINGS SURVEY
SHEET 1 OF 26 SHEETS

LIBRARY OF CONGRESS PRINTS & PHOTOGRAPHS

IF REPRODUCED, PLEASE CREDIT THE HISTORIC AMERICAN BUILDINGS SURVEY, NATIONAL PARK SERVICE, NAME OF DELINEATOR, DATE OF DRAWING

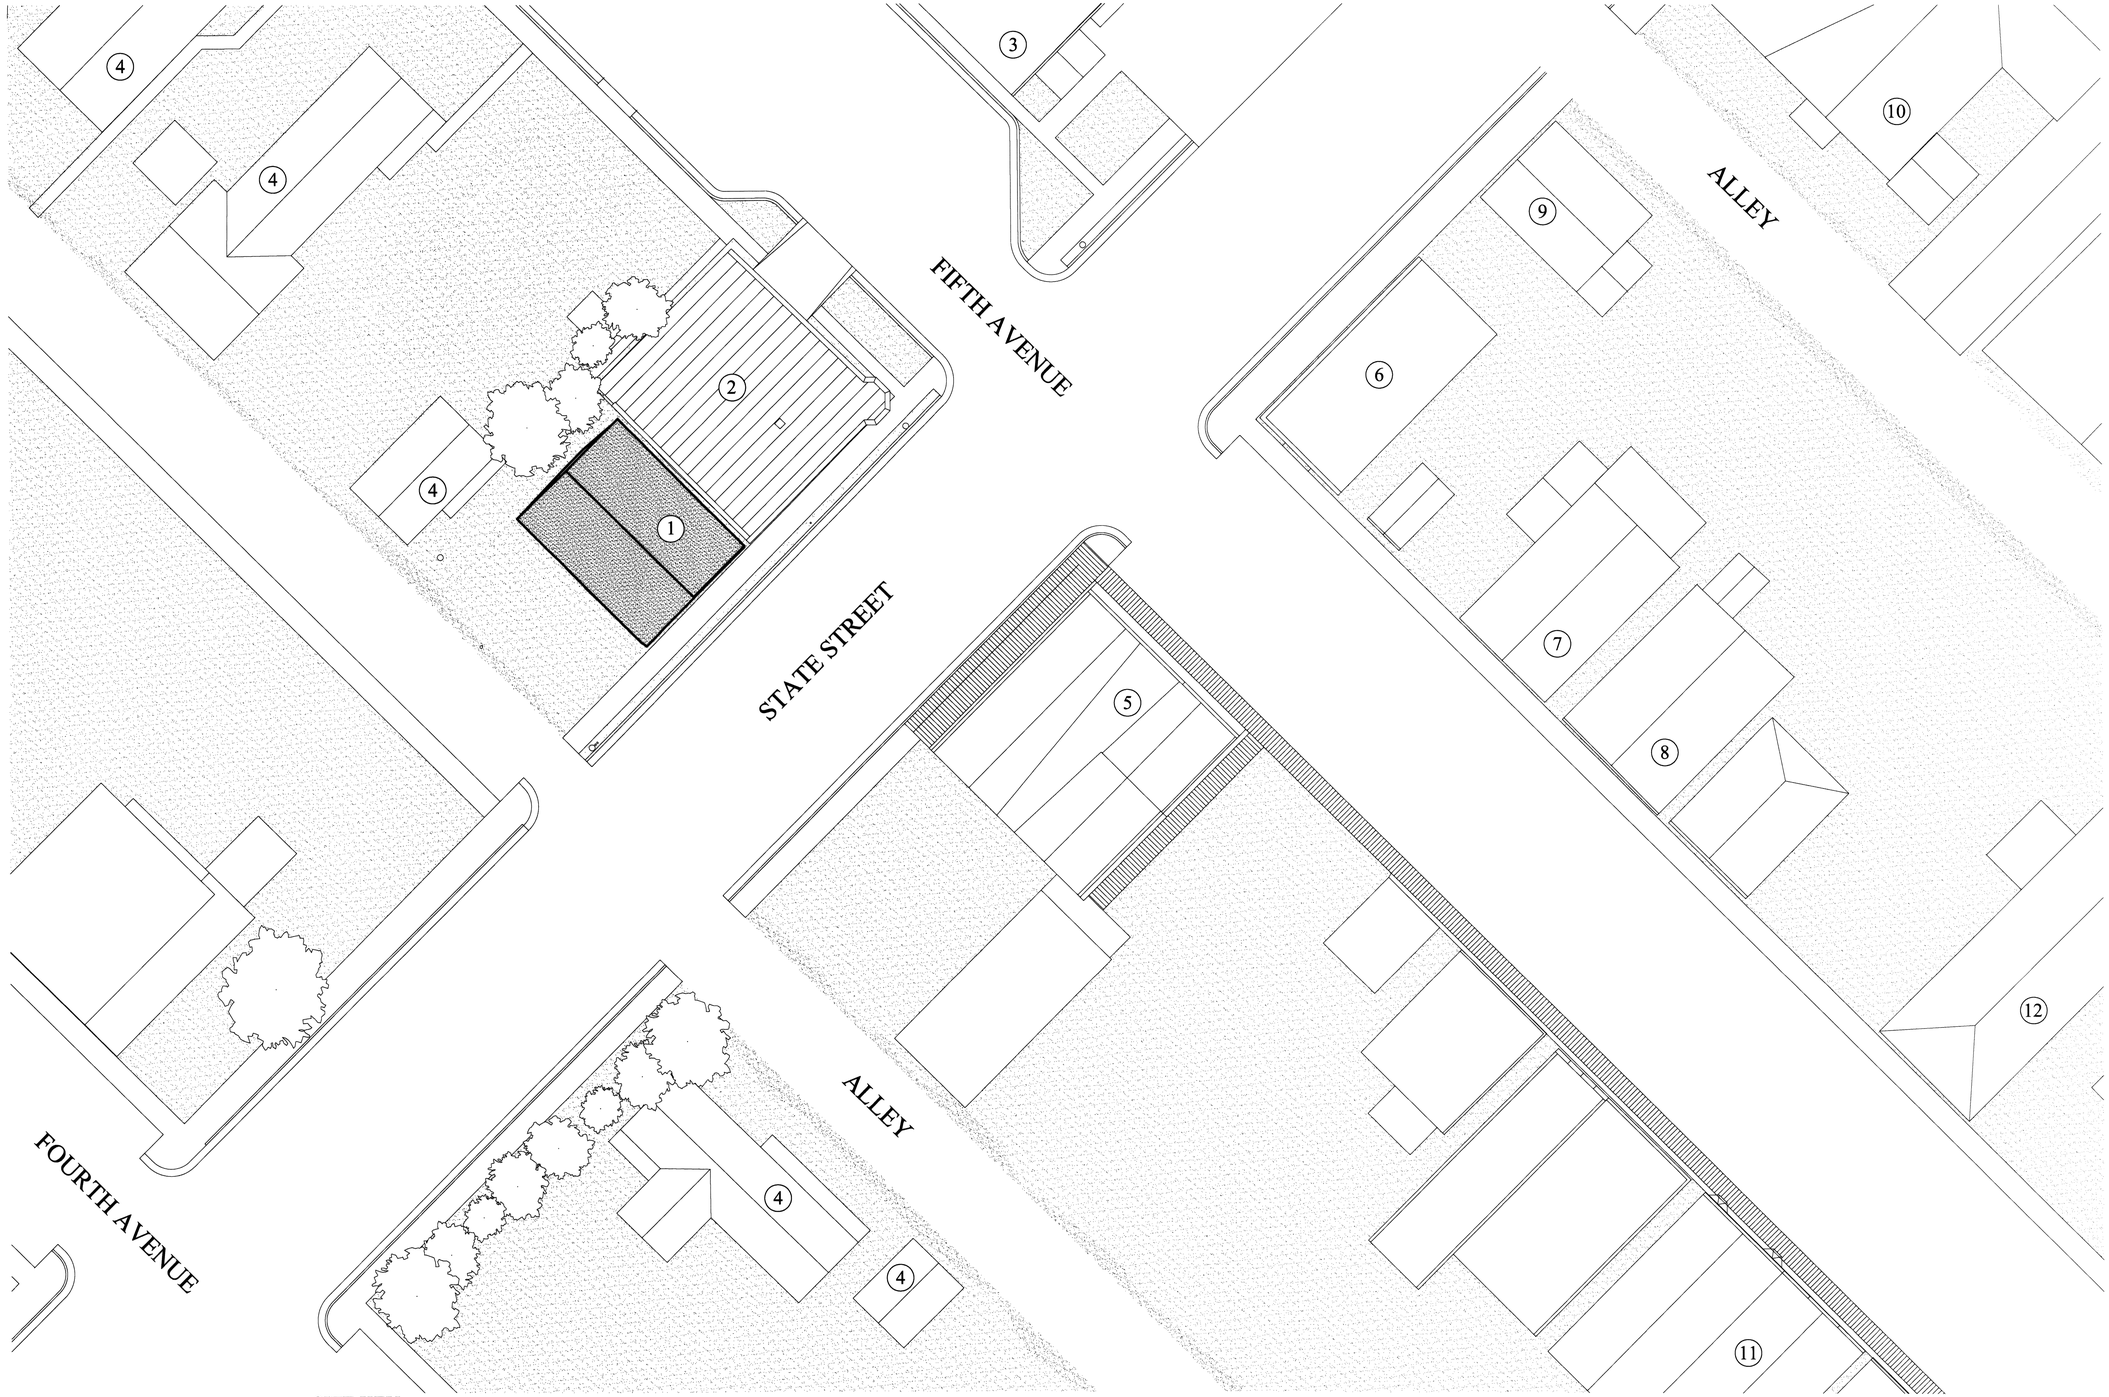

SITE KEY

1. YMCA (1900 - RELOCATED 1903-1905)
2. MEYER BUILDING (1899)
3. SKAGWAY VOLUNTEER FIRE DEPARTMENT
4. PRIVATE RESIDENCE
5. PORTLAND HOUSE (c. 1897)
6. TANNER BUILDING (c. 1900)
7. CITY HALL (1897)
8. BOARD OF TRADE (1898)
9. TANNER RESIDENCE (c. 1900s)
10. ELKS MEETING HALL
11. SEATTLE HOTEL, FRYE-BRUHN MEAT MARKET (1897)
12. HOUSE OF RICH (1906)

SITE PLAN

SCALE: FEET 1/16" = 1'-0" 0 4' 8' 16' 32'

CENTIMETERS 1:192 0 1 2 4 6 10

N

DRAWN BY: REBECCA SHAFFER (2010) MICHELLE CHIRCOP (2012)

YMCA GYMNASIUM

KLONDIKE GOLD RUSH NATIONAL HISTORICAL PARK

SKAGWAY ALASKA


YMCA GYMNASIUM
NATIONAL PARK SERVICE
UNITED STATES DEPARTMENT OF THE INTERIOR

SURVEY NO. AK-229

HISTORIC AMERICAN BUILDINGS SURVEY
SHEET 2 OF 26 SHEETS

LIBRARY OF CONGRESS PRINTS & PHOTOGRAPHS

IF REPRODUCED, PLEASE CREDIT THE HISTORIC AMERICAN BUILDINGS SURVEY, NATIONAL PARK SERVICE, NAME OF DELINEATOR, DATE OF DRAWING

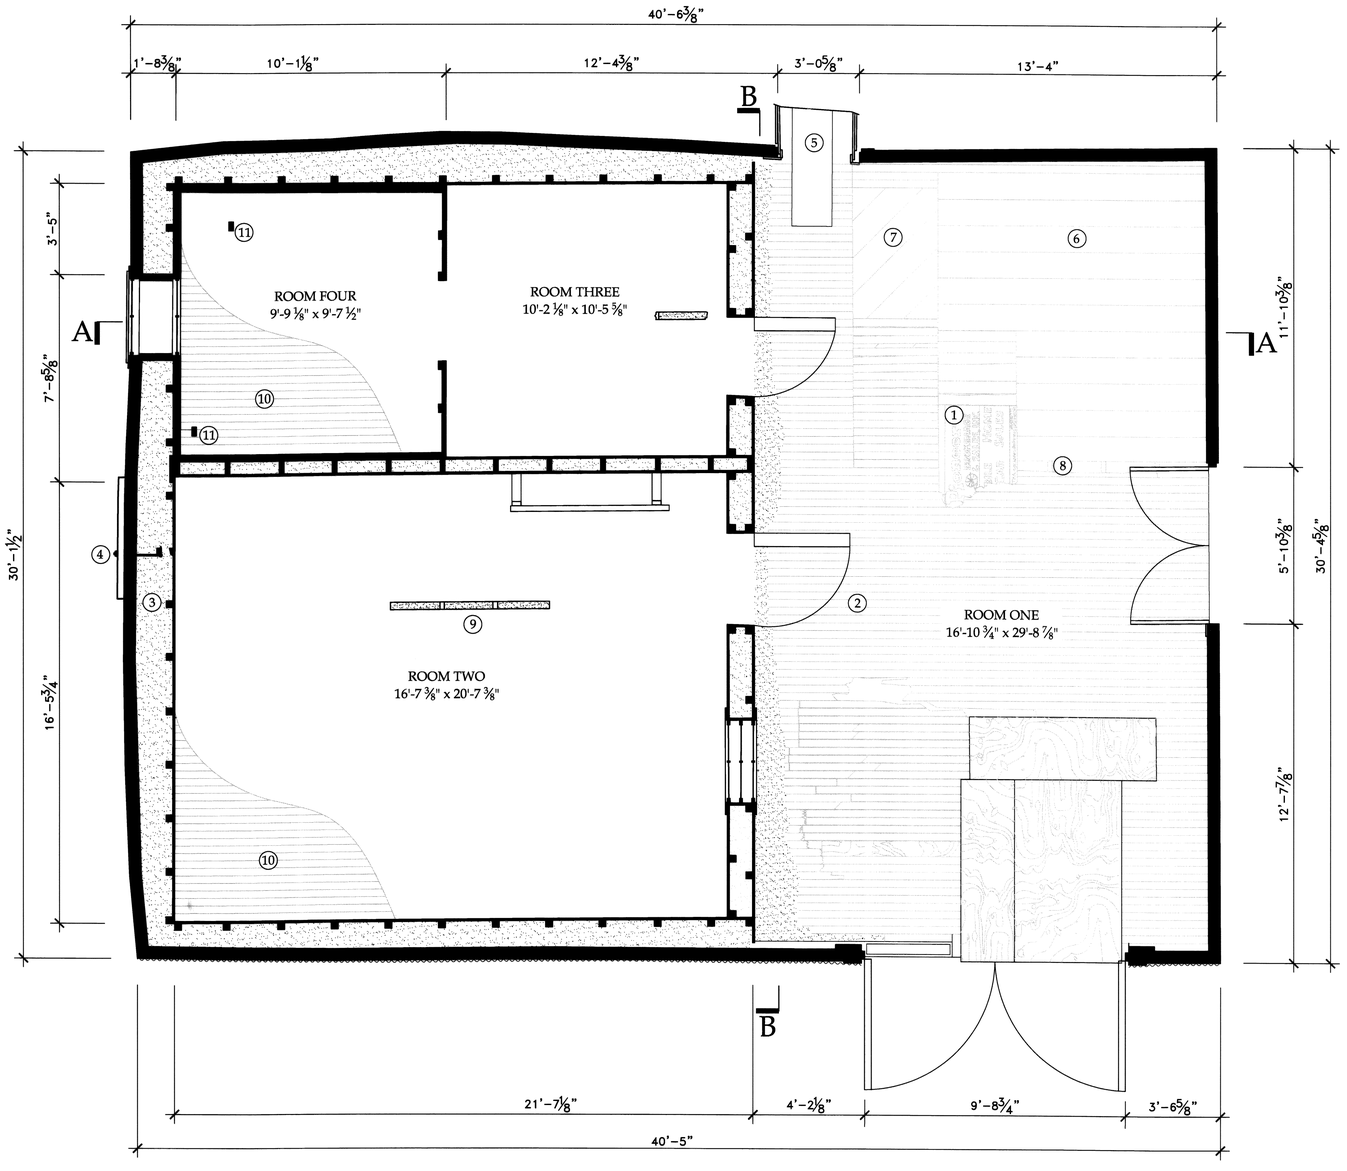

FLOOR PLAN

SCALE: 3/8" = 1' - 0"

0 1' 2' 4' FEET

0 .25 0.5 1 METERS

MATERIAL NOTES

1. "PIONEER BROKERAGE & SALES INC. MOBILE HOME SALES" PAINTED SIGN USED AS FLOOR PATCH
2. ¾" x 3 3/8" TONGUE & GROOVE, DETERIORATED
3. SAWDUST INSULATION
4. TENSION TIE
5. PASSAGEWAY TO MEYER BUILDING
6. 1"x 12" SPRUCE SUB FLOOR, DETERIORATED
7. 1"x 10" PLANKS
8. 2"x 6" FLOOR JOISTS, DETERIORATED
9. FLOOR JOISTS & SAWDUST INSULATION VISIBLE THROUGH MISSING FLOOR BOARDS
10. 7/8" x 3 3/8" TONGUE & GROOVE
11. MEAT RACK SUPPORTS

N

DRAWN BY: REBECCA SHAFFER (2010) MICHELLE CHIRCOP (2012)

YMCA GYMNASIUM
NATIONAL PARK SERVICE
UNITED STATES DEPARTMENT OF THE INTERIOR


YMCA GYMNASIUM
KLONDIKE GOLD RUSH NATIONAL HISTORICAL PARK
SKAGWAY ALASKA


SURVEY NO. AK-229

HISTORIC AMERICAN BUILDINGS SURVEY
SHEET 3 OF 26 SHEETS


LIBRARY OF CONGRESS PRINTS & PHOTOGRAPHS

IF REPRODUCED, PLEASE CREDIT THE HISTORIC AMERICAN BUILDINGS SURVEY, NATIONAL PARK SERVICE, NAME OF DELINEATOR, DATE OF DRAWING

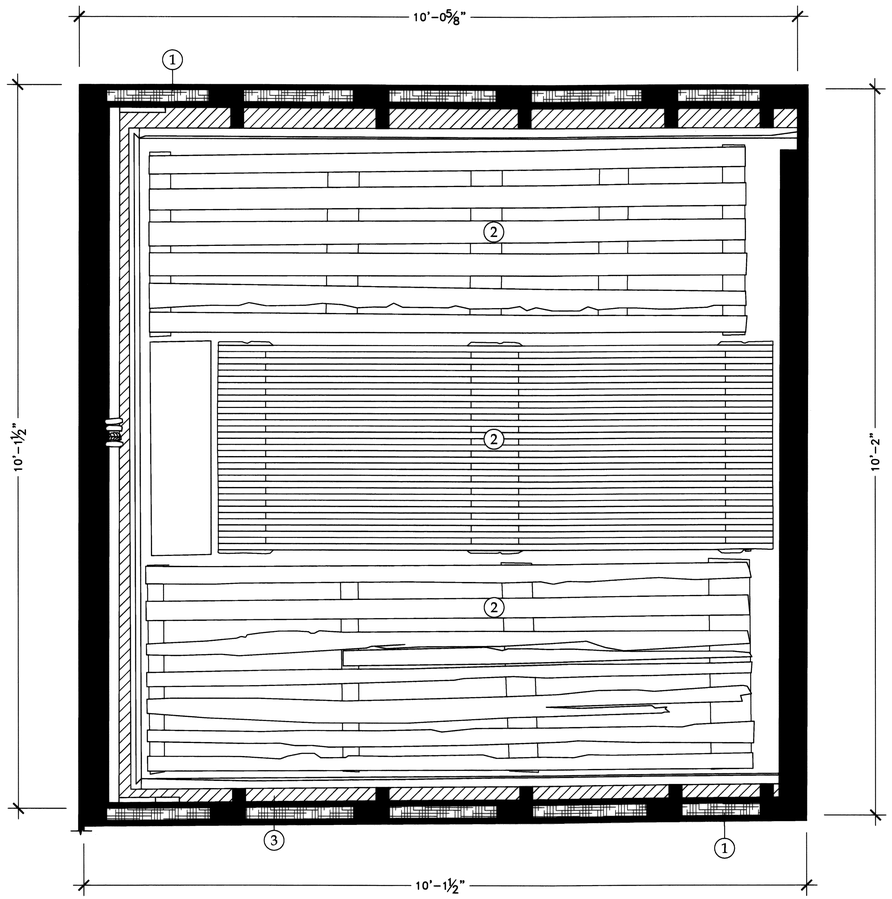

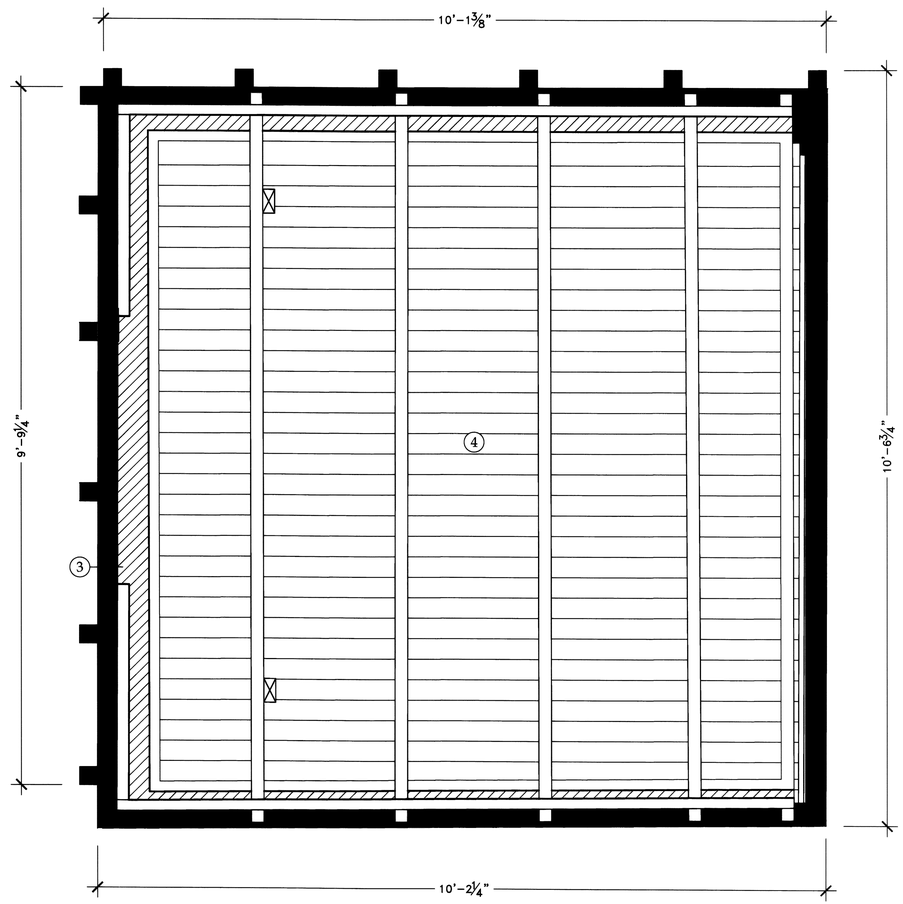

4
BELOW

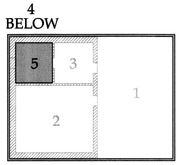

KEY


ROOM FIVE ICE RACK PLAN

SCALE: 1" = 1' - 0"

MATERIAL NOTES

1. BURLAP SACKS STUFFED INSIDE WALL CAVITY
2. REMOVABLE ICE RACKS
3. OPEN TO BELOW
4. ¾" x 3 ½" TONGUE AND GROOVE


5
ABOVE

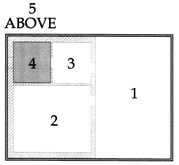

KEY

ROOM FOUR REFLECTED CEILING PLAN

SCALE: 1" = 1' - 0"

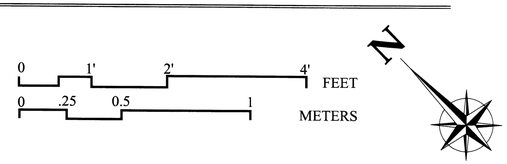

DRAWN BY: REBECCA SHAFFER (2010) MICHELLE CHIRCOP (2012)

YMCA GYMNASIUM
NATIONAL PARK SERVICE
UNITED STATES DEPARTMENT OF THE INTERIOR

YMCA GYMNASIUM

KLONDIKE GOLD RUSH NATIONAL HISTORICAL PARK


SKAGWAY ALASKA

SURVEY NO. AK-229

HISTORIC AMERICAN BUILDINGS SURVEY
SHEET 4 OF 26 SHEETS

LIBRARY OF CONGRESS PRINTS & PHOTOGRAPHS

IF REPRODUCED, PLEASE CREDIT THE HISTORIC AMERICAN BUILDINGS SURVEY, NAME OF DELINEATOR, DATE OF DRAWING

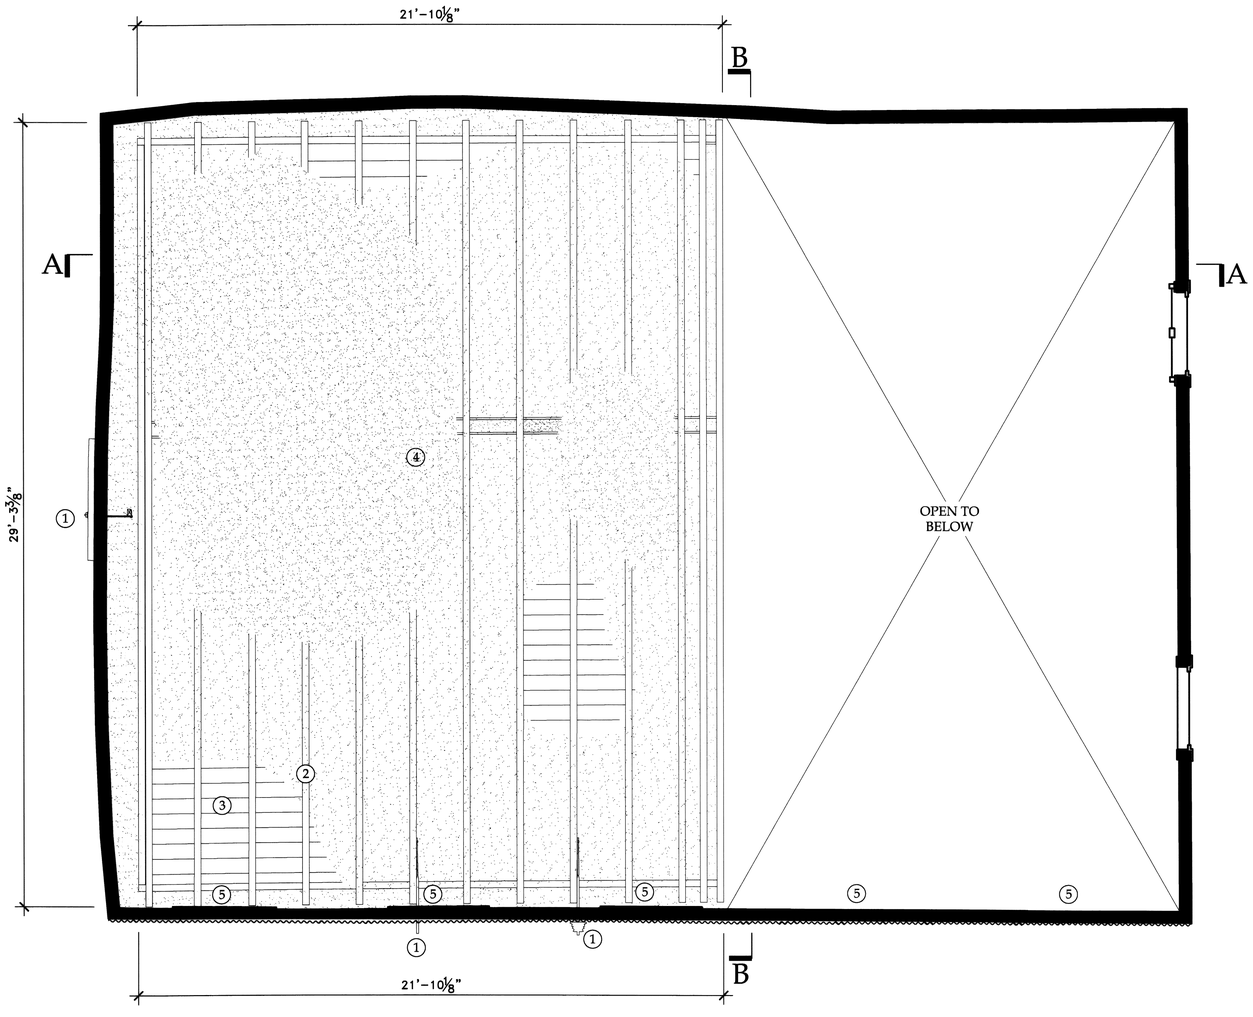


LOFT PLAN

SCALE: ⅜" = 1' - 0"


0 1' 2' 4' FEET

0 .25 0.5 1 METERS

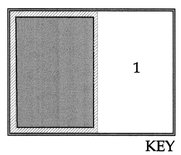

MATERIAL NOTES

1. TENSION TIE
2. 3"x 5" ROUGH SAWN ROOF JOISTS AT 24" ON CENTER
3. ⅞" x 6 ⅜" ROUGH SAWN CEILING BOARDS
4. SAWDUST INSULATION
5. 3'-1 ⅞" x 3'-9 ⅝" ROUGH OPENING OF WINDOWS VISIBLE IN 1903 PHOTOGRAPHS

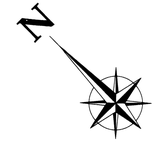

DRAWN BY: REBECCA SHAFFER (2010) MICHELLE CHIRCOP (2012)

YMCA GYMNASIUM
NATIONAL PARK SERVICE
UNITED STATES DEPARTMENT OF THE INTERIOR

YMCA GYMNASIUM


KLONDIKE GOLD RUSH NATIONAL HISTORICAL PARK


SKAGWAY ALASKA

SURVEY NO.	HISTORIC AMERICAN BUILDINGS SURVEY
AK-229	SHEET 5 OF 26 SHEETS

LIBRARY OF CONGRESS PRINTS & PHOTOGRAPHS

IF REPRODUCED, PLEASE CREDIT THE HISTORIC AMERICAN BUILDINGS SURVEY, NATIONAL PARK SERVICE. NAME OF ORGANIZATION, DATE OF DRAWING

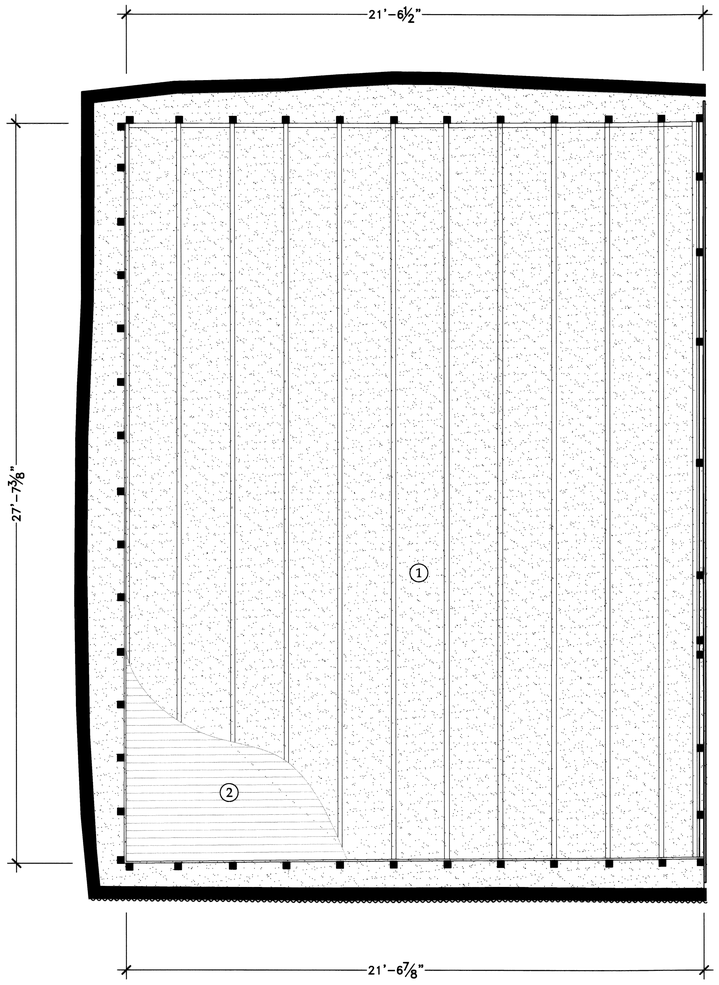

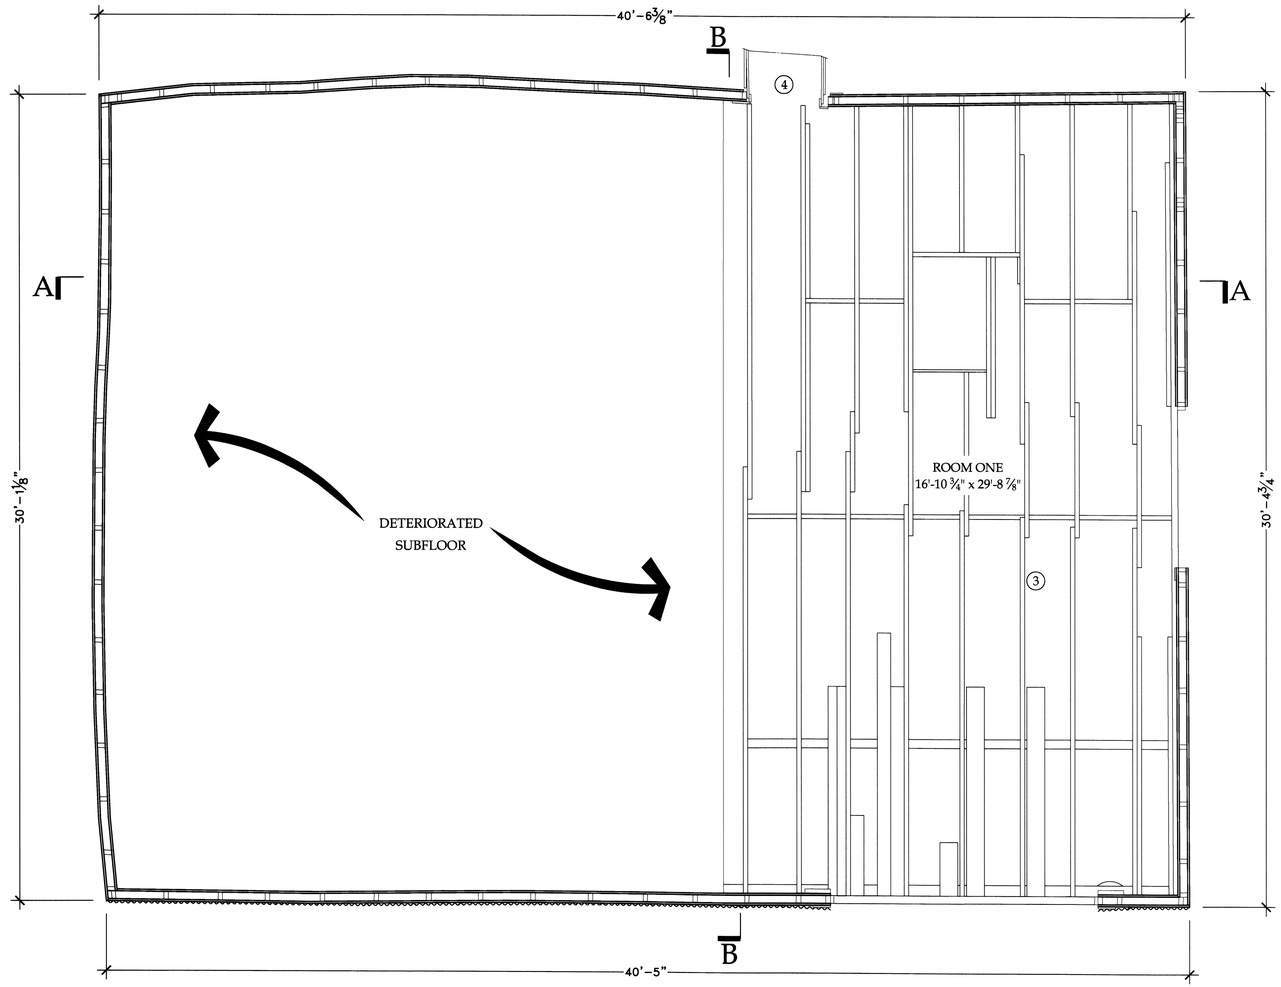



COLD STORAGE FLOOR FRAMING PLAN

SCALE: ⅜" = 1' - 0"

YMCA FLOOR FRAMING PLAN

SCALE: ⅜" = 1' - 0"

0 1' 2' 4' FEET

0 .25 0.5 1 METERS

MATERIAL NOTES

1. SAWDUST INSULATION
2. ⅞" x 3 ⅜" TONGUE & GROOVE
3. 2"x 6" FLOOR JOISTS, DETERIORATED
4. PASSAGEWAY TO MEYER BUILDING

DRAWN BY: REBECCA SHAFFER (2010) MICHELLE CHIRCOP (2012)

YMCA GYMNASIUM
NATIONAL PARK SERVICE
UNITED STATES DEPARTMENT OF THE INTERIOR


YMCA GYMNASIUM
KLONDIKE GOLD RUSH NATIONAL HISTORICAL PARK
SKAGWAY ALASKA

SURVEY NO. AK-229

HISTORIC AMERICAN BUILDINGS SURVEY
SHEET 6 OF 26 SHEETS

LIBRARY OF CONGRESS
PRINTS & PHOTOGRAPHS

IF REPRODUCED, PLEASE CREDIT THE HISTORIC AMERICAN BUILDINGS SURVEY, NATIONAL PARK SERVICE, NAME OF DELINEATOR, DATE OF DRAWING

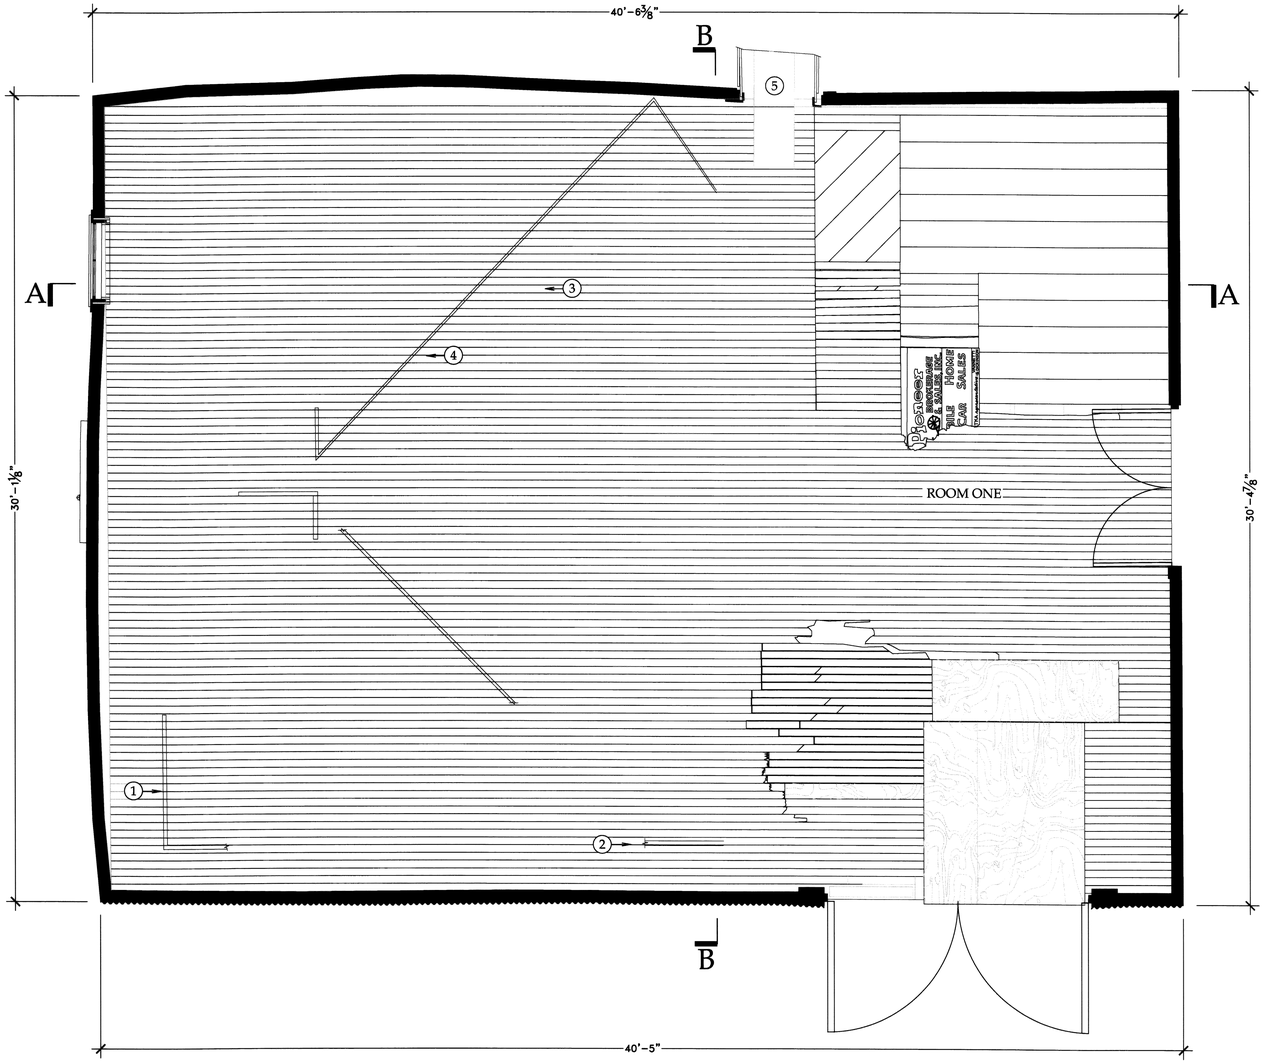

GYMNASIUM FLOOR PLAN

SCALE: ⅜" = 1' - 0"

0 1' 2' 4' FEET

0 .25 0.5 1 METERS

N

GYMNASIUM FLOOR NOTES

THE NATIONAL PARK SERVICE INITIATED STABILIZATION EFFORTS ON THE YMCA IN 2010 WHICH INCLUDED THE CONSTRUCTION OF A NEW FOUNDATION. THE COLD STORAGE UNITS CONSTRUCTED BY THE ARCTIC MEAT COMPANY WERE CAREFULLY RECORDED AND DISASSEMBLED TO FACILITATE THE CONSTRUCTION OF THE FOUNDATION. WHEN THE COLD STORAGE UNITS WERE REMOVED, THE ORIGINAL GYMNASIUM FLOOR WAS DISCOVERED WITH THE REMAINS OF THE PAINTED LINES DESCRIBED ABOVE. RESEARCH INDICATES THAT THESE LINES MAY HAVE BEEN USED FOR INDOOR BASEBALL, A POPULAR GAME IN the 1890s AND EARLY 1900s, WHICH LATER EVOLVED INTO SOFTBALL.

MATERIAL NOTES

1. GREEN LINE
2. GREEN LINE LIKELY CONTINUOUS WITH LINE ON LEFT
3. ANIMAL BONES & HAT DISCOVERED BENEATH FLOOR AT THIS LOCATION
4. RED LINE
5. PASSAGEWAY TO MEYER BUILDING

DRAWN BY: REBECCA SHAFFER (2010) MICHELLE CHIRCOP (2012)

YMCA GYMNASIUM
NATIONAL PARK SERVICE
UNITED STATES DEPARTMENT OF THE INTERIOR

SKAGWAY

YMCA GYMNASIUM

KLONDIKE GOLD RUSH NATIONAL HISTORICAL PARK


ALASKA

SURVEY NO. AK-229

HISTORIC AMERICAN BUILDINGS SURVEY
SHEET 7 OF 26 SHEETS

LIBRARY OF CONGRESS
PRINTS & PHOTOGRAPHS

IF REPRODUCED, PLEASE CREDIT THE HISTORIC AMERICAN BUILDINGS SURVEY, NATIONAL PARK SERVICE, NAME OF DELINEATOR, DATE OF DRAWING

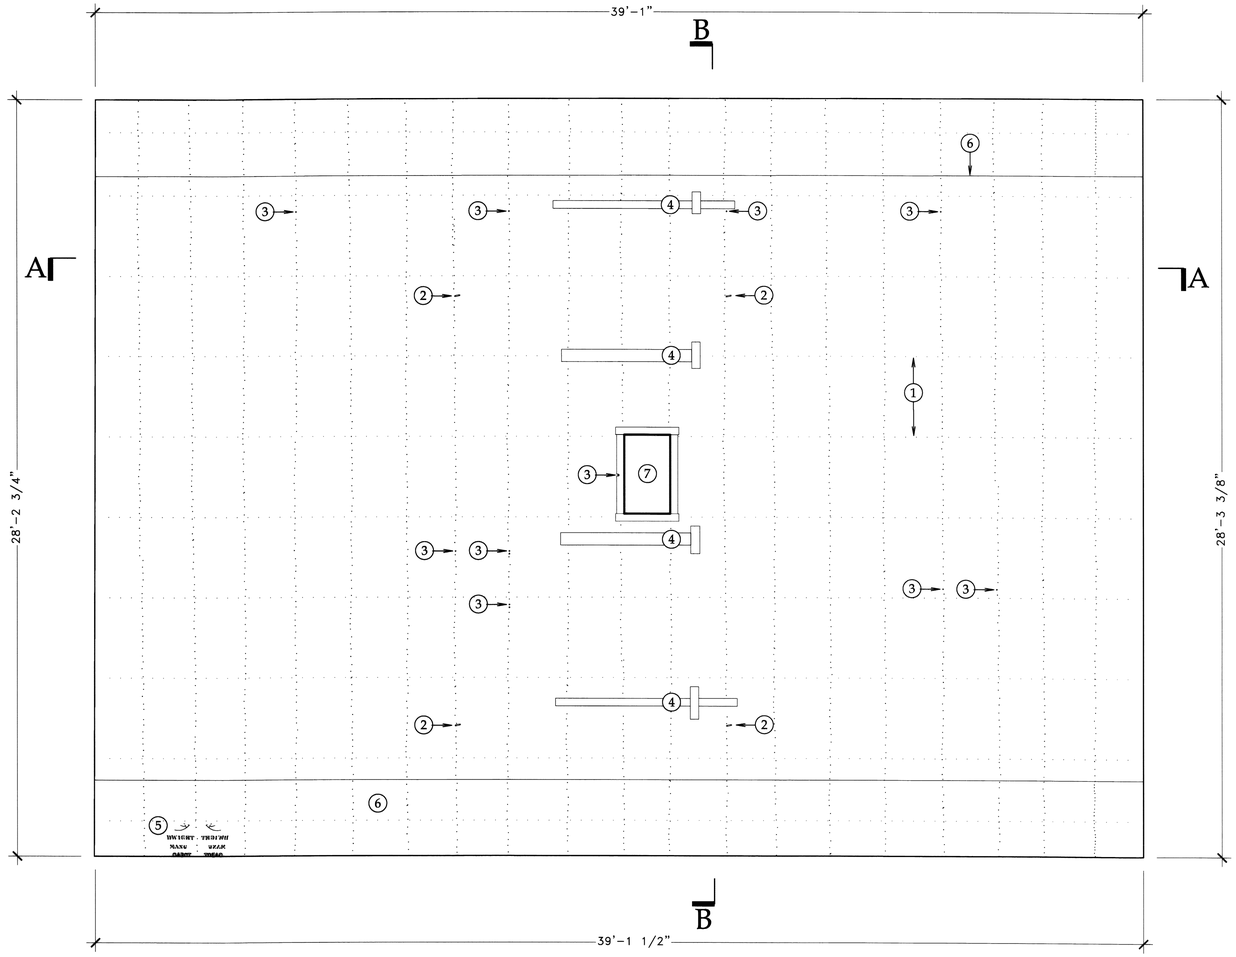

REFLECTED CEILING PLAN

SCALE: 3/8" = 1' - 0"

0 1' 2' 4' FEET

0 .25 0.5 METERS

N

MATERIAL NOTES

1. PAINTED CANVAS, SEAMS EVERY 3'-0", TACK LINES AT CEILING JOISTS AT 24" ON CENTER
2. PORCELAIN TUBE WITH WIRING FOR LIGHTING
3. VACANT THREADED HOLES, ½" DIAMETER
4. ¾"x 5½" BOARDS NAILED TO CEILING TRUSSES
5. TEXT PAINTED ON CANVAS, "DWIGHT MANU CABOT"
6. TRANSITION FROM SLOPED CEILING TO FLAT CEILING
7. ATTIC ACCESS

DRAWN BY: REBECCA SHAFFER (2010) MICHELLE CHIRCOP (2012)

YMCA GYMNASIUM
NATIONAL PARK SERVICE
UNITED STATES DEPARTMENT OF THE INTERIOR

YMCA GYMNASIUM
KLONDIKE GOLD RUSH NATIONAL HISTORICAL PARK
SKAGWAY ALASKA

SURVEY NO. AK-229

HISTORIC AMERICAN BUILDINGS SURVEY
SHEET 8 OF 26 SHEETS

LIBRARY OF CONGRESS PRINTS & PHOTOGRAPHS DIVISION


IF REPRODUCED, PLEASE CREDIT THE HISTORIC AMERICAN BUILDINGS SURVEY, NATIONAL PARK SERVICE. NAME OF DELINEATOR, DATE OF DRAWING

ROOF PLAN

SCALE: 3/8" = 1' - 0"

MATERIAL NOTES

① CORRUGATED METAL ROOFING
② LADDER REMNANT
③ ROOF LADDER

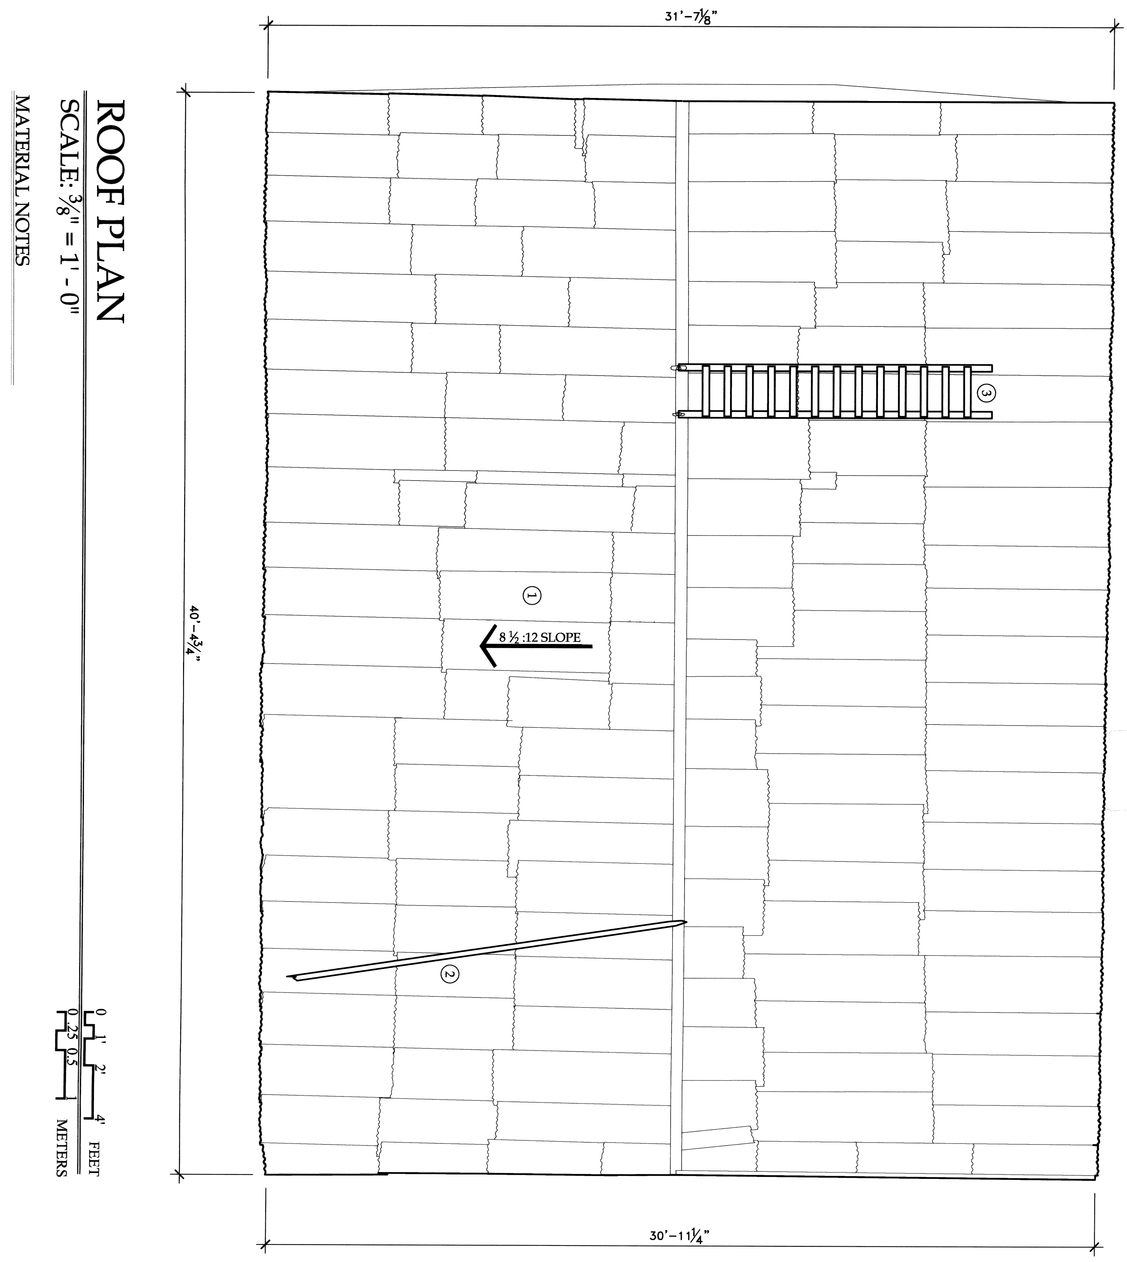




DRAWN BY: REBECCA SHAFFER (2010) MICHELLE CHIRCOP (2012)

YMCA GYMNASIUM NATIONAL PARK SERVICE UNITED STATES DEPARTMENT OF THE INTERIOR	YMCA GYMNASIUM SKAGWAY — KLONDIKE GOLD RUSH NATIONAL HISTORICAL PARK — ALASKA	SURVEY NO. AK-229	HISTORIC AMERICAN BUILDINGS SURVEY SHEET 9 OF 26 SHEETS	LIBRARY OF CONGRESS DOCKET NUMBER

IF REPRODUCED, PLEASE CREDIT THE HISTORIC AMERICAN BUILDINGS SURVEY, NATIONAL PARK SERVICE, NAME OF DELINEATOR, DATE OF DRAWING

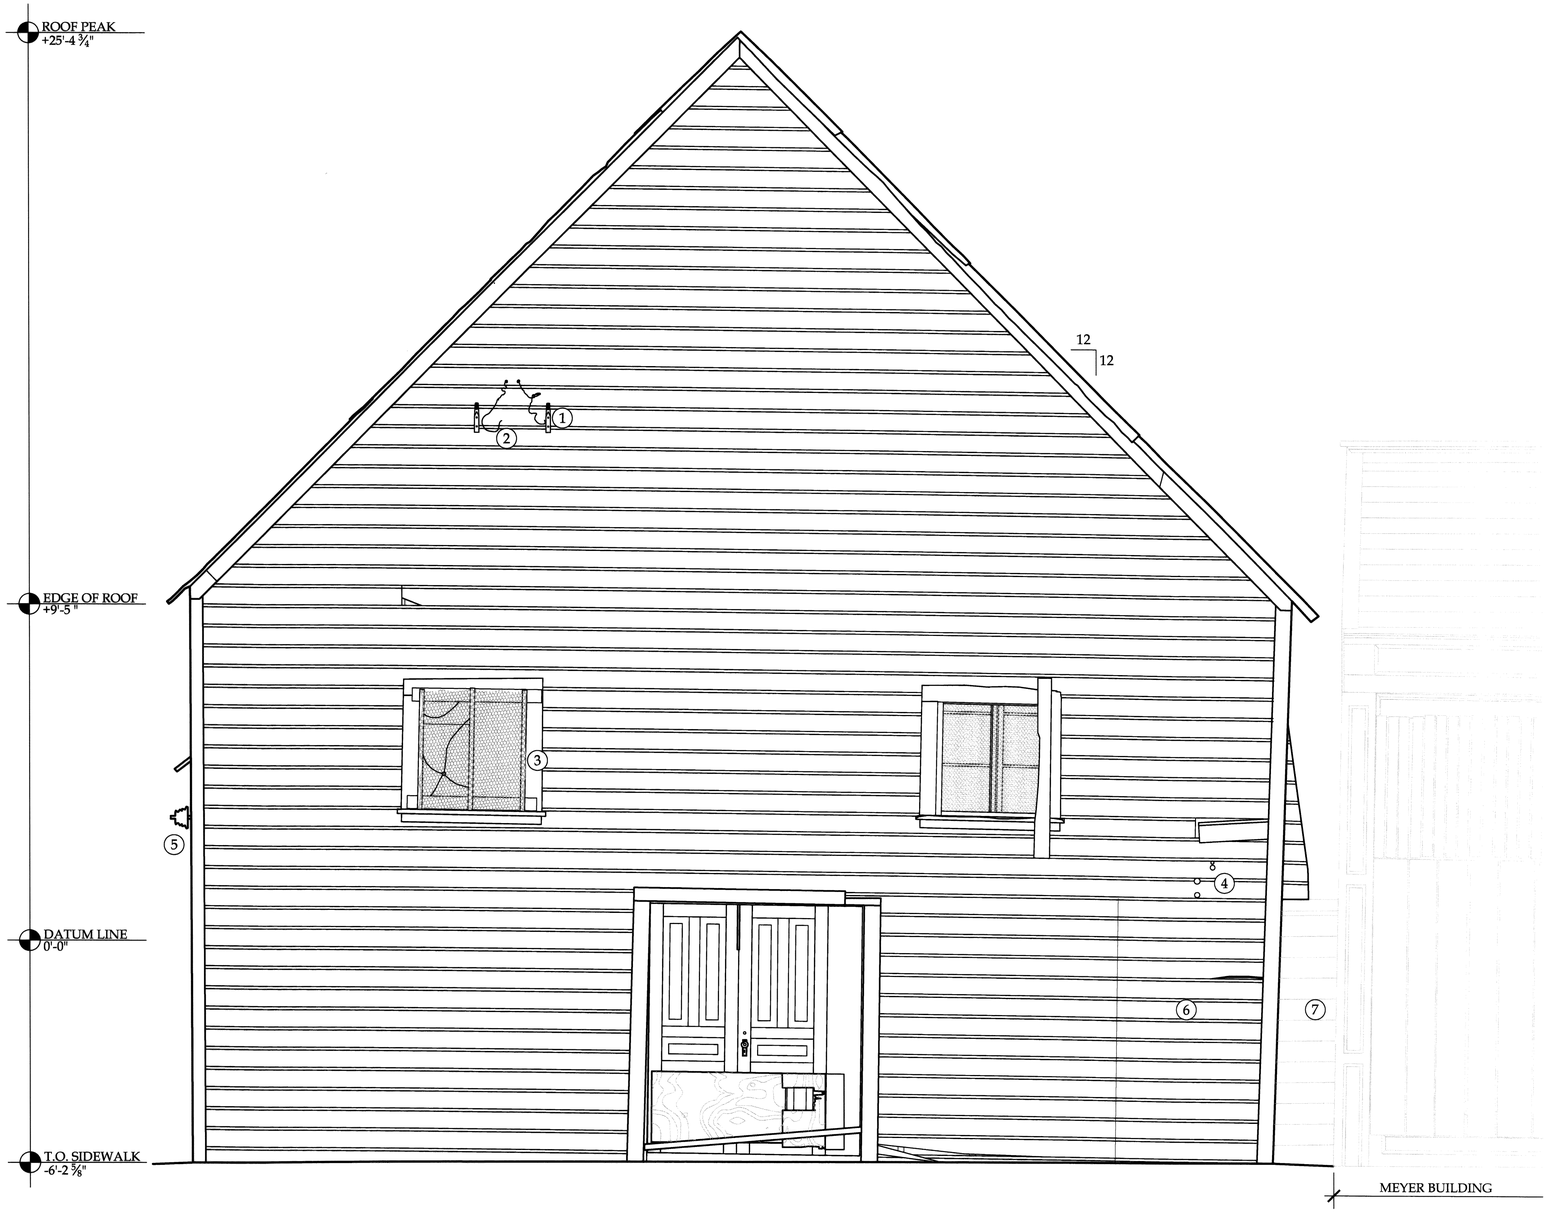

EAST ELEVATION

SCALE: ½" = 1' - 0"

0 1' 2' 4' FEET

0 .25 0.5 1 METERS

MATERIAL NOTES

1. WOOD INSULATOR POSTS
2. ELECTRICAL WIRE REMNANT
3. CHICKEN WIRE, 1" HEXAGONAL MESH
4. ABANDONED ELECTRICAL PENETRATIONS
5. TENSION TIE CAP
6. DOOR PATCH
7. PASSAGEWAY TO MEYER BUILDING

DRAWN BY: REBECCA SHAFFER (2010) MICHELLE CHIRCOP (2012)

YMCA GYMNASIUM
NATIONAL PARK SERVICE
UNITED STATES DEPARTMENT OF THE INTERIOR

YMCA GYMNASIUM

KLONDIKE GOLD RUSH NATIONAL HISTORICAL PARK


SKAGWAY ALASKA

SURVEY NO. AK-229

HISTORIC AMERICAN BUILDINGS SURVEY
SHEET 10 OF 26 SHEETS

LIBRARY OF CONGRESS PRINTS & PHOTOGRAPHS

IF REPRODUCED, PLEASE CREDIT THE HISTORIC AMERICAN BUILDINGS SURVEY, NATIONAL PARK SERVICE, NAME OF DELINEATOR, DATE OF DRAWING

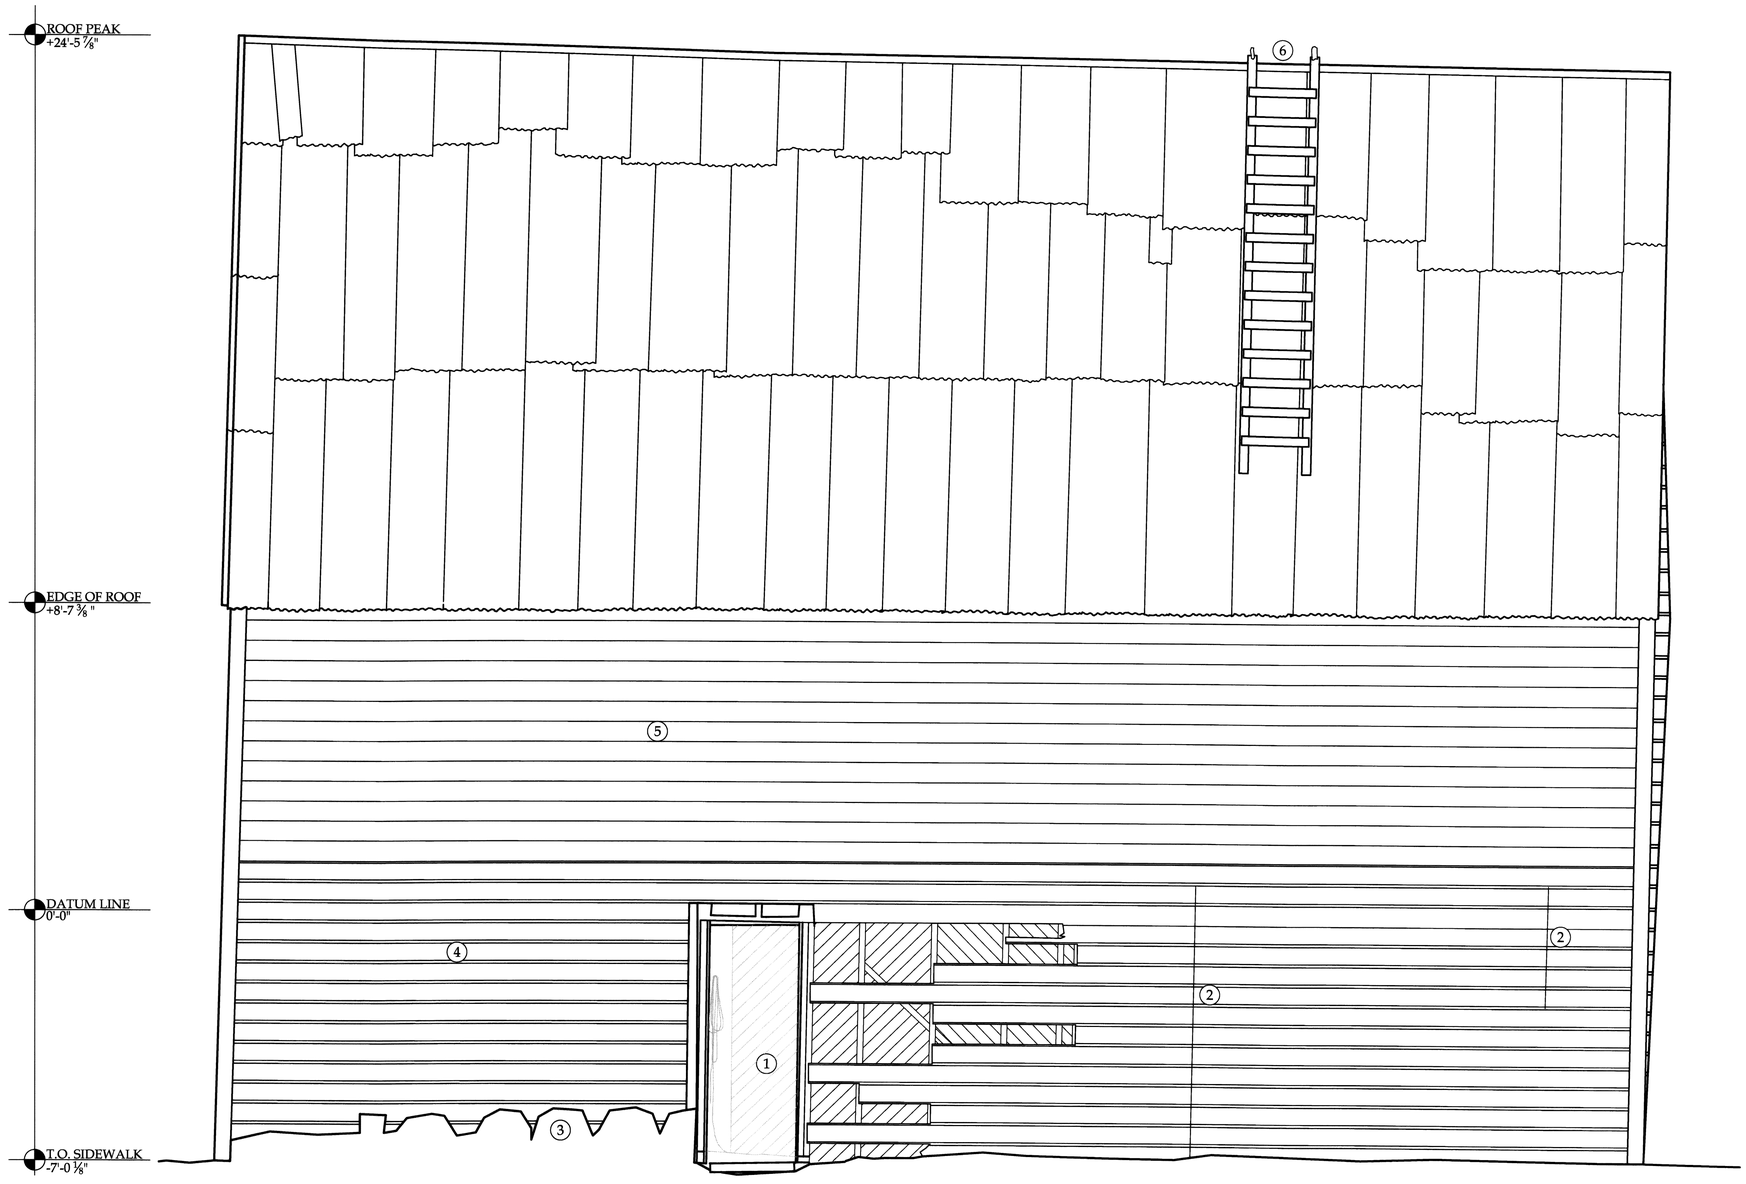

NORTH ELEVATION

SCALE: ½" = 1' - 0"

0 1' 2' 4' FEET

0 .25 0.5 1 METERS

MATERIAL NOTES

1. PASSAGEWAY TO MEYER BUILDING
2. CONTINUOUS VERTICAL JOINTS IN SIDING
3. CAR TIRES LEANING AGAINST SIDING
4. ¾" x 5 ¼" DROP SIDING
5. ¾" x 7 ¼" SHIPLAP SIDING
6. ROOF LADDER

DRAWN BY: REBECCA SHAFFER (2010) MICHELLE CHIRCOP (2012)

YMCA GYMNASIUM
NATIONAL PARK SERVICE
UNITED STATES DEPARTMENT OF THE INTERIOR


YMCA GYMNASIUM
KLONDIKE GOLD RUSH NATIONAL HISTORICAL PARK
SKAGWAY ALASKA

SURVEY NO. AK-229

HISTORIC AMERICAN BUILDINGS SURVEY
SHEET 11 OF 26 SHEETS

LIBRARY OF CONGRESS SHEET NUMBER

IF REPRODUCED, PLEASE CREDIT THE HISTORIC AMERICAN BUILDINGS SURVEY, NATIONAL PARK SERVICE, NAME OF DELINEATOR, DATE OF DRAWING

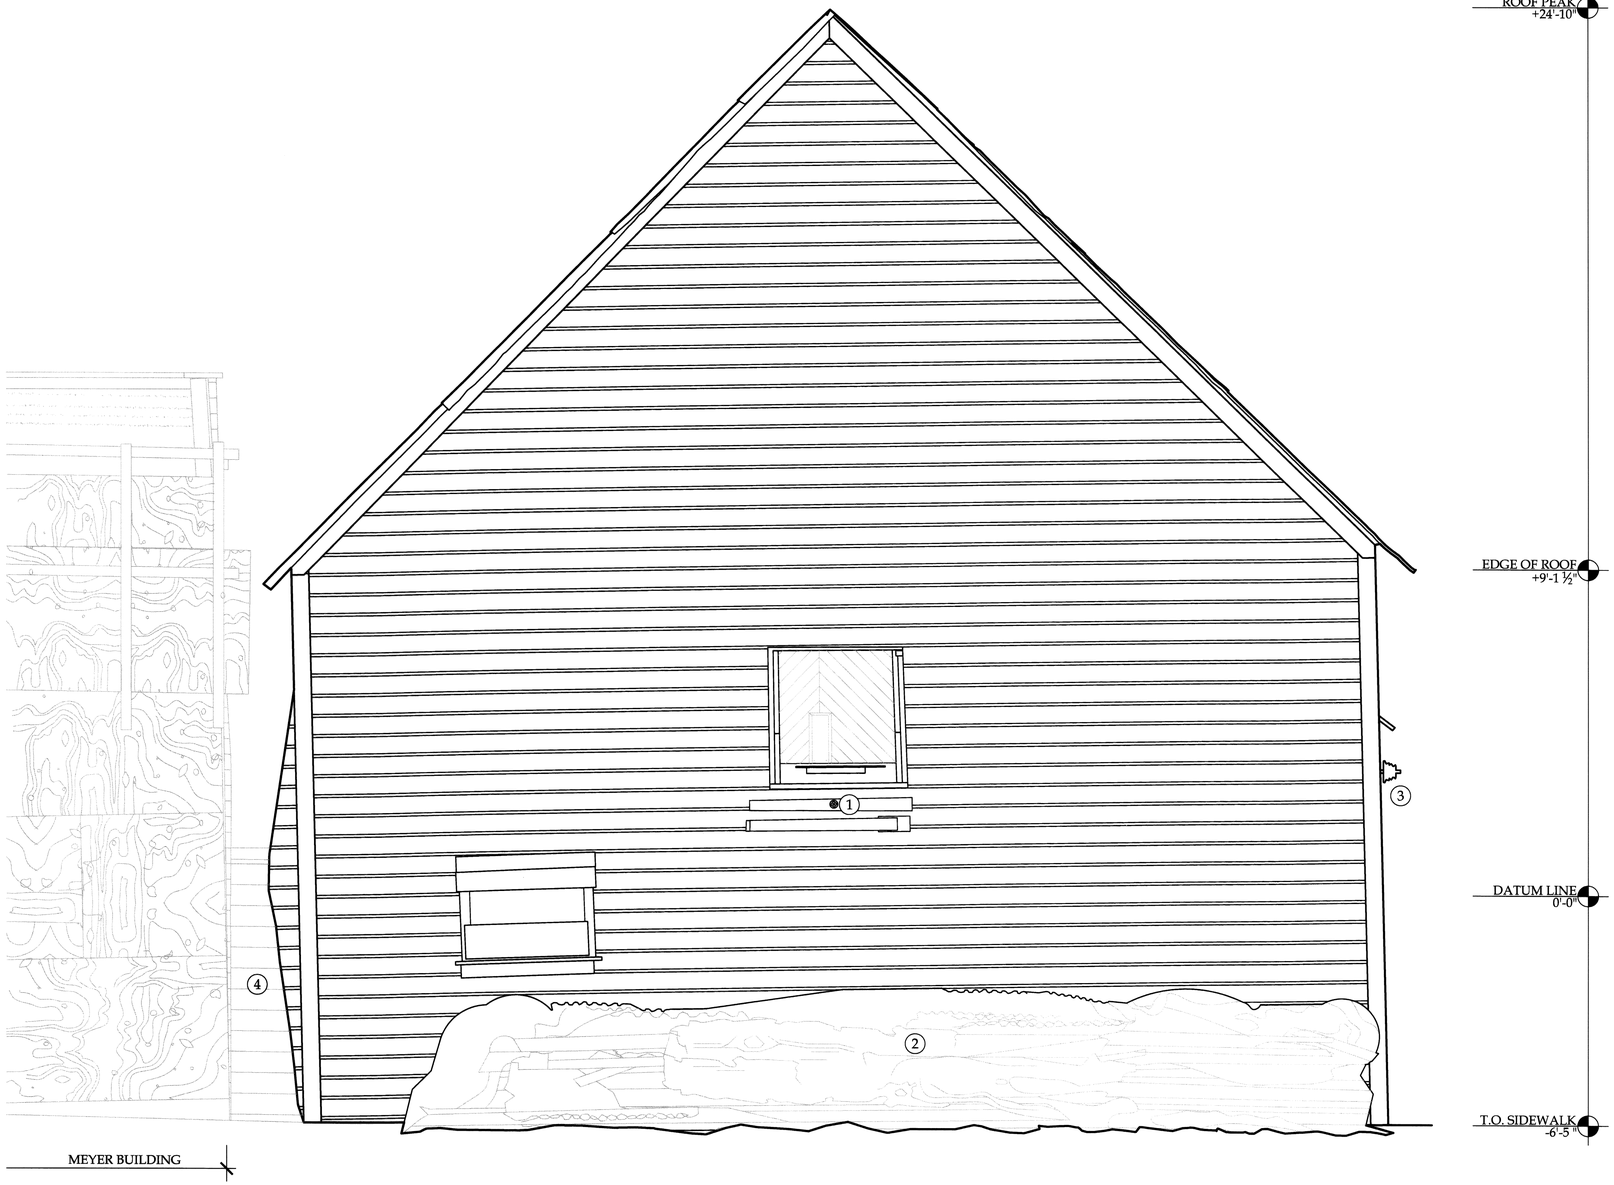

WEST ELEVATION

SCALE: ½" = 1' - 0"

0 1' 2' 4' FEET

0 .25 0.5 1 METERS

MATERIAL NOTES

1. TENSION TIE
2. PILE OF DISCARDED PLYWOOD, CORRUGATED METAL & TIRES
3. TENSION TIE CAP
4. PASSAGE WAY TO MEYER BUILDING

DRAWN BY: REBECCA SHAFFER (2010) MICHELLE CHIRCOP (2012)

YMCA GYMNASIUM
NATIONAL PARK SERVICE
UNITED STATES DEPARTMENT OF THE INTERIOR

YMCA GYMNASIUM

KLONDIKE GOLD RUSH NATIONAL HISTORICAL PARK


SKAGWAY ALASKA

SURVEY NO. AK-229

HISTORIC AMERICAN BUILDINGS SURVEY
SHEET 12 OF 26 SHEETS

LIBRARY OF CONGRESS PRINTS & PHOTOGRAPHS

IF REPRODUCED, PLEASE CREDIT THE HISTORIC AMERICAN BUILDINGS SURVEY, NATIONAL PARK SERVICE, NAME OF DELINEATOR, DATE OF DRAWING

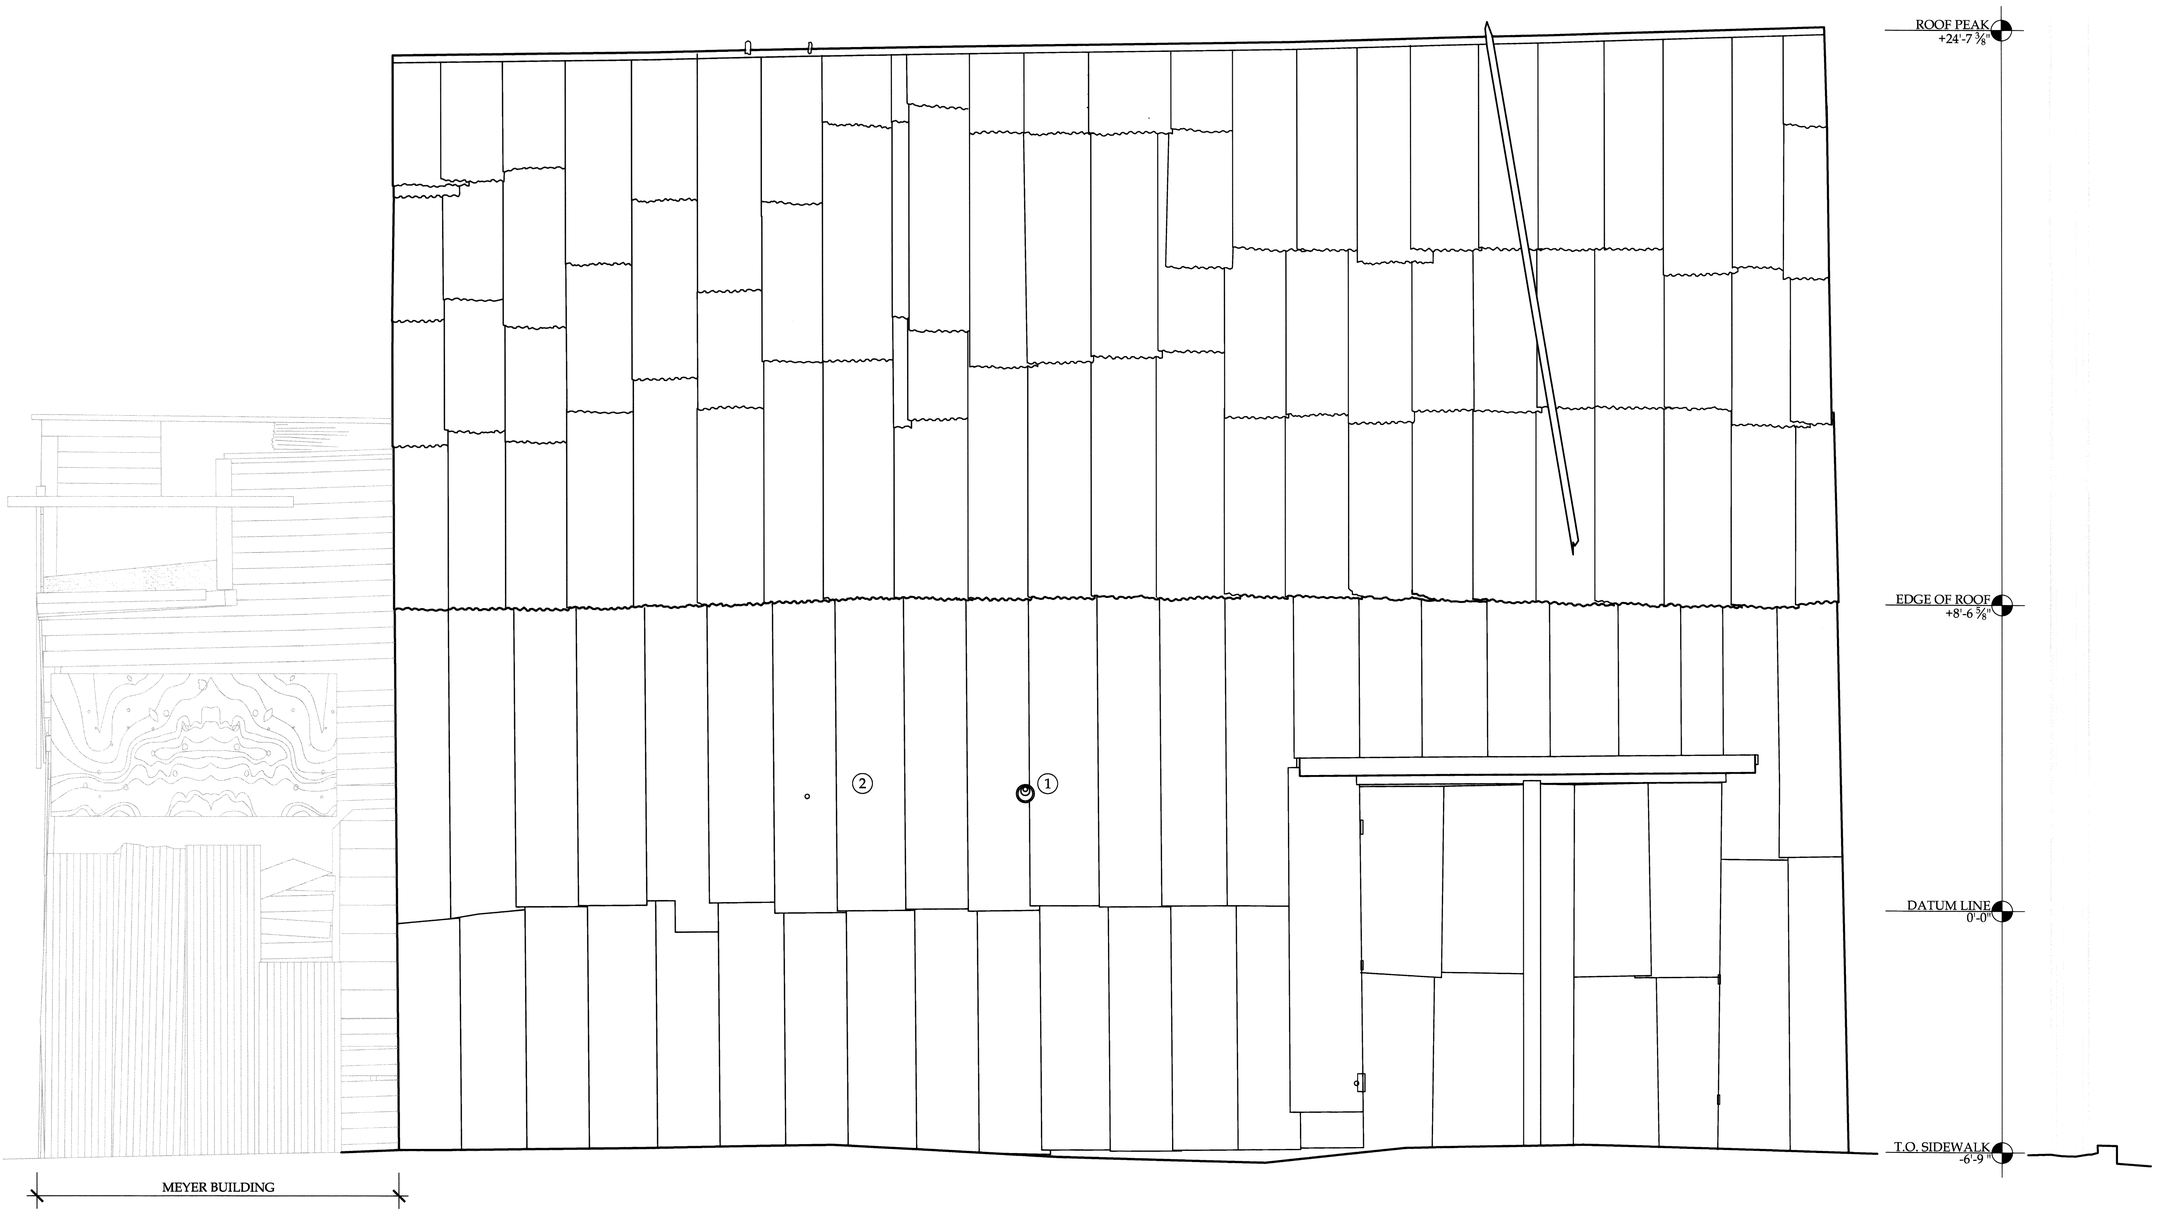

SOUTH ELEVATION

SCALE: ½" = 1' - 0"

0 1' 2' 4' FEET

0 .25 0.5 1 METERS

MATERIAL NOTES

① TENSION TIE CAP
② CORRUGATED METAL SIDING

DRAWN BY: REBECCA SHAFFER (2010) MICHELLE CHIRCOP (2012)

YMCA GYMNASIUM
NATIONAL PARK SERVICE
UNITED STATES DEPARTMENT OF THE INTERIOR


YMCA GYMNASIUM
KLONDIKE GOLD RUSH NATIONAL HISTORICAL PARK
SKAGWAY ALASKA

SURVEY NO. AK-229

HISTORIC AMERICAN BUILDINGS SURVEY
SHEET 13 OF 26 SHEETS

LIBRARY OF CONGRESS PRINTS & PHOTOGRAPHS

IF REPRODUCED, PLEASE CREDIT THE HISTORIC AMERICAN BUILDINGS SURVEY, NATIONAL PARK SERVICE, NAME OF DELINEATOR, DATE OF DRAWING

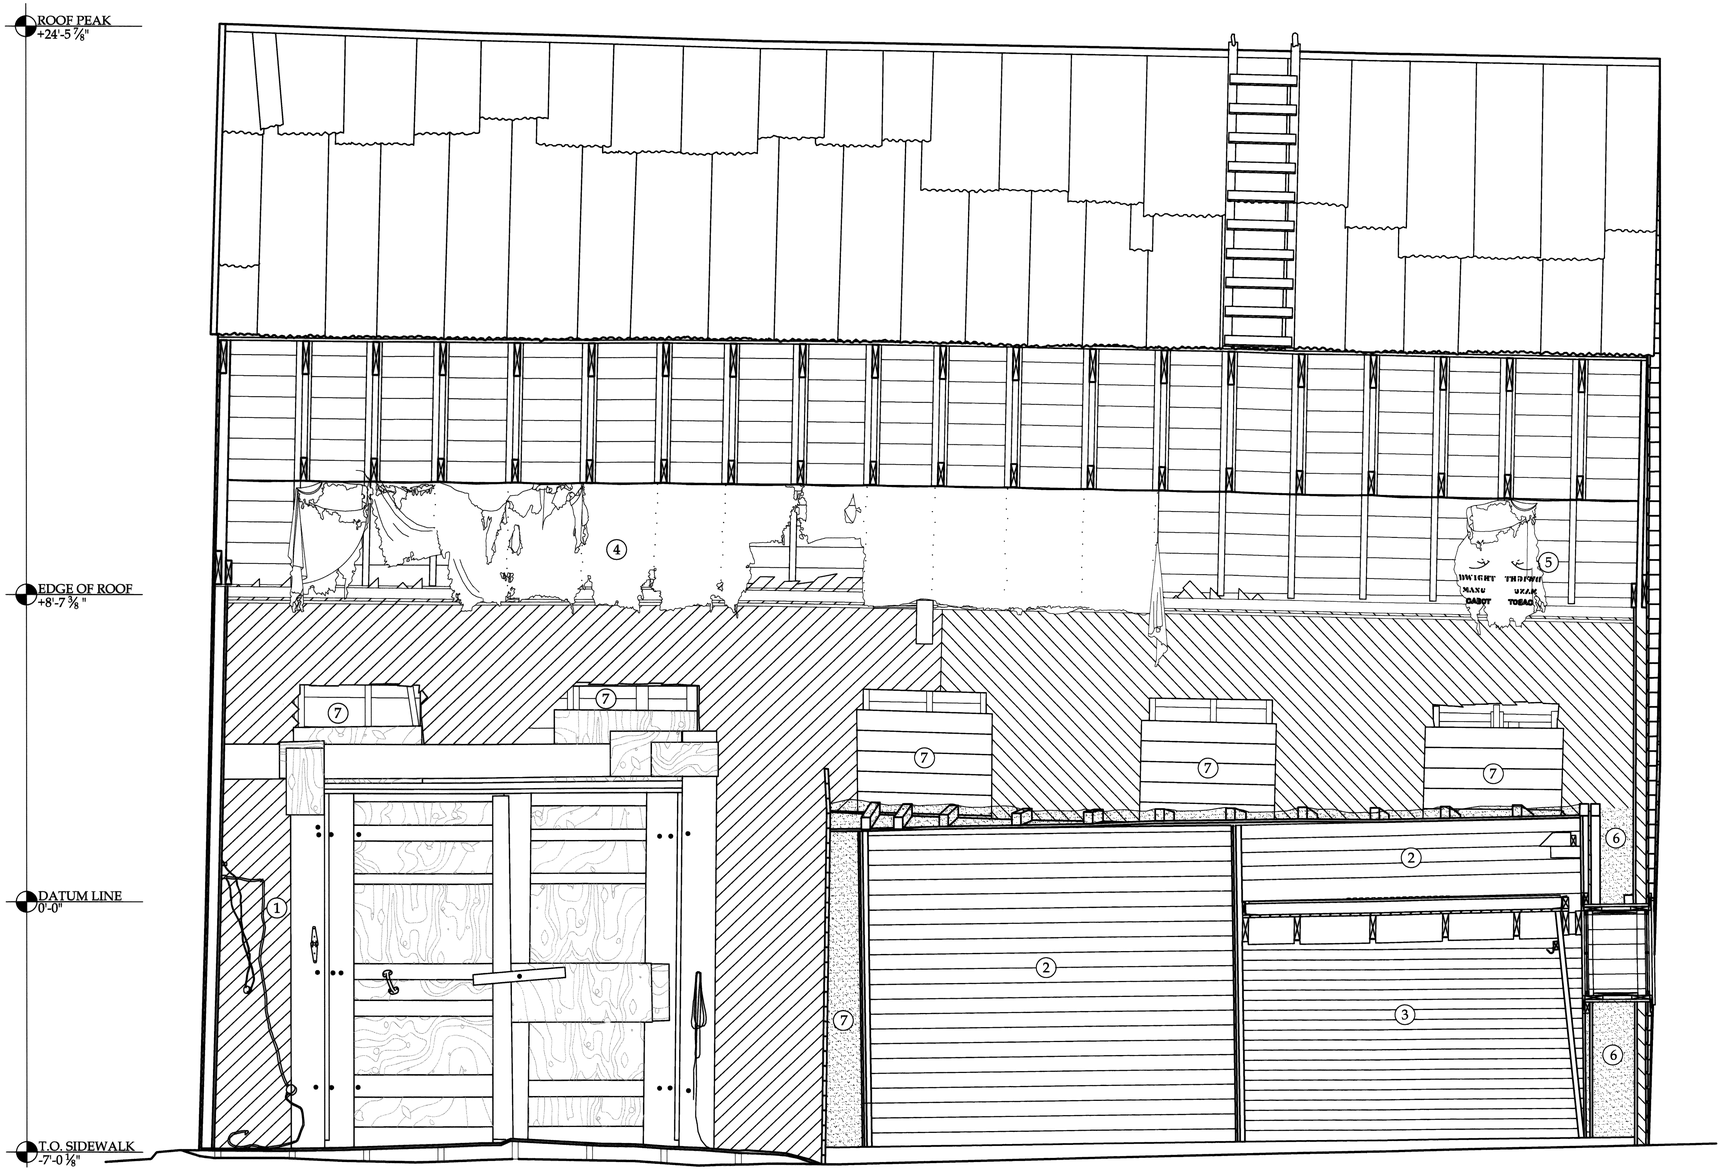

SECTION A-A

SCALE: 1/2" = 1' - 0"

0 1' 2' 4' FEET

0 .25 0.5 1 METERS

MATERIAL NOTES

1. INSULATED ELECTRICAL WIRING
2. 7/8" x 6 7/8" SHIPLAP
3. 7/8" x 3 3/8" TONGUE & GROOVE
4. PAINTED CANVAS, SEAMS EVERY 3'-0"
5. TEXT PAINTED ON CANVAS, "DWIGHT MANU CABOT"
6. SAWDUST INSULATION
7. 3'-1 7/8" x 3'-9 5/8" ROUGH OPENING OF WINDOWS VISIBLE IN 1903 PHOTOGRAPHS

DRAWN BY: REBECCA SHAFFER (2010) MICHELLE CHIRCOP (2012)

YMCA GMYNASIUM
NATIONAL PARK SERVICE
UNITED STATES DEPARTMENT OF THE INTERIOR

YMCA GMYNASIUM

KLONDIKE GOLD RUSH NATIONAL HISTORICAL PARK


SKAGWAY ALASKA

SURVEY NO. AK-229

HISTORIC AMERICAN BUILDINGS SURVEY
SHEET 14 OF 26 SHEETS

LIBRARY OF CONGRESS PRINTS & PHOTOGRAPHS

IF REPRODUCED, PLEASE CREDIT THE HISTORIC AMERICAN BUILDINGS SURVEY, NATIONAL PARK SERVICE, NAME OF DELINEATOR, DATE OF DRAWING

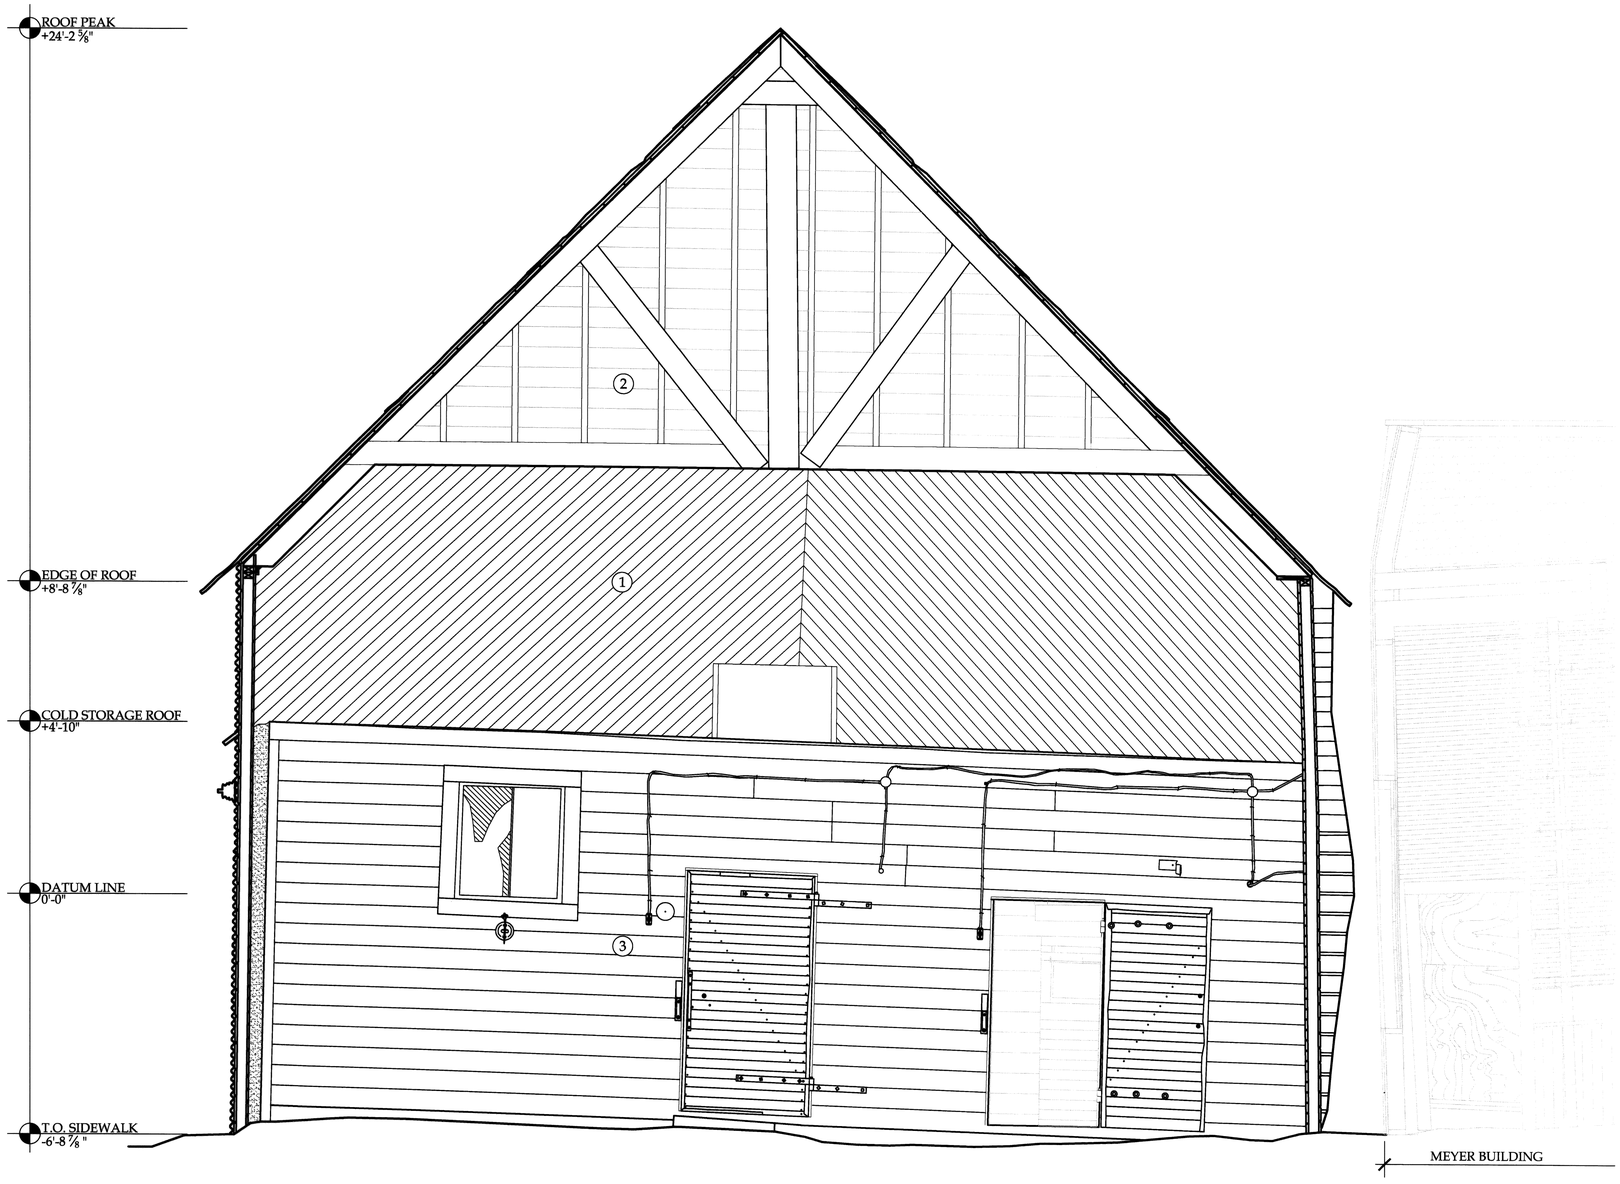

SECTION B-B

SCALE: ½" = 1' - 0"

0 1' 2' 4' FEET

0 .25 0.5 1 METERS

MATERIAL NOTES

① 7/8" x 3 3/8" TONGUE & GROOVE
② 3/4" x 5 1/4" DROP SIDING
③ 7/8" x 6 7/8" SHIPLAP

DRAWN BY: REBECCA SHAFFER (2010) MICHELLE CHIRCOP (2012)

YMCA GYMNASIUM
NATIONAL PARK SERVICE
UNITED STATES DEPARTMENT OF THE INTERIOR


YMCA GYMNASIUM
KLONDIKE GOLD RUSH NATIONAL HISTORICAL PARK
SKAGWAY ALASKA


SURVEY NO. AK-229

HISTORIC AMERICAN BUILDINGS SURVEY
SHEET 15 OF 26 SHEETS

LIBRARY OF CONGRESS PRINTS & PHOTOGRAPHS

IF REPRODUCED, PLEASE CREDIT THE HISTORIC AMERICAN BUILDINGS SURVEY, NATIONAL PARK SERVICE, NAME OF DELINEATOR, DATE OF DRAWING

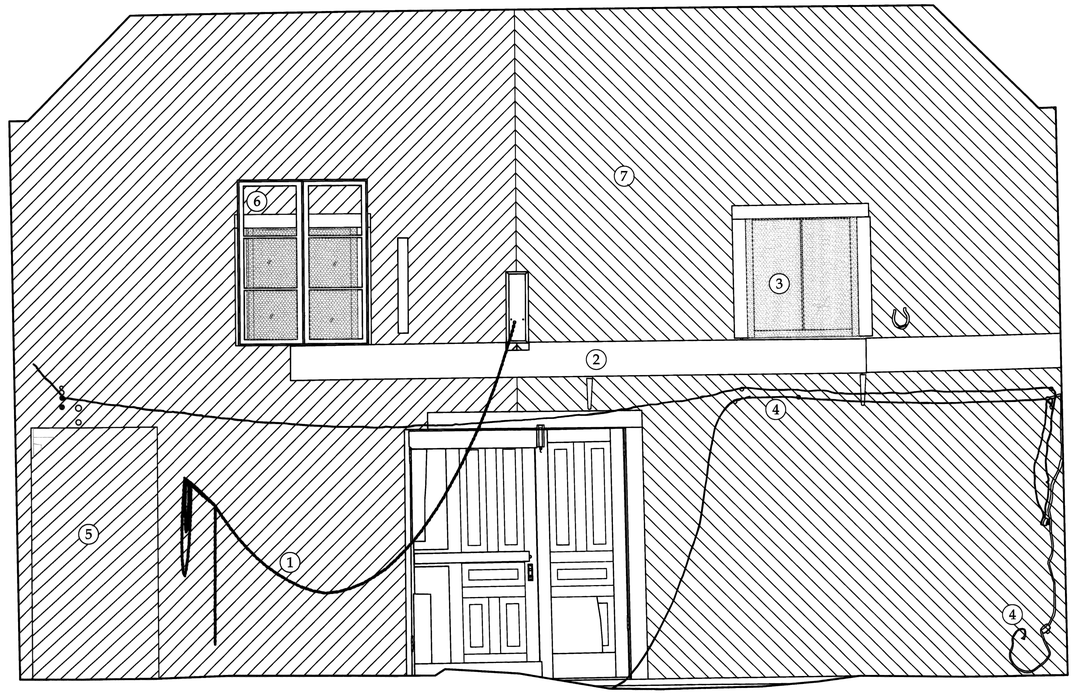

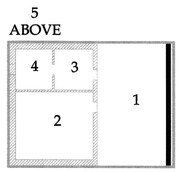

EAST INTERIOR ELEVATION

SCALE: ½" = 1' - 0"

0 1' 2' 4' FEET

0 .25 0.5 1 METERS

MATERIAL NOTES

1. ¼" DIAMETER STEEL CHAIN CONNECTED TO WOOD PLANK
2. 12" x 21'-6 ⅝" PLANK
3. CHICKEN WIRE, 1" HEXAGONAL MESH
4. INSULATED ELECTRICAL WIRES
5. DOOR PATCH
6. WINDOWS WITH AFFIXED LABEL "SINGLE STRENGTH B QUALITY FLAT DRAWN AMERICAN WINDOW GLASS CO PITTSBURGH, PA U.S.A"
7. ⅞" x 3 ⅜" TONGUE & GROOVE

DRAWN BY: REBECCA SHAFFER (2010) MICHELLE CHIRCOP (2012)

YMCA GYMNASIUM
NATIONAL PARK SERVICE
UNITED STATES DEPARTMENT OF THE INTERIOR

YMCA GYMNASIUM


KLONDIKE GOLD RUSH NATIONAL HISTORICAL PARK

SKAGWAY ALASKA


SURVEY NO. AK-229

HISTORIC AMERICAN BUILDINGS SURVEY
SHEET 16 OF 26 SHEETS

IF REPRODUCED, PLEASE CREDIT THE HISTORIC AMERICAN BUILDINGS SURVEY, NATIONAL PARK SERVICE, NAME OF DELINEATOR, DATE OF DRAWING

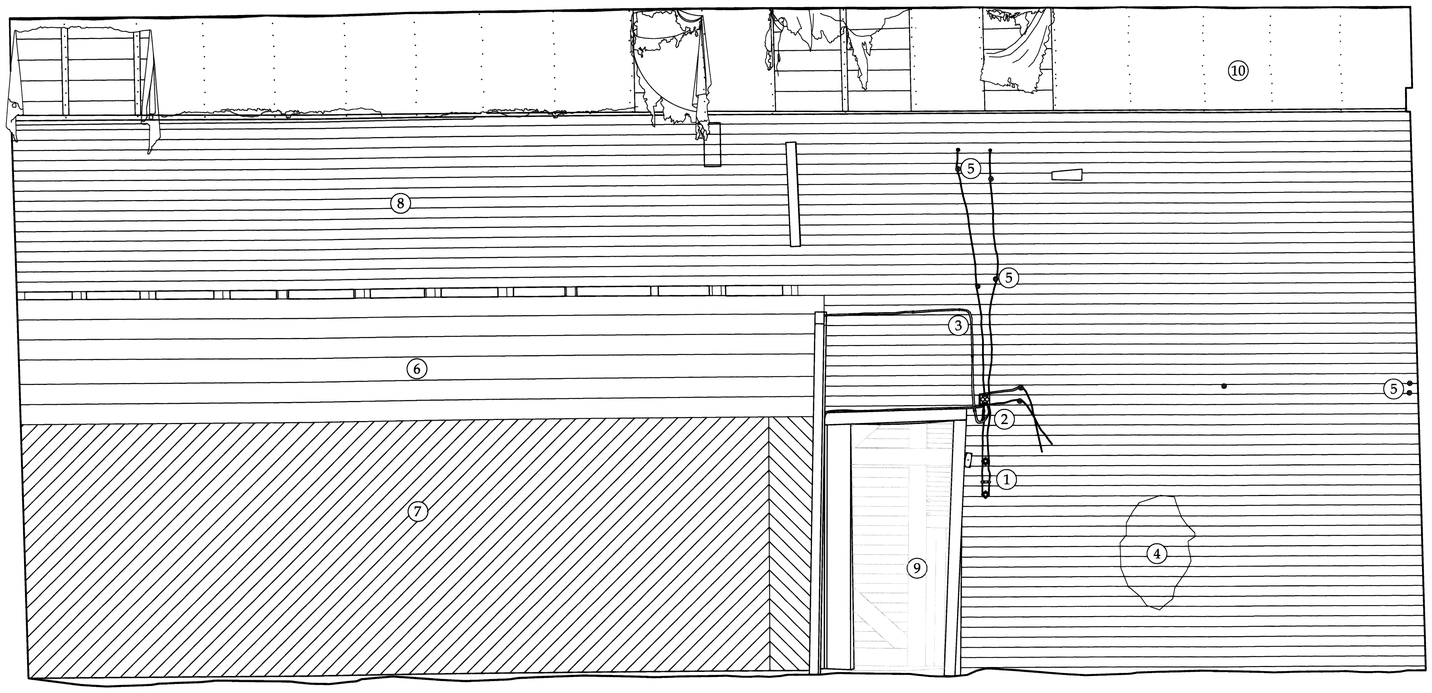

5
ABOVE

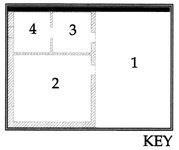

KEY

NORTH INTERIOR ELEVATION

SCALE: ½" = 1' - 0"

0 1' 2' 4' FEET

0 .25 0.5 1 METERS

MATERIAL NOTES

1. CERAMIC LIGHT SOCKETS
2. ELECTRICAL FUSES
3. INSULATED ELECTRICAL WIRING
4. PAINT MARK ON PANELING
5. CERAMIC WIRE INSULATORS
6. 1" x 6 ¾" BOARDS
7. ⅞" x 3 ⅜" TONGUE & GROOVE BOARDS IN ORIGINAL CONFIGURATION
8. ⅞" x 3 ⅜" TONGUE & GROOVE (REUSED)
9. PASSAGEWAY TO MEYER BUILDING
10. PAINTED CANVAS, SEAMS EVERY 3'-0". TACK LINES AT CEILING JOISTS AT 24" ON CENTER

DRAWN BY: REBECCA SHAFFER (2010) MICHELLE CHIRCOP (2012)

YMCA GYMNASIUM
NATIONAL PARK SERVICE
UNITED STATES DEPARTMENT OF THE INTERIOR

YMCA GYMNASIUM

KLONDIKE GOLD RUSH NATIONAL HISTORICAL PARK


SKAGWAY ALASKA

SURVEY NO. AK-229

HISTORIC AMERICAN BUILDINGS SURVEY
SHEET 17 OF 26 SHEETS

DEPARTMENT OF THE INTERIOR
NPS

IF REPRODUCED, PLEASE CREDIT THE HISTORIC AMERICAN BUILDINGS SURVEY, NATIONAL PARK SERVICE, NAME OF DELINEATOR, DATE OF DRAWING

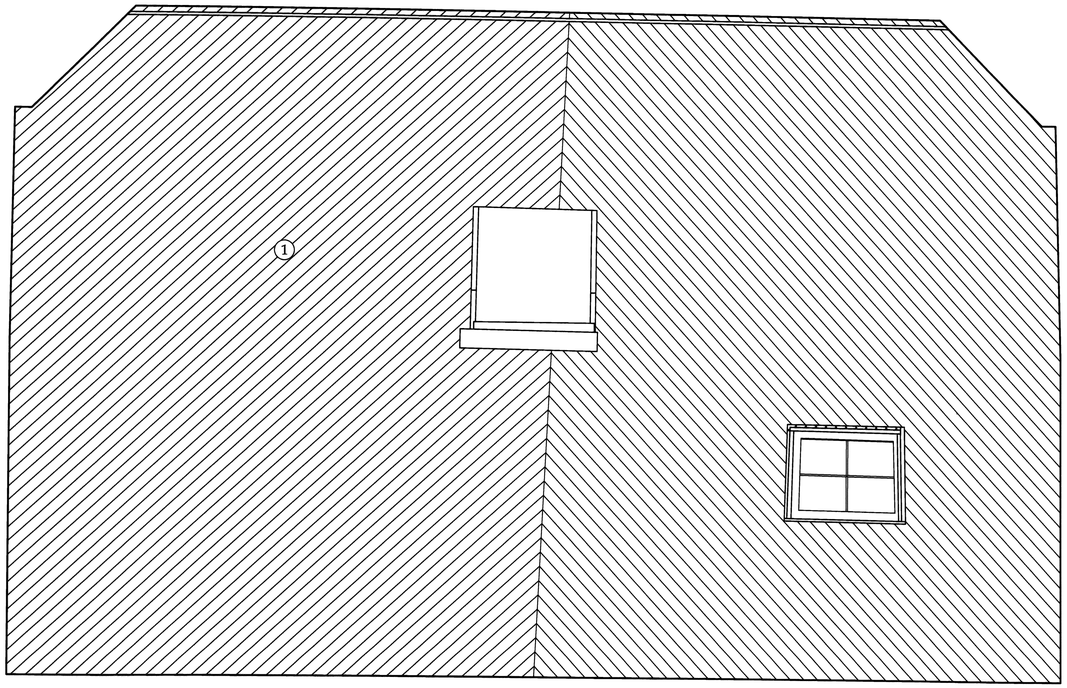

WEST INTERIOR ELEVATION

SCALE: ½" = 1' - 0"


0 1' 2' 4' FEET

0 .25 0.5 1 METERS

MATERIAL NOTES

① ⅞" x 3⅜" TONGUE & GROOVE

5
ABOVE

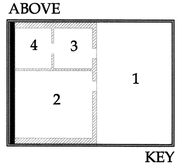

KEY

DRAWN BY: REBECCA SHAFFER (2010) MICHELLE CHIRCOP (2012)


YMCA GYMNASIUM
KLONDIKE GOLD RUSH NATIONAL HISTORICAL PARK
SKAGWAY ALASKA

YMCA GYMNASIUM
NATIONAL PARK SERVICE
UNITED STATES DEPARTMENT OF THE INTERIOR


SURVEY NO. AK-229

HISTORIC AMERICAN BUILDINGS SURVEY
SHEET 18 OF 26 SHEETS

IF REPRODUCED, PLEASE CREDIT THE HISTORIC AMERICAN BUILDINGS SURVEY, NATIONAL PARK SERVICE, NAME OF DELINEATOR, DATE OF DRAWING

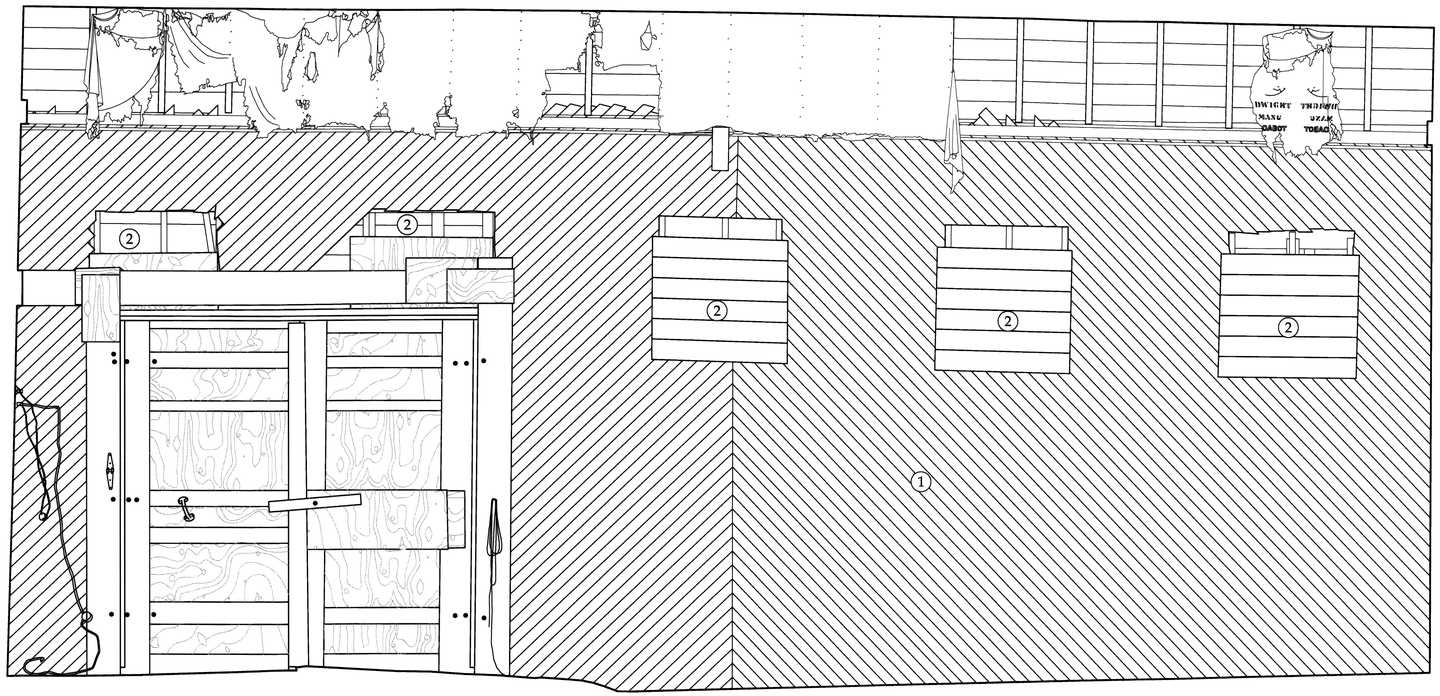

5
ABOVE

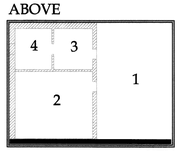

KEY

SOUTH INTERIOR ELEVATION

SCALE: ½" = 1' - 0"

0 1' 2' 4' FEET

0 .25 0.5 1 METERS

MATERIAL NOTES

① ⅞" x 3 ⅜" TONGUE & GROOVE

② 3'-1 ⅞" x 3'-9 ⅝" ROUGH OPENING OF WINDOWS VISIBLE IN 1903 PHOTOGRAPHS

DRAWN BY: REBECCA SHAFFER (2010) MICHELLE CHIRCOP (2012)

YMCA GYMNASIUM
NATIONAL PARK SERVICE
UNITED STATES DEPARTMENT OF THE INTERIOR

YMCA GYMNASIUM

KLONDIKE GOLD RUSH NATIONAL HISTORICAL PARK


SKAGWAY ALASKA

SURVEY NO. AK-229

HISTORIC AMERICAN BUILDINGS SURVEY
SHEET 19 OF 26 SHEETS


LIBRARY OF CONGRESS
PRINTS & PHOTOGRAPHS


IF REPRODUCED, PLEASE CREDIT THE HISTORIC AMERICAN BUILDINGS SURVEY, NATIONAL PARK SERVICE, NAME OF DELINEATOR, DATE OF DRAWING

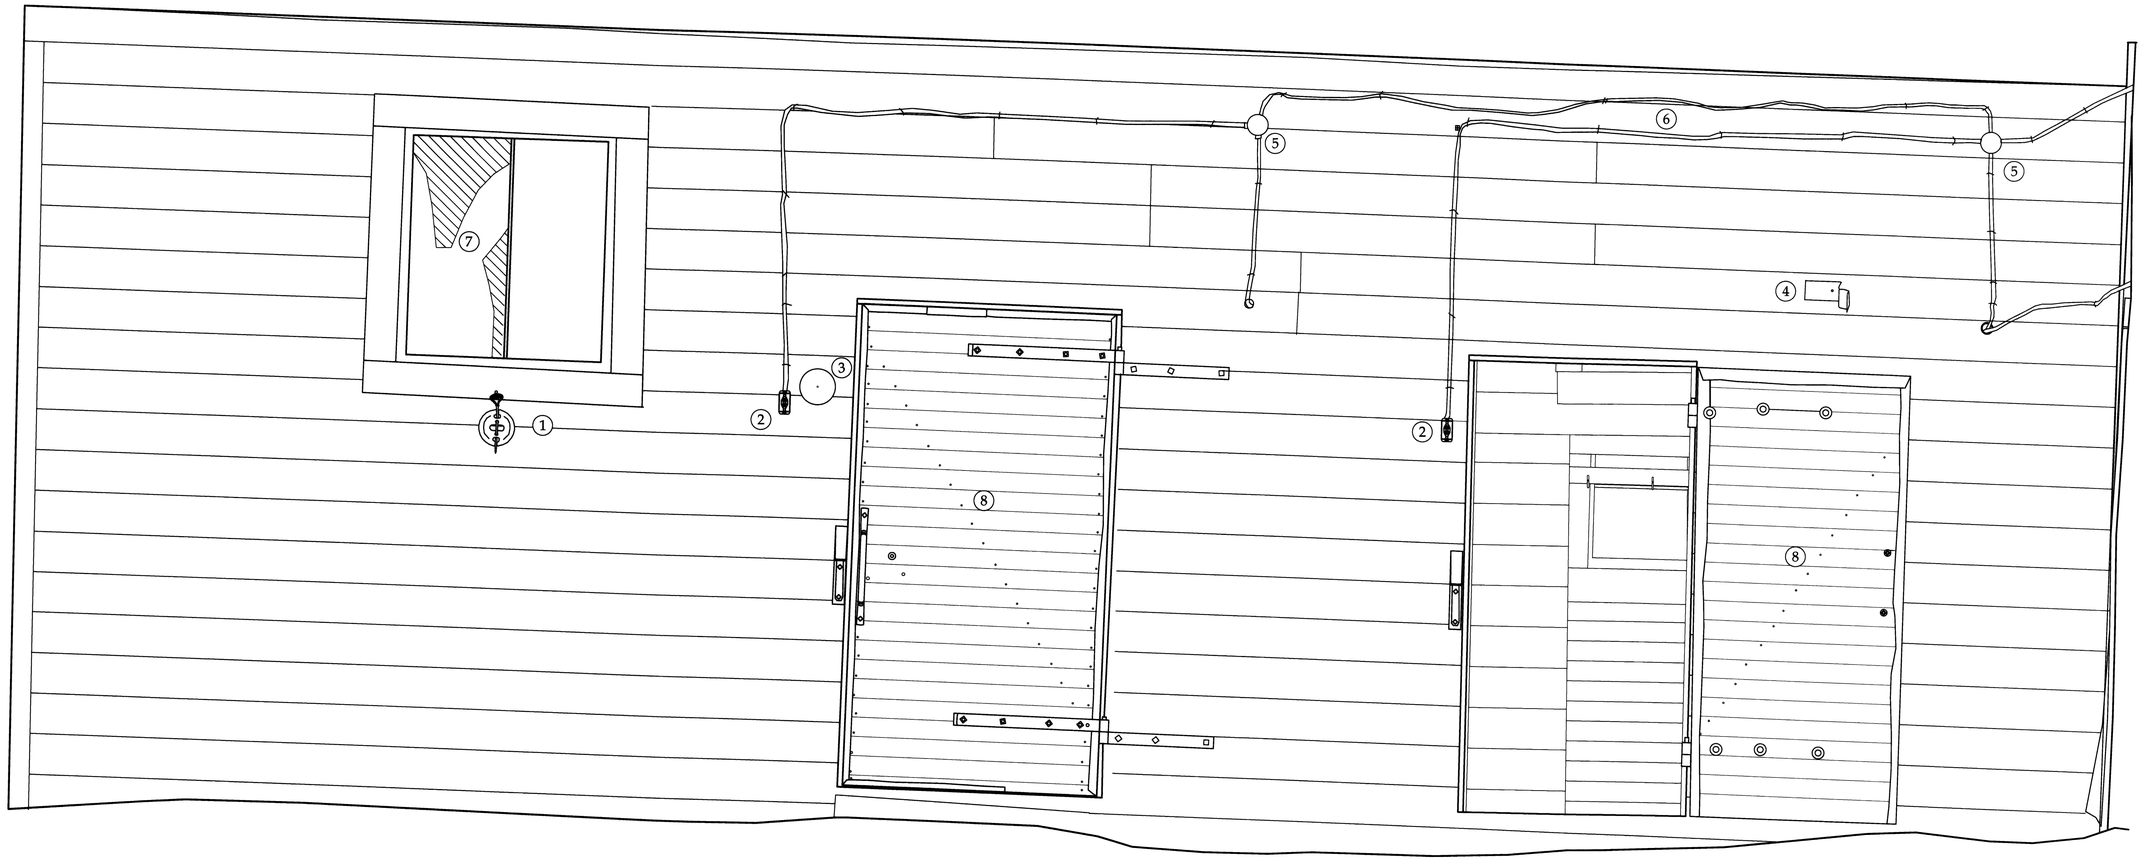

COLD STORAGE ELEVATION

SCALE: 1" = 1' - 0"

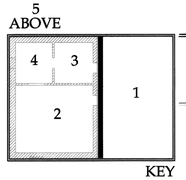

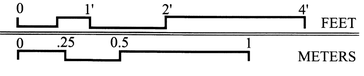

MATERIAL NOTES

1. CAST IRON STOVE PIPE DAMPER
2. PUSH BUTTON SWITCH
3. 6" DIA METAL WIRE SPOOL
4. METAL FLASHING REMNANT
5. ELECTRICAL JUNCTION BOXES
6. INSULATED ELECTRICAL WIRING
7. BROKEN GLASS
8. INSULATED DOOR

DRAWN BY: REBECCA SHAFFER (2010) MICHELLE CHIRCOP (2012)

YMCA GYMNASIUM
NATIONAL PARK SERVICE
UNITED STATES DEPARTMENT OF THE INTERIOR

YMCA GYMNASIUM

KLONDIKE GOLD RUSH NATIONAL HISTORICAL PARK


SKAGWAY ALASKA

SURVEY NO. AK-229


HISTORIC AMERICAN BUILDINGS SURVEY
SHEET 20 OF 26 SHEETS

LIBRARY OF CONGRESS PRINTS & PHOTOGRAPHS DIVISION

IF REPRODUCED, PLEASE CREDIT THE HISTORIC AMERICAN BUILDINGS SURVEY, NATIONAL PARK SERVICE, NAME OF DELINEATOR, DATE OF DRAWING

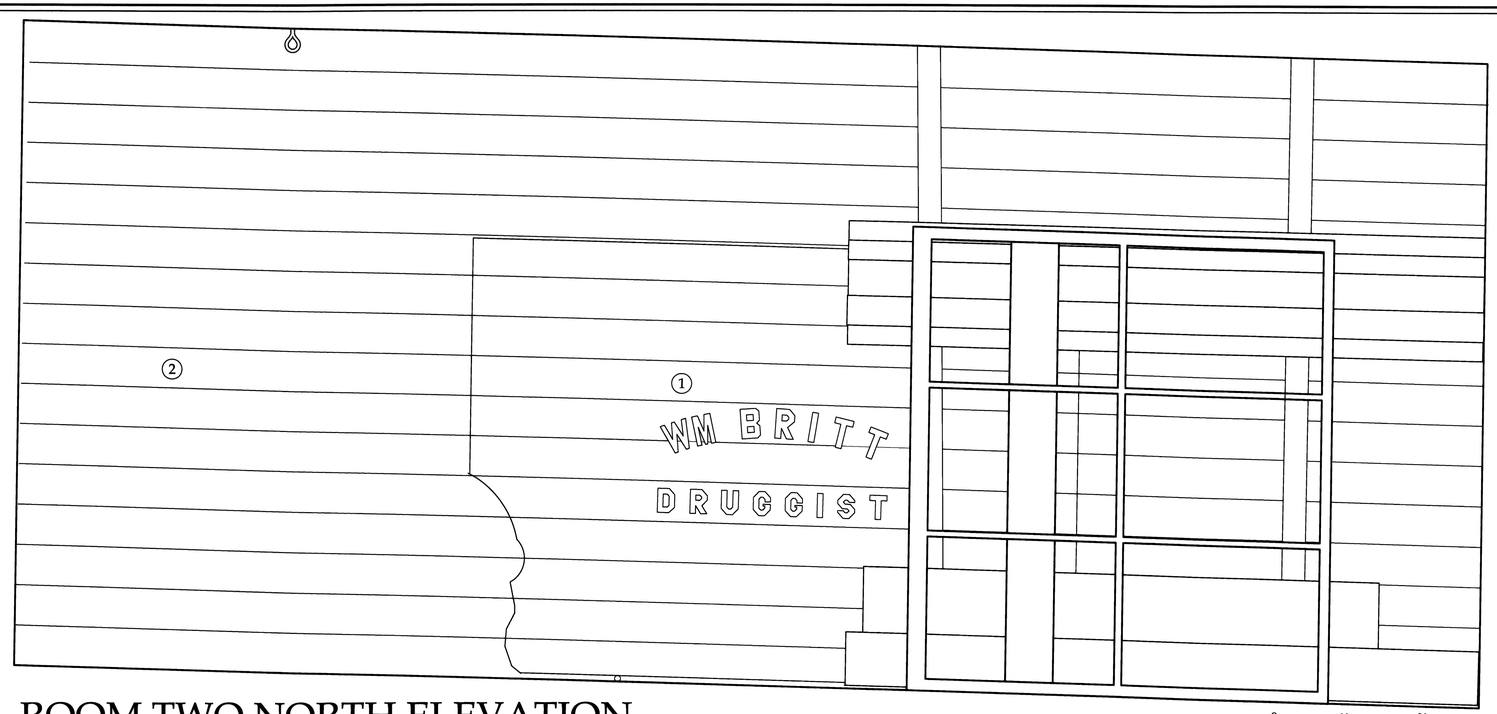

5
ABOVE

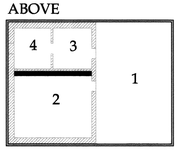


KEY

ROOM TWO NORTH ELEVATION


SCALE: 1" = 1' - 0"

0 1' 2' 4' FEET

0 .25 0.5 1 METERS

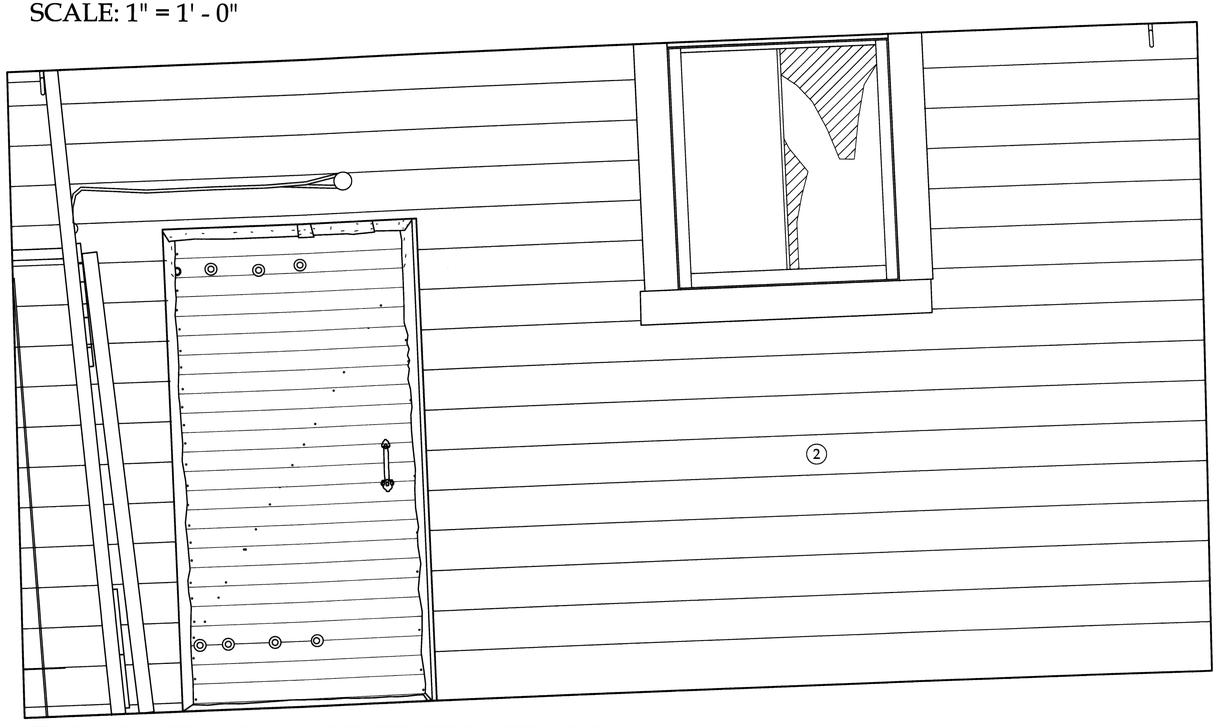

5
ABOVE

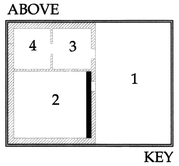

KEY

MATERIAL NOTES

1. PLATE GLASS WINDOW
2. 7/8" x 6 7/8" SHIPLAP

ROOM TWO EAST ELEVATION

SCALE: 1" = 1' - 0"

0 1' 2' 4' FEET

0 .25 0.5 1 METERS

DRAWN BY: REBECCA SHAFFER (2010) MICHELLE CHIRCOP (2012)

YMCA GYMNASIUM
NATIONAL PARK SERVICE
UNITED STATES DEPARTMENT OF THE INTERIOR


YMCA GYMNASIUM
KLONDIKE GOLD RUSH NATIONAL HISTORICAL PARK
SKAGWAY ALASKA


SURVEY NO. AK-229

HISTORIC AMERICAN BUILDINGS SURVEY
SHEET 21 OF 26 SHEETS

LIBRARY OF CONGRESS PRINTS & PHOTOGRAPHS

IF REPRODUCED, PLEASE CREDIT THE HISTORIC AMERICAN BUILDINGS SURVEY, NATIONAL PARK SERVICE, NAME OF DELINEATOR, DATE OF DRAWING

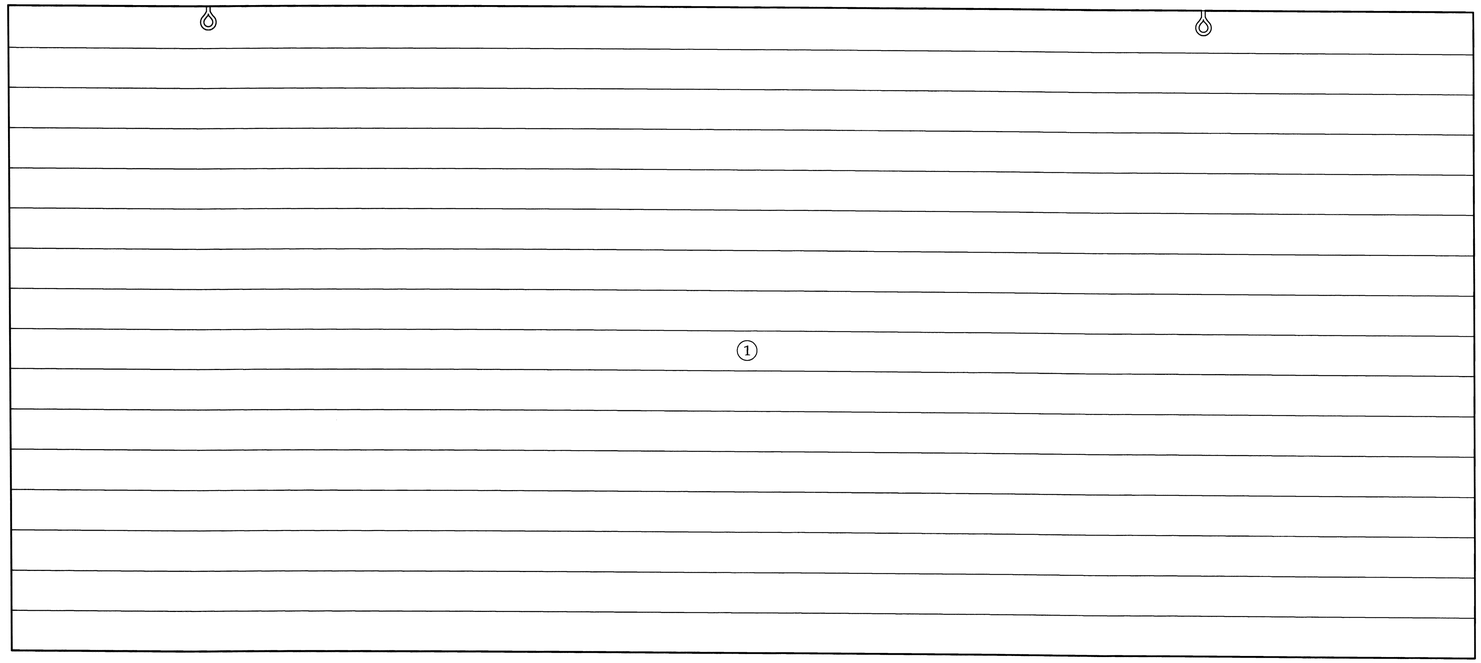

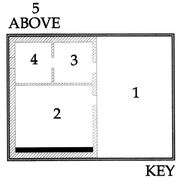



ROOM TWO SOUTH ELEVATION

SCALE: 1" = 1' - 0"

0 1' 2' 4' FEET

0 .25 0.5 1 METERS

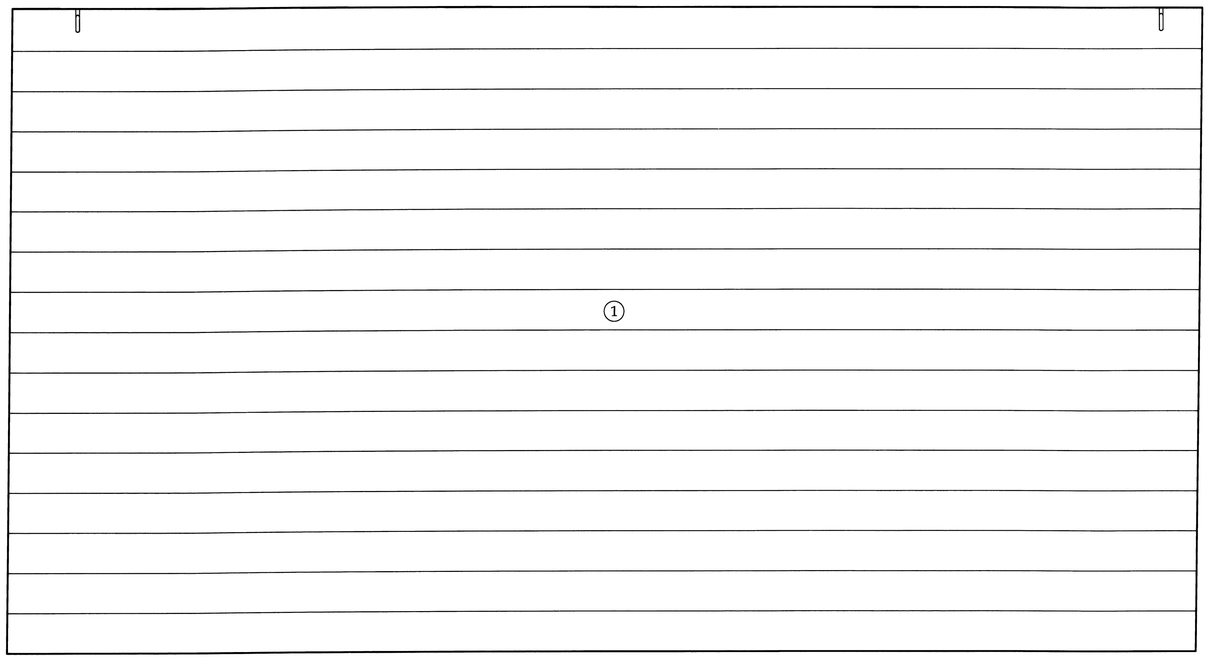

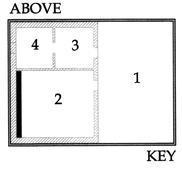

ROOM TWO WEST ELEVATION

SCALE: 1" = 1' - 0"

0 1' 2' 4' FEET

0 .25 0.5 1 METERS

MATERIAL NOTES

① 7/8" x 6 7/8" SHIPLAP

DRAWN BY: REBECCA SHAFFER (2010) MICHELLE CHIRCOP (2012)

YMCA GYMNASIUM
NATIONAL PARK SERVICE
UNITED STATES DEPARTMENT OF THE INTERIOR


YMCA GYMNASIUM
KLONDIKE GOLD RUSH NATIONAL HISTORICAL PARK
SKAGWAY ALASKA

SURVEY NO. AK-229


HISTORIC AMERICAN BUILDINGS SURVEY
SHEET 22 OF 26 SHEETS

LIBRARY OF CONGRESS PRINTS & PHOTOGRAPHS DIVISION

IF REPRODUCED, PLEASE CREDIT THE HISTORIC AMERICAN BUILDINGS SURVEY, NATIONAL PARK SERVICE, NAME OF DELINEATOR, DATE OF DRAWING

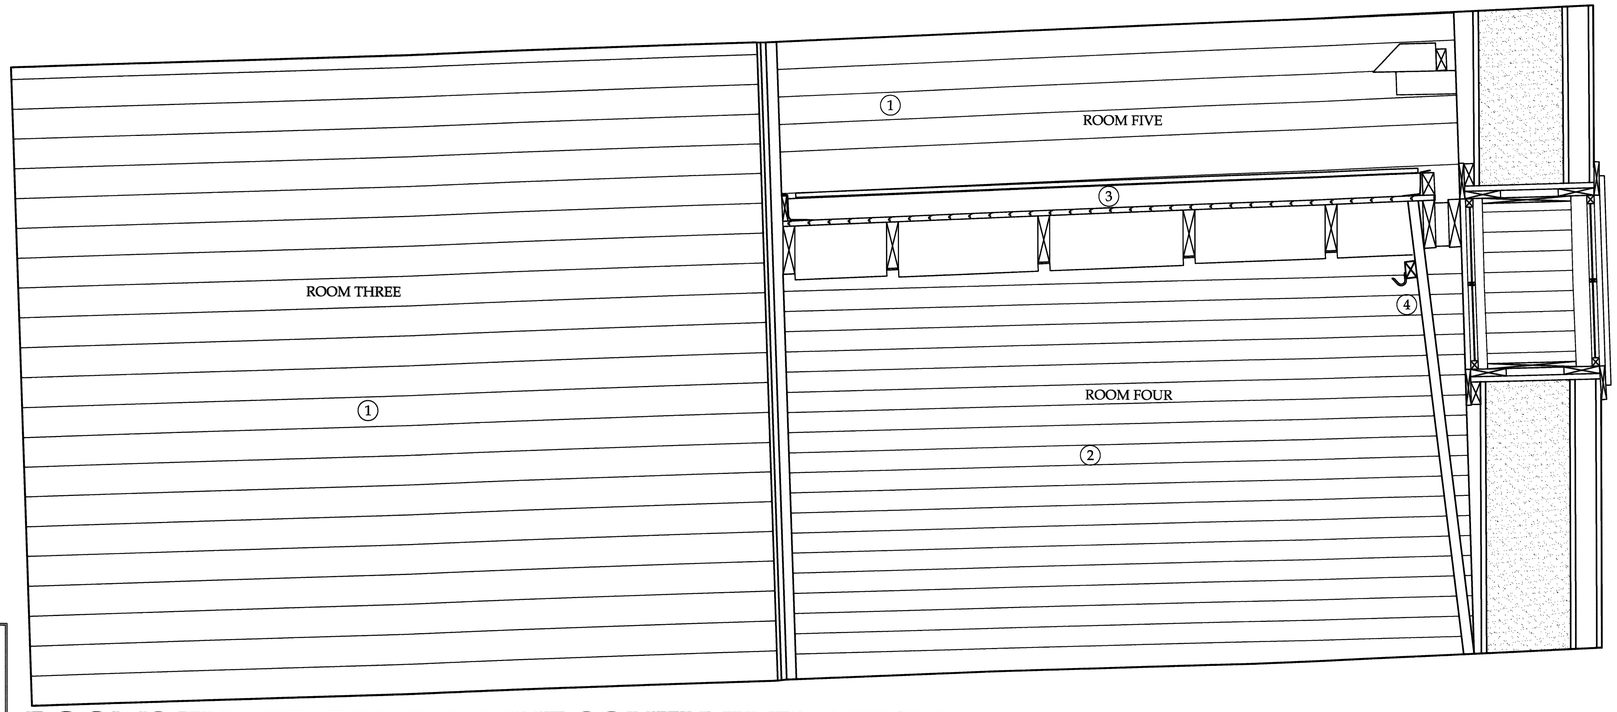

5
ABOVE

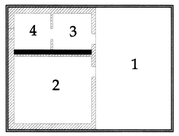


KEY

ROOMS THREE, FOUR & FIVE SOUTH ELEVATION


SCALE: 1" = 1' - 0"

0 1' 2' 4' FEET

0 .25 0.5 1 METERS

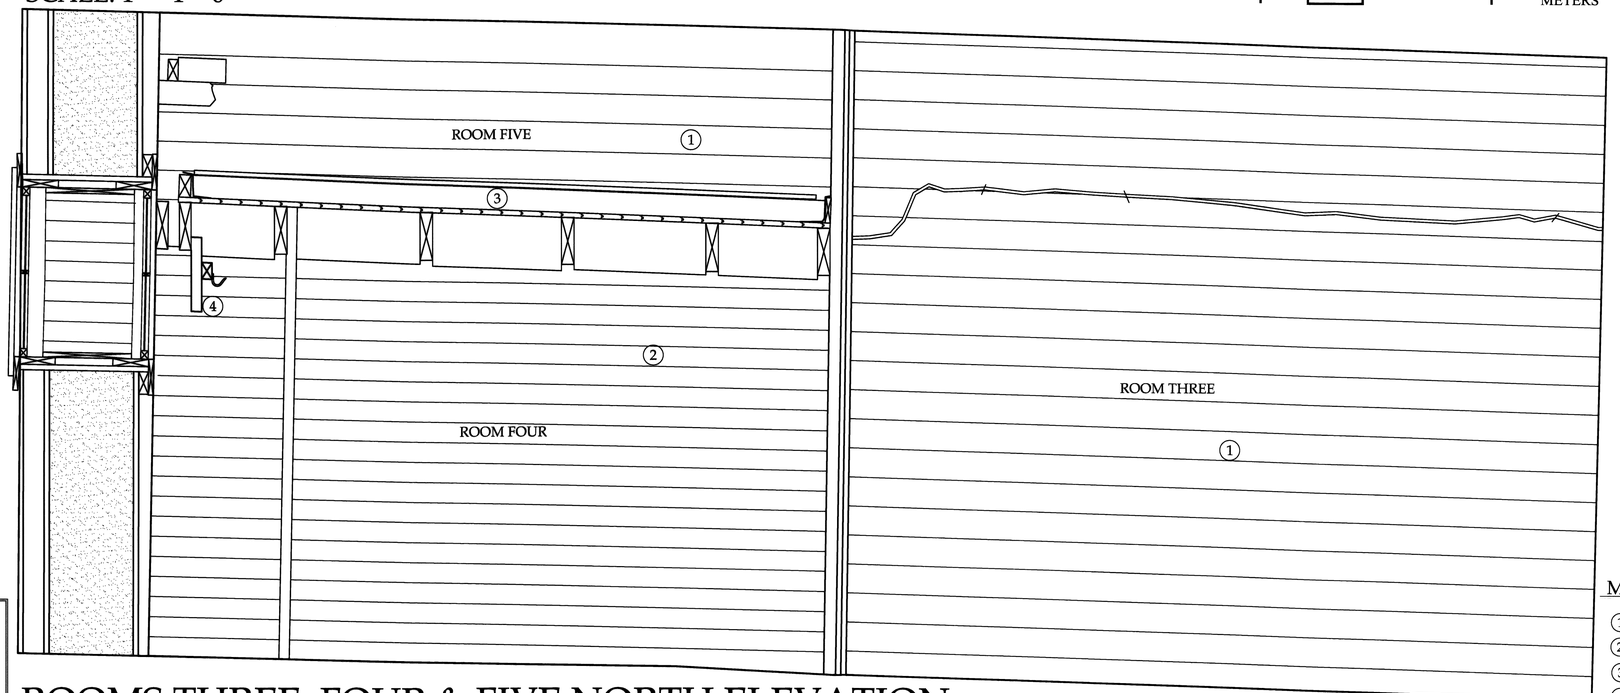

5
ABOVE

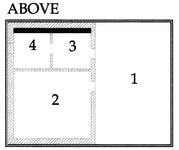

KEY

ROOMS THREE, FOUR & FIVE NORTH ELEVATION

SCALE: 1" = 1' - 0"

0 1' 2' 4' FEET

0 .25 0.5 1 METERS

MATERIAL NOTES

1. 7/8" x 6 7/8" SHIPLAP
2. 7/8" x 3 3/8" TONGUE & GROOVE
3. ICE RACK
4. MEAT RACK

DRAWN BY: REBECCA SHAFFER (2010) MICHELLE CHIRCOP (2012)

YMCA GYMNASIUM
NATIONAL PARK SERVICE
UNITED STATES DEPARTMENT OF THE INTERIOR

YMCA GYMNASIUM

KLONDIKE GOLD RUSH NATIONAL HISTORICAL PARK


SKAGWAY ALASKA

SURVEY NO. AK-229


HISTORIC AMERICAN BUILDINGS SURVEY
SHEET 23 OF 26 SHEETS

LIBRARY OF CONGRESS PRINTS & PHOTOGRAPHS

IF REPRODUCED, PLEASE CREDIT THE HISTORIC AMERICAN BUILDINGS SURVEY, NATIONAL PARK SERVICE, NAME OF DELINEATOR, DATE OF DRAWING

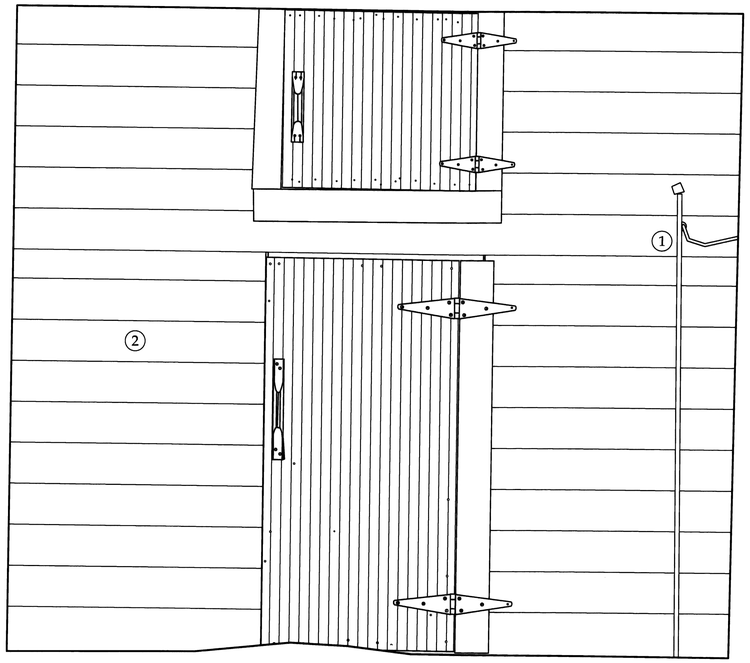

5
ABOVE

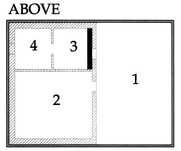


KEY

ROOM THREE EAST ELEVATION


SCALE: 1" = 1' - 0"

MATERIAL NOTES

1. STEEL DRAIN PIPE
2. 7/8" x 6 7/8" SHIPLAP
3. CERAMIC LIGHT SOCKET
4. 7/8" x 5" SHIPLAP

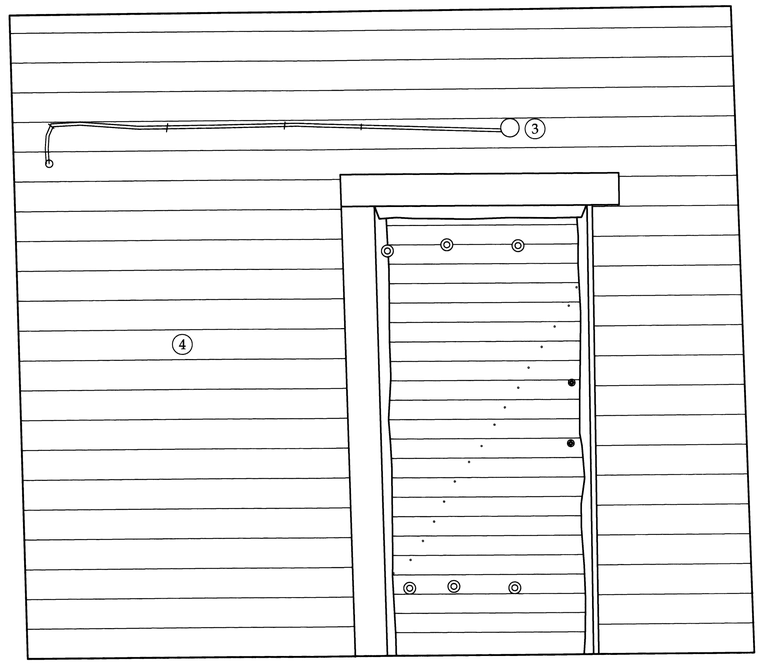

5
ABOVE

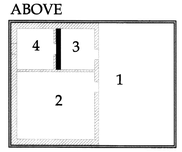

KEY

ROOM THREE WEST ELEVATION

SCALE: 1" = 1' - 0"

0 1' 2' 4' FEET

0 .25 0.5 1 METERS

DRAWN BY: REBECCA SHAFFER (2010) MICHELLE CHIRCOP (2012)

YMCA GYMNASIUM
NATIONAL PARK SERVICE
UNITED STATES DEPARTMENT OF THE INTERIOR


YMCA GYMNASIUM
KLONDIKE GOLD RUSH NATIONAL HISTORICAL PARK
SKAGWAY ALASKA


SURVEY NO. AK-229


HISTORIC AMERICAN BUILDINGS SURVEY
SHEET 24 OF 26 SHEETS

LIBRARY OF CONGRESS PRINTS & PHOTOGRAPHS

IF REPRODUCED, PLEASE CREDIT THE HISTORIC AMERICAN BUILDINGS SURVEY, NATIONAL PARK SERVICE, NAME OF DELINEATOR, DATE OF DRAWING

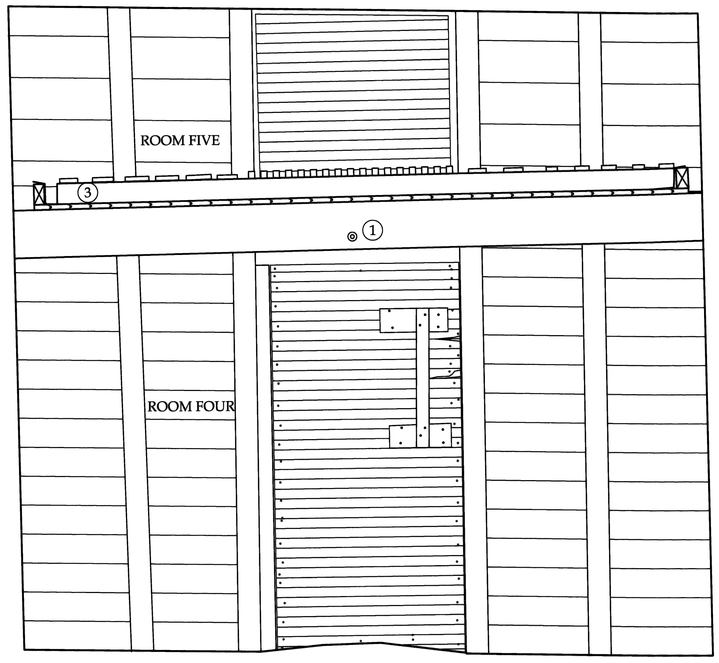

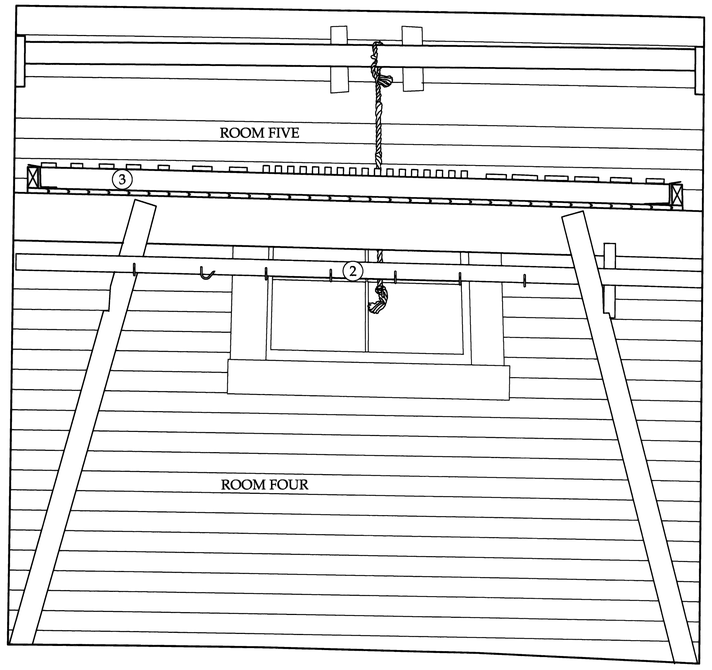


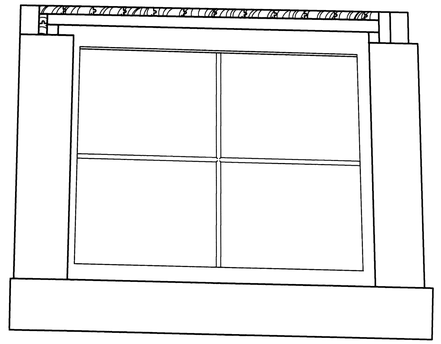

COLD STORAGE WINDOW


SCALE: 1-½" = 1' - 0"

5 ABOVE

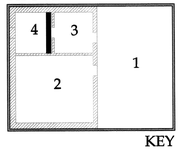


KEY

5 ABOVE

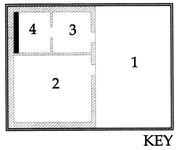

KEY

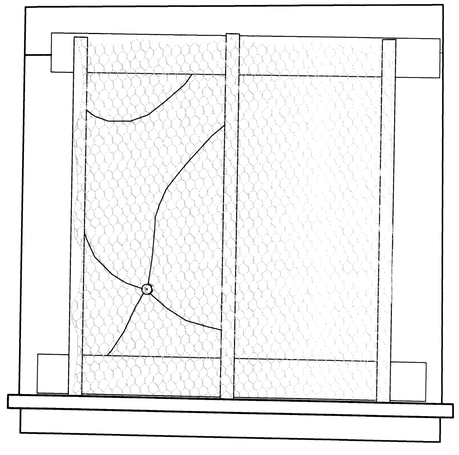

EAST ELEVATION WINDOW


SCALE: 1-½" = 1' - 0"

ROOMS FOUR & FIVE EAST ELEVATION

SCALE: 1" = 1' - 0"

ROOMS FOUR & FIVE WEST ELEVATION

SCALE: 1" = 1' - 0"

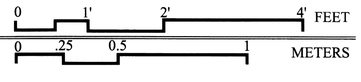

MATERIAL NOTES

① CERAMIC LIGHT SOCKET
② MEAT RACK
③ ICE RACK WITH METAL TRAY BELOW

DRAWN BY: REBECCA SHAFFER (2010) MICHELLE CHIRCOP (2012)

YMCA GYMNASIUM
NATIONAL PARK SERVICE
UNITED STATES DEPARTMENT OF THE INTERIOR


YMCA GYMNASIUM
KLONDIKE GOLD RUSH NATIONAL HISTORICAL PARK
SKAGWAY ALASKA

SURVEY NO. AK-229

HISTORIC AMERICAN BUILDINGS SURVEY
SHEET 25 OF 26 SHEETS

LIBRARY OF CONGRESS PRINTS AND PHOTOGRAPHS


IF REPRODUCED, PLEASE CREDIT THE HISTORIC AMERICAN BUILDINGS SURVEY, NATIONAL PARK SERVICE, NAME OF INSTIGATOR, DATE OF DRAWING

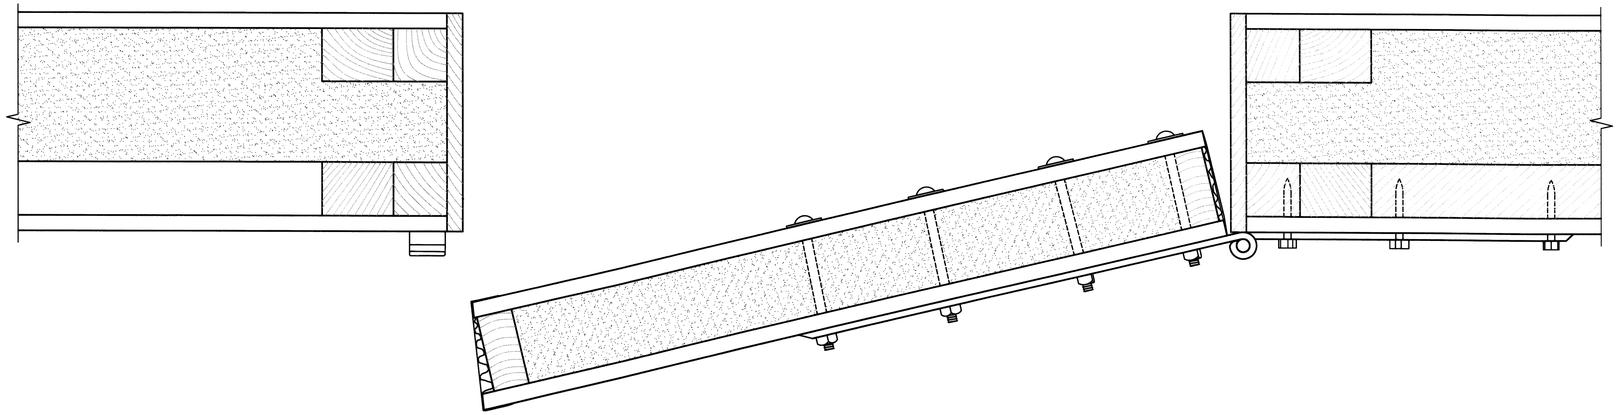

INSULATED DOOR ASSEMBLY

SCALE: 3" = 1' - 0"


0 1½" 3" 6" INCHES
0 4 12 CENTIMETERS

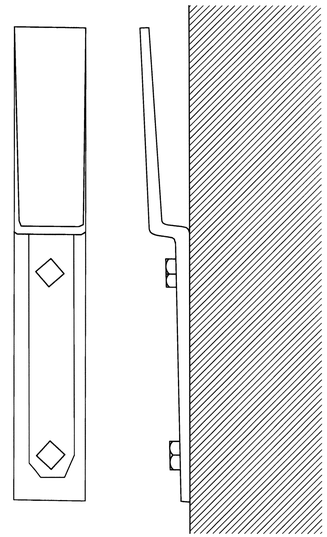

DOOR LATCH

SCALE:6" = 1' - 0"

0 ½" 1" 2" INCHES
0 1 2 4 6 CENTIMETERS

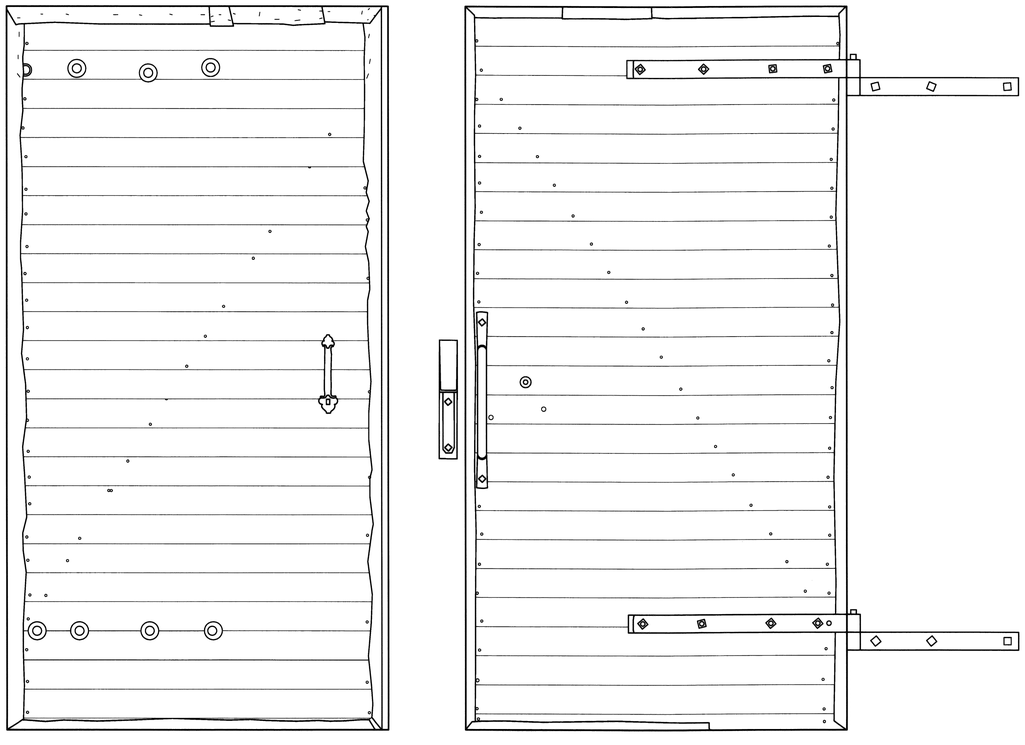


INTERIOR EXTERIOR

INSULATED DOOR ELEVATIONS

SCALE: 1 ½" = 1' - 0"

0 3" 6" 12" INCHES
0 8 15 25 CENTIMETERS

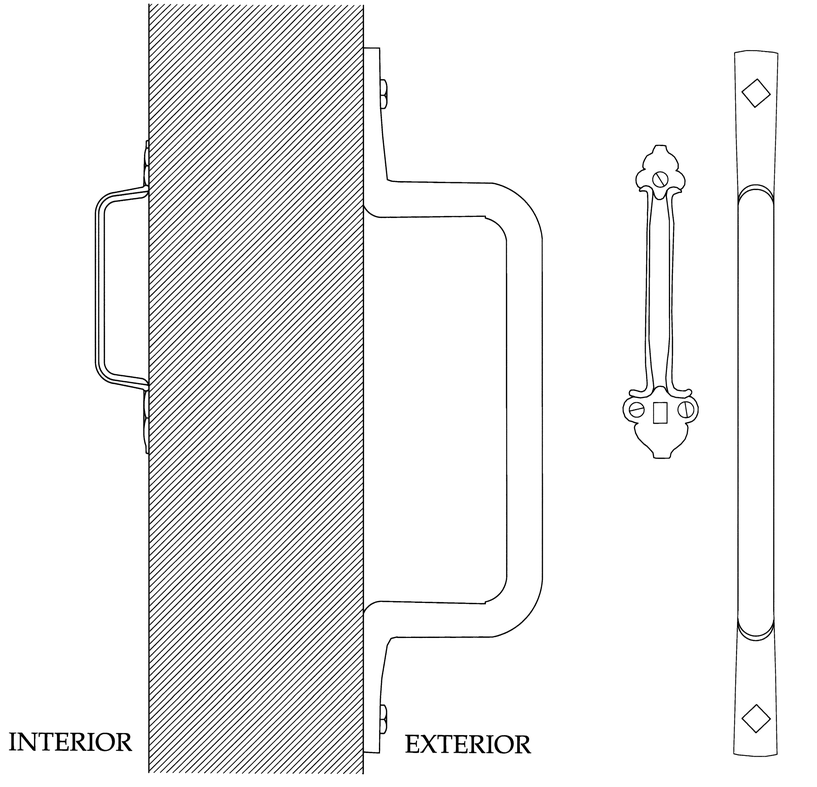

INTERIOR EXTERIOR

DOOR HANDLE PROFILES

SCALE:6" = 1' - 0"

0 ½" 1" 2" INCHES
0 1 2 4 6 CENTIMETERS

DRAWN BY: REBECCA SHAFFER (2010) MICHELLE CHIRCOP (2012)

YMCA GYMNASIUM
NATIONAL PARK SERVICE
UNITED STATES DEPARTMENT OF THE INTERIOR

YMCA GYMNASIUM

KLONDIKE GOLD RUSH NATIONAL HISTORICAL PARK
SKAGWAY ALASKA

SURVEY NO. AK-229

HISTORIC AMERICAN BUILDINGS SURVEY
SHEET 26 OF 26 SHEETS

LIBRARY OF CONGRESS PRINTS & PHOTOGRAPHS

IF REPRODUCED, PLEASE CREDIT THE HISTORIC AMERICAN BUILDINGS SURVEY, NATIONAL PARK SERVICE, NAME OF DELINEATOR, DATE OF DRAWING

HISTORIC AMERICAN BUILDINGS SURVEY

INDEX TO PHOTOGRAPHS

YMCA BUILDING HABS AK-229
(Young Men's Christian Association Building)
Klondike Gold Rush National Historical Park
~~Skagway Historic District and White Pass~~ Skagway and White Pass Historic District
475 State Street
Skagway
Skagway-Hoonah-Angoon Census Area
Alaska

INDEX TO BLACK AND WHITE PHOTOGRAPHS

Robert Lyon in October 2009, and Ron Klein in May 2010, photographers

AK-229-1	East elevation
AK-229-2	East and north elevations
AK-229-3	East and south elevations
AK-229-4	South elevation
AK-229-5	West and south elevations
AK-229-6	West and north elevations
AK-229-7	Interior south elevation
AK-229-8	Interior north elevation
AK-229-9	Interior east elevation
AK-229-10	Interior east elevation of cold storage lockers
AK-229-11	Interior east elevation of cold storage lockers
AK-229-12	South cold storage door closed
AK-229-13	North cold storage door closed
AK-229-14	North cold storage door open
AK-229-15	West elevation of interior south cold storage locker
AK-229-16	East elevation of interior south cold storage locker
AK-229-17	West elevation of interior of north cold storage locker

AK-229-18	View of interior of ice storage area, west elevation of north cold storage locker
AK-229-19	East elevation of interior of north cold storage locker
AK-229-20	Detail of lettering on cloth ceiling, above loft on south elevation, west end
AK-229-21	Interior west elevation of loft over cold storage locker
AK-229-22	Interior east elevation from loft
AK-229-23	Detail of wall and cloth ceiling
AK-229-24	Detail of wall and cloth ceiling


HAER AK-229-1
Kodak 400TMY-2



HABS AK-229-2.






HAER AK-229-3
Kodak 4000TMY-2



Kodak 400TMY-2

HABS AK-229-4





HABS AK-229-5 Kodak 400TMY-2






HAER AK-229-6
Kodak 400TMY-2
AREA 1




Kodak 400TMY-2
HABS AK-229-7



Kodak 400TMY-2





HABS AK-229-1

Kodak 400TMY-2



HABS AK-229-10

Kodak 400TMY-2




HABS AK-229-11
Kodak 400TMY-2




HABS AK-229-12
Kodak 400TMY-2



HABS AK-229-13






HABS AK-229-14
Kodak 400TMY-2



HABS AK-229-15



Kodak 400TMY-2




HABS AK-229-16
Kodak 400TMY-2



Kodak 400TMY-2

HABS AK-249-17





Kodak 400TMY-2



HABS AK-229-18




HABS AK-229-19
Kodak 400TMY-2



Kodak 400TMY-2

HABS AK-229-20



HABS AK-229-21
Kodak 400TMY-2



HABS AK-229-32



Kodak 400TMY-2



HABS AK-229-23

Kodak 400TMY-2




HABS AK-229-24
Kodak 400TMY-2

