


CIVILIAN CONSERVATION CORPS (CCC) CAMP NP-5-C,
BARRACKS NO. 5
(Jack Gray Warehouse)
Mesa Verde National Park
CCC Camp Historic District at Chapin Mesa
Cortez vicinity
Montezuma County
Colorado

HABS CO-198-A
HABS CO-198-A


REDUCED COPIES OF MEASURED DRAWINGS

HISTORIC AMERICAN BUILDINGS SURVEY
National Park Service
U.S. Department of the Interior
1849 C Street NW
Washington, DC 20240-0001

CIVILIAN CONSERVATION CORPS (CCC) CAMP NP-5-C, BARRACKS #5 MESA VERDE NATIONAL PARK

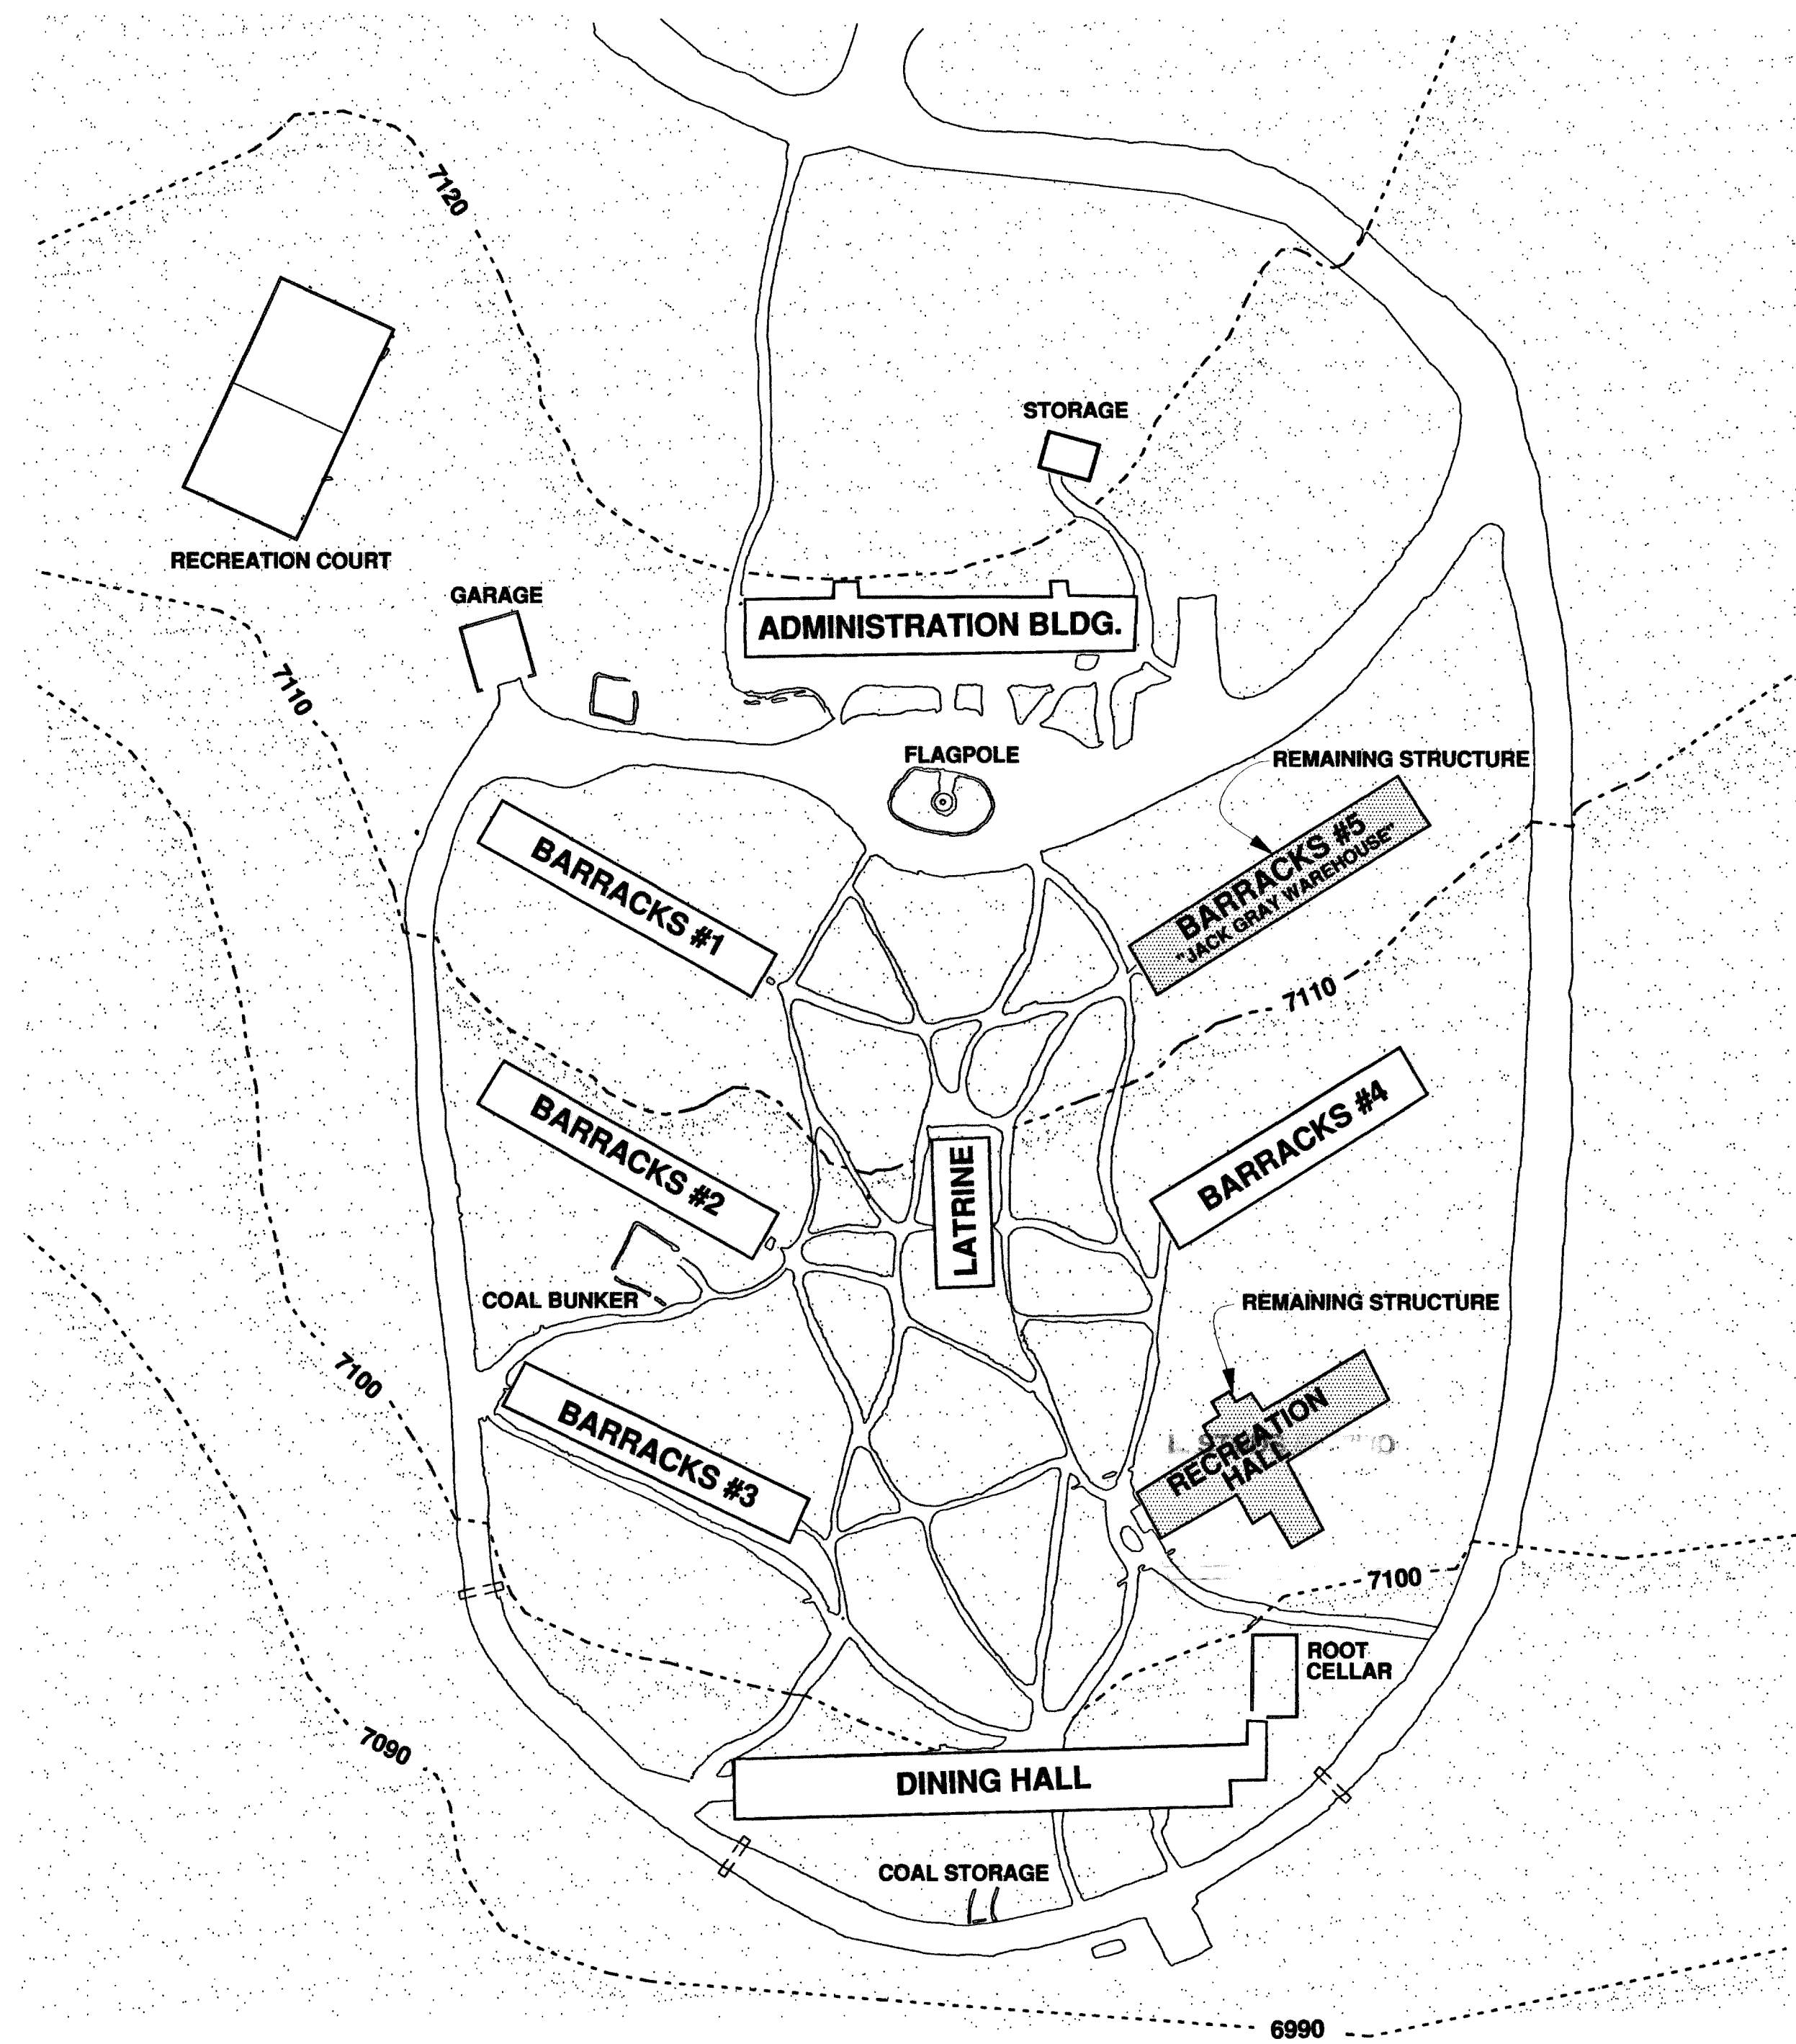

HISTORIC SITE PLAN
CCC CAMP NP-5-C

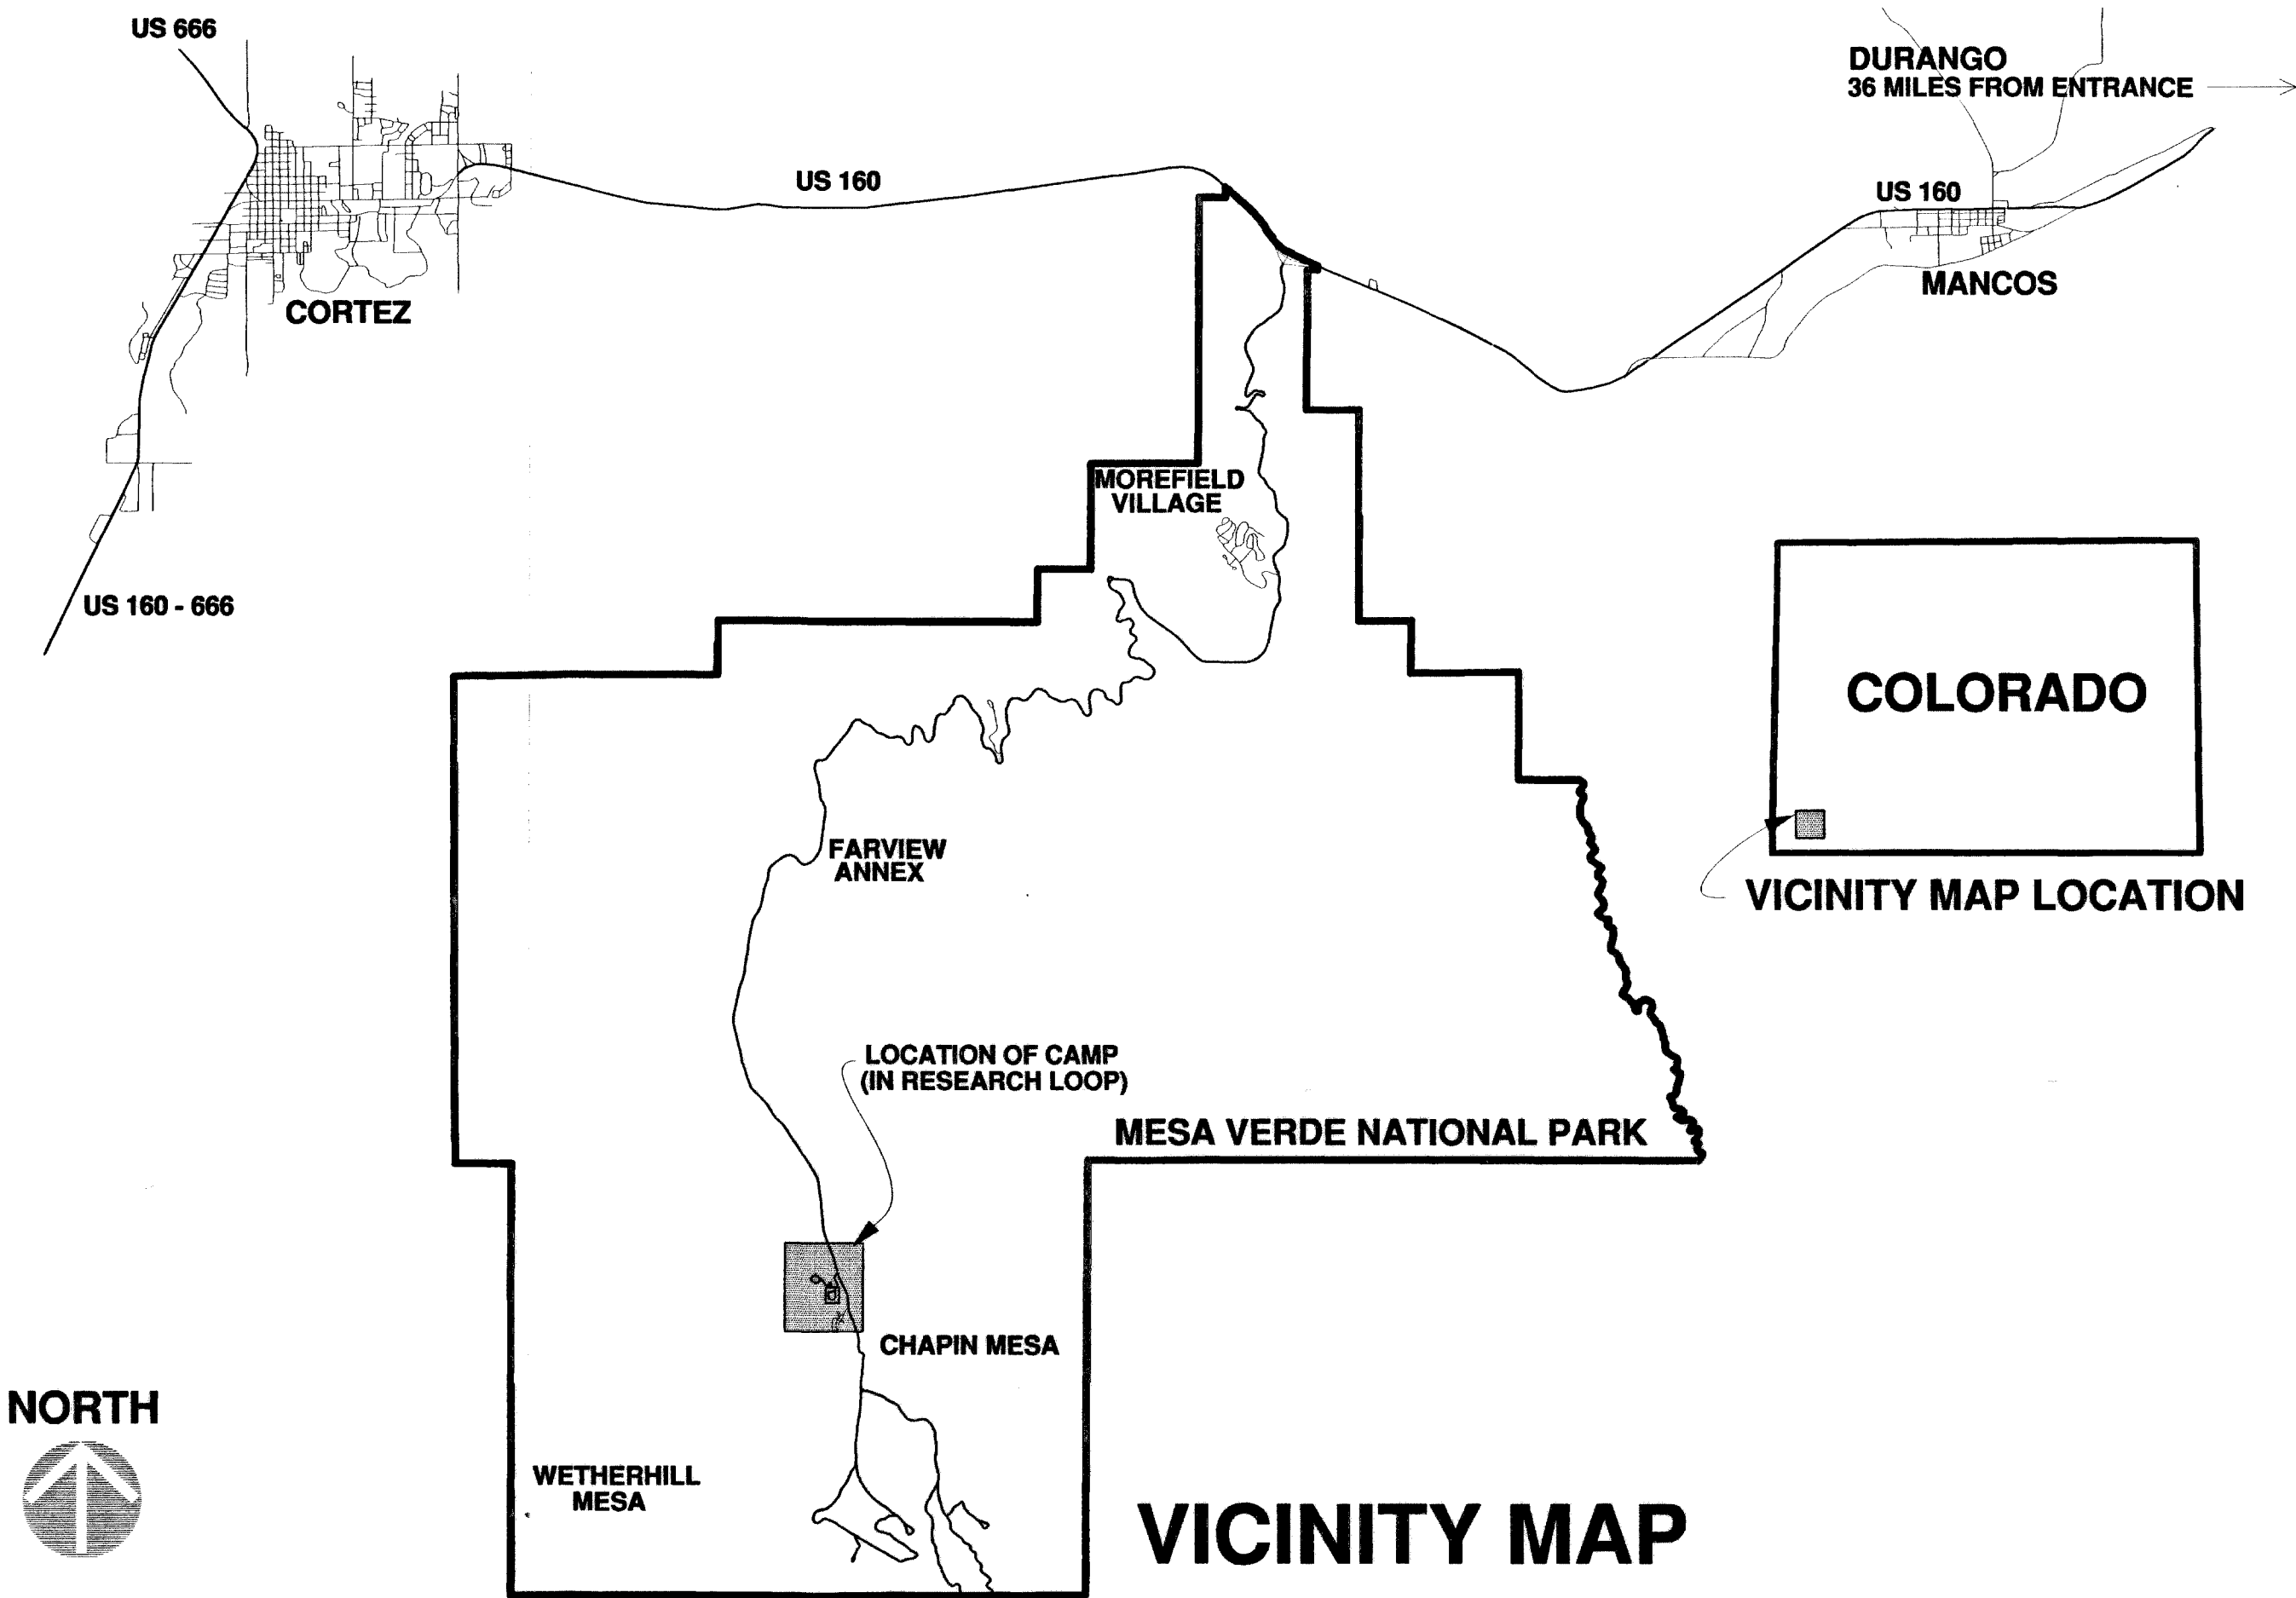


MESA VERDE NATIONAL PARK PLAYED HOST TO THREE SEPARATE CCC CAMPS AT VARIOUS TIMES BETWEEN 1933 AND 1942. THE FIRST CAMP OPENED IN PRATER CANYON IN 1933 AND CLOSED IN 1934. THAT SAME YEAR, TWO NEW CAMPS OPENED ON CHAPIN MESA. THESE TWO CAMPS MERGED IN 1937. THE REMAINING CAMP, KNOWN BY THE DESIGNATION NP-5-C, CONTINUED TO OPERATE UNTIL THE CCC PROGRAM DISBANDED IN 1942. THE BUILDINGS AND LANDSCAPE FEATURES REMAINING FROM NP-5-C ARE NOW DESIGNATED AS THE CCC CAMP HISTORIC DISTRICT.



THE CCC CAMP HISTORIC DISTRICT CONTAINS TWO SECTIONS, THE UPPER (NORTH) SECTION, AND A LOWER (SOUTH) SECTION. THE LOWER SECTION INCLUDES THE FEATURES OF THE CCC CAMP ITSELF. THESE FEATURES INCLUDE THE CCC RECREATION HALL, A BARRACKS BUILDING (#5), AND A LABYRINTH OF TRAILS THAT ONCE CONNECTED VARIOUS BUILDINGS IN THE CAMP. THIS LOWER SECTION STILL RETAINS SOME SEMBLANCE OF ITS ORIGINAL "U" SHAPED CONFIGURATION OF BUILDINGS.

THE PREDOMINATE ARCHITECTURAL STYLE OF THE HISTORIC DISTRICT CAN PERHAPS BEST BE DESCRIBED AS UTILITARIAN. THE BUILDINGS EXHIBIT ARCHITECTURAL CHARACTERISTICS TYPICALLY ASSOCIATED WITH CCC CAMPS, THAT IS, THEY WERE CONSTRUCTED IN A ROUGH AND INEXPENSIVE MANNER BASED ON THE ASSUMPTION THAT THEY WOULD ONLY BE USED FOR A TEMPORARY PERIOD. BARRACKS #5, ALSO KNOWN AS THE "JACK GRAY WAREHOUSE" WAS CONSTRUCTED IN 1934 AS ONE OF THE FIVE ORIGINAL BARRACKS BUILDINGS IN THE CCC CAMP. IN CLASSIC BARRACKS STYLE, THE BUILDING IS LONG AND NARROW, WITH A LIGHT WOOD FRAME COVERED ON THE EXTERIOR BY 8" HORIZONTAL LAP SIDING. THE ROOF, ORIGINALLY COVERED WITH ONLY ASPHALT PAPER, HAS HAD CORRUGATED METAL SHEETS ADDED AT A LATER DATE. ON THE INTERIOR, THE BUILDING HAS A TONGUE IN GROOVE WOOD FLOOR, CELOTEX WALLS, AND AN OPEN CEILING.


THIS PROJECT WAS UNDERTAKEN BY DONALD W. CORBEIL, WITH ASSISTANCE IN MEASURING BY JAMES McARTHUR, WORKING UNDER CONTRACT WITH THE NATIONAL PARK SERVICE. THE PROJECT WAS DONE UNDER THE DIRECTION OF SAYRE HUTCHISON AND LYSA WEGMAN-FRENCH OF THE INTERMOUNTAIN SUPPORT OFFICE, CULTURAL AND NATIONAL REGISTER PROGRAM SERVICES, DENVER, COLORADO.

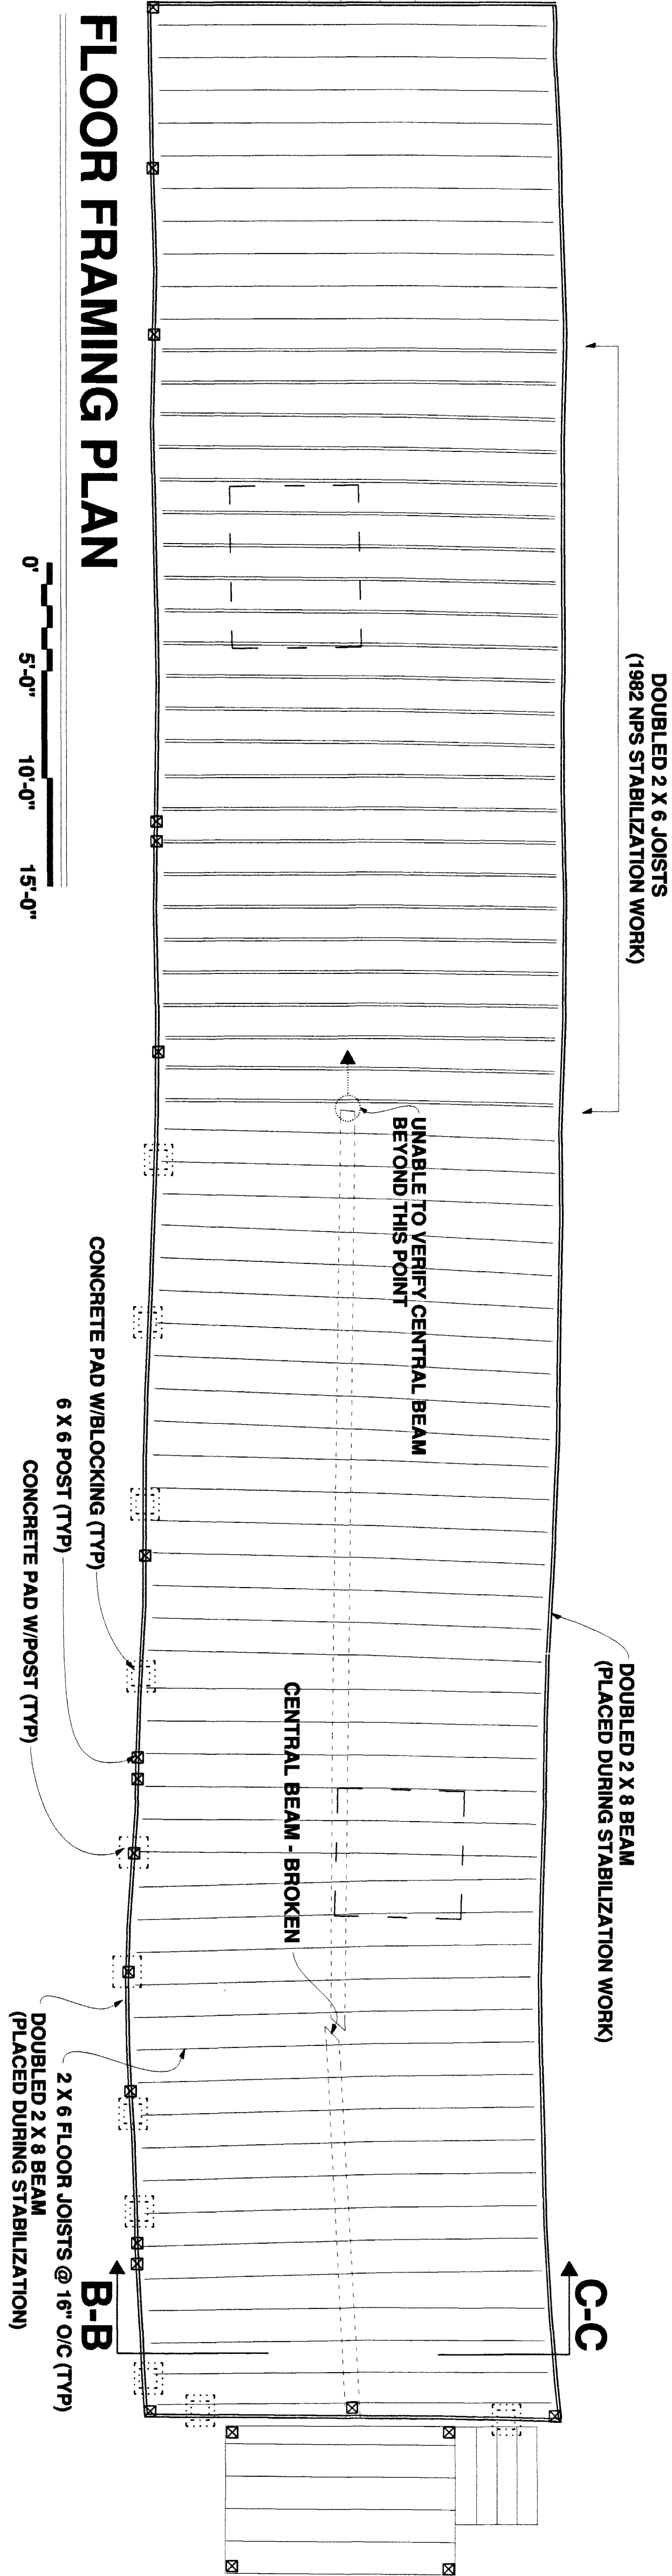

FLOOR FRAMING PLAN

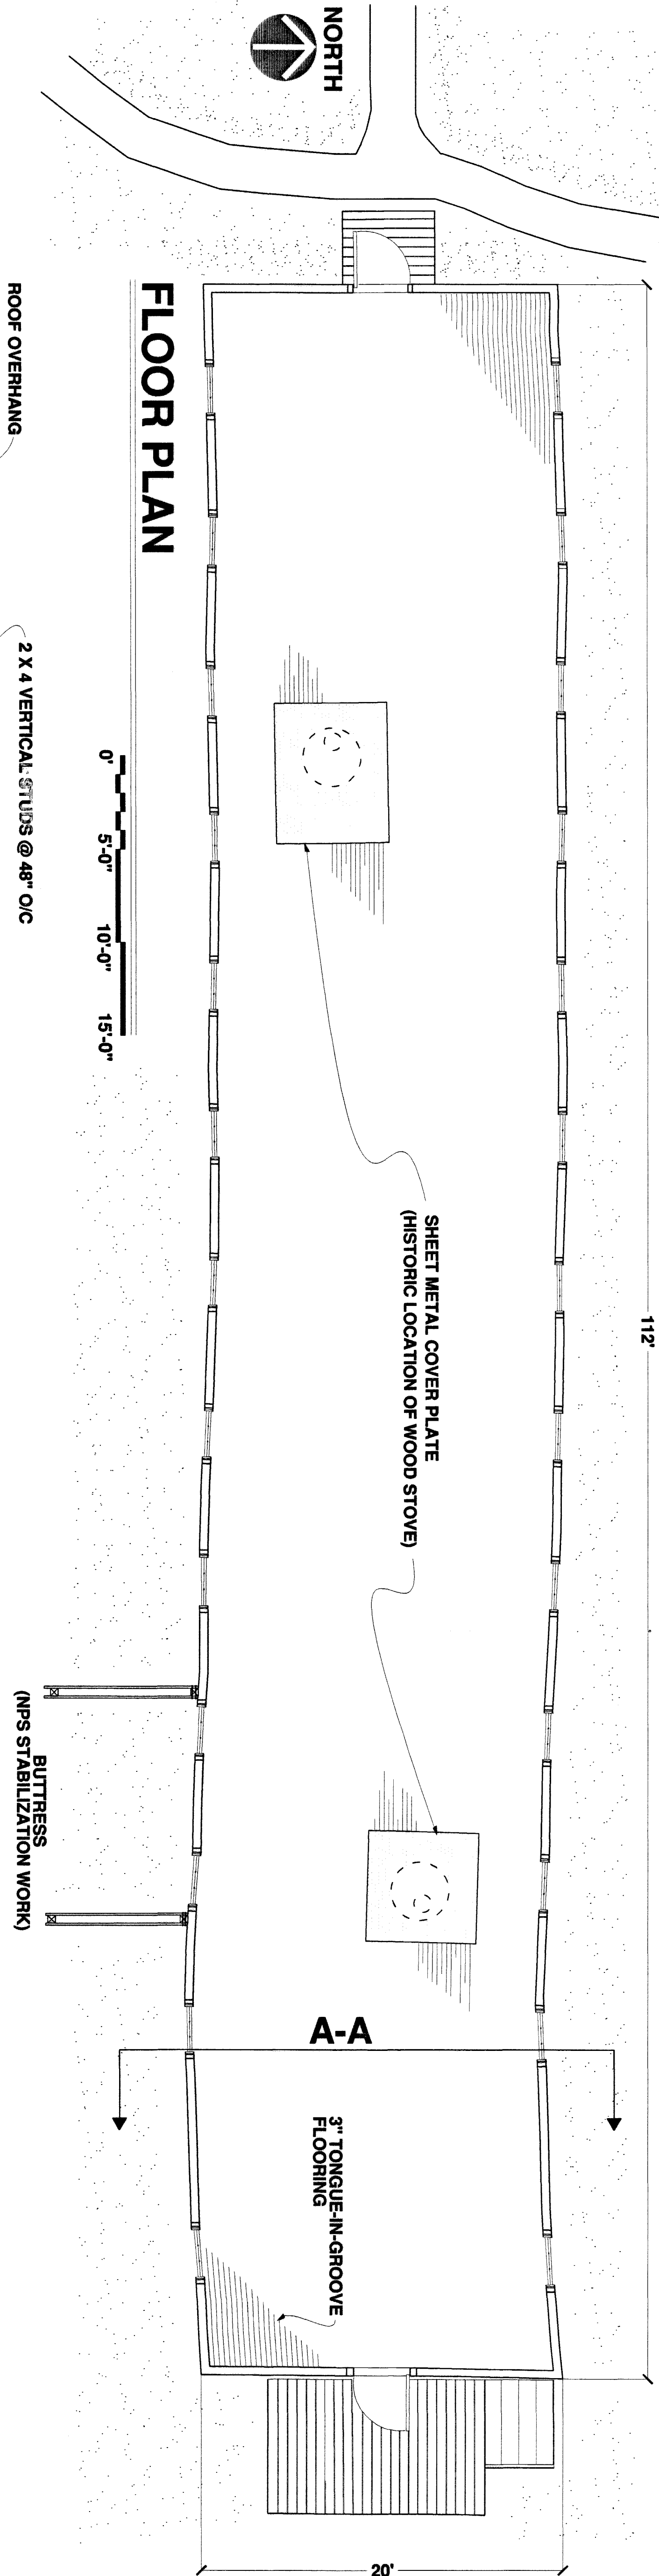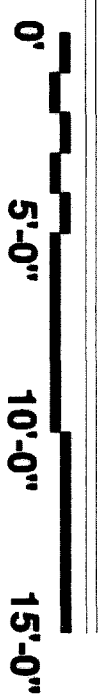

FLOOR PLAN

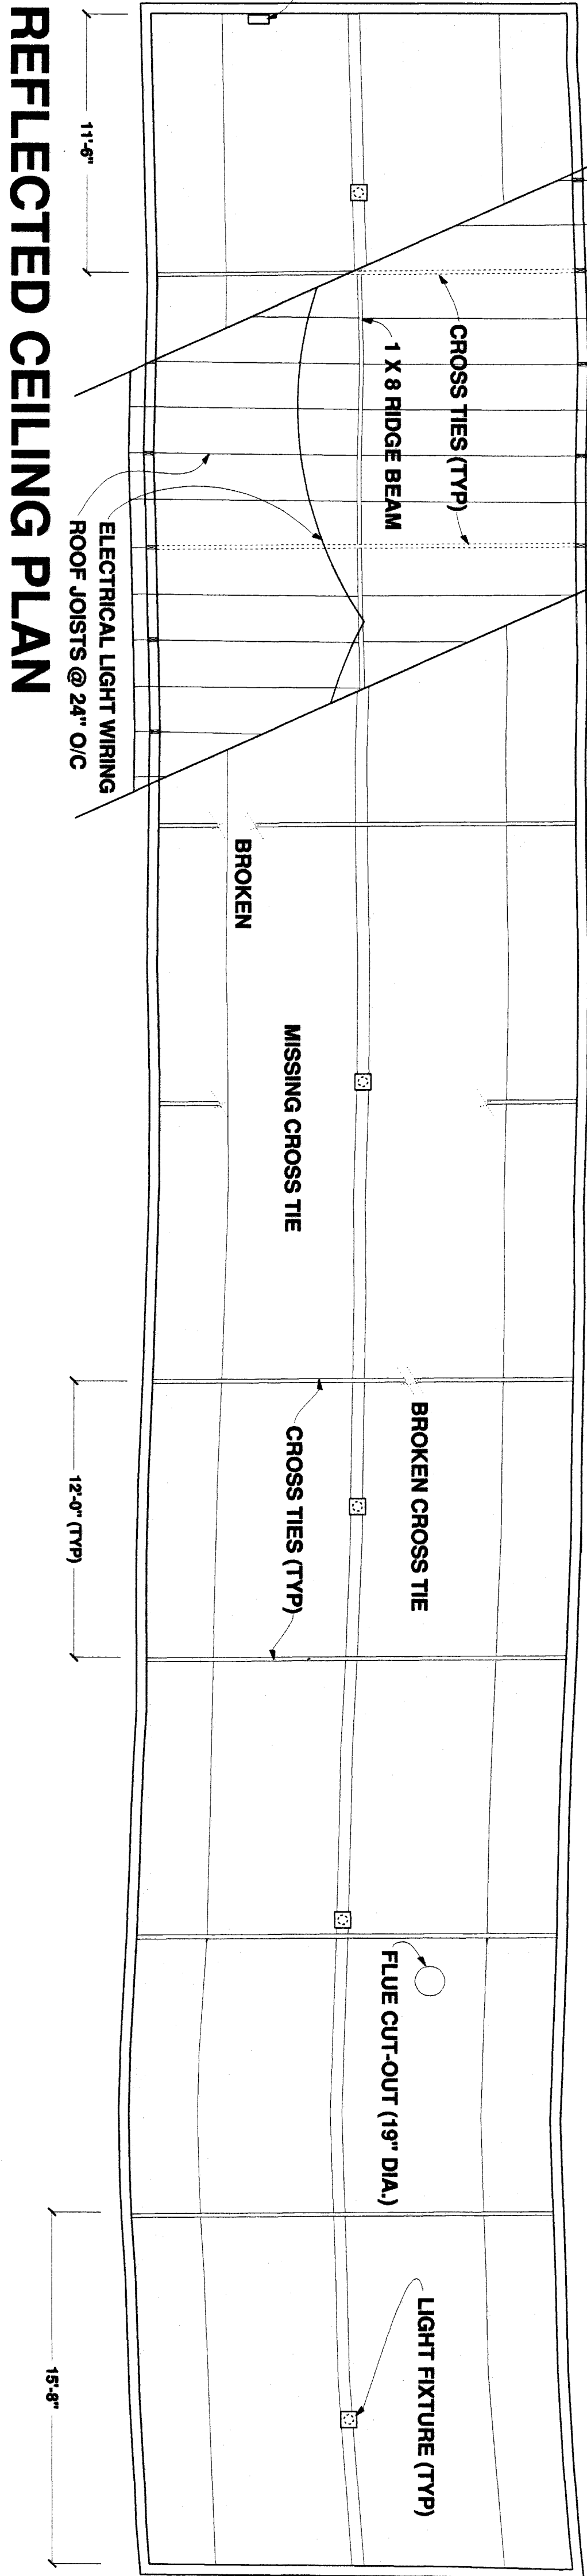

REFLECTED CEILING PLAN



DRAWN BY: Donald W. Corbeil, 1999






INTERMOUNTAIN SUPPORT OFFICE/DENVER
NATIONAL PARK SERVICE
UNITED STATES DEPARTMENT OF THE INTERIOR

CIVILIAN CONSERVATION CORPS (CCC) CAMP NP-5-C, BARRACKS #5
MESA VERDE NATIONAL PARK CORTEZ VICINITY MONTEZUMA COUNTY COLORADO

SURVEY NO.
CO
198-A

HISTORIC AMERICAN
BUILDINGS SURVEY
SHEET 2 OF 4 SHEET

LIBRARY OF CONGRESS
DIXIE NUMBER

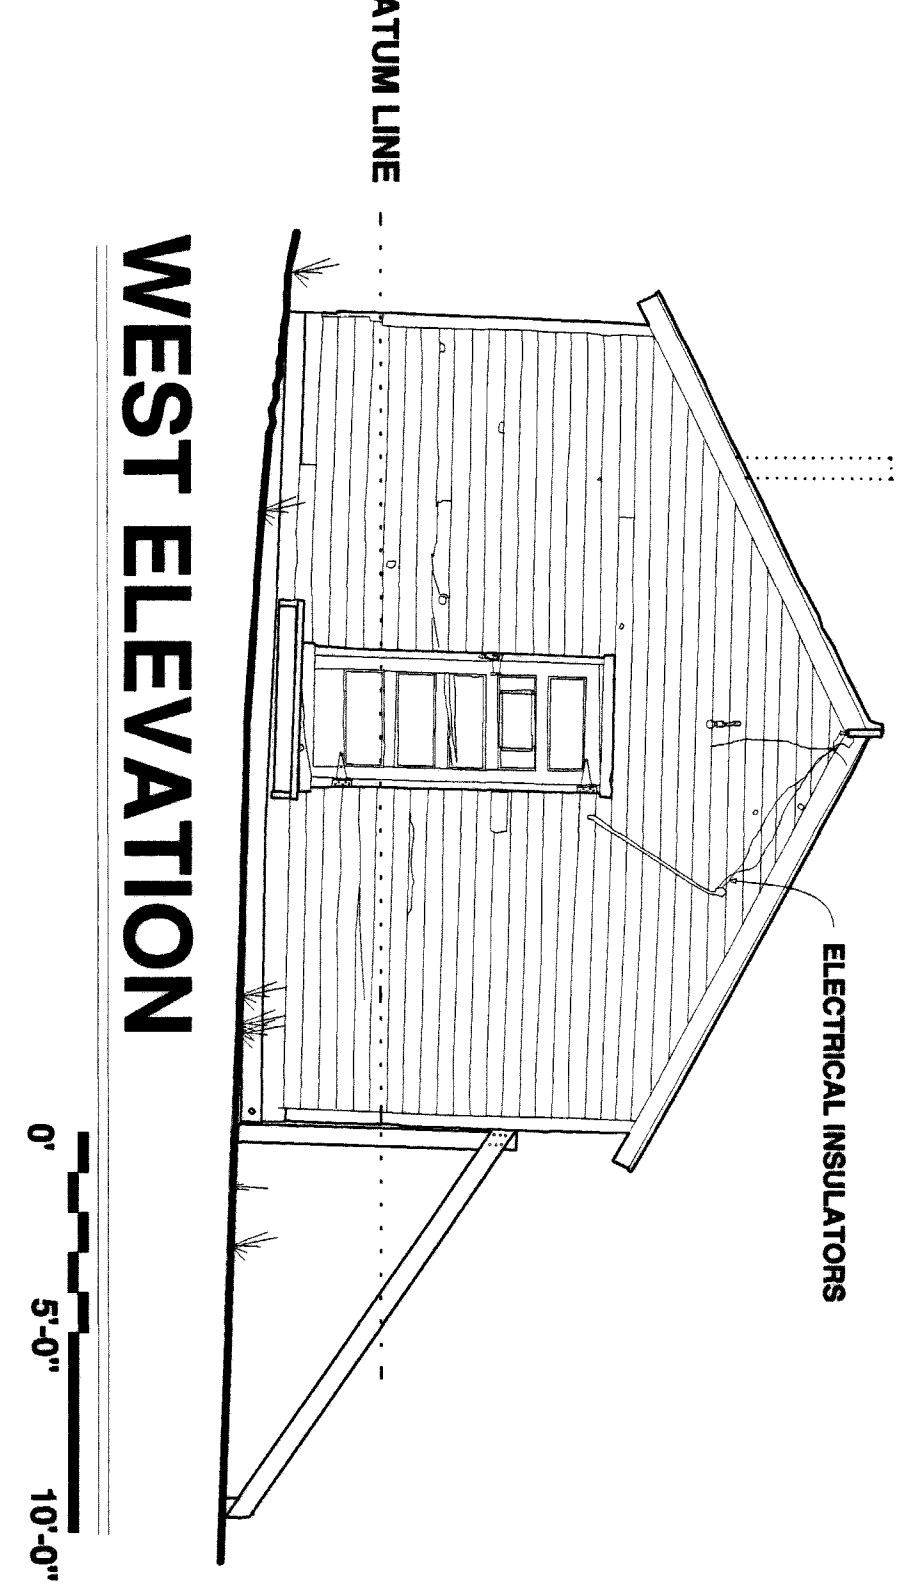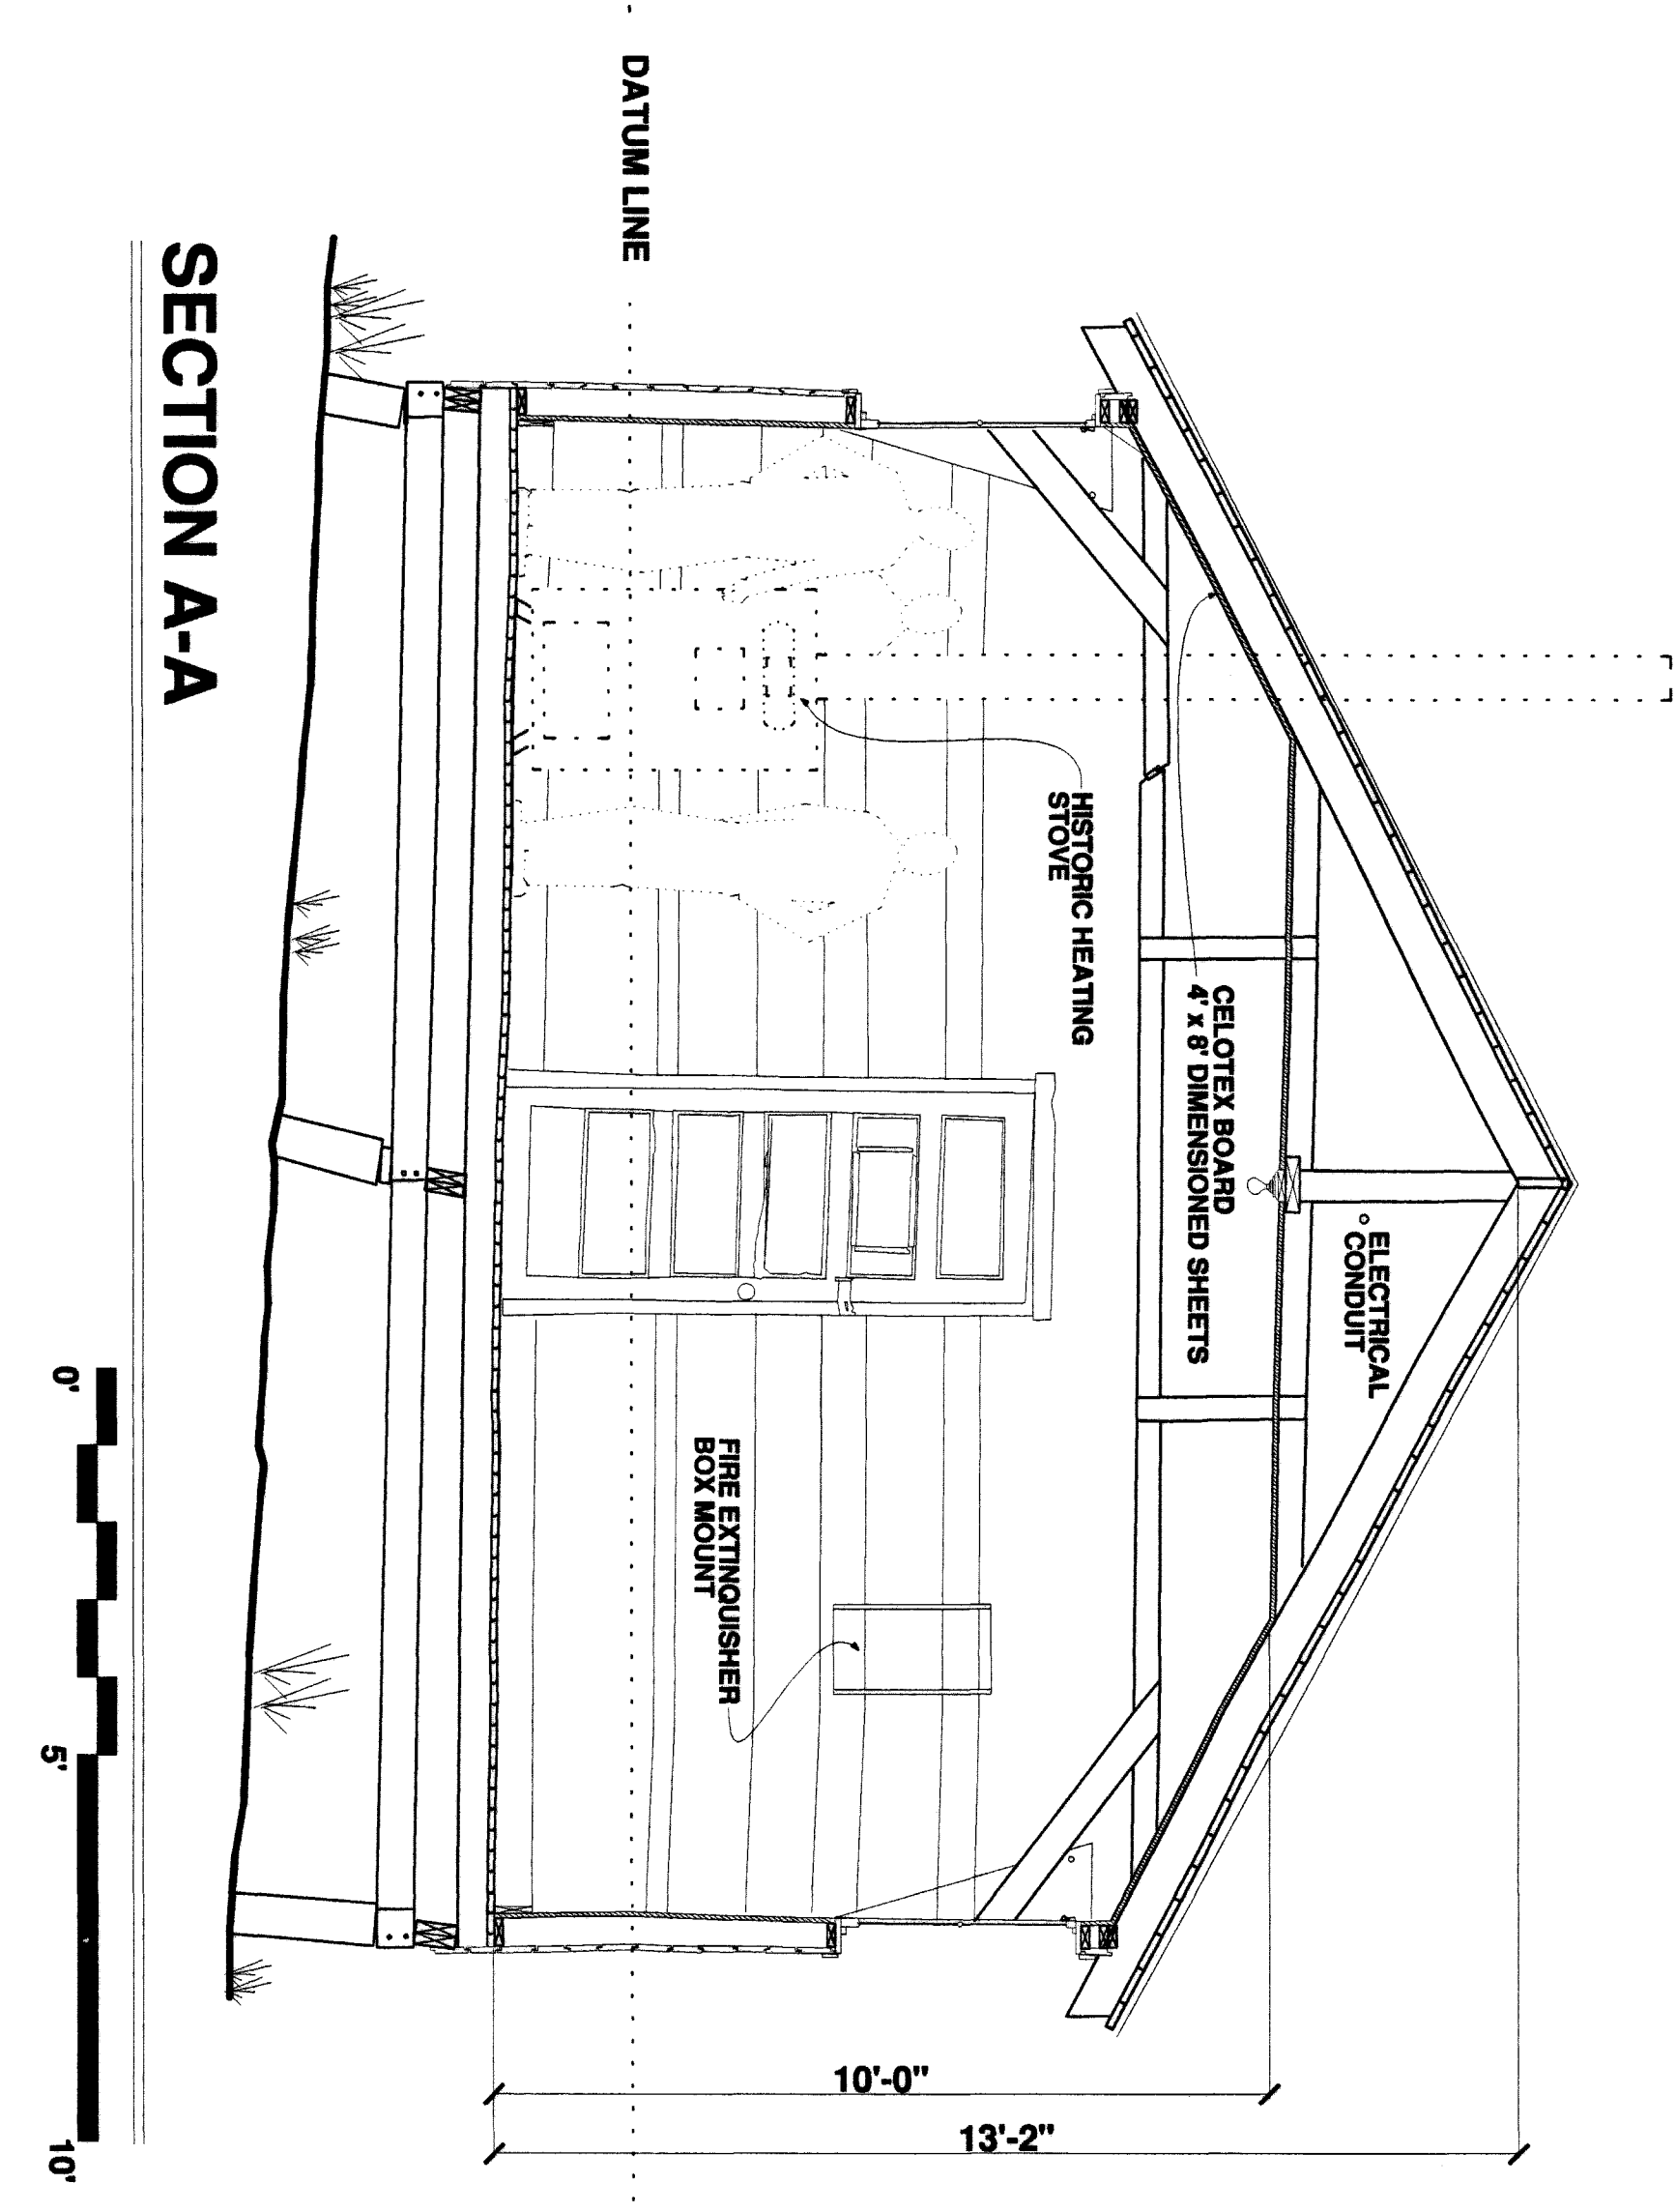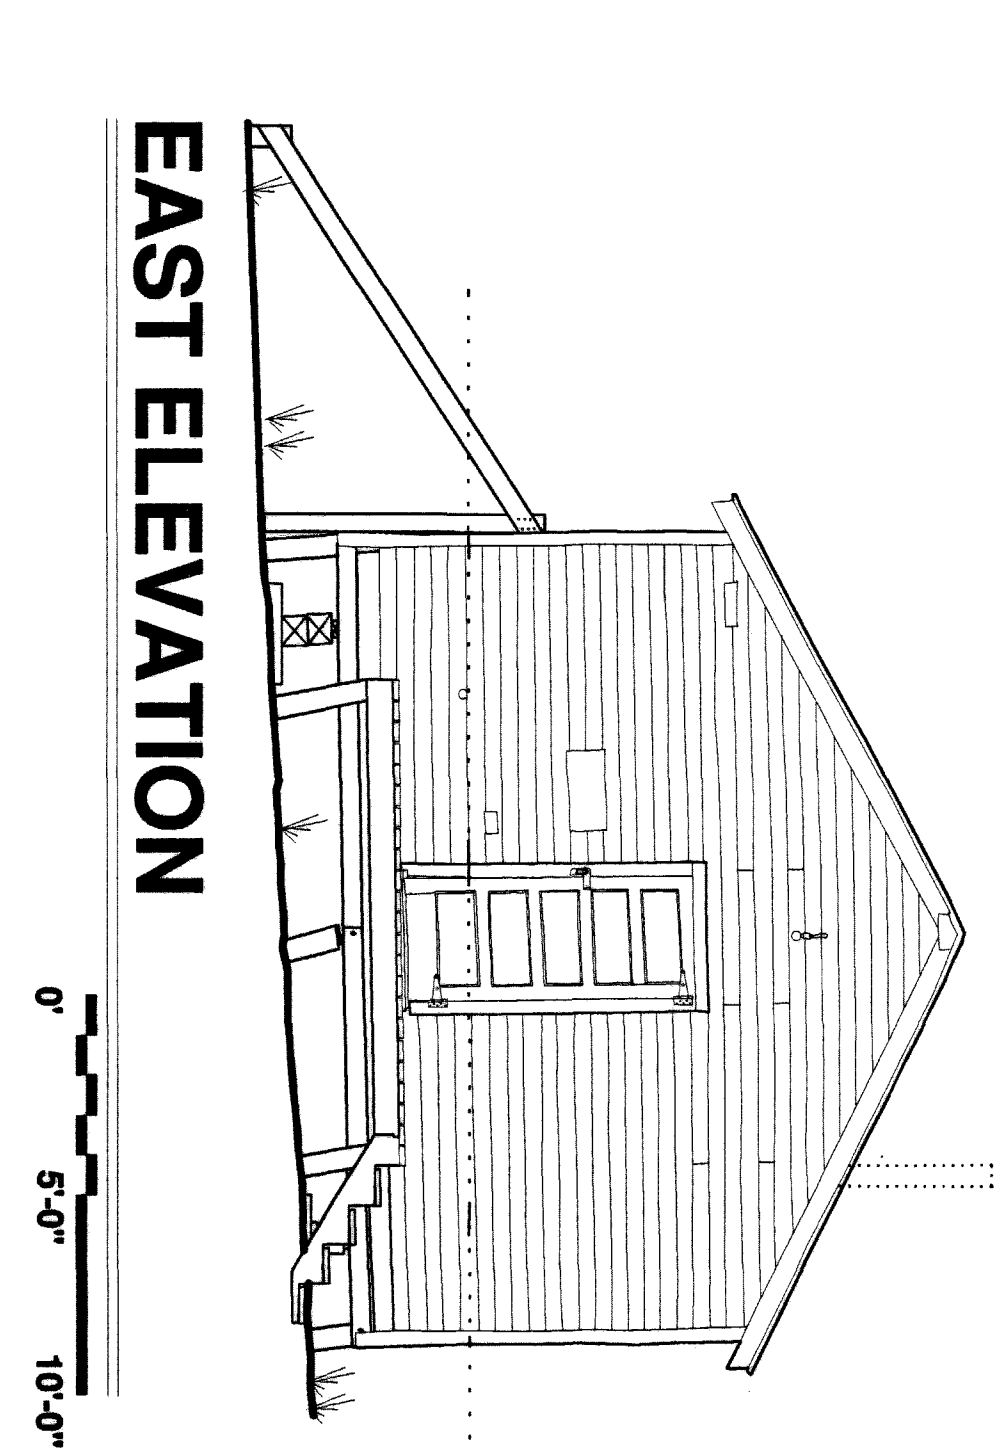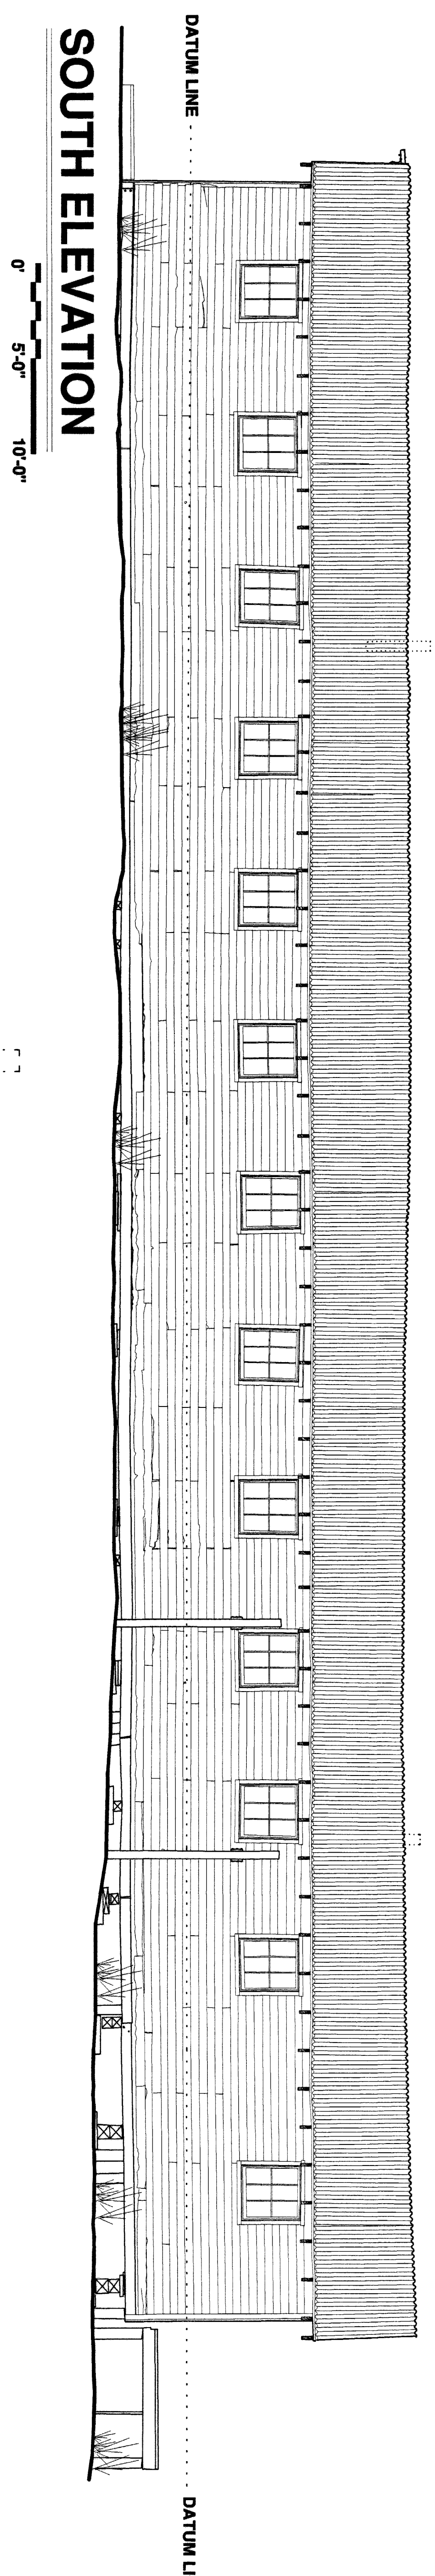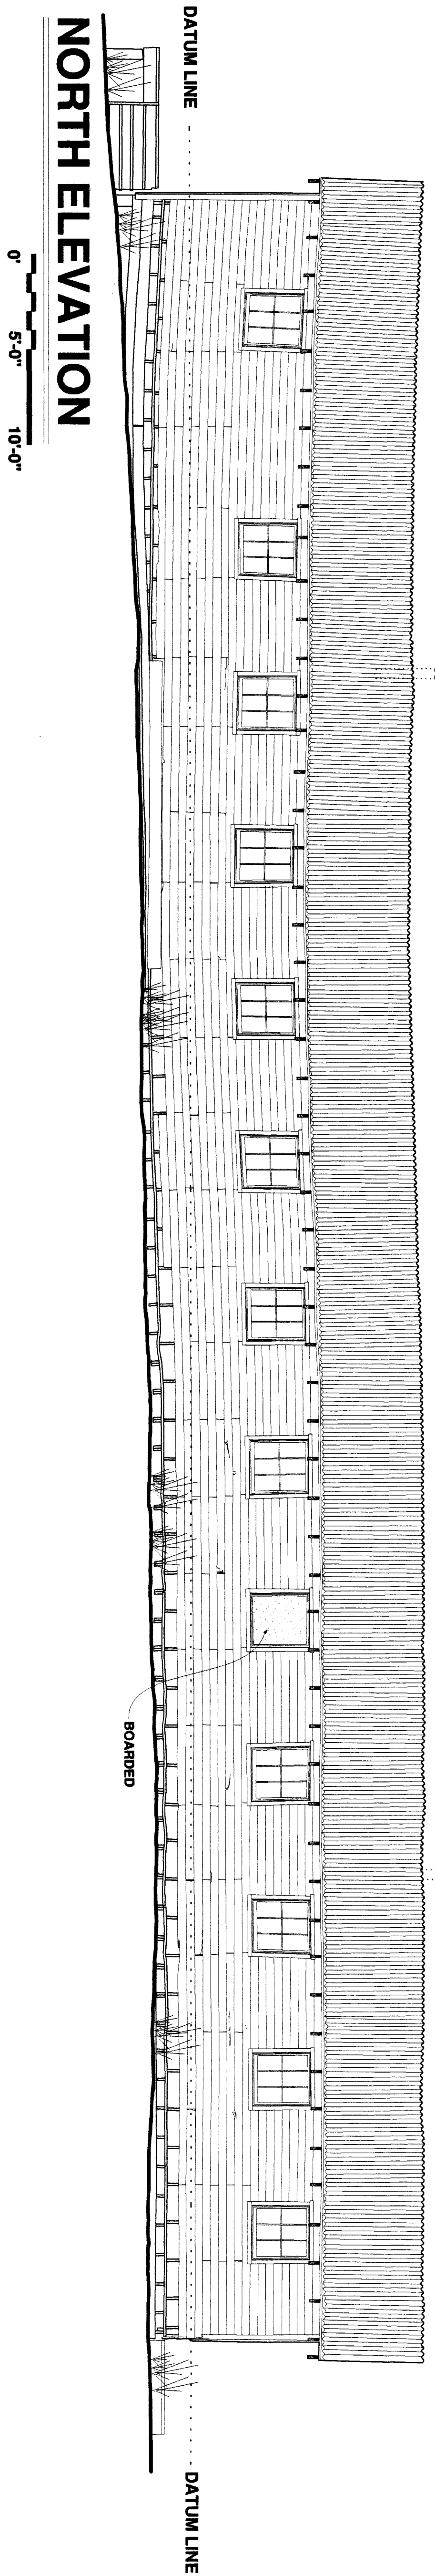

DRAWN BY: Donald W. Corbeil, 1999

INTERMOUNTAIN SUPPORT OFFICE/DENVER
NATIONAL PARK SERVICE
UNITED STATES DEPARTMENT OF THE INTERIOR


CIVILIAN CONSERVATION CORPS (CCC) CAMP NP-5-C, BARRACKS #5
MESA VERDE NATIONAL PARK CORTEZ VICINITY MONTEZUMA COUNTY COLORADO

SURVEY NO.
CO
198-A



HISTORIC AMERICAN
BUILDINGS SURVEY
SHEET 3 OF 4 SHEET

LIBRARY OF CONGRESS
BOOK NUMBER

IF REPRODUCED, PLEASE CREDIT THE HISTORIC AMERICAN BUILDINGS SURVEY, NATIONAL PARK SERVICE, NAME OF DELINEATOR, DATE OF DRAWING


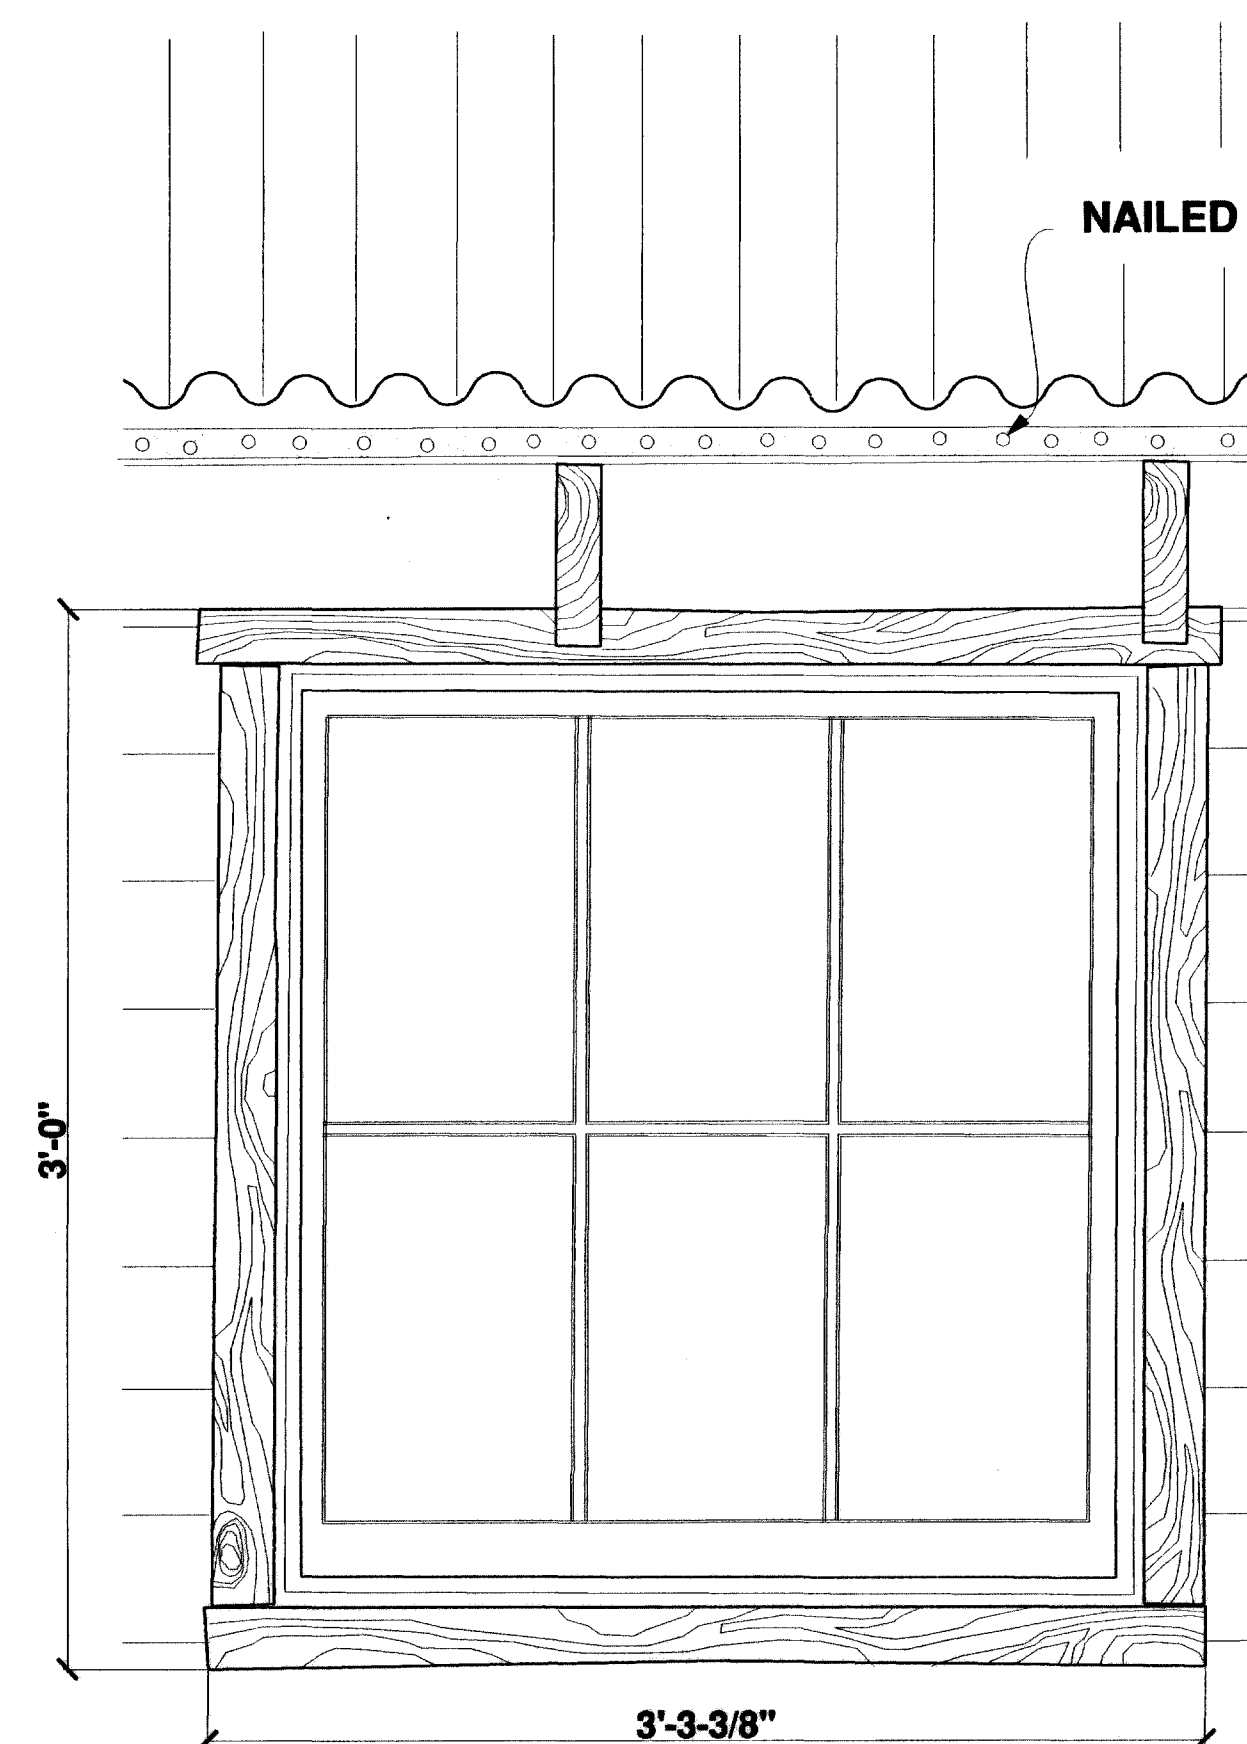


TYPICAL WINDOW ELEVATION

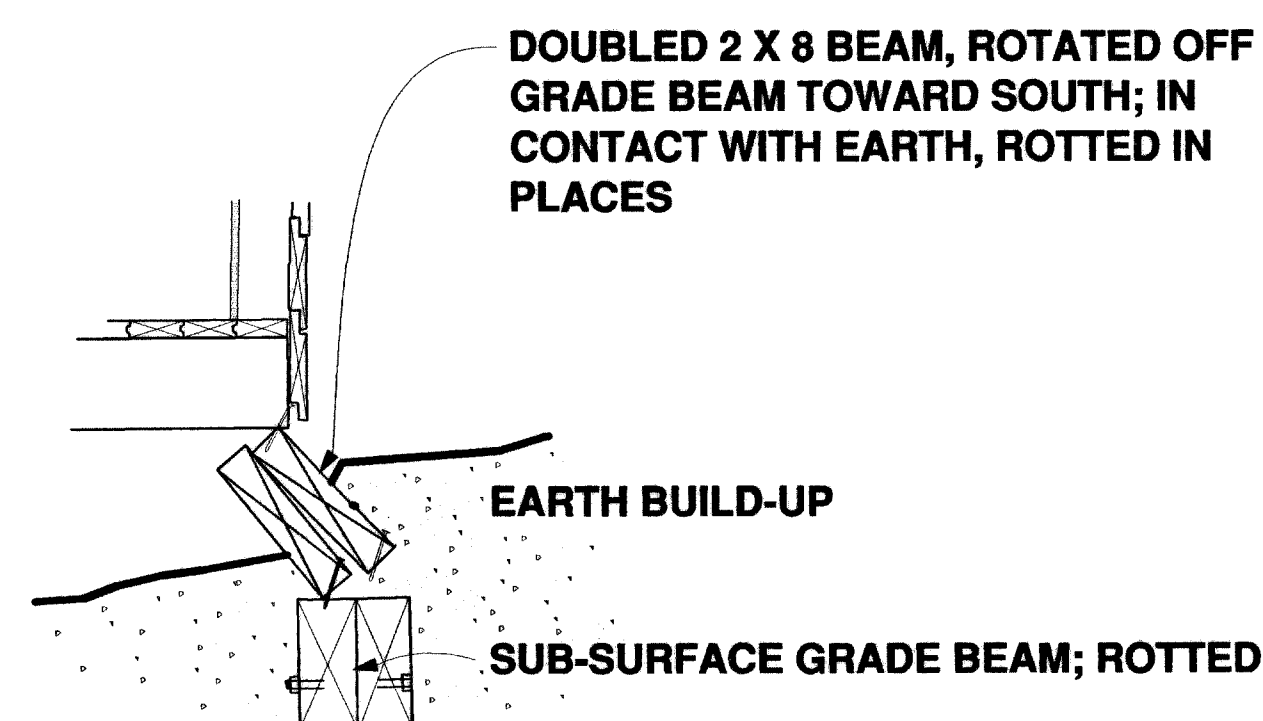
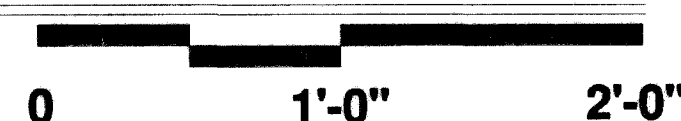


FOUNDATION SECTION C-C



NORTH END, LOOKING WEST

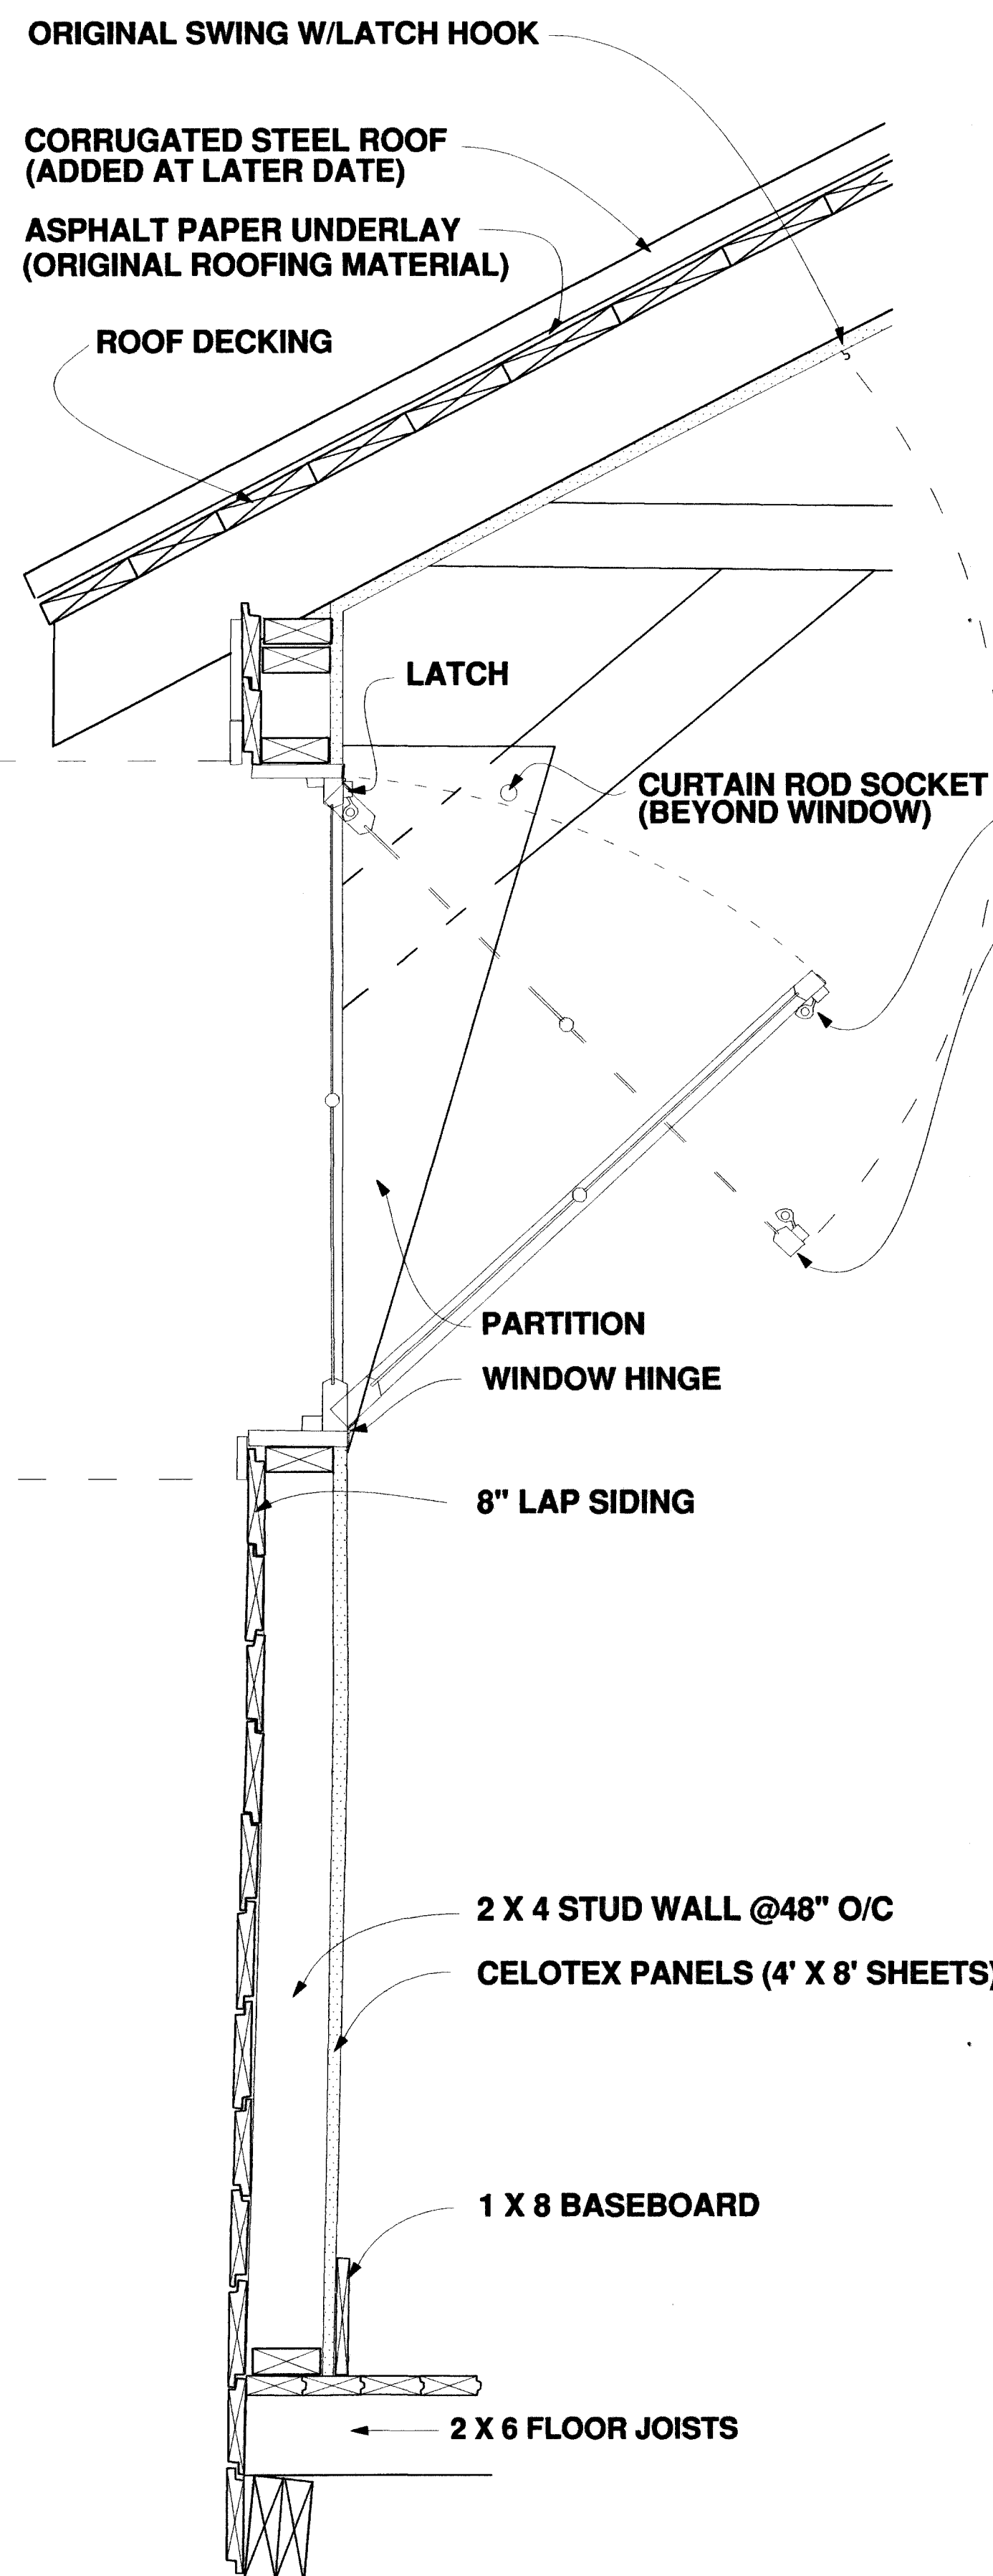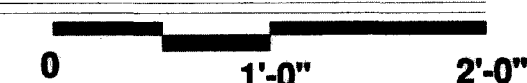

WALL SECTION

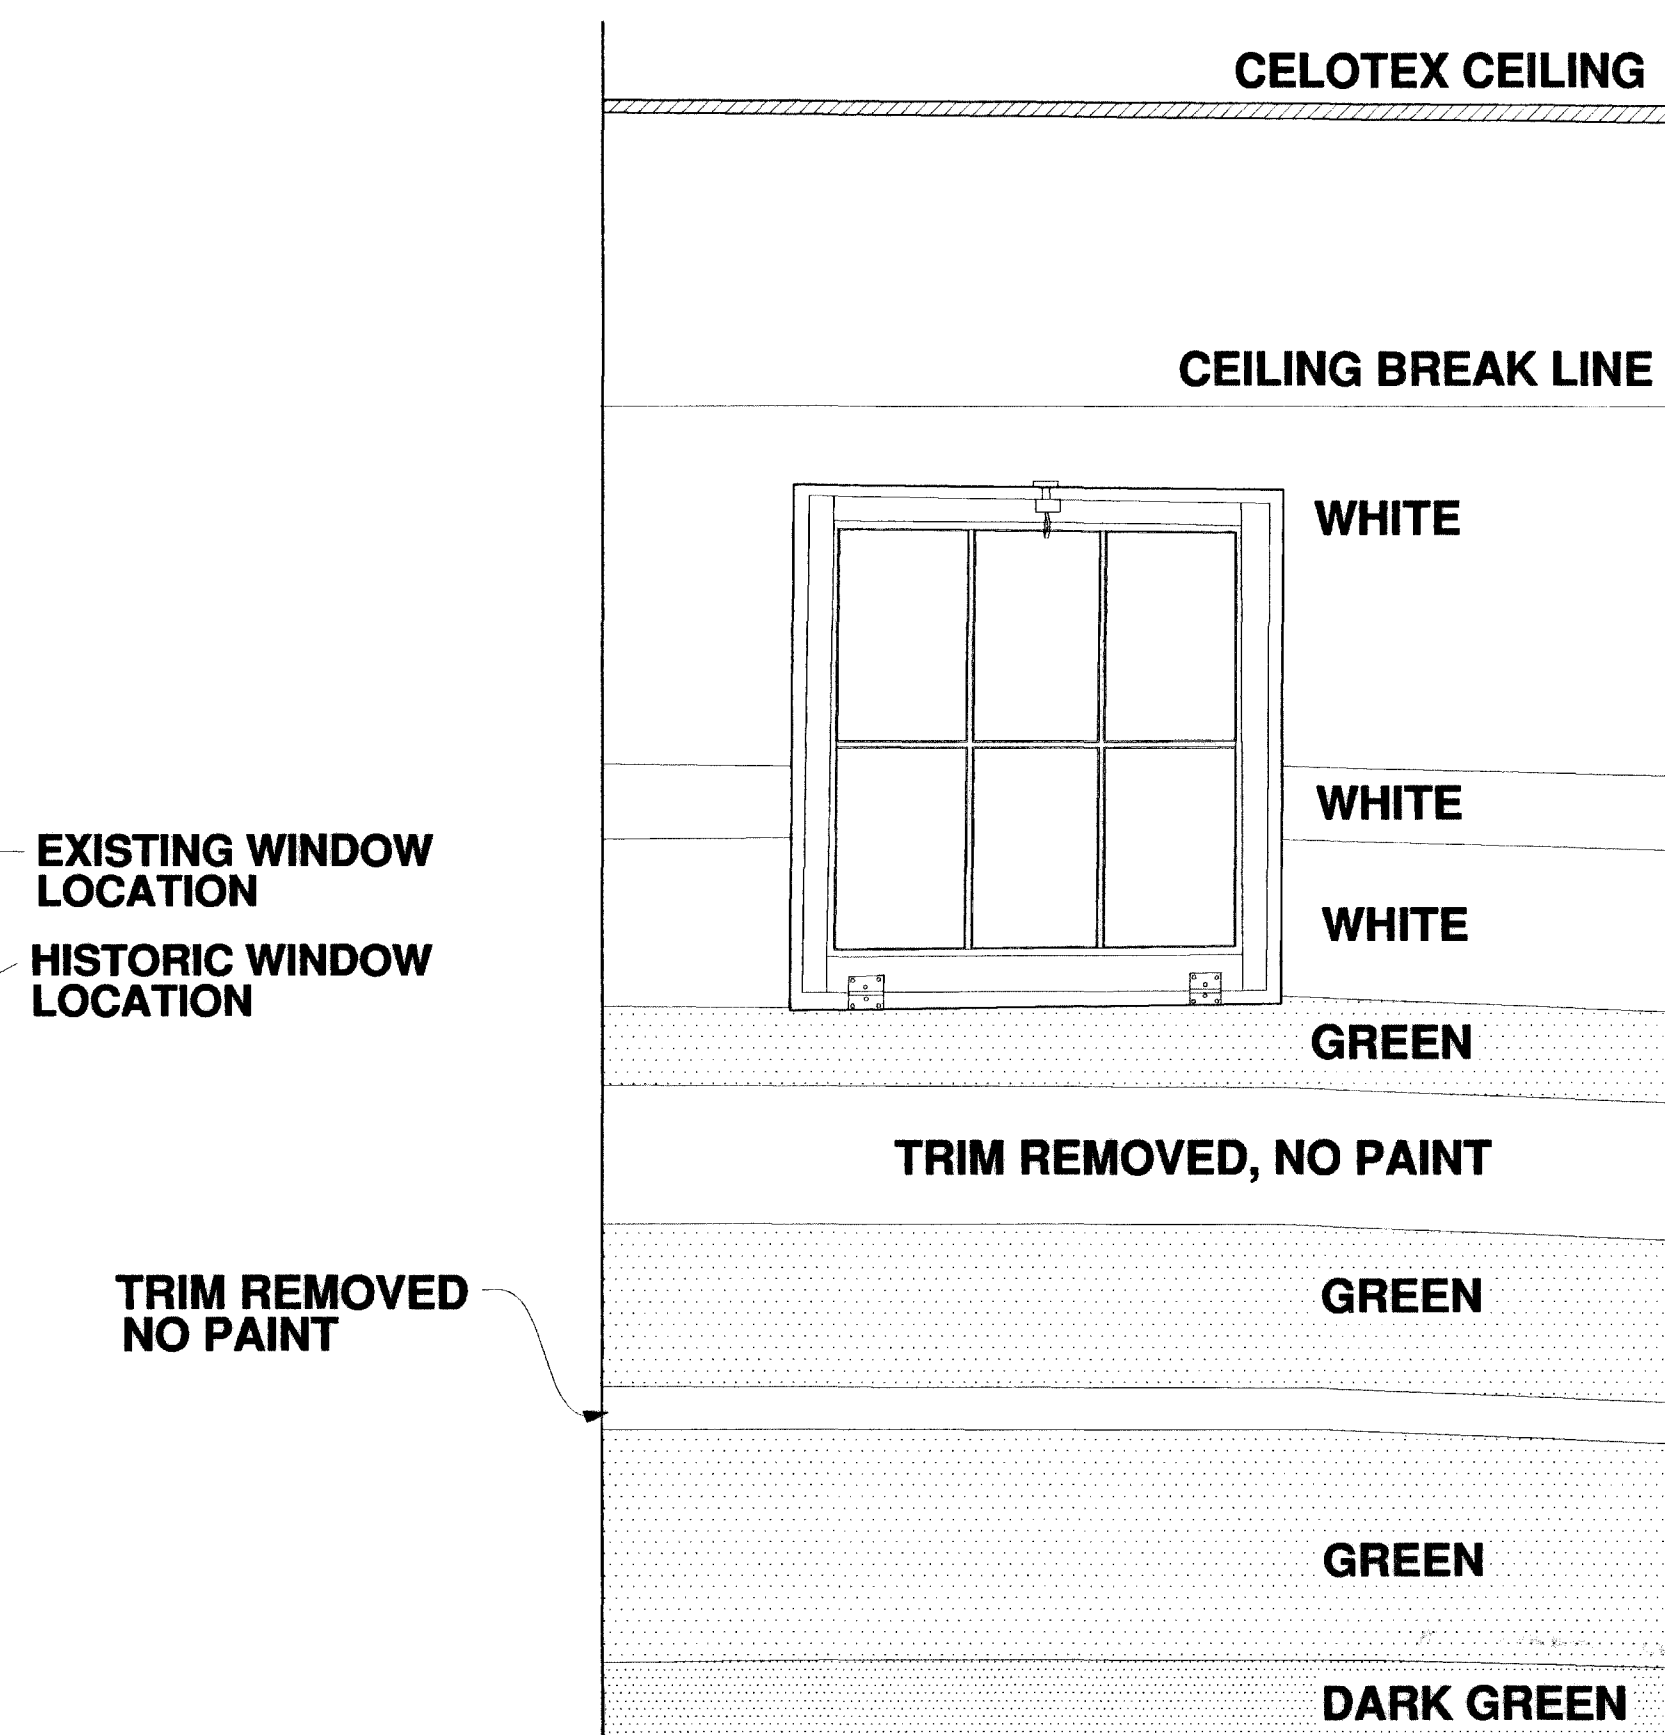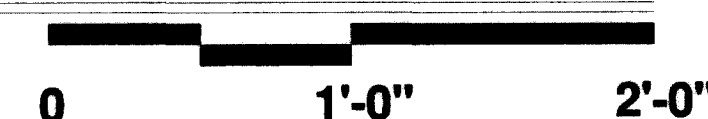


**INTERIOR WALL
PAINT SEQUENCE (TYP)**

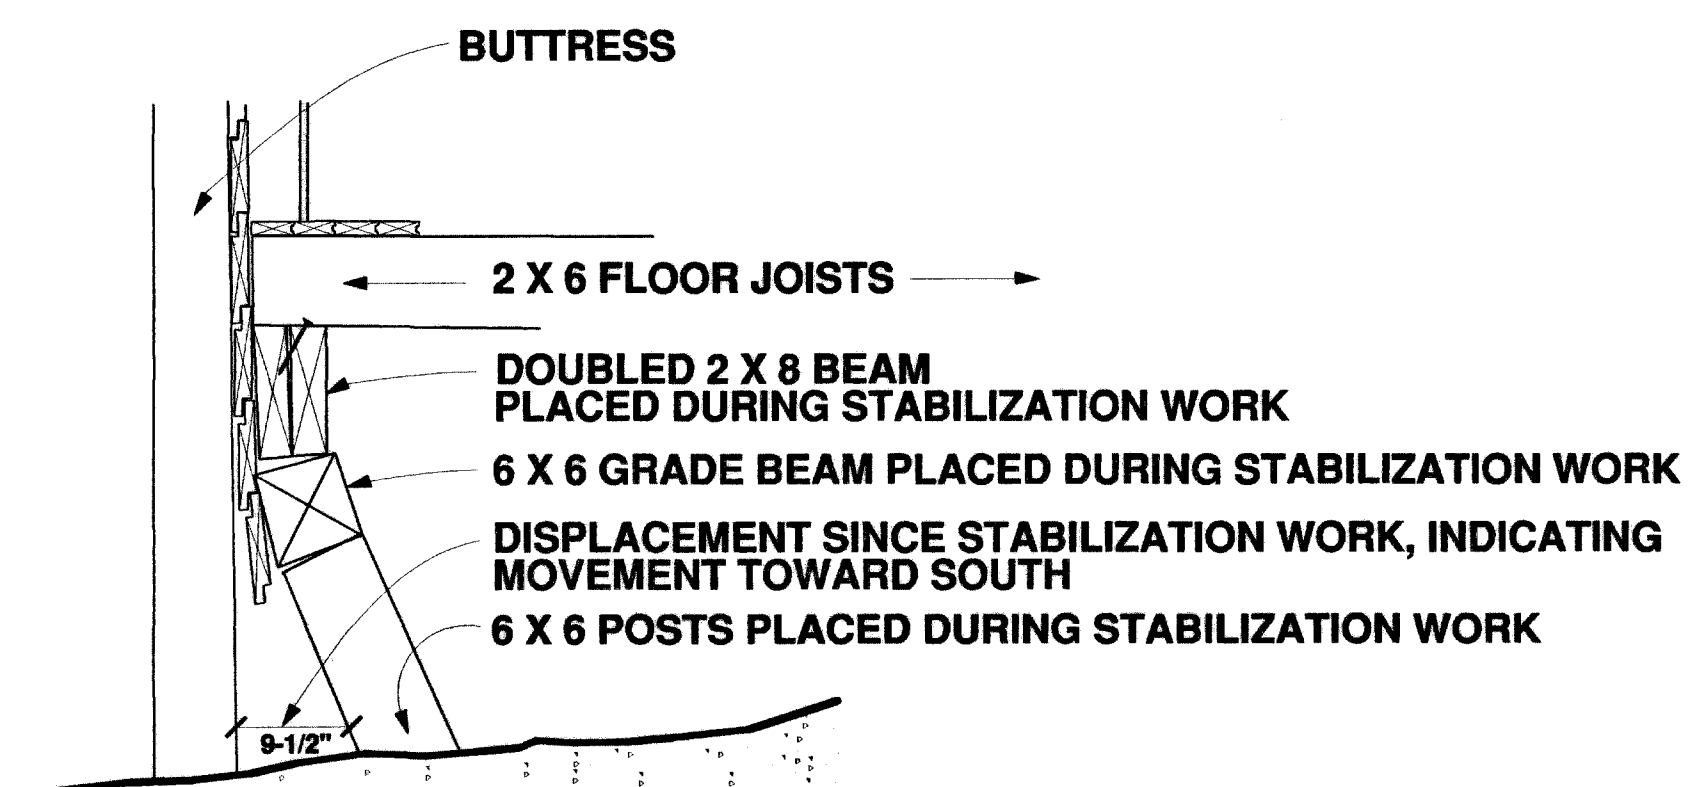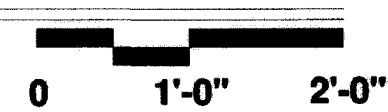

FOUNDATION SECTION B-B

THROUGH BUTTRESS SUPPORT
LOOKING WEST

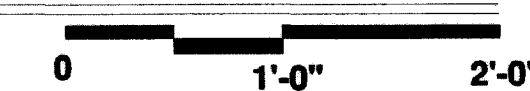

DRAWN BY: Donald W. Corbell, 1999

INTERMOUNTAIN SUPPORT OFFICE/DENVER
NATIONAL PARK SERVICE
UNITED STATES DEPARTMENT OF THE INTERIOR

CIVILIAN CONSERVATION CORPS (CCC) CAMP NP-5-C, BARRACKS #5
MESA VERDE NATIONAL PARK
CORTEZ VICINITY
MONTEZUMA COUNTY
COLORADO

SHEET NO. CO 198-A
HISTORIC AMERICAN BUILDINGS SURVEY

DATE: 1999

IF REPRODUCED, PLEASE CREDIT THE HISTORIC AMERICAN BUILDINGS SURVEY, NATIONAL PARK SERVICE, NAME OF DESIGNATOR, DATE OF DRAWING